

# *City of Jonestown, Texas*

# AGENDA REPORT

**Meeting Date:** January 12, 2026

## Agenda Item Number:

1. *What is the name of the author?*

(City Secretary's Use Only)

**Department:** Development Services

**Budgeted Amount:** \$0

Date Prepared: January 7, 2026

**Exhibits:** Letter of Justification For a Special Exception  
SFR Rendering For Permit 2024-1036  
Notice of Hearing

## Subject

Consideration and Approval of a Special Exception Request to Allow Unenclosed Parking in Lieu of Enclosed Parking as Required by Table 3.2.4-1 of the Jonestown Unified Development Code (UDC) for a Single-Family Residence at 17363 East Reed Parks Road

## Recommendation

Staff recommends that the Board of Adjustments deny the request to allow unenclosed parking in lieu of enclosed parking as required by Table 3.2.4-1 of the Jonestown UDC for a single-family residence at 17363 East Reed Parks Road, pursuant to UDC Section 1.05.086(b)(2).

## Discussion

The applicant requests a Special Exception to allow unenclosed parking (carport) in lieu of the two (2) enclosed parking spaces per dwelling unit required for single-family residences under UDC §3.2.4, Parking, and Table 3.2.4-1. The subject property is zoned R-1.

The applicant previously submitted Residential – New Construction Building Permit No. 2024-1036, which depicted enclosed parking consistent with the applicable parking requirements. The permit was reviewed and approved based on that compliance. The current request reflects a subsequent change in design preference to replace the approved enclosed parking with unenclosed parking, rather than a condition imposed by the ordinance or the physical characteristics of the property.

The request is evaluated under the criteria set forth in UDC Section 1.05.086(b)(2). A Special Exception may be granted only if the required findings can be made. Staff have reviewed the applicant's Letter of Justification dated October 16, 2025, and finds that the request does not satisfy the applicable criteria.

**EVALUATION OF SPECIAL EXCEPTION CRITERIA PER UDC §1.05.086(b)(2)**

**1. Character or use of the building**

UDC §1.05.086(b)(2) requires a finding that “the character or use of the building is such as to make unnecessary the full provision of parking or loading facilities.”

Staff find this criterion is not met. The proposed development is a single-family residence, a use for which two (2) enclosed parking spaces per dwelling unit are expressly required in the R-1 zoning district pursuant to Table 3.2.4-1. The character and use of the residence are typical of residential development within the city and do not reduce or eliminate the need for the required enclosed parking. The applicant’s justification is based on architectural design intent and project vision rather than a functional aspect of the use that would make enclosed parking unnecessary.

**2. Topography or unusual shape of the lot**

The ordinance requires a finding that “the topography or unusual shape of the lot and regulations would impose an unreasonable hardship upon the use of the lot, as contrasted with merely granting an advantage or a convenience.”

Staff find this criterion is not met. While the property is large and features Hill Country topography, these characteristics are common within Jonestown and do not prevent compliance with the enclosed parking requirement. The applicant’s previously approved building permit 2024-1036 demonstrates that the site can reasonably accommodate enclosed parking in compliance with Table 3.2.4-1. The request to allow unenclosed parking would provide a design preference or convenience rather than relief from an unreasonable hardship created by the lot’s physical conditions.

**3. Application of Table 3.2.4-1 parking regulations**

UDC §1.05.086(b)(2) further requires a finding that “the regulations in Table 3.2.4-1 would impose an unreasonable hardship upon the use of the lot, as contrasted with merely granting an advantage or a convenience.”

Staff find this criterion is not met. The enclosed parking requirement applies uniformly to single-family residences in the R-1 district and was met through the applicant’s originally approved plans under Permit No. 2024-1036. The applicant has not demonstrated that compliance with the enclosed parking requirement deprives the property of reasonable use. Instead, the request seeks relief from a standard previously accepted and approved in order to pursue an alternative architectural approach involving unenclosed parking.


**City of Jonestown,  
Texas**

**AGENDA REPORT**

Therefore, based on the above rationale, Staff find that the applicant has not demonstrated that the request satisfies the required findings under UDC Section 1.05.086(b)(2). The request represents a voluntary design change rather than an unreasonable hardship imposed by the ordinance or the physical characteristics of the property. For these reasons, Staff recommends denial of the Special Exception request.

<b>Approval By</b>	
<b>Department Head</b>	<i>PLM</i>
<b>City Administrator</b>	<i>Shae Marvin</i>
	<i>1/7/2026</i>

**REQUEST TO BE PLACED ON THE AGENDA OF  
THE BOARD OF ADJUSTMENT AND APPEAL  
APPLICATION FOR CONSIDERATION OF A:  
VARIANCE – APPEAL – SPECIAL EXCEPTION**
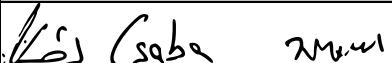
<b>VARIANCE <input type="checkbox"/></b>	<b>APPEAL <input type="checkbox"/></b>	<b>SPECIAL EXCEPTION <input checked="" type="checkbox"/></b>
<b>PROJECT INFORMATION</b>		
<b>Subject property street address</b> 17363 E Reed Parks Rd, Jonestown, TX 78645		<b>Date submitted</b> Dec 3, 2025
<b>Legal Description</b> ABS 325 SUR 603 GREGG J & ABS 2536 SUR	<b>Subdivision</b> 104 CARLTON J F ACR 5.338	<b>Section or Block</b> <b>Lot Number</b>
<b>CONTACT INFO</b>		
<b>Property Owners Name</b> Csaba Kos & Seon Mee Chang	<b>Phone Number</b> 737-781-2127	<b>Email</b> csaba.kos@gmail.com
<b>Mailing Address</b> 2820 Latana Ridge Dr	<b>City</b> Austin	<b>State</b> TX
<b>REQUEST DETAILS</b>		
<b>Explanation of request</b> This is a request for a Special Exception from the residential parking requirements, as explicitly authorized by Chapter 1, Section 1.05.086(b) of the Ordinances. The request is to permit the construction of an architecturally integrated, attached carport in lieu of the mandated enclosed garage for a new single-family residence. The basis for this request is that the unique character of the proposed building, the special conditions of the 5-acre property, and the unreasonable hardship imposed by the literal enforcement of the ordinance make the full provision of an enclosed garage unnecessary and detrimental. The proposed design, by the nationally recognized firm Alterstudio, utilizes the carport as a superior and integral architectural element that is more harmonious with the modern design and the natural Hill Country topography of the large, private lot.		
<b>REQUIRED ITEMS</b>		
<input checked="" type="checkbox"/> <b>Copy of plat or survey of subject property.</b> <input checked="" type="checkbox"/> <b>If the application is for a variance, attach a detailed drawing of a plot plan showing location of the area of the property that will be affected by this request.</b> <input checked="" type="checkbox"/> <b>Include a letter describing in detail the reason(s) for the request and describe the hardship on which the request is based.</b> <input checked="" type="checkbox"/> <b>Appropriate check list completed and signed.</b> <input checked="" type="checkbox"/> <b>If application is for an appeal, state in the explanation of request above the decision of the city official and/or application/permit denial that is being appealed. Please include a copy of any applications and written correspondence from the City official that you may have.</b> <input checked="" type="checkbox"/> <b>All filing fees, and related fees must be paid before the request will be put on an agenda.</b> <input checked="" type="checkbox"/> <b>Application must be signed by all legal owners of the subject property or by the legally authorized agent for the property owner(s).</b> <input checked="" type="checkbox"/> <b>Application fee \$825.00</b>		
<b>APPLICANTS SIGNATURE</b>		
 Applicants signature	Csaba Kos & Seon Mee Chang Printed name	Dec 3, 2025 Date

<b>FOR CITY USE ONLY</b>		
<b>Reviewed and accepted for filing by:</b>		
<b>Name:</b> _____	<b>Title:</b> _____	<b>Date:</b> _____
<b>Meeting date:</b> _____	<b>\$825.00 Application fee paid <input type="checkbox"/></b>	
<b>Action from meeting:</b> _____		

# City of Jonestown

## VARIANCE CHECKLIST

YES <input checked="" type="checkbox"/>	NO <input type="checkbox"/>	Is the request for a variance owing to special conditions inherent in the property itself? Example: The property has an odd shape, large trees would have to be cut to meet building requirements, hill, bluff, or creek reduces building area of the lot
YES <input checked="" type="checkbox"/>	NO <input type="checkbox"/>	Is the condition unique to this property?
YES <input type="checkbox"/>	NO <input checked="" type="checkbox"/>	Is this condition self-imposed or self-created?
YES <input checked="" type="checkbox"/>	NO <input type="checkbox"/>	Will literal enforcement of the zoning ordinance result in unnecessary hardship? Example: Protected trees would have to be removed, minimum square footage could not be met due to terrain or shape of the lot.
YES <input type="checkbox"/>	NO <input checked="" type="checkbox"/>	Will the hardship prevent any reasonable use of the property without a variance? Without the variance the property owner would be denied the use of the property.
YES <input type="checkbox"/>	NO <input checked="" type="checkbox"/>	Would the granting of the variance be contrary to the public interest, or have an adverse effect on the surrounding property?
YES <input checked="" type="checkbox"/>	NO <input type="checkbox"/>	Is the request within the spirit of the zoning ordinance?

Comments: \_\_\_\_\_  
 \_\_\_\_\_  
 \_\_\_\_\_  
 \_\_\_\_\_  
 \_\_\_\_\_

### FOR CITY USE ONLY

The variance request has been reviewed for compliance using the checklist and is

APPROVED FOR PROCESSING

REJECTED FOR NON-QUALIFYING

Reviewed by \_\_\_\_\_ Title \_\_\_\_\_ Date \_\_\_\_\_

The Honorable Chair and Members of the Board of Adjustment and Appeals  
City of Jonestown  
18649 FM 1431, Suite 1A  
Jonestown, TX 78645

**RE: Letter of Justification for a Special Exception Request for an Architectural Carport  
at 17363 E Reed Parks Rd, Jonestown, TX**

Dear Chair and Members of the Board,

As owners of the property at 17363 E Reed Parks Rd, we respectfully request a Special Exception from the residential parking requirements to permit an architecturally integrated carport in lieu of an enclosed garage. This request is made pursuant to the authority granted to the Board in the Code of Ordinances, Chapter 1, Section 1.05.086(b), which allows for exceptions in cases of unreasonable hardship due to a building's unique character and a lot's specific conditions.

We respect that the garage requirement serves an important purpose for most properties, typically to maintain neighborhood aesthetics and prevent street congestion. However, our property's unique conditions—its substantial 5-acre size, the privacy it affords, and a home site with significant setbacks from the road—render those concerns inapplicable in this case. This unique combination, along with its Hill Country topography and the home's specific architectural character, presents precisely the type of special condition the ordinance was designed to accommodate. Our project, designed by the nationally acclaimed firm Alterstudio and built by Abode Modern Homes, a six-time recipient of Austin Home Magazine's "Builder of the Year" award, is intended to be a benchmark for high-quality, site-sensitive development that aligns with the city's long-term vision.

Our request is based on the following points of hardship:

- 1. Architectural & Topographical Hardship:** The core design principle of our home is its integration with the landscape. The architectural concept, from a firm with over 200 design awards, is predicated on transparency to preserve the visual continuity of the Hill Country terrain. A mandated enclosed garage, with its solid walls and greater visual mass, would create an opaque barrier, functionally severing the home from the very landscape it was designed to honor. The hardship is the imposition of a feature that is visually incongruous with the site's natural character and fundamentally compromises the architectural integrity of the design.
- 2. Conflict with the City's Vision:** The most significant hardship is the conflict between a prescriptive ordinance and the opportunity to create a landmark home that embodies Jonestown's own values. The Jonestown Comprehensive Plan's (<https://ecode360.com/JO6363/document/753001707.pdf>, Ordinance no. 2023-O-638) vision is to "Preserve the Hill Country scenery and natural topography". Our proposed design, with its site-sensitive carport, is demonstrably more aligned with this vision than

a conventional garage. Forcing a standard garage would compel a design that is less in keeping with the character the city officially seeks to preserve, creating a hardship of lost opportunity for both our family and the community.

This request is not based on financial cost, construction ease, or personal convenience. Building a carport to the high architectural standards of Alterstudio is not a cost-saving measure. We are choosing the more difficult design path because it is the only way to maintain the integrity of the site.

Granting this exception would resolve a demonstrable hardship and allow for the creation of a home that thoughtfully contributes to the community by exemplifying the principles of high-quality, site-sensitive design outlined in the Comprehensive Plan.

We believe our project fully satisfies the criteria for a special exception and represents an opportunity to add a beautiful and respectful home to Jonestown. Thank you for your time and consideration. We look forward to presenting our project to you in person.

Sincerely,

Csaba Kos and Seon Mee Chang  
17363 E Reed Parks Rd  
Jonestown, TX 78645



2015 IRC  
2015 IECC

# City of Jonestown

18649 FM 1431, 1A  
Jonestown, Texas 78645  
Phone: (512) 267-0359 ◊ Fax: (512) 267-1712  
Web: jonestown.org

## PLAN REVIEW

### 17363 E. Reed Park Road

Address:

Richard White

1/30/2024

Permit Applicant:

Date:

Subdivision:

Section:

Phase:

Block:

Lot:

New Residence

R3

V-B

Project:

Zoning:

Group:

Construction Type:

2024-1036

Permit:

## REVIEW – CONDITIONALLY APPROVED

### Documentation Submitted

Document	Document Date	A/E/S Seal	Registration #
Site Plan	1/26/2024	RA	17761
Foundation	12/15/2023	PE	99208
Structural Framing	12/15/2023	PE	99208
Wind Brace Plan	12/15/2023	PE	99208
Building Design	12/15/2023	RA	17761
Roof Plan	12/15/2023	RA	17761
Electrical Plans	1/26/2024	RA	17761
Manual J/S/D	5/15/2023		
Energy Conservation	4/26/2023		

## Comments

	A site plan was submitted. It is the responsibility of the builder to ensure that building setbacks and easements are observed. A form check survey by a licensed professional surveyor is required prior to concrete placement.
	The builder is to ensure that the final drainage flows away from structure per IRC. <b>Inspector will site verify code compliance of drainage.</b>
	The builder is to ensure compliance with all City of Jonestown adopted Ordinances.
IRC R322.2	Buildings and structures constructed in whole or in part in a flood hazard area shall be designed and constructed in accordance with Sections R322.2.1 through R322.2.3. Owner/builder is responsible to apply with governing flood authority for development permit. Elevation certificate may be required.
IRC Chpt. 11 IECC 2015	Please ensure values assumed in energy compliance calculations are incorporated into home construction. Be advised proposed U values and shading coefficients for windows and glass doors will be site verified.
IRC E3902.16	All kitchens, family rooms, dining rooms, living rooms, parlors, libraries, dens, bedrooms, sunrooms, rec rooms, closets, hallways, laundry areas and similar rooms or areas shall be protected with Arc-Fault Circuit-interruption per this section.
IRC E3901.12	A 125-volt, single phase, 15- or 20-ampere-rated receptacle outlet shall be installed at an accessible location on the same level and within 25 ft. for the servicing of heating, A/C and refrigeration equipment. <b>Inspector will site verify.</b>
IRC R315	A carbon monoxide alarm is required to be installed outside of each separate sleeping area in dwellings which have fuel-fired appliances or attached garages. <b>Inspector will site-verify.</b>
IRC Table R302.6	All habitable rooms above the garage shall be separated by not less than 5/8-inch Type X gypsum board or equivalent. <b>Inspector will site verify.</b>

IRC R308.4	Tempered glass is required in all glazing in a hazardous location in accordance with this section. <b>Inspector will site verify.</b>
IRC R311.7	All stairs, landings, and handrails shall be in accordance with the IRC. <b>Inspector will site-verify</b>
IRC R502.11.1	A floor truss system is indicated, provide truss plans to Inspector. Wood trusses shall be designed in accordance with approved engineering practice. The design and manufacture of metal-plate-connected wood trusses shall comply with ANSI/TPI 1. <b>City Inspector may request additional information at the time of inspection.</b>
IRC R703.4	Approved corrosion-resistant flashing shall be provided in the exterior wall envelope in such a manner as to prevent entry of water into the wall cavity or penetration of water to the building structural framing components. <b>Inspector will site verify.</b>
IRC P3008.1	Sewage backflow. All structures connected to the City sewer system shall be protected by an approved backwater valve, installed in the building drain. Plumbing fixtures installed above one story shall not discharge through a backwater valve. <b>Inspector will site verify.</b>
IRC R106.1	Contractor shall stop work if damage to structural members is noticed. Inform City of Jonestown of damage and schedule an inspection.

## **INSPECTIONS REQUIRED**

### **House**

1. Temporary Meter Loop Inspection
2. Water / Sewer Yard-Lines Inspection
3. Plumbing Rough-In / Foundation Layout Inspection
4. Under Slab Water Distribution Piping Inspection
5. UFER Inspection (*unless using ground rods*)
6. Foundation Pre-pour Inspection
7. \*\*1
8. Sheathing Inspection
9. Weather Resistant Barrier Inspection
10. Stucco/Lath Inspection
11. Frame, Mechanical, Electrical Rough-in & Plumbing Top-out
12. Insulation / Energy Inspection \*\*2
13. Wallboard Inspection
14. Electrical Meter Connection Inspection
15. Final Inspection (Building, Mechanical, Electrical, Plumbing & Final Energy)

### **\*\* Additional Inspections to be performed by others.**

\*\*1. Foundation Pre-pour Inspection by Design Engineer. **Certification letter from design engineer to be delivered to the City of Jonestown prior to issuance of CO.**

\*\*2. 2018 IECC Compliance Inspection (Duct Leakage & Blower Door Test). **Passing report from third-party HERS rater to be delivered to City of Jonestown prior to issuance of CO.** The following link identifies accredited third-party providers for the State of Texas after choosing Texas in the dropdown menu:  
[http://www.resnet.us/professional/programs/search\\_directory](http://www.resnet.us/professional/programs/search_directory)

**To schedule City inspections, please log on to [www.mypermitnow.gov](http://www.mypermitnow.gov).**

**Plans must be on-site when inspections are being performed.**

**REVIEWED BY: Jaime Lanka, ATS Engineers, (737) 346-8246, [jaime\\_lanka@ats-engineers.com](mailto:jaime_lanka@ats-engineers.com)**

### **Plan Review Limitations**

*This plan review describes observations made by ATS in consideration of the referenced codes and does not include recommendations for remedial actions. No independent design or engineering analyses of the architectural, fire protection, structural, mechanical, electrical, plumbing or energy systems has been performed to verify the suitability or performance of the proposed systems, features and components. This review does not include Dark Sky, Fire, Health, Irrigation, Landscape, Parking, Signage, Technology or Zoning.*

*ATS makes no warranties or guarantees, either expressed or implied, that all items of a deficient nature and/or improper construction techniques, etc. have been discovered and commented upon in this plan review. This plan review has been prepared to identify the current code deficiencies observed and should not be considered an exhaustive description of every item that may require correction and/or clarification.*

*Review and acceptance of these plans for construction does not alleviate the responsibility of the design professional(s) and contractor(s) to comply with the code in its entirety. Field verification must also be completed to ensure compliance with jurisdiction-adopted code(s), ordinances and requirements of other authorities having jurisdiction. ATS has been engaged as a "Building Official" with regard to providing plan review services and inspections and has proceeded as such with the express understanding that the provisions of IBC Section 104 govern its limitations of liability.*

P.O. Box 220 S-204P, Austin, TX 78767  
(512) 473-3216 or 1-800-776-5272, Ext. 3216  
Fax (512) 473-3501



2643 N. Wirtz Dam Road, Marble Falls, TX 78654  
(512) 473-3216 or 1-800-776-5272, Ext. 3216  
Fax (830) 693-6242

Lower Colorado River Authority

## LCRA ON-SITE SEWAGE FACILITIES PROGRAM FLOODPLAIN COMPLIANCE ACKNOWLEDGEMENT

LCRA's On-Site Sewage Facilities (OSSF) Rules require applicant to document compliance with applicable flood damage prevention regulations or documentation that such regulations are not applicable to this property.

This documentation must be submitted along with the application for an on-site sewage facilities construction permit to be issued by LCRA. Please complete this form to fulfill the documentation for your property.

### This is to verify that

Property owner Csava Kos  
Site address 17363 E Reed Parks Rd  
Legal description of property ABS 325 SUR 603 GREGG J & ABS 2536 SUR 104 CARLTON J F ACR 5.338  
City (if applicable) Jonestown  
County Travis  
Development Permit Number \_\_\_\_\_

This documentation is verification that the applicant has complied with flood damage prevention regulations as described within the National Flood Insurance Act of 1968, 82 Stat. 572, 42 U.S.C.A.

C. Jolley  
Floodplain Administrator


11/15/23  
Date

<u>City of Jonestown Tx</u> (Name of permitting authority)	(Permitting authority will check applicable notes)
<input checked="" type="checkbox"/> No development shall occur until a <u>Jonestown</u> (Name of permitting authority) permit has been issued and posted.	
<input type="checkbox"/> To remain in compliance a completed elevation certificate must be returned to within _____ days of completion of the 1 <sup>st</sup> floor. (Name of permitting authority)	
<input type="checkbox"/> Replacement of OSSF only.	
<input checked="" type="checkbox"/> By law, the minimum finished floor elevation (FFE) of any habitable structure on Lake Travis must be at least one foot above the Federal Emergency Management Agency (FEMA) floodplain of 722 feet above mean sea level (msl) all new habitable structures must have a FFE of at least 723.	

# National Flood Hazard Layer FIRMette



97°55'54"W 30°28'59"N

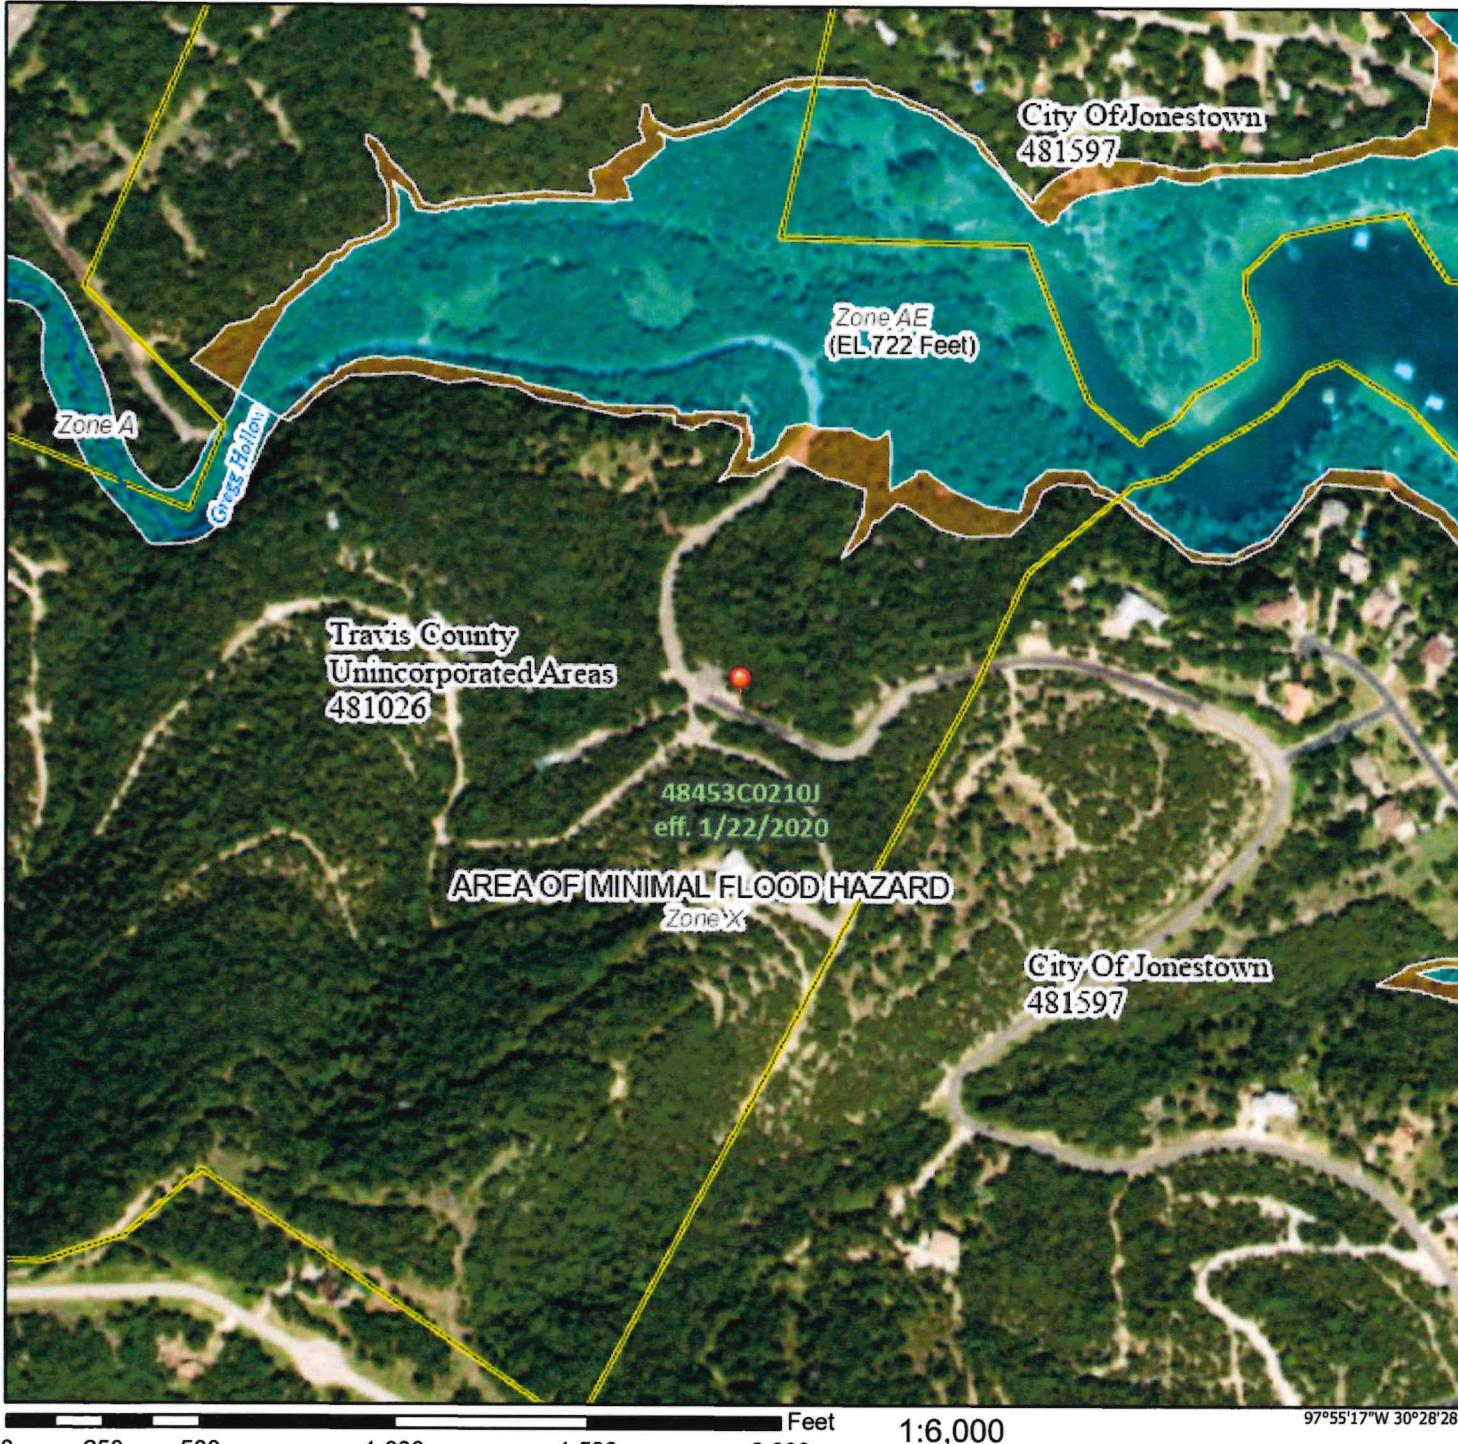

## Legend

SEE FIS REPORT FOR DETAILED LEGEND AND INDEX MAP FOR FIRM PANEL LAYOUT

Without Base Flood Elevation (BFE)  
Zone A, V, A99  
With BFE or Depth Zone AE, AO, AH, VE, AR  
Regulatory Floodway

### SPECIAL FLOOD HAZARD AREAS

0.2% Annual Chance Flood Hazard, Area of 1% annual chance flood with average depth less than one foot or with drainage areas of less than one square mile Zone .

Future Conditions 1% Annual Chance Flood Hazard Zone X

Area with Reduced Flood Risk due to Levee. See Notes. Zone X

Area with Flood Risk due to Levee Zone D

### OTHER AREAS OF FLOOD HAZARD

NO SCREEN Area of Minimal Flood Hazard Zone X

Effective LOMRs

Area of Undetermined Flood Hazard Zone

### OTHER AREAS

— Channel, Culvert, or Storm Sewer

||||| Levee, Dike, or Floodwall

20.2 Cross Sections with 1% Annual Chance

17.5 Water Surface Elevation

— Coastal Transect

~~~~~ Base Flood Elevation Line (BFE)

— Limit of Study

— Jurisdiction Boundary

— Coastal Transect Baseline

— Profile Baseline

— Hydrographic Feature

### OTHER FEATURES

Digital Data Available

No Digital Data Available

Unmapped



The pin displayed on the map is an approximate point selected by the user and does not represent an authoritative property location.


This map complies with FEMA's standards for the use of digital flood maps if it is not void as described below. The basemap shown complies with FEMA's basemap accuracy standards

The flood hazard information is derived directly from the authoritative NFHL web services provided by FEMA. This map was exported on 11/15/2023 at 5:06 PM and does not reflect changes or amendments subsequent to this date and time. The NFHL and effective information may change or become superseded by new data over time.

This map image is void if the one or more of the following map elements do not appear: basemap imagery, flood zone labels, legend, scale bar, map creation date, community identifiers, FIRM panel number, and FIRM effective date. Map images for unmapped and unmodernized areas cannot be used for regulatory purposes.





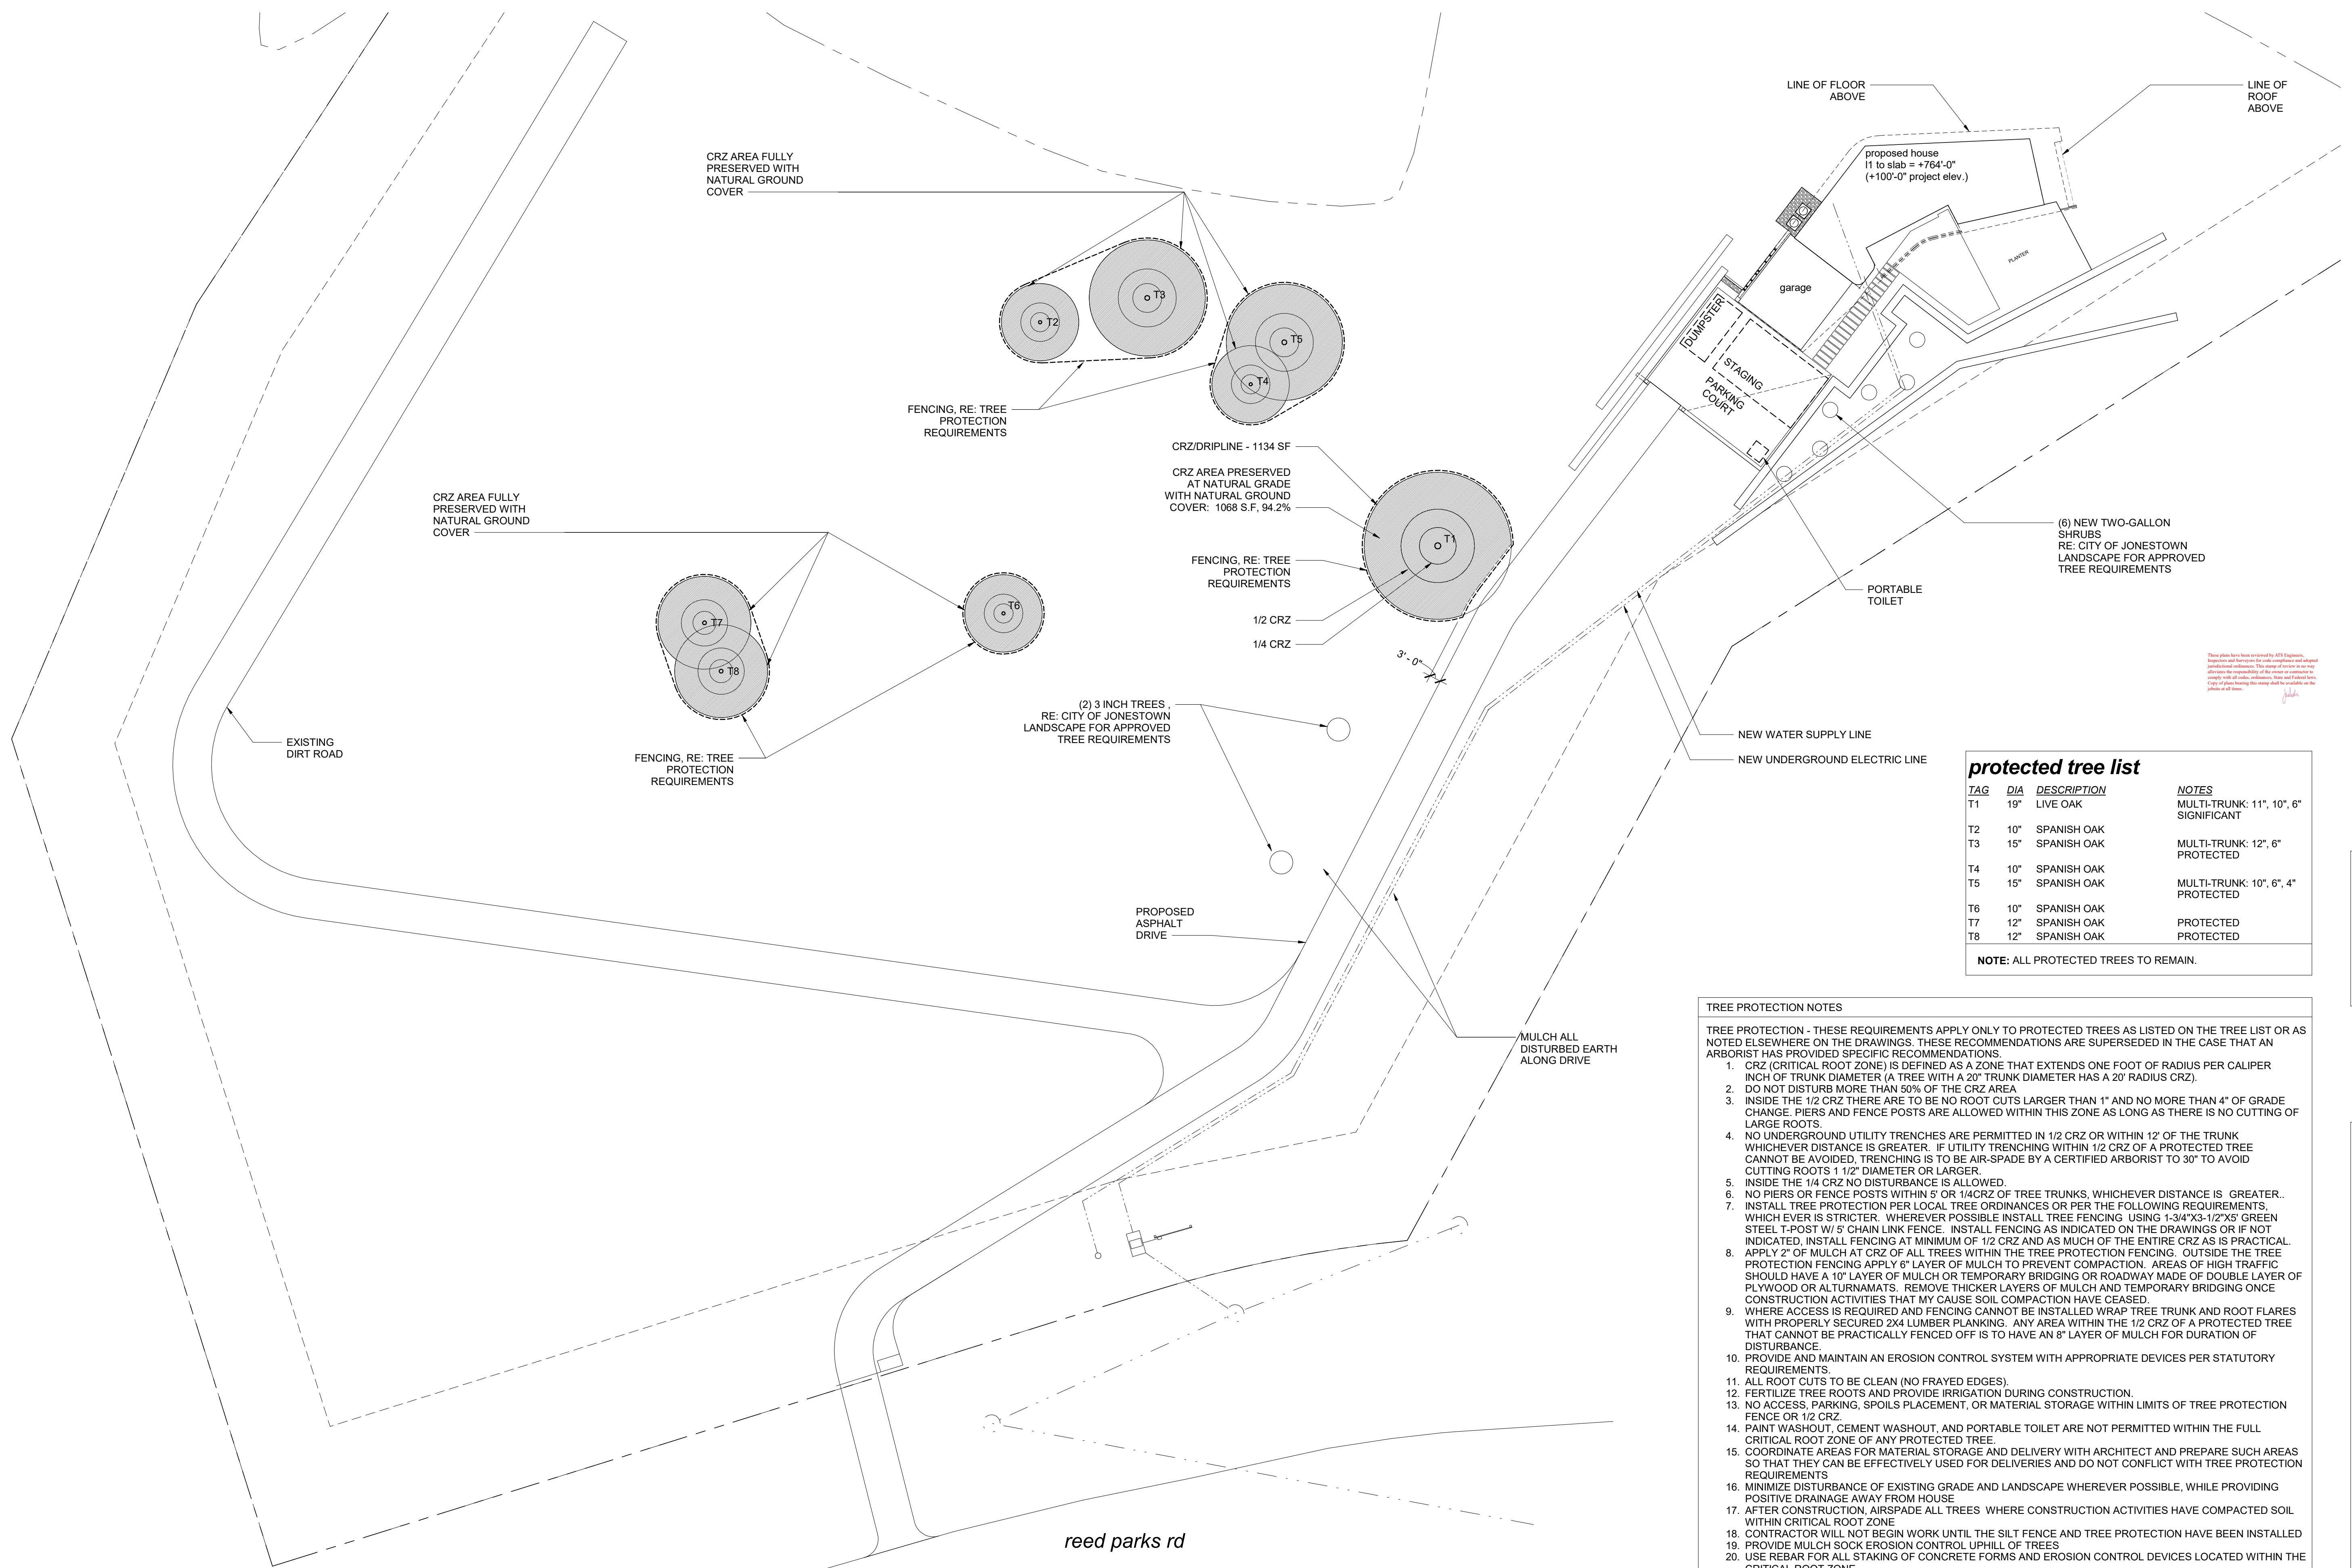

#### protected tree list

| TAG | DIA | DESCRIPTION | NOTES                                 |
|-----|-----|-------------|---------------------------------------|
| T1  | 19" | LIVE OAK    | MULTI-TRUNK: 11", 10", 6" SIGNIFICANT |
| T2  | 10" | SPANISH OAK |                                       |
| T3  | 15" | SPANISH OAK | MULTI-TRUNK: 12", 6" PROTECTED        |
| T4  | 10" | SPANISH OAK |                                       |
| T5  | 15" | SPANISH OAK | MULTI-TRUNK: 10", 6", 4" PROTECTED    |
| T6  | 10" | SPANISH OAK |                                       |
| T7  | 12" | SPANISH OAK | PROTECTED                             |
| T8  | 12" | SPANISH OAK | PROTECTED                             |

NOTE: ALL PROTECTED TREES TO REMAIN.


#### TREE PROTECTION NOTES

TREE PROTECTION - THESE REQUIREMENTS APPLY ONLY TO PROTECTED TREES AS LISTED ON THE TREE LIST OR AS NOTED ELSEWHERE ON THE DRAWINGS. THESE RECOMMENDATIONS ARE SUPERSEDED IN THE CASE THAT AN ARBORIST HAS SPECIFIC REQUIREMENTS.

- CRITICAL ROOT ZONE IS DEFINED AS A ZONE THAT EXTENDS ONE FOOT OF RADIUS PER CALIPER INCH OF TRUNK DIAMETER (A TREE WITH A 20" TRUNK DIAMETER HAS A 20' RADIUS CRZ).
- DO NOT DISTURB MORE THAN 50% OF THE CRZ AREA.
- INSIDE THE 1/2 CRZ THERE ARE TO BE NO ROOT CUTS LARGER THAN 1" AND NO MORE THAN 4" OF GRADE CHANGE. PIERS AND FENCE POSTS ARE ALLOWED WITHIN THIS ZONE AS LONG AS THERE IS NO CUTTING OF LARGE ROOTS.
- NO UNDERGROUND UTILITY TRENCHES ARE PERMITTED IN 1/2 CRZ OR WITHIN 12' OF THE TRUNK WHICHEVER DISTANCE IS GREATER. IF UTILITY TRENCHING WITHIN 1/2 CRZ OF A PROTECTED TREE CANNOT BE AVOIDED, TRENCHING IS TO BE AIR-SPADE BY A CERTIFIED ARBORIST TO 30" TO AVOID CUTTING ROOTS 1/2" DIAMETER OR LARGER.
- INSIDE THE 1/4 CRZ NO DISTURBANCE IS ALLOWED.
- NO PIER OR FENCE POSTS ARE ALLOWED IN 1/4 CRZ OF TREE TRUNKS. WHICHEVER DISTANCE IS GREATER, INSTALL THE PIER OR FENCE POSTS IN PER LOCATED UTILITIES ORDER THE TRENCHING REQUIREMENTS.
- WHEN EVER IS STRICTLY NECESSARY, WHEREVER POSSIBLE INSTALL TREE FENCING USING 4'-0"X3'-0"X2"-0" GREEN STEEL P-POST W/5' CHAIN LINK FENCE. INSTALL FENCING AS INDICATED ON THE DRAWINGS OR IF NOT INDICATED, INSTALL FENCING AT MINIMUM OF 1/2 CRZ AND AS MUCH OF THE ENTIRE CRZ AS IS PRACTICAL.
- APPLY 2" OF MULCH AT CRZ OF ALL TREES WITHIN THE TREE PROTECTION FENCING. OUTSIDE THE TREE PROTECTION FENCING APPLY 6" LAYER OF MULCH TO PREVENT COMPACTION. AREAS OF HIGH TRAFFIC SHOULD HAVE A 10" LAYER OF MULCH OR TEMPORARY BRIDGING OR ROADWAY MADE OF DOUBLE LAYER OF PLYWOOD OR ALTRUMATAMS. REMOVE THICKER LAYERS OF MULCH AND TEMPORARY BRIDGING ONCE CONSTRUCTION ACTIVITIES THAT MAY CAUSE SOIL COMPACTION HAVE CEASED.
- WHERE ACCESS IS REQUIRED AND FENCING CANNOT BE INSTALLED WRAP TREE TRUNK AND ROOT FLARES WITH PROPERLY SECURE 2X4 LUMBER PLANKING. ANY AREA WITHIN THE 1/2 CRZ OF A PROTECTED TREE THAT CANNOT BE PRACTICALLY FENCED OFF IS TO HAVE AN 8" LAYER OF MULCH FOR DURATION OF DISRUPTION.
- PROVIDE AND MAINTAIN AN EROSION CONTROL SYSTEM WITH APPROPRIATE DEVICES PER STATUTORY REQUIREMENTS.
- ALL ROOT CUTS TO BE CLEAN (NO FRAYED EDGES).
- FERTILIZE TREE ROOTS AND PROVIDE IRRIGATION DURING CONSTRUCTION.
- NO ACCESS, PARKING, SPOILS PLACEMENT, OR MATERIAL STORAGE WITHIN LIMITS OF TREE PROTECTION FENCE OR 1/2 CRZ.
- PAINT WASHOUT, CEMENT WASHOUT, AND PORTABLE TOILET ARE NOT PERMITTED WITHIN THE FULL CRITICAL ROOT ZONE OF ANY PROTECTED TREE.
- COORDINATE AREAS FOR MATERIAL STORAGE AND DELIVERY WITH ARCHITECT AND PREPARE SUCH AREAS SO THAT THEY CAN BE EFFECTIVELY USED FOR DELIVERIES AND DO NOT CONFLICT WITH TREE PROTECTION REQUIREMENTS.
- MINIMIZE DISTURBANCE OF EXISTING GRADE AND LANDSCAPE WHEREVER POSSIBLE, WHILE PROVIDING CONCRETE EASEMENT AWAY FROM HOUSE.
- AFTER CONSTRUCTION, AIRSPADE ALL TREES WHERE CONSTRUCTION ACTIVITIES HAVE COMPACTED SOIL WITHIN CRITICAL ROOT ZONE.
- CONTRACTOR WILL NOT BEGIN WORK UNTIL THE SILT FENCE AND TREE PROTECTION HAVE BEEN INSTALLED.
- PROVIDE MULCH SOCK EROSION CONTROL UPHILL OF TREES.
- USE REBAR FOR ALL STAKING OF CONCRETE FORMS AND EROSION CONTROL DEVICES LOCATED WITHIN THE CRITICAL ROOT ZONE.

**kos**  
**residence**

17363 E Reed Parks Rd.  
Jonestown, Texas 78645

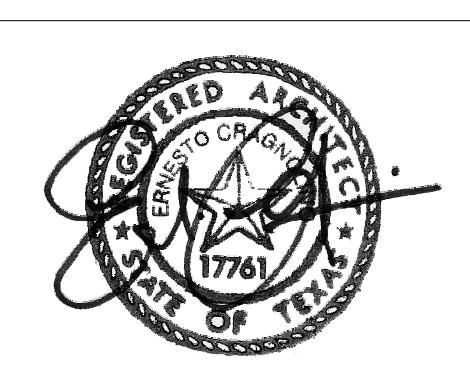

**alterstudio**  
architecture LLP


1801 lavaca st #106  
austin, texas 78701  
512 499 8007



BUILDING PERMIT 12.15.2023

Scale: As indicated  
HALF OF DRAWING WHEN PRINTED ON 12X18.  
DO NOT SCALE DRAWINGS.  
CONTACT ARCHITECT IN CASE OF DISCREPANCIES.  
THIS SHEET IS ONLY ONE COMPONENT OF THE  
TOTAL DRAWINGS WHICH CONSISTS OF  
ALL DRAWINGS AND SPECIFICATIONS.

**landscape and  
tree protection**

**A0.30**

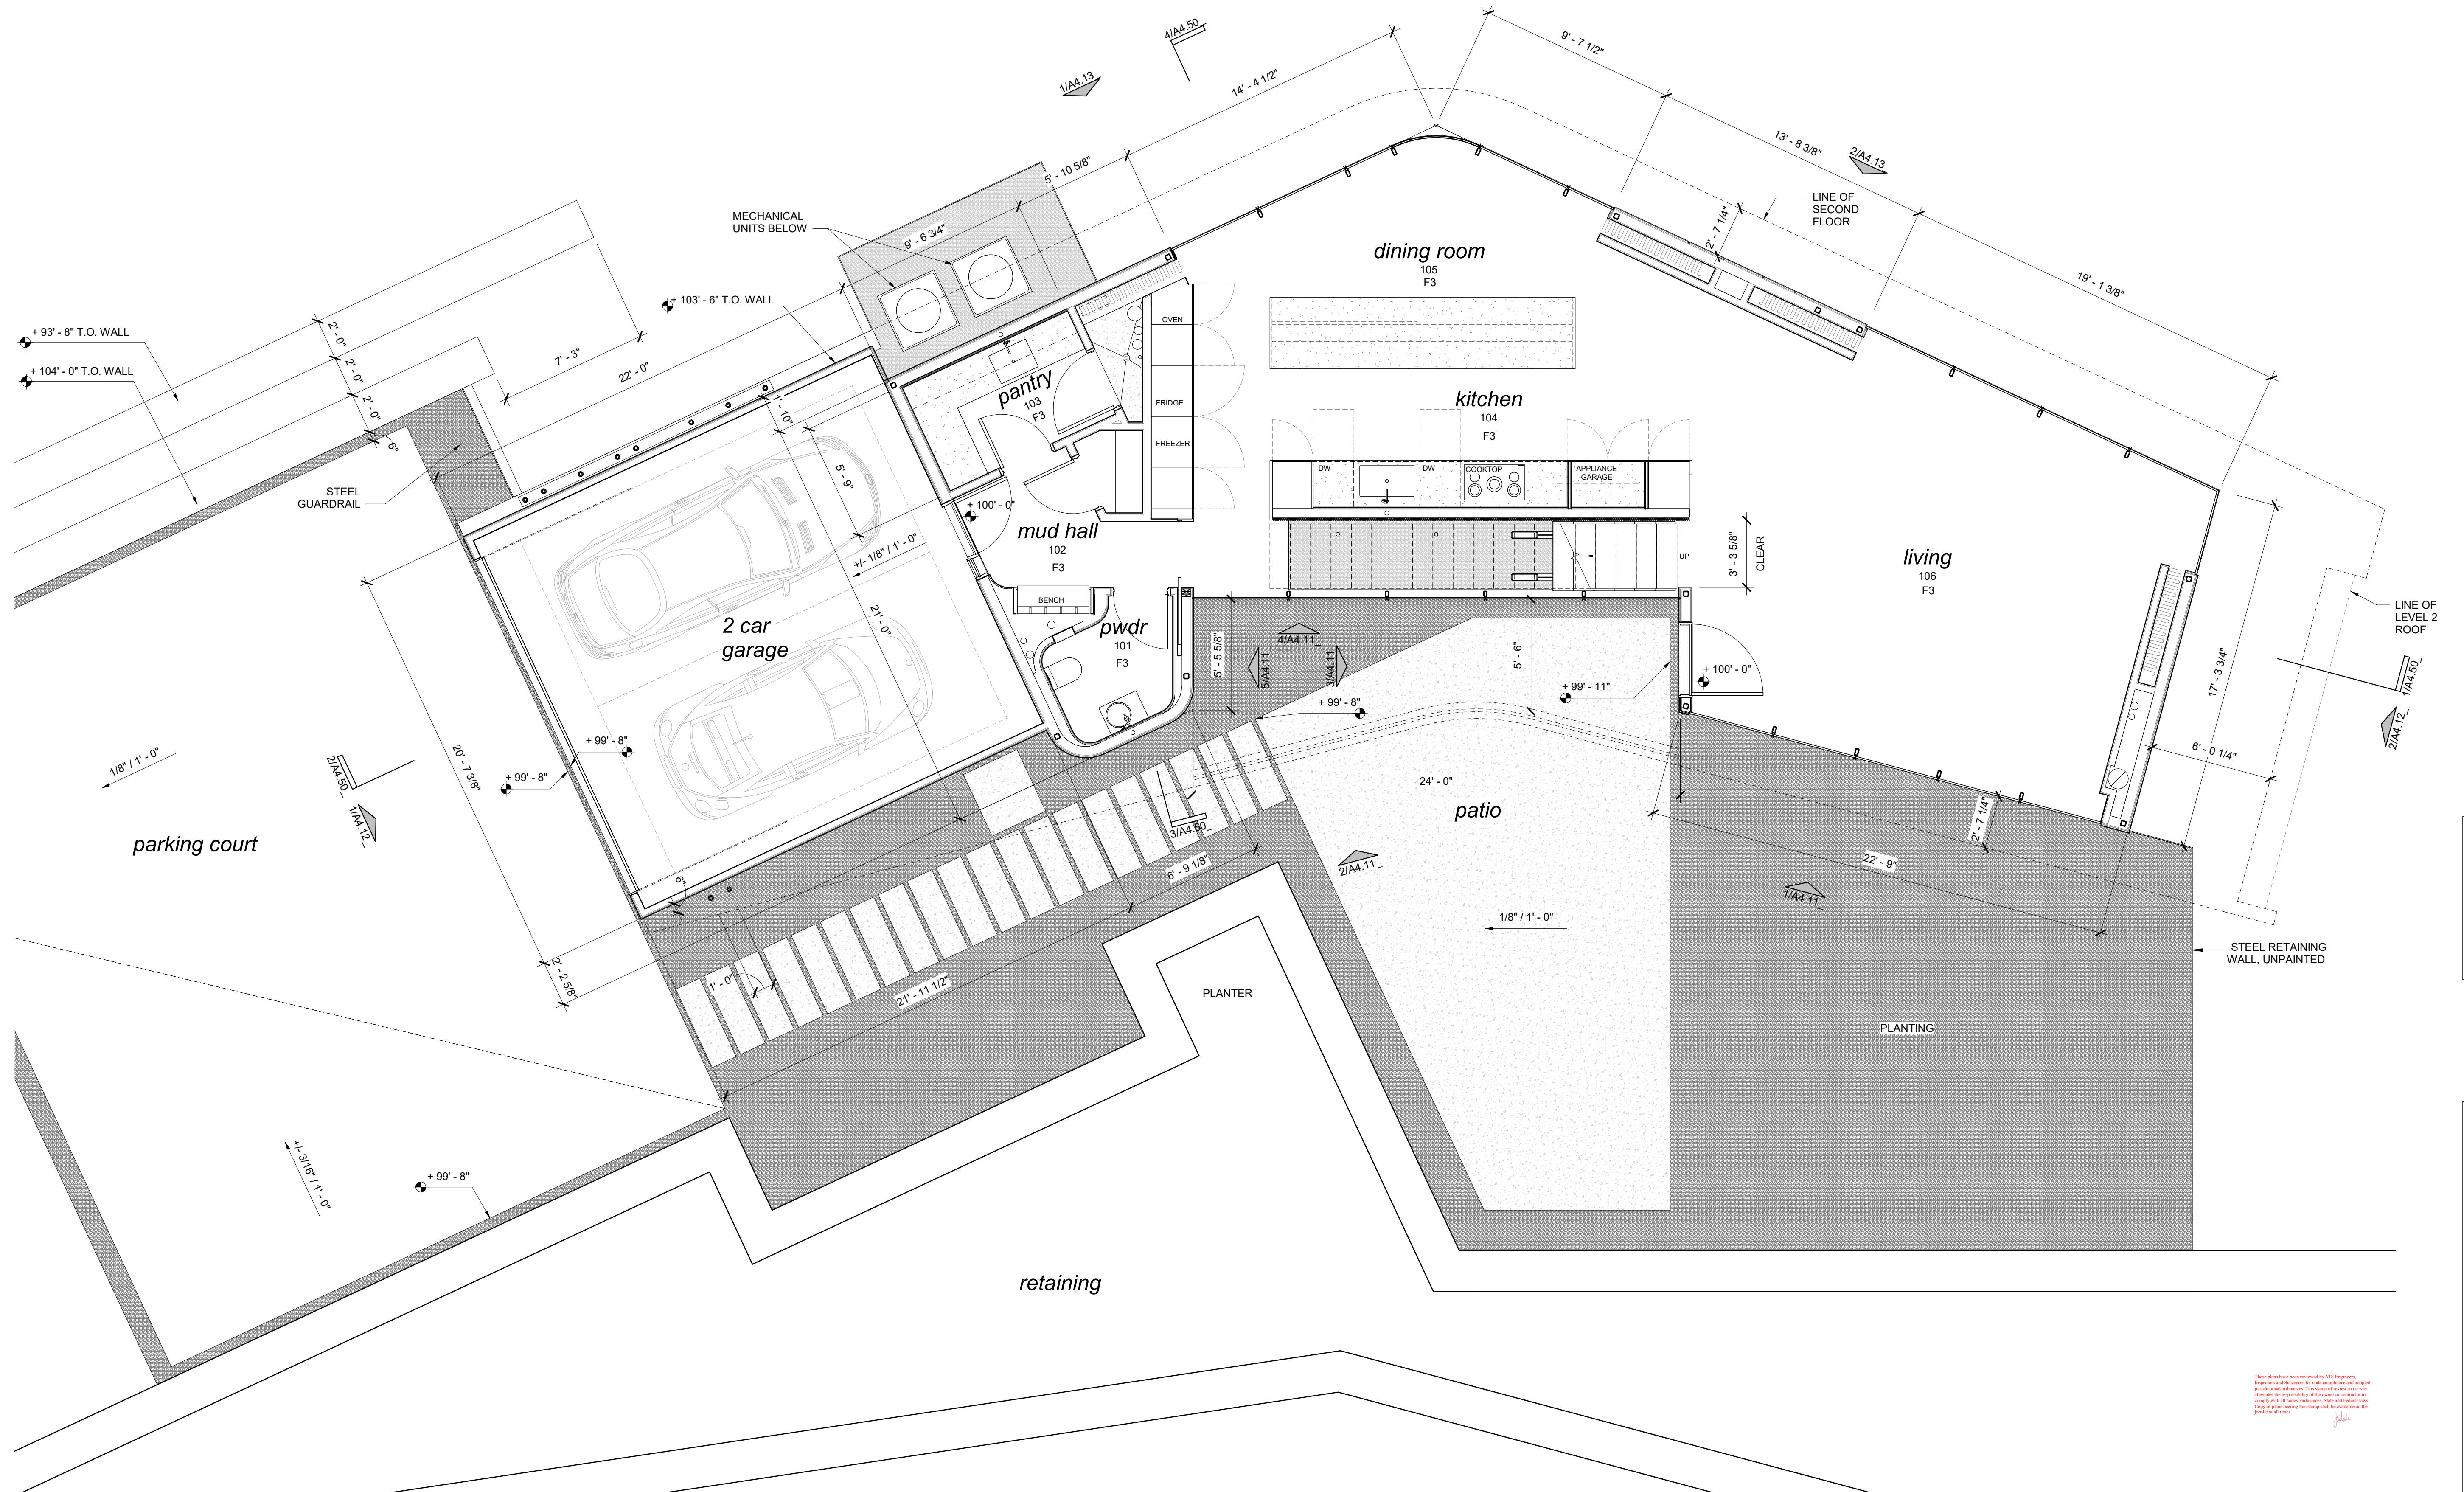

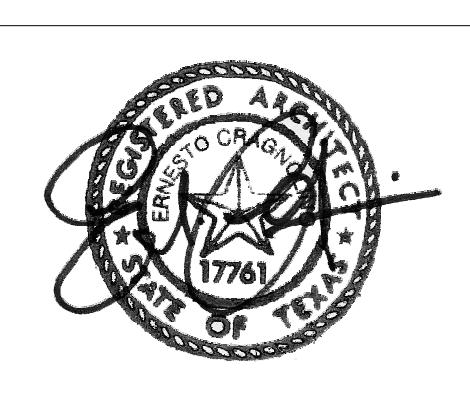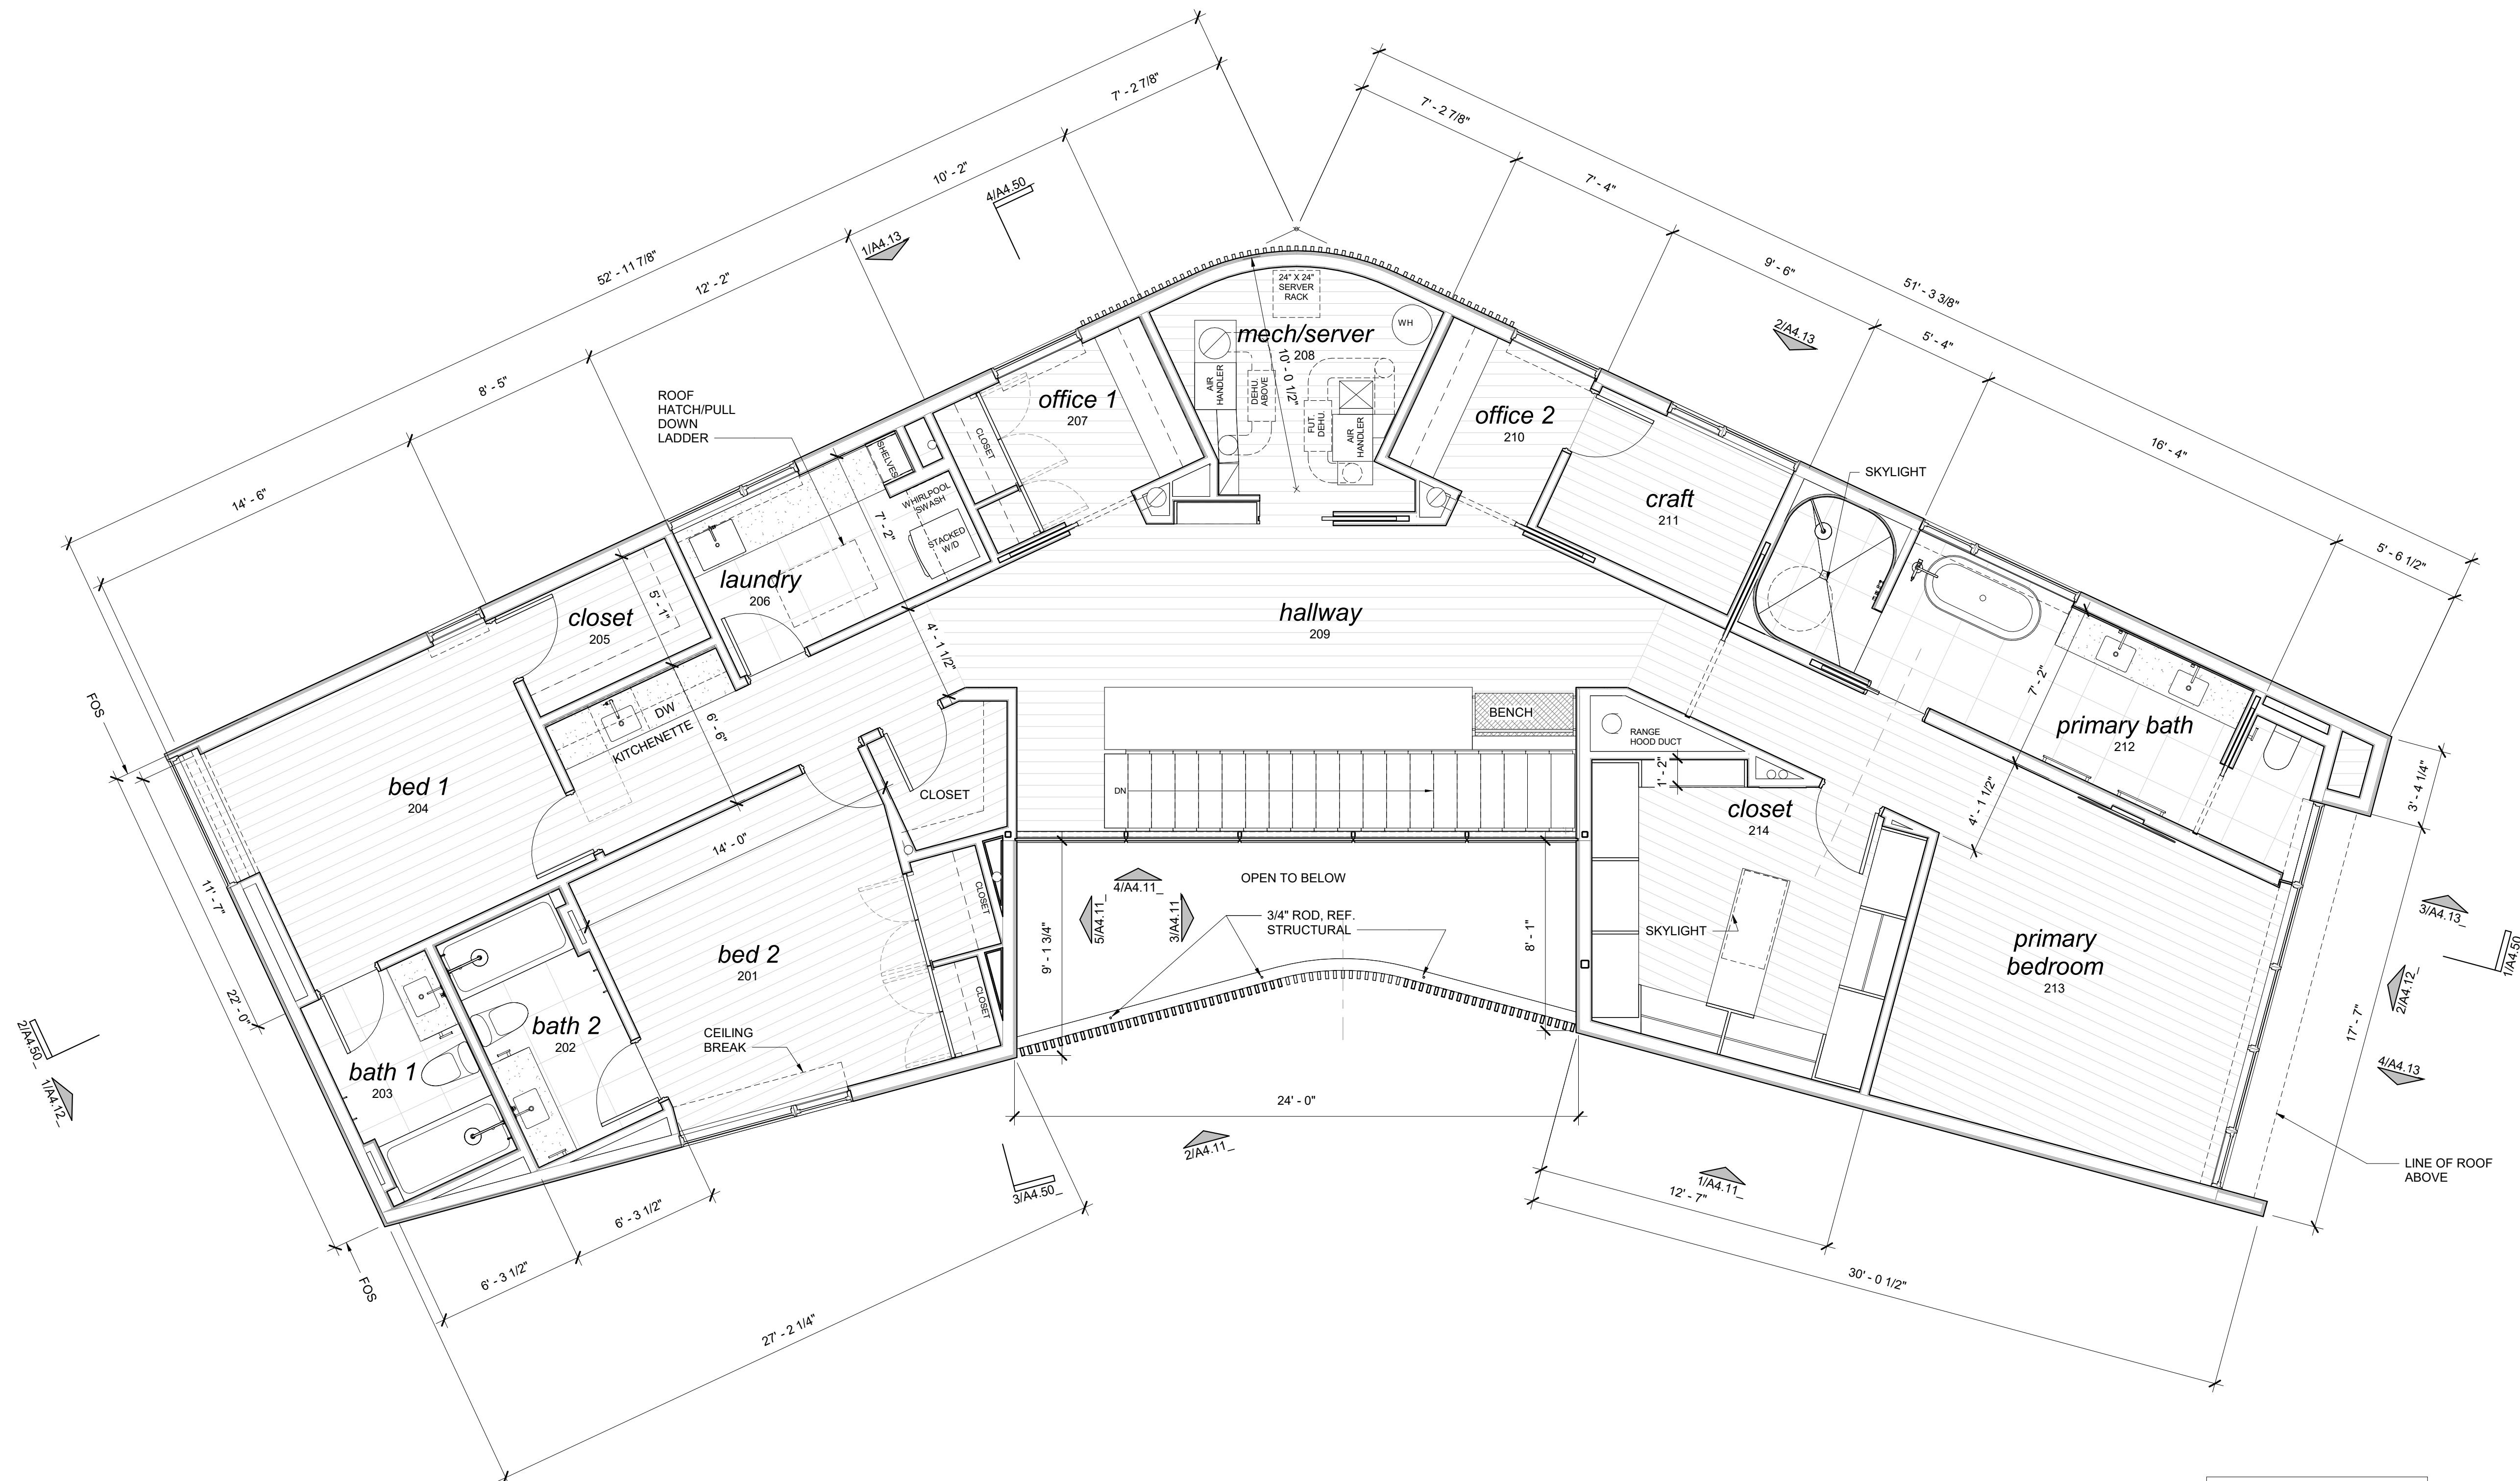

alterstudio  
architecture LLP

1801 lavaca st #106  
austin, texas 78701  
512 499 8007


DD PRICING SET 06.16.2023  
SEPTIC PERMIT 08.11.2023  
BUILDING PERMIT 12.15.2023

HALF OF UNITS SCALE WHEN PRINTED ON 12X18.  
DO NOT SCALE DRAWINGS.  
CONTACT ARCHITECT IN CASE OF DISCREPANCIES.  
THIS SHEET IS ONLY ONE COMPONENT OF THE  
TOTAL DESIGN. SEE OTHER SHEETS FOR  
ALL DRAWINGS AND SPECIFICATIONS.

level 2 floor plan

A2.21

These plans have been reviewed by ATS Engineers and have been found to be code compliant as of the date of review. The plans are subject to change if any changes are made to the plans or if any changes are made to the building code. The plans are not to be used for construction unless they are in accordance with all codes, ordinances, State and Federal laws, and regulations. The plans are to be used only for the purpose for which they were intended and the plans shall not be reproduced in whole or in part.

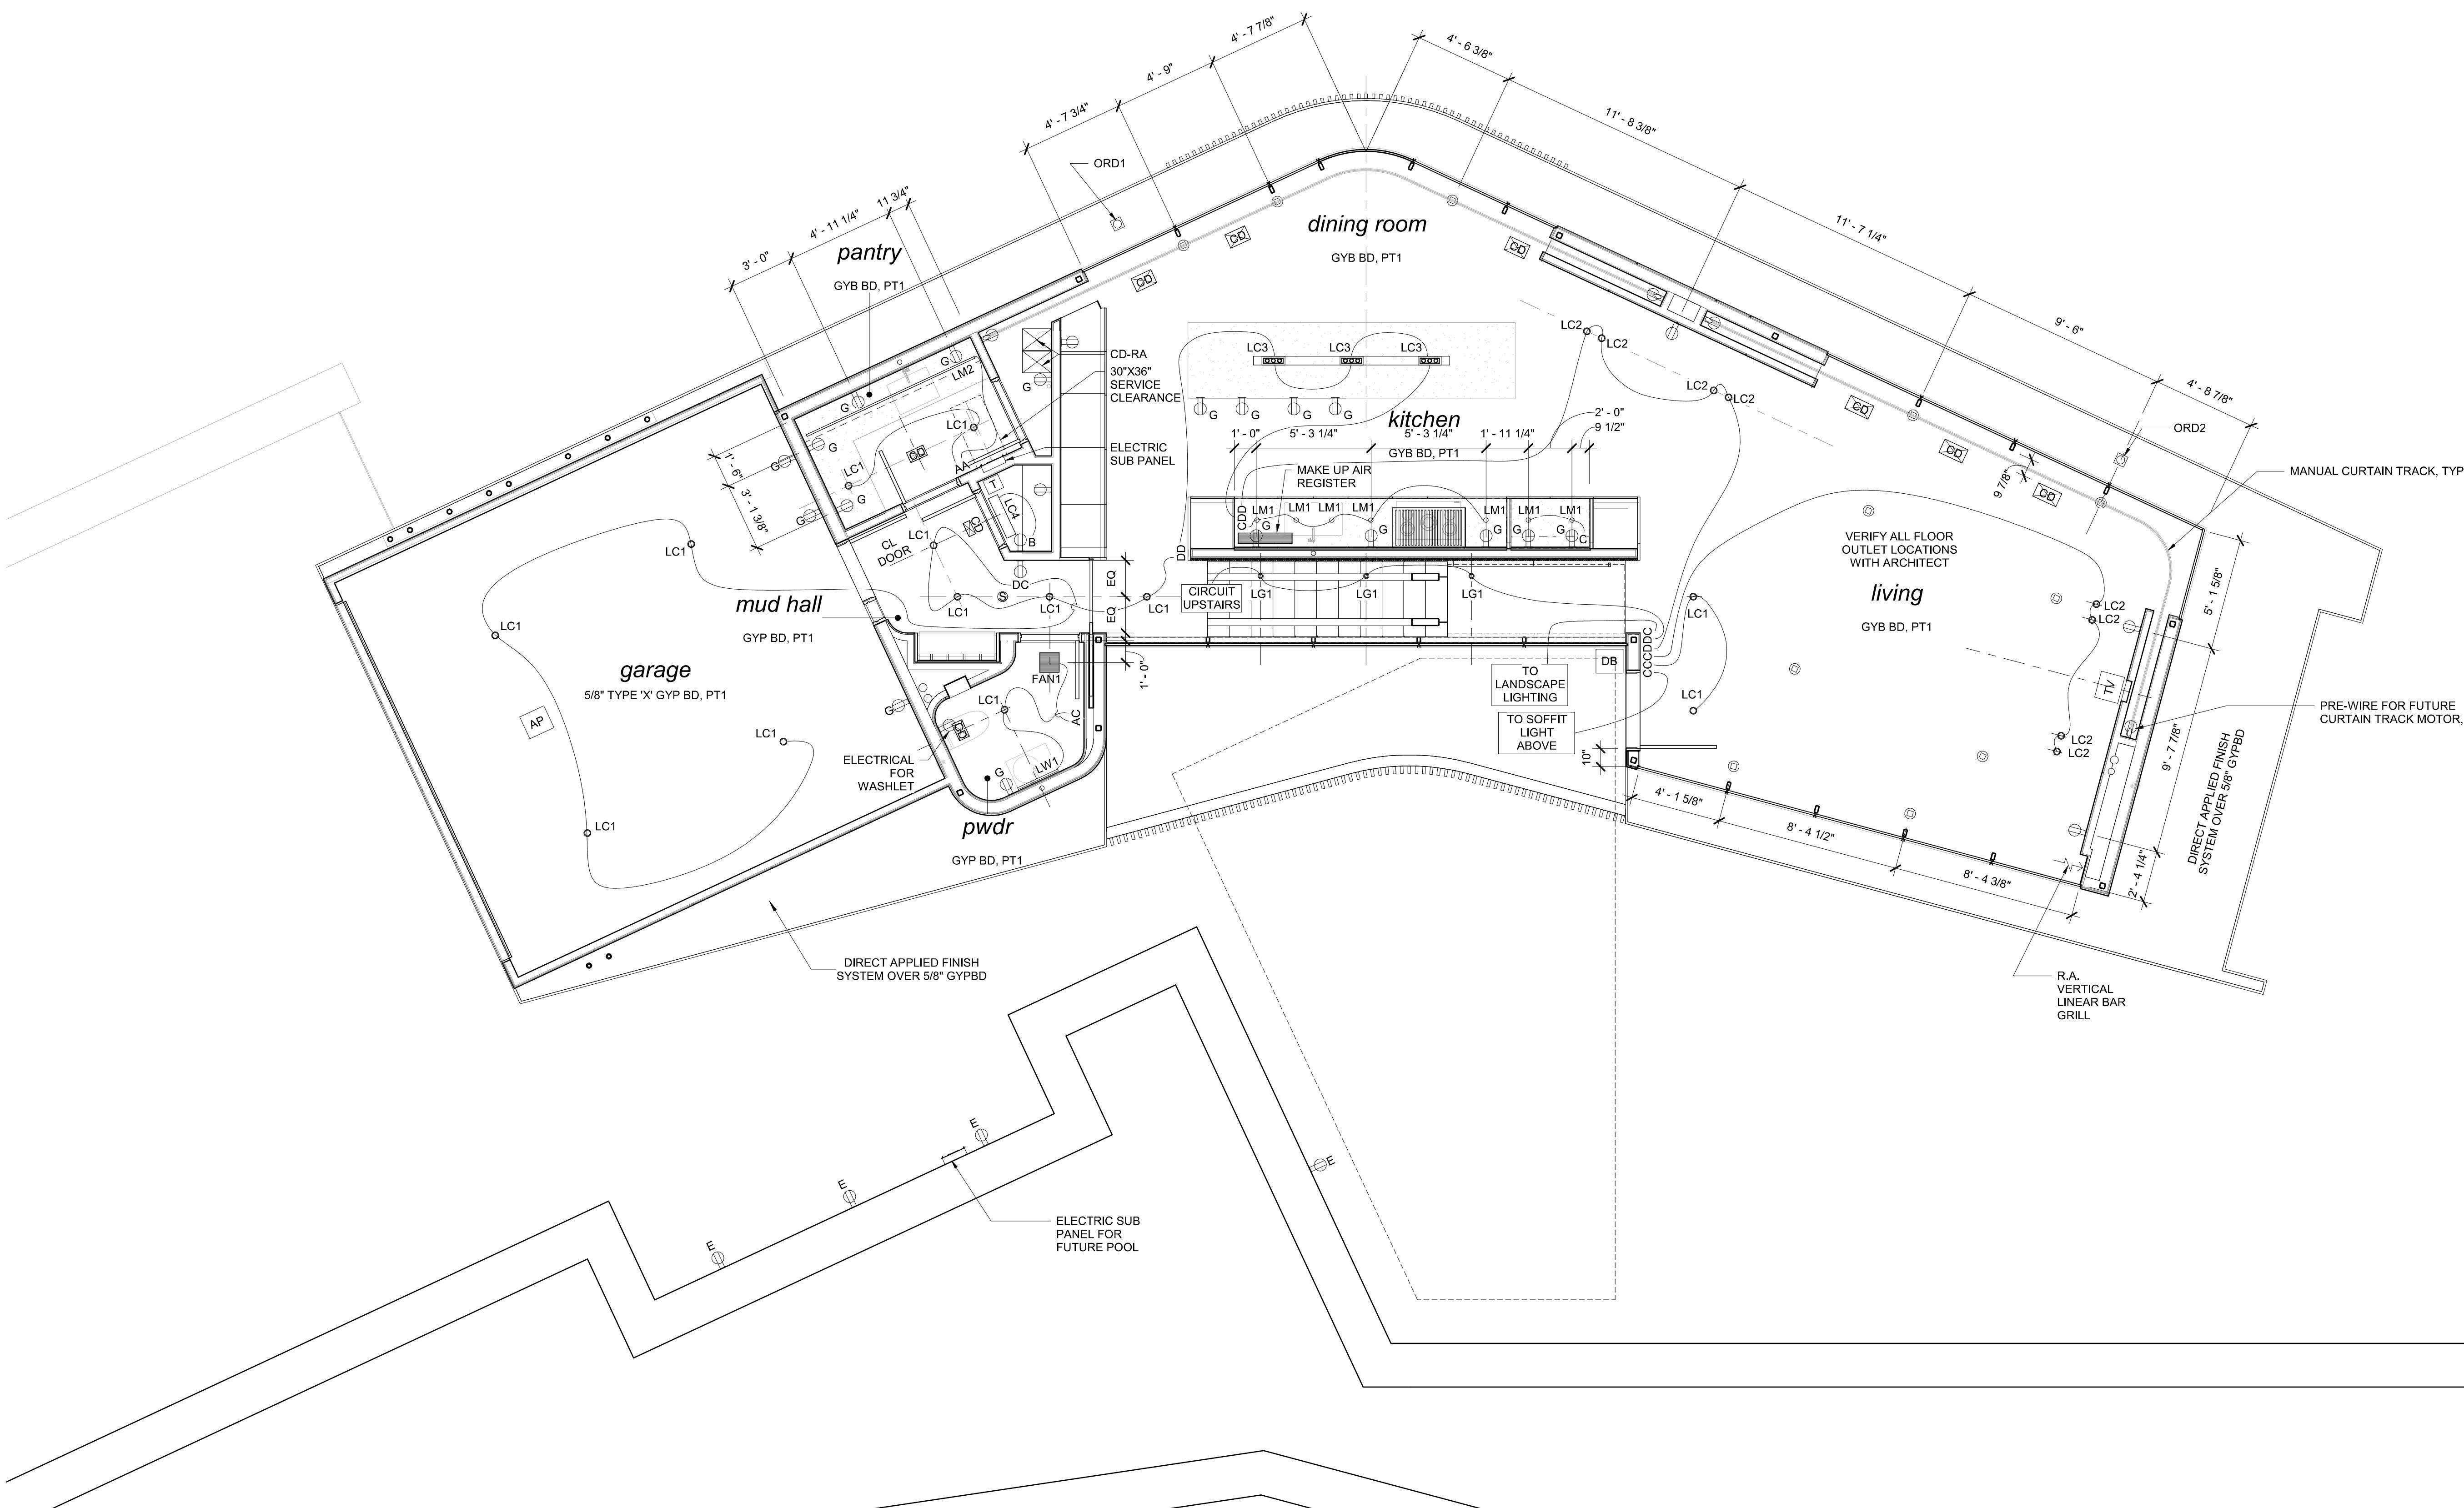

| lighting fixture list                      |                                          |
|--------------------------------------------|------------------------------------------|
| KEY                                        | DESCRIPTION                              |
| LC1                                        | RECESSED DOWNLIGHT - 3"                  |
| LC2                                        | RECESSED DOWNLIGHT - ADJUSTABLE - 3"     |
| LC3                                        | RECESSED DOWNLIGHT - 3 GANG - ADJUSTABLE |
| LC4                                        | LINEAR CEILING MOUNT UTILITY LIGHT - 2'L |
| LC5                                        | LINEAR CEILING MOUNT UTILITY LIGHT - 4'L |
| LC6                                        | 7" ROUND SURFACE MOUNT LED DOWNLIGHT     |
| LG1                                        | RECESSED LANDSCAPE UPLIGHT, ROUND TRIM   |
| LM1                                        | DOWNLIGHT - FIXED                        |
| LM2                                        | LED TAPE LIGHT AT MILLWORK               |
| LW1                                        | WALL MOUNT HIGH OUTPUT LED TAPE LIGHT    |
| SEE PROJECT MANUAL FOR FULL SPECIFICATIONS |                                          |


| switch list |                 |                              |
|-------------|-----------------|------------------------------|
| MARK        | MANUFACTURER    | DESCRIPTION                  |
| A           | LUTRON          | SINGLE POLE                  |
| B           | LUTRON          | 3 WAY GENERAL PURPOSE SWITCH |
| C           | LUTRON          | SINGLE POLE DIMMER           |
| D           | LUTRON          | 3 WAY DIMMER                 |
| J           | LEVITON (1865)  | JAMB SWITCH                  |
| M           | SOMFY(DECOFLEX) | MOTORIZED SHADE CONTROL      |

| device list |                   |                    |                                                   |
|-------------|-------------------|--------------------|---------------------------------------------------|
| MARK        | MANUFACTURER      | MODEL              | DESCRIPTION                                       |
| G           | LUTRON            | DESIGNER STYLE     | DUPLEX OUTLET                                     |
| P           | LUTRON            | DESIGNER STYLE     | SINGLE OUTLET                                     |
| R           | LUTRON            | DESIGNER STYLE     | SWITCHED DUPLEX OUTLET                            |
| T           | LUTRON            | DESIGNER STYLE     | GROUND FAULT INTERRUPT OUTLET                     |
| EC          | MOCKETT           | PCS34 90/94        | COUNTERTOP POP UP OUTLET                          |
| S           | ARLINGTON         | FLBC4560NL         | RECESSED FLOOR OUTLET                             |
| T           | ARLINGTON         | FLBR5420           | RECESSED FLOOR OUTLET AT FRAMED FLOORS            |
| DB          | ARLINGTON         | TVB810             | TELEVISION MOUNTING BOX, MOUNT 60" AFF UNO        |
| AP          | ARLINGTON         | IN-BOX             | EXTERIOR RECESSED GFI OUTLET                      |
|             | THOMAS & BETTS    | DKG-PRO            | RED DOT DECK GROMMET PRO                          |
|             | NEST              | PROTECT            | SMOKE/CARBON MONOXIDE DETECTOR                    |
|             | AMERICAN STANDARD | UX360              | SMART THERMOSTAT                                  |
|             | REOLINK           | VIDEO DOORBELL POE | ETHERNET POWERED VIDEO DOORBELL WITH CHIME/CAMERA |
|             | TP-LINK           | EAP610             | WIRELESS ACCESS POINT - CEILING MOUNT             |
|             |                   |                    | ETHERNET CABLE PATCH PANEL                        |

| rcp/electrical plan - level 1                                                                                                                                                                                                                                                                                                                                                                                                                                        |  |  |  |
|----------------------------------------------------------------------------------------------------------------------------------------------------------------------------------------------------------------------------------------------------------------------------------------------------------------------------------------------------------------------------------------------------------------------------------------------------------------------|--|--|--|
| <p>These plans have been reviewed by AT&amp;T Engineers. Inspectors and Surveyors for code compliance and design are responsible for determining if the plans are in accordance with the applicable codes. It is the responsibility of the designer to make sure the plans are in accordance with all codes, ordinances, State and Federal laws. Copying or distributing these plans shall not be taken to be a license of all rights.</p> <p><i>[Signature]</i></p> |  |  |  |

A3.11

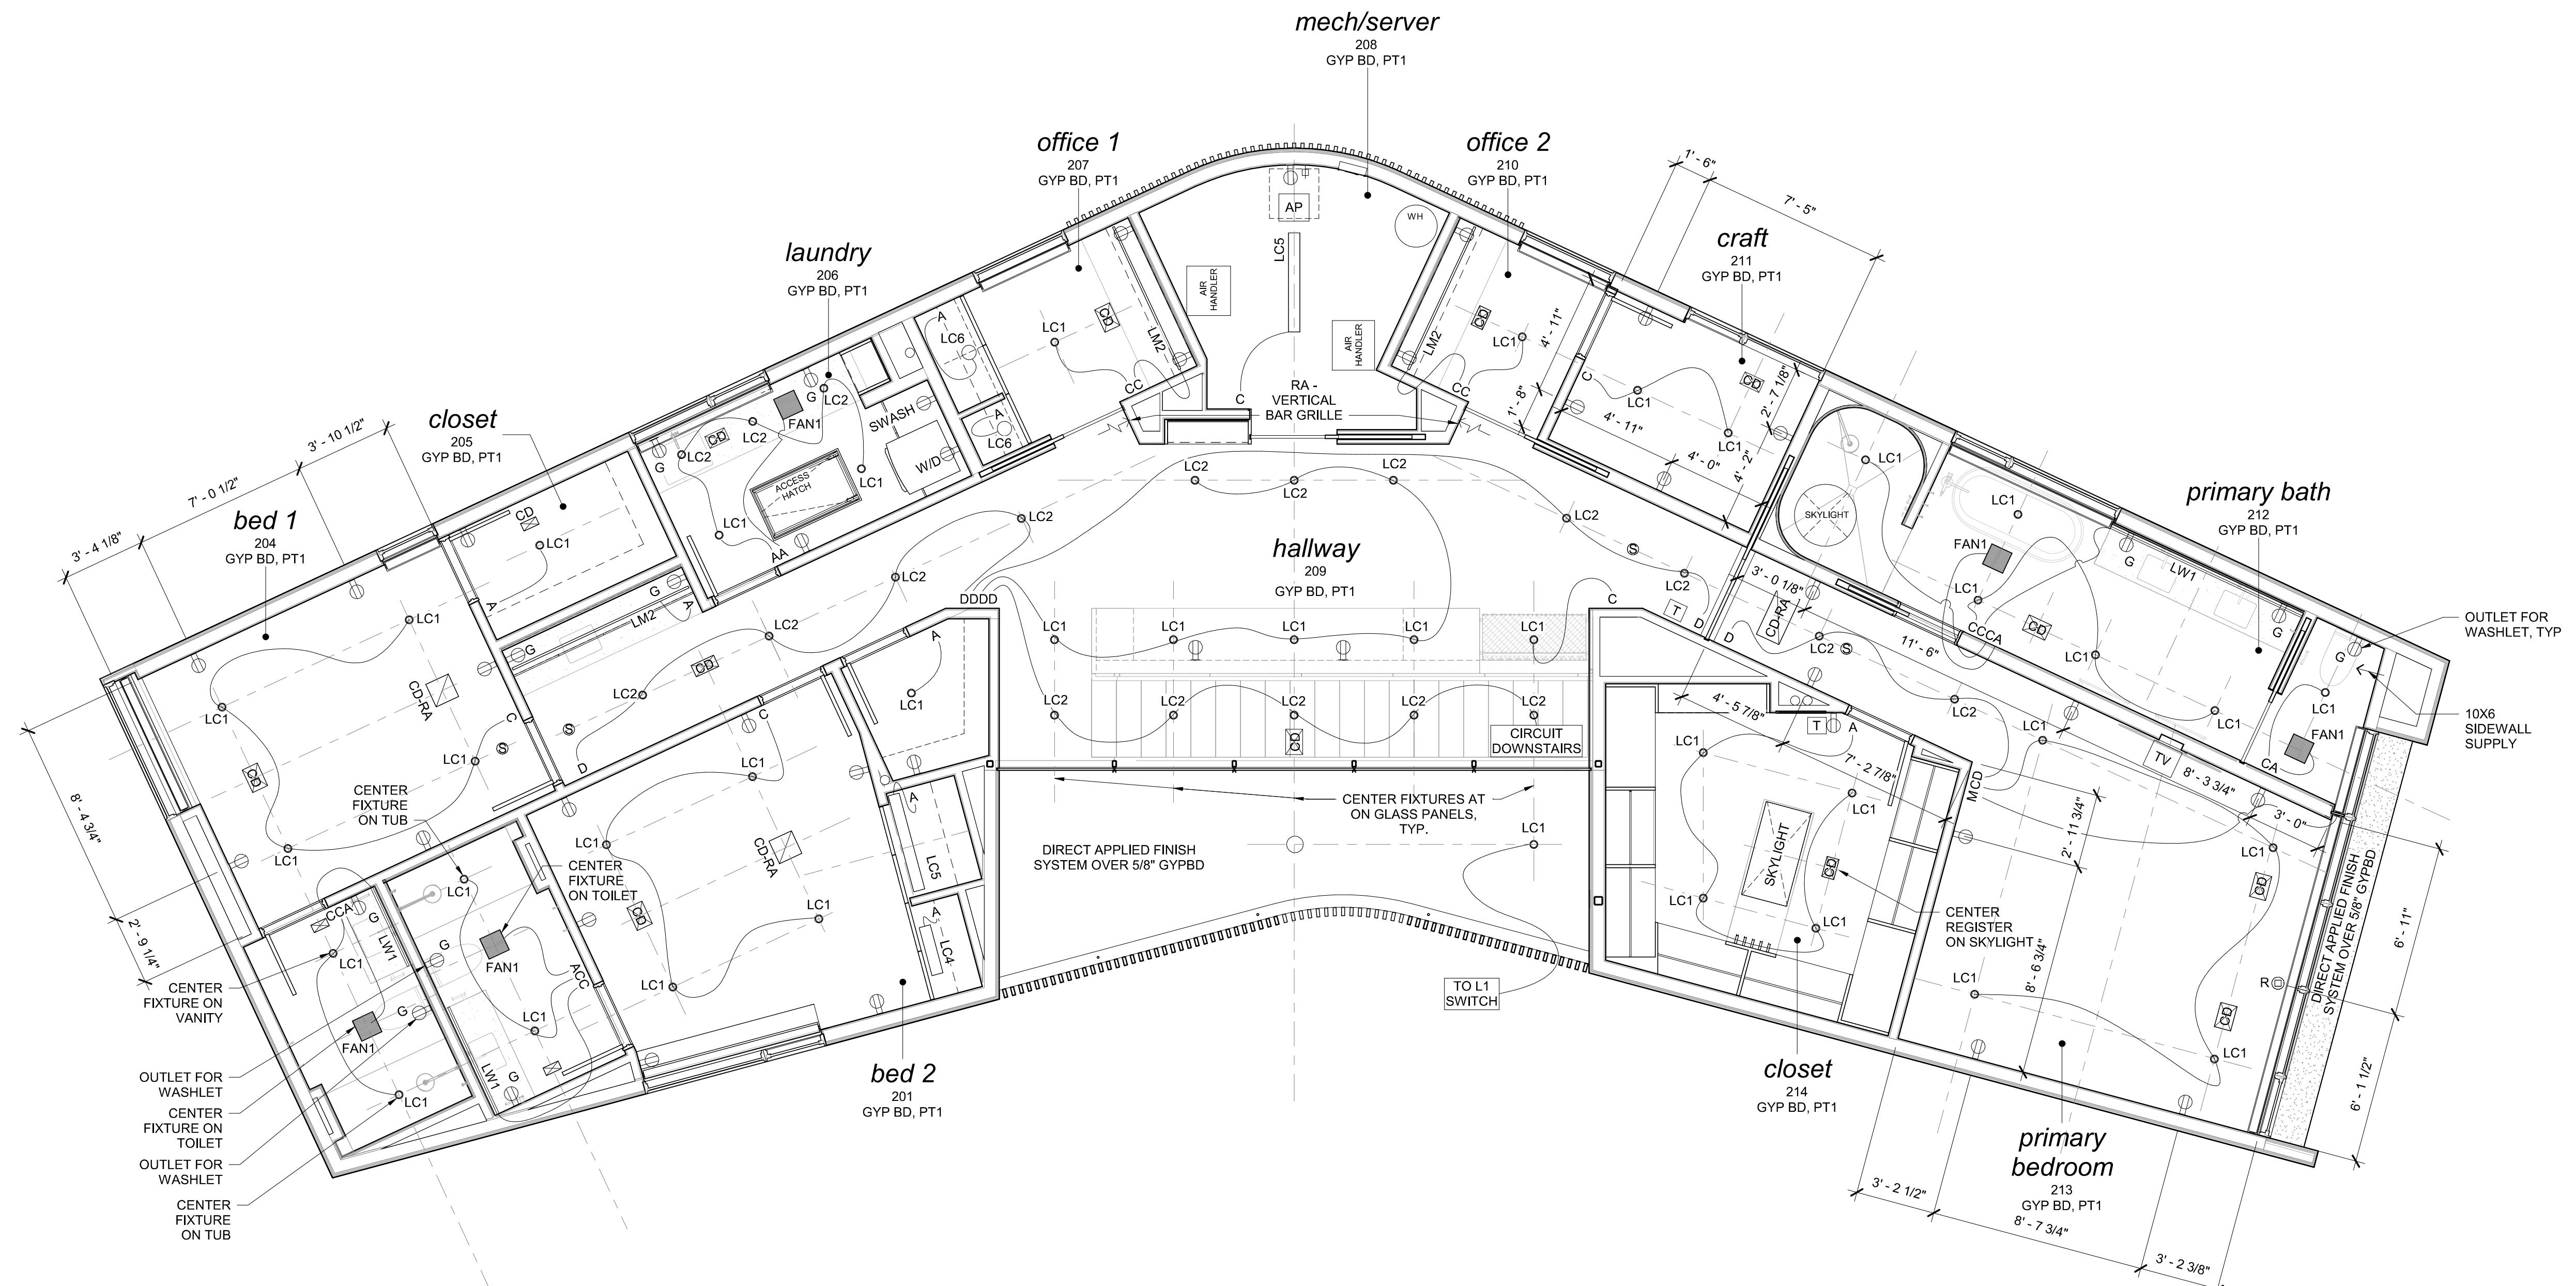

| NOTES:                                                                                                                                                                                                                                 |  |
|----------------------------------------------------------------------------------------------------------------------------------------------------------------------------------------------------------------------------------------|--|
| 1. SWITCHES, RECEPTACLES AND ENTERTAINMENT BUNDLE COVER PLATES TO BE LUTRON DESIGNER SCREWLESS WALL PLATE                                                                                                                              |  |
| 2. PROVIDE GFCI OUTLETS WITH SURGE PROTECTION.                                                                                                                                                                                         |  |
| 3. PROVIDE STARLINK TERMINAL AT ROOF, RE: ROOF PLAN.                                                                                                                                                                                   |  |
| 4. PROVIDE SPECTRUM CABLE SERVICE.                                                                                                                                                                                                     |  |
| 5. PROVIDE DATA WIRING (VERIFY TYPE WITH OWNER) BETWEEN STARLINK TERMINAL, SERVER CABINET, 1 WIFI CEILING ACCESS POINT (AP) PER FLOOR, 1 WIFI CEILING AP FOR CARPORT, 1 EXTERNAL WIFI AP, OFFICE 1&2, PRIMARY BEDROOM TV AND DOORBELL. |  |
| 6. PROVIDE POE (POWER OVER ETHERNET) SECURITY CAMERAS WITH DATA WIRING (VERIFY TYPE WITH OWNER) TO THE SERVER CABINET, VERIFY NUMBER AND LOCATION WITH OWNER.                                                                          |  |
| 7. PROVIDE ALTERNATIVE PRICING FOR PROJECT USING INNOVELLI RED DIMMER SWITCHES IN LIEU OF LUTRON SWITCHES AND DIMMERS.                                                                                                                 |  |
| 8. PROVIDE ALTERNATIVE PRICING USING COMMERCIAL GRADE OUTLETS IN LIEU OF LUTRON.                                                                                                                                                       |  |
| 9. PROVIDE KEYLESS ENTRY AT BOTH FRONT AND BACK DOORS, VERIFY SYSTEM WITH OWNER AND ARCHITECT.                                                                                                                                         |  |

| lighting fixture list |                                          |
|-----------------------|------------------------------------------|
| KEY                   | DESCRIPTION                              |
| LC1                   | RECESSED DOWNLIGHT - 3"                  |
| LC2                   | RECESSED DOWNLIGHT - ADJUSTABLE - 3"     |
| LC3                   | RECESSED DOWNLIGHT - 3 GANG - ADJUSTABLE |
| LC4                   | LINEAR CEILING MOUNT UTILITY LIGHT - 2'L |
| LC5                   | LINEAR CEILING MOUNT UTILITY LIGHT - 4'L |
| LC6                   | 7" ROUND SURFACE MOUNT LED DOWNLIGHT     |
| LG1                   | RECESSED LANDSCAPE UPLIGHT, ROUND TRIM   |
| LM1                   | DOWNLIGHT - FIXED                        |
| LM2                   | LED TAPE LIGHT AT MILLWORK               |
| LW1                   | WALL MOUNT HIGH OUTPUT LED TAPE LIGHT    |

SEE PROJECT MANUAL FOR FULL SPECIFICATIONS

| switch list |                 |
|-------------|-----------------|
| MARK        | MANUFACTURER    |
| A           | LUTRON          |
| B           | LUTRON          |
| C           | LUTRON          |
| D           | LUTRON          |
| J           | LEVITON (1865)  |
| M           | SOMFY(DECOFLEX) |


| device list |                |
|-------------|----------------|
| MARK        | MANUFACTURER   |
| G           | LUTRON         |
| R           | LUTRON         |
| T           | LUTRON         |
| E           | LUTRON         |
| S           | LUTRON         |
| D           | MOCKETT        |
| B           | ARLINGTON      |
| P           | ARLINGTON      |
| TV          | ARLINGTON      |
| EC          | THOMAS & BETTS |
| DB          | ARLINGTON      |
| AP          | ARLINGTON      |
| AP          | TP-LINK        |

DD PRICING SET 06.16.2023  
CONSTRUCTION 01.20.2023  
1 PERMIT RESPONSE 01.26.2024

Scale: 1/4" = 1'-0"  
HALF OF NOTED SCALE WHEN PRINTED ON 12X18.  
DO NOT SCALE DRAWINGS.  
CONTACT ARCHITECT IN CASE OF DISCREPANCIES.  
THIS SHEET IS ONLY ONE COMPONENT OF THE  
TOTAL DRAWINGS WHICH CONSISTS OF  
ALL DRAWINGS AND SPECIFICATIONS.


rcc/electrical plan  
- level 2

A3.21

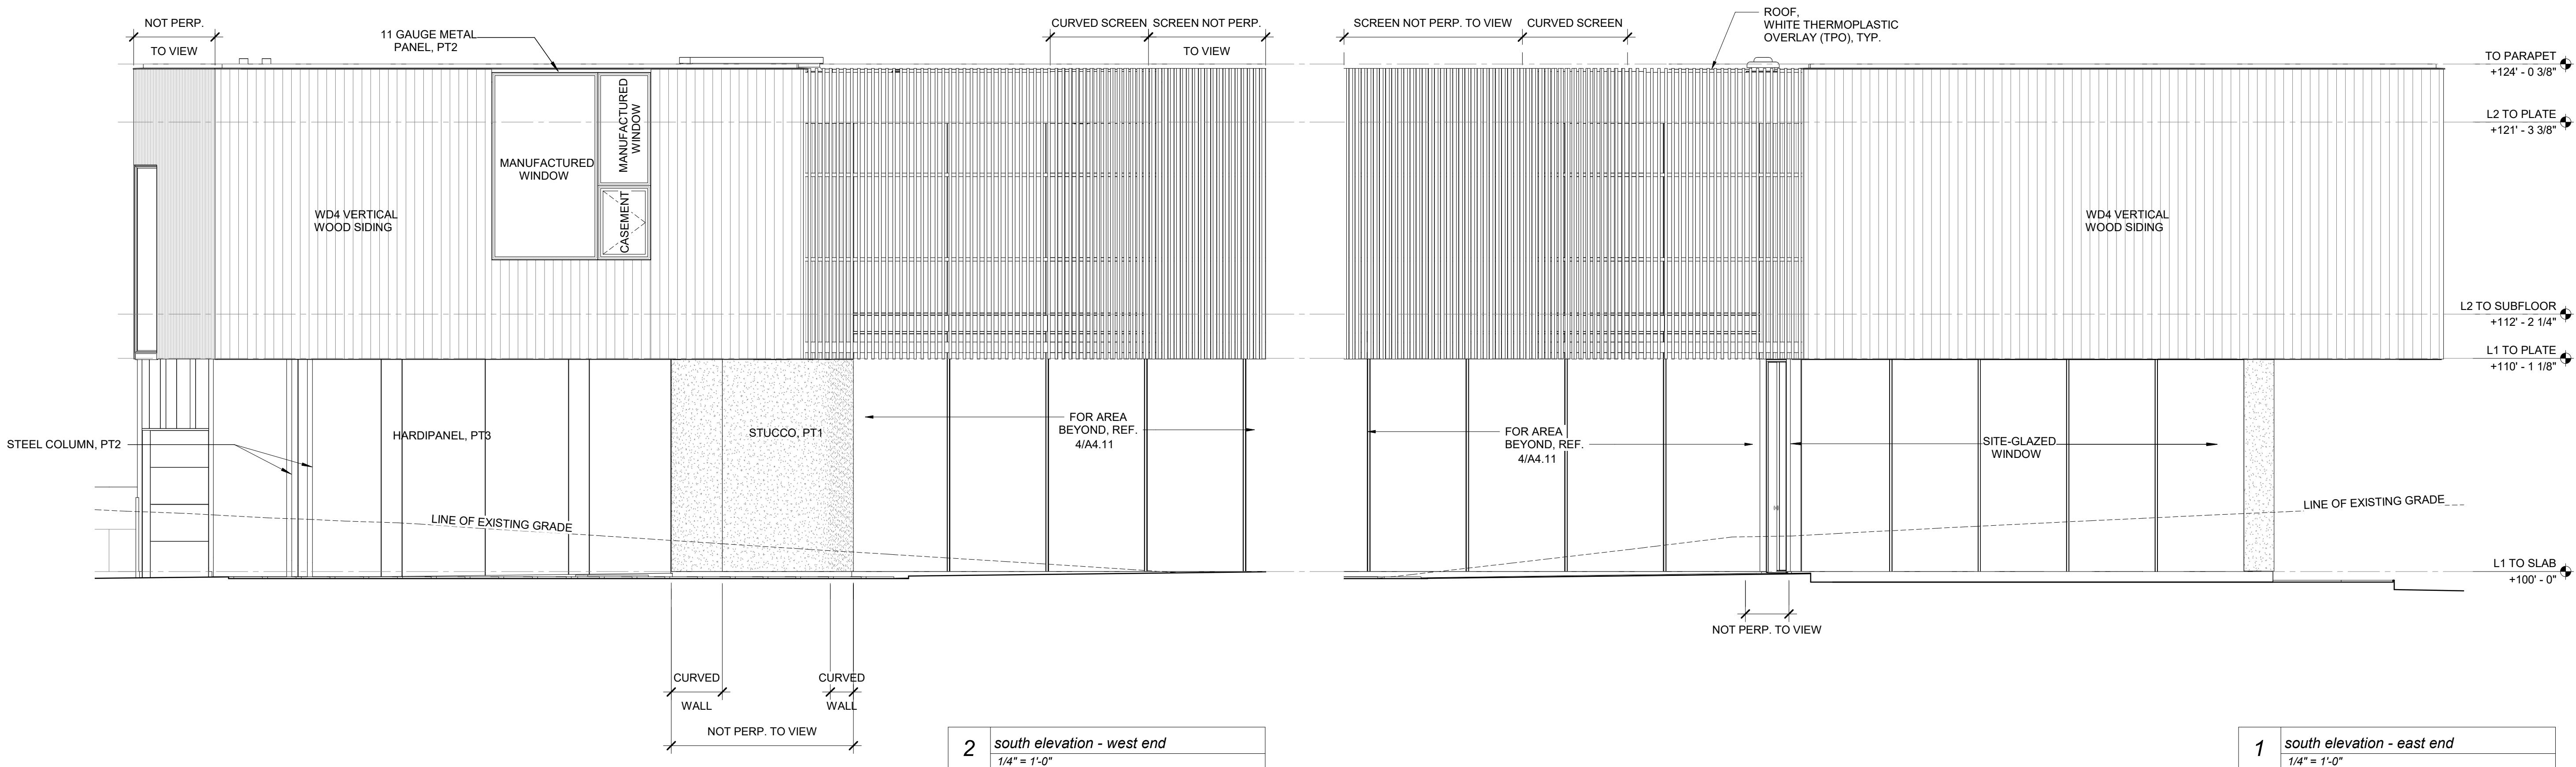

**kos  
residence**


17363 E Reed Parks Rd.  
Jonestown, Texas 78645

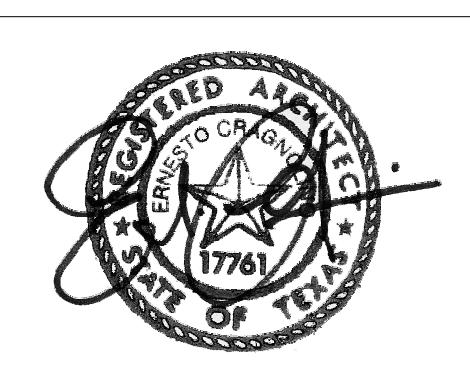

**alterstudio**  
architecture LLP

1801 lavaca st #106  
austin, texas 78701  
512 499 8007

DD PRICING SET 06.16.2023  
BUILDING PERMIT 12.15.2023

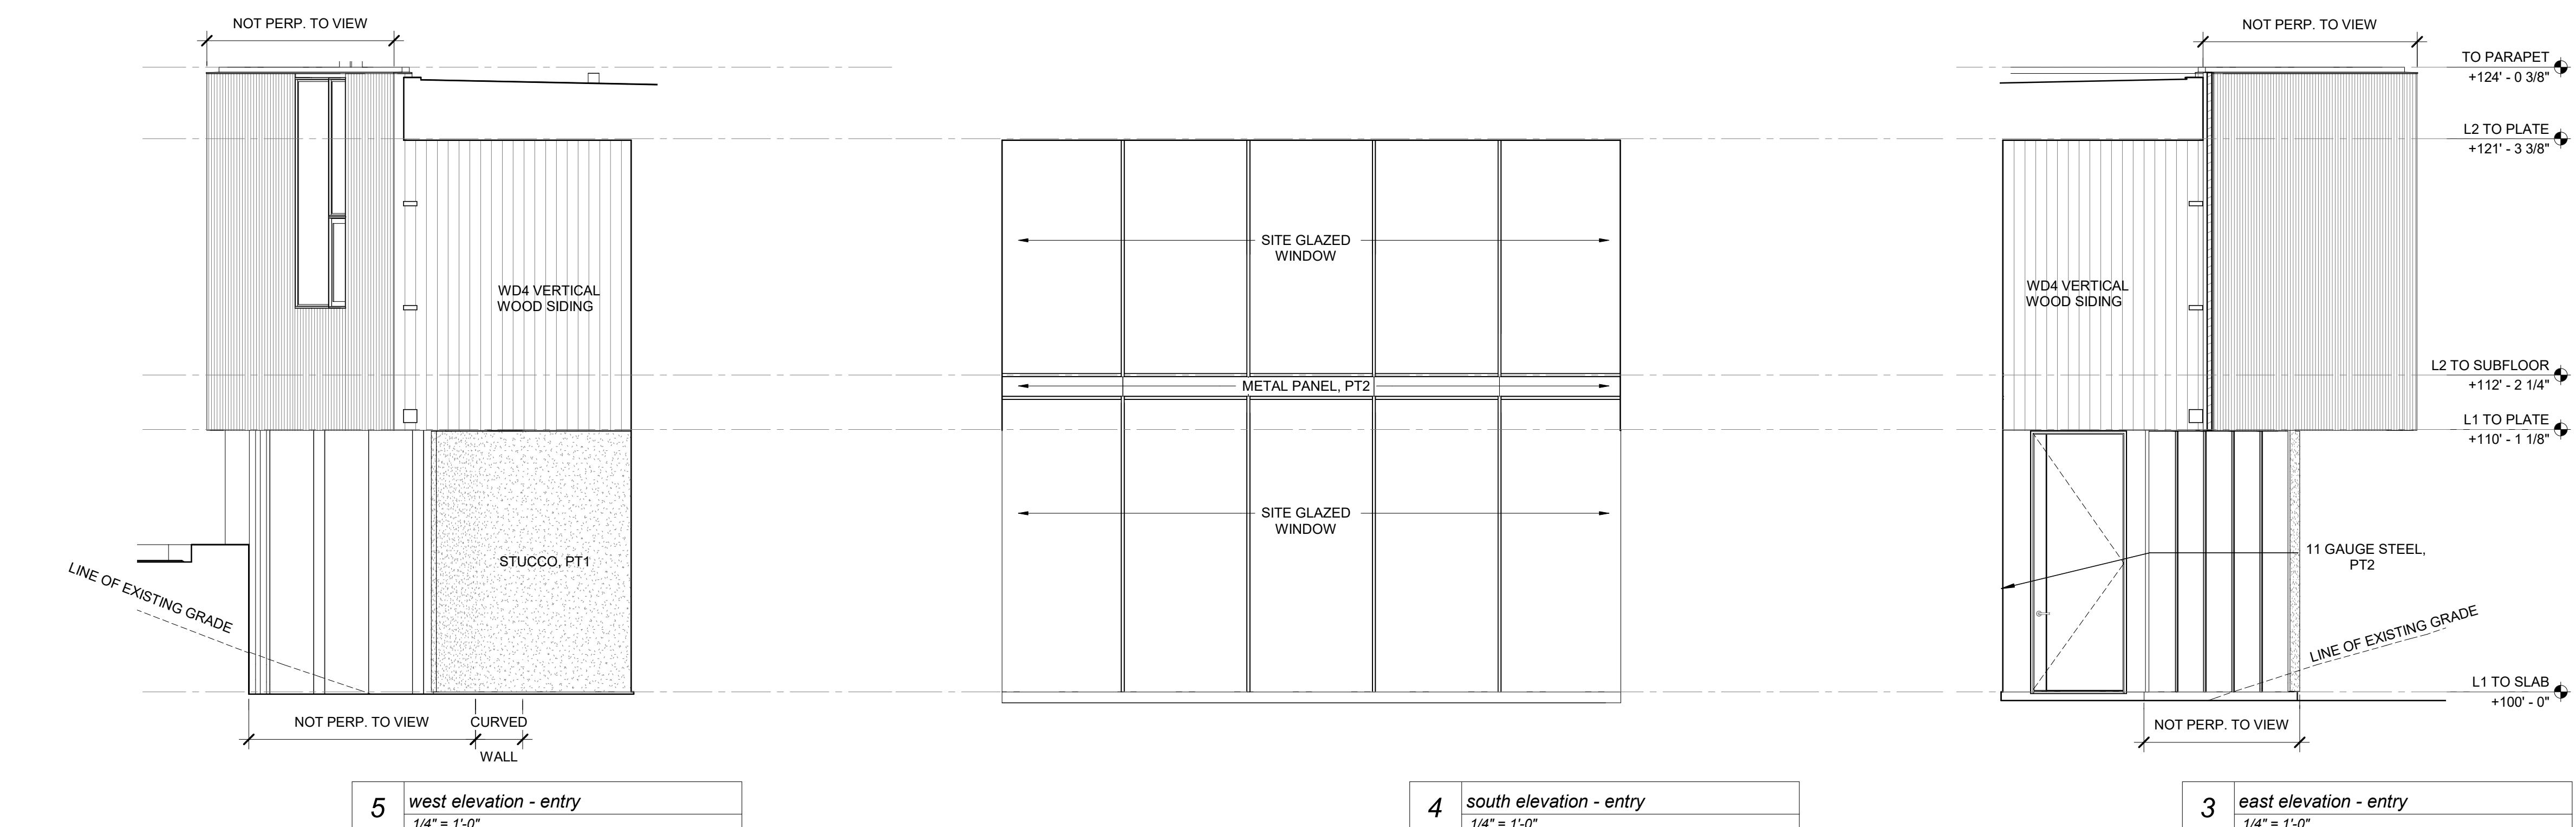


Scale: 1/4" = 1'-0"  
HALF OF NOTED SCALE WHEN PRINTED ON 12X18.  
DO NOT SCALE DRAWINGS.  
CONTACT ARCHITECT IN CASE OF DISCREPANCIES.  
THIS SHEET IS ONLY ONE COMPONENT OF THE  
TOTAL DRAWINGS AND SPECIFICATIONS  
CONSISTS OF  
ALL DRAWINGS AND SPECIFICATIONS

These plans have been reviewed by AT3 Engineers.  
Approved for construction in accordance with the adopted  
model building ordinances. This stamp of review is not  
a substitute for a building permit. The plans must be  
complied with all codes, ordinances, state and Federal laws.  
Any deviation from the plans must be made in accordance with  
the plans and specifications.


elevations

**A4.11**

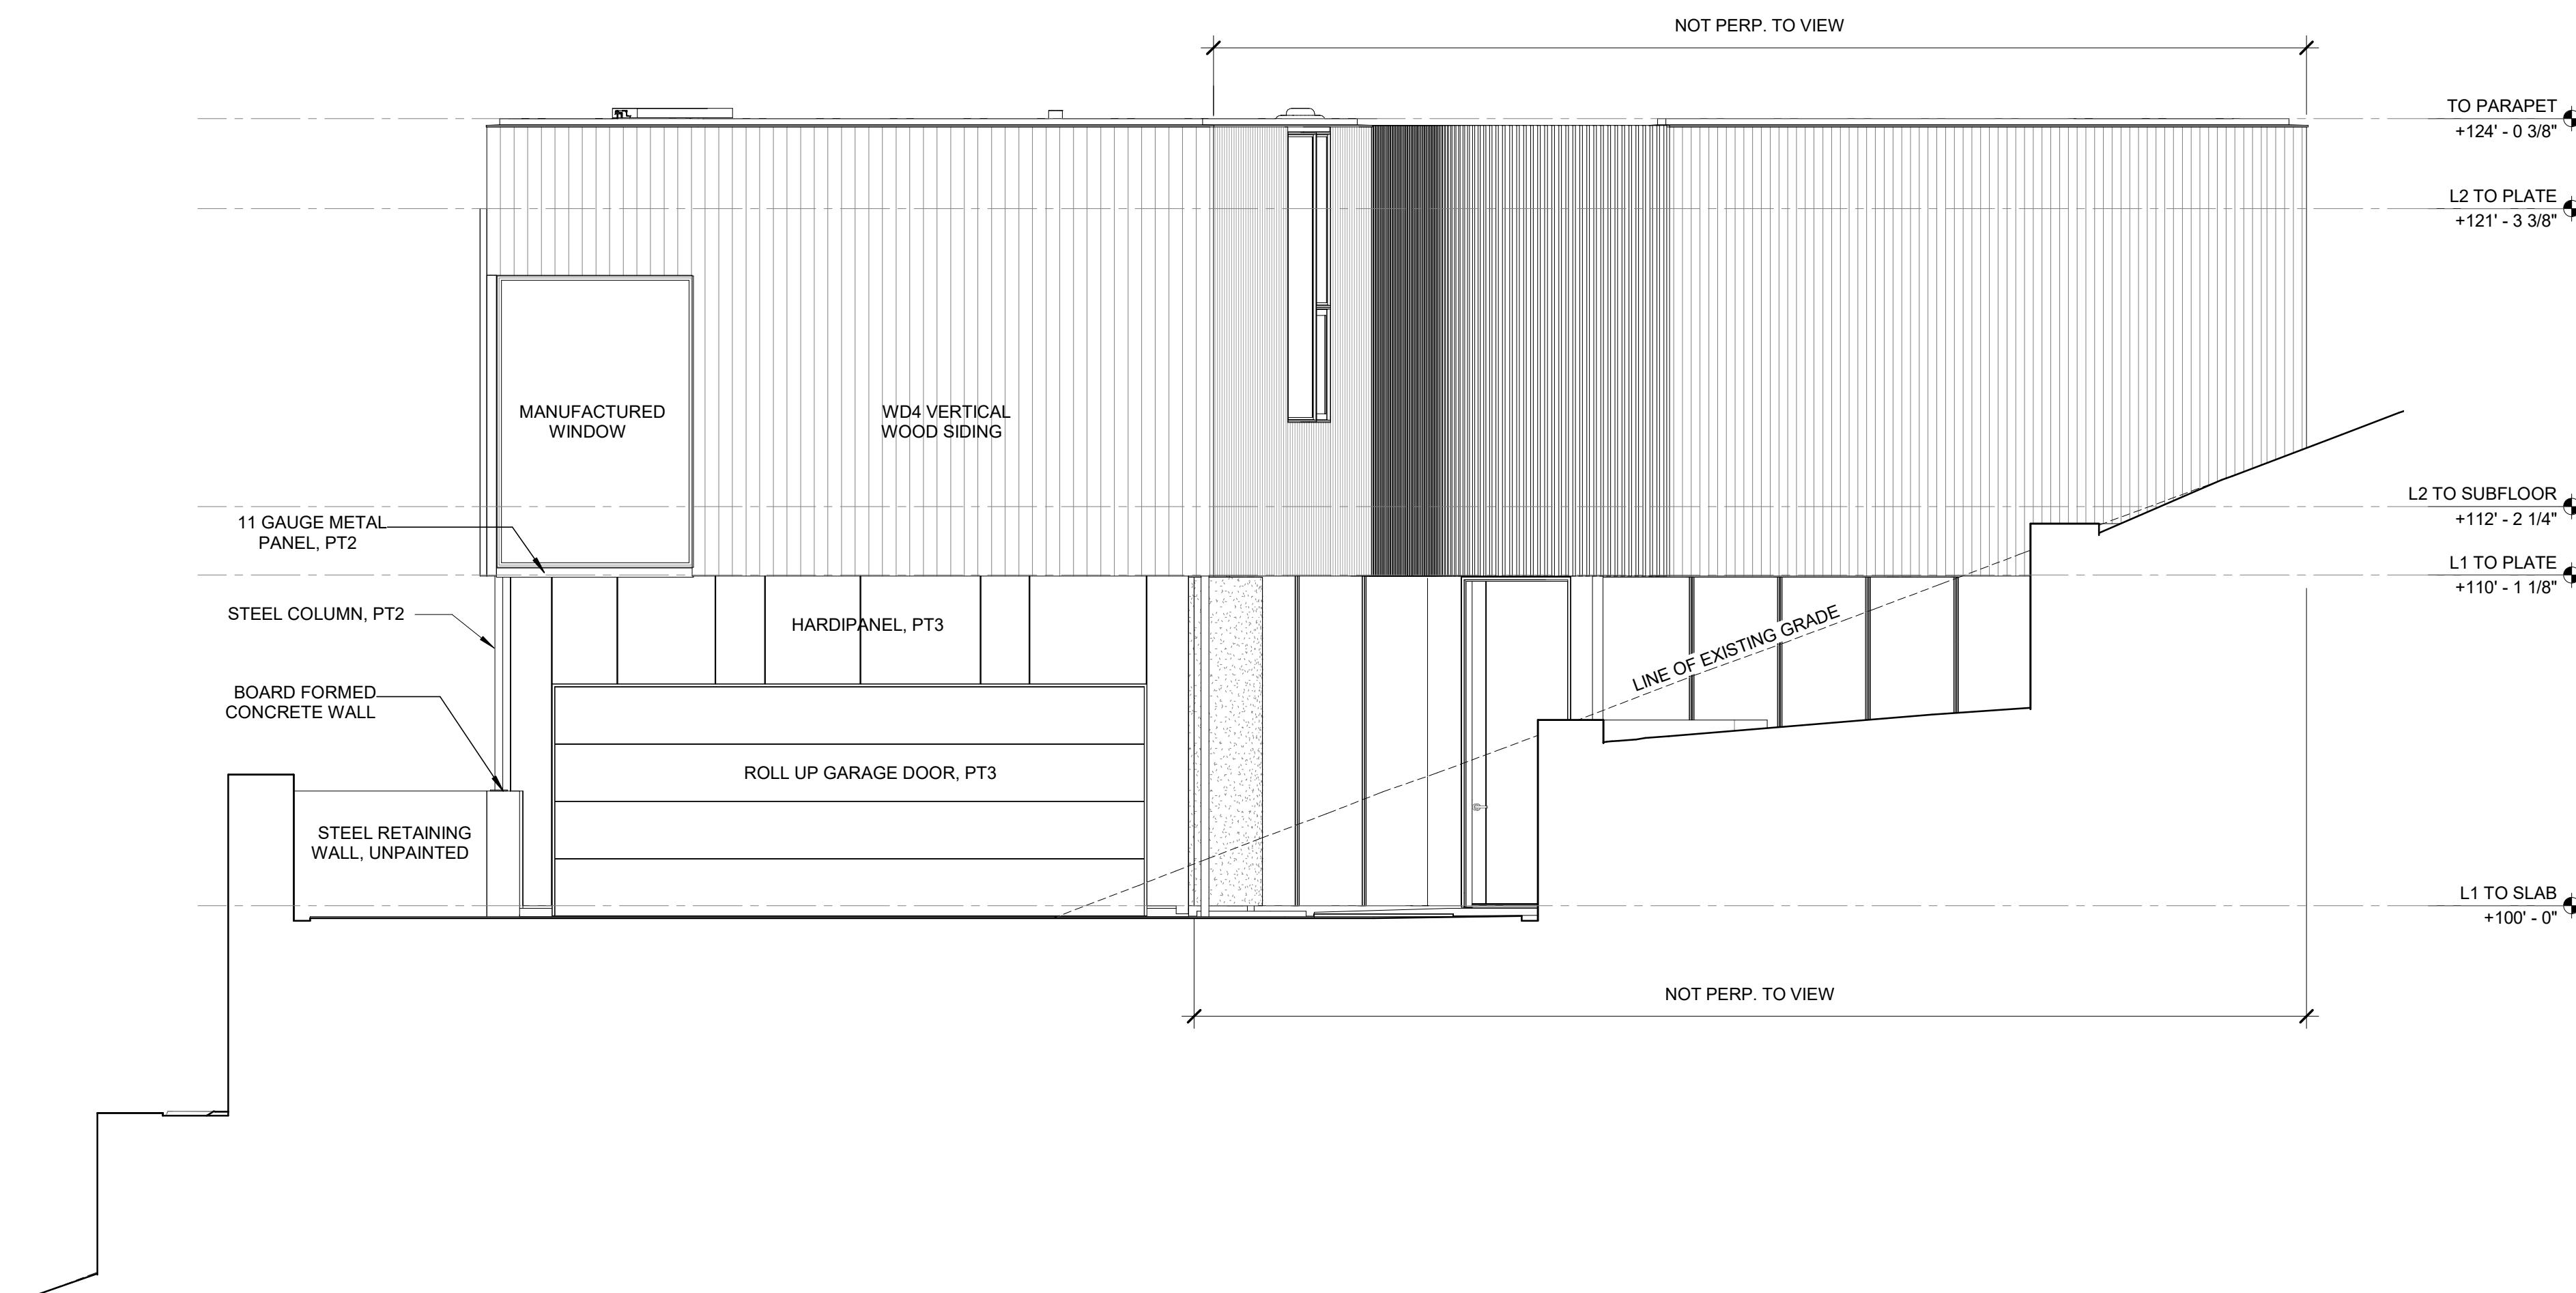

# ***kos residence***

7363 E Reed Parks Rd.  
nestown, Texas 78645

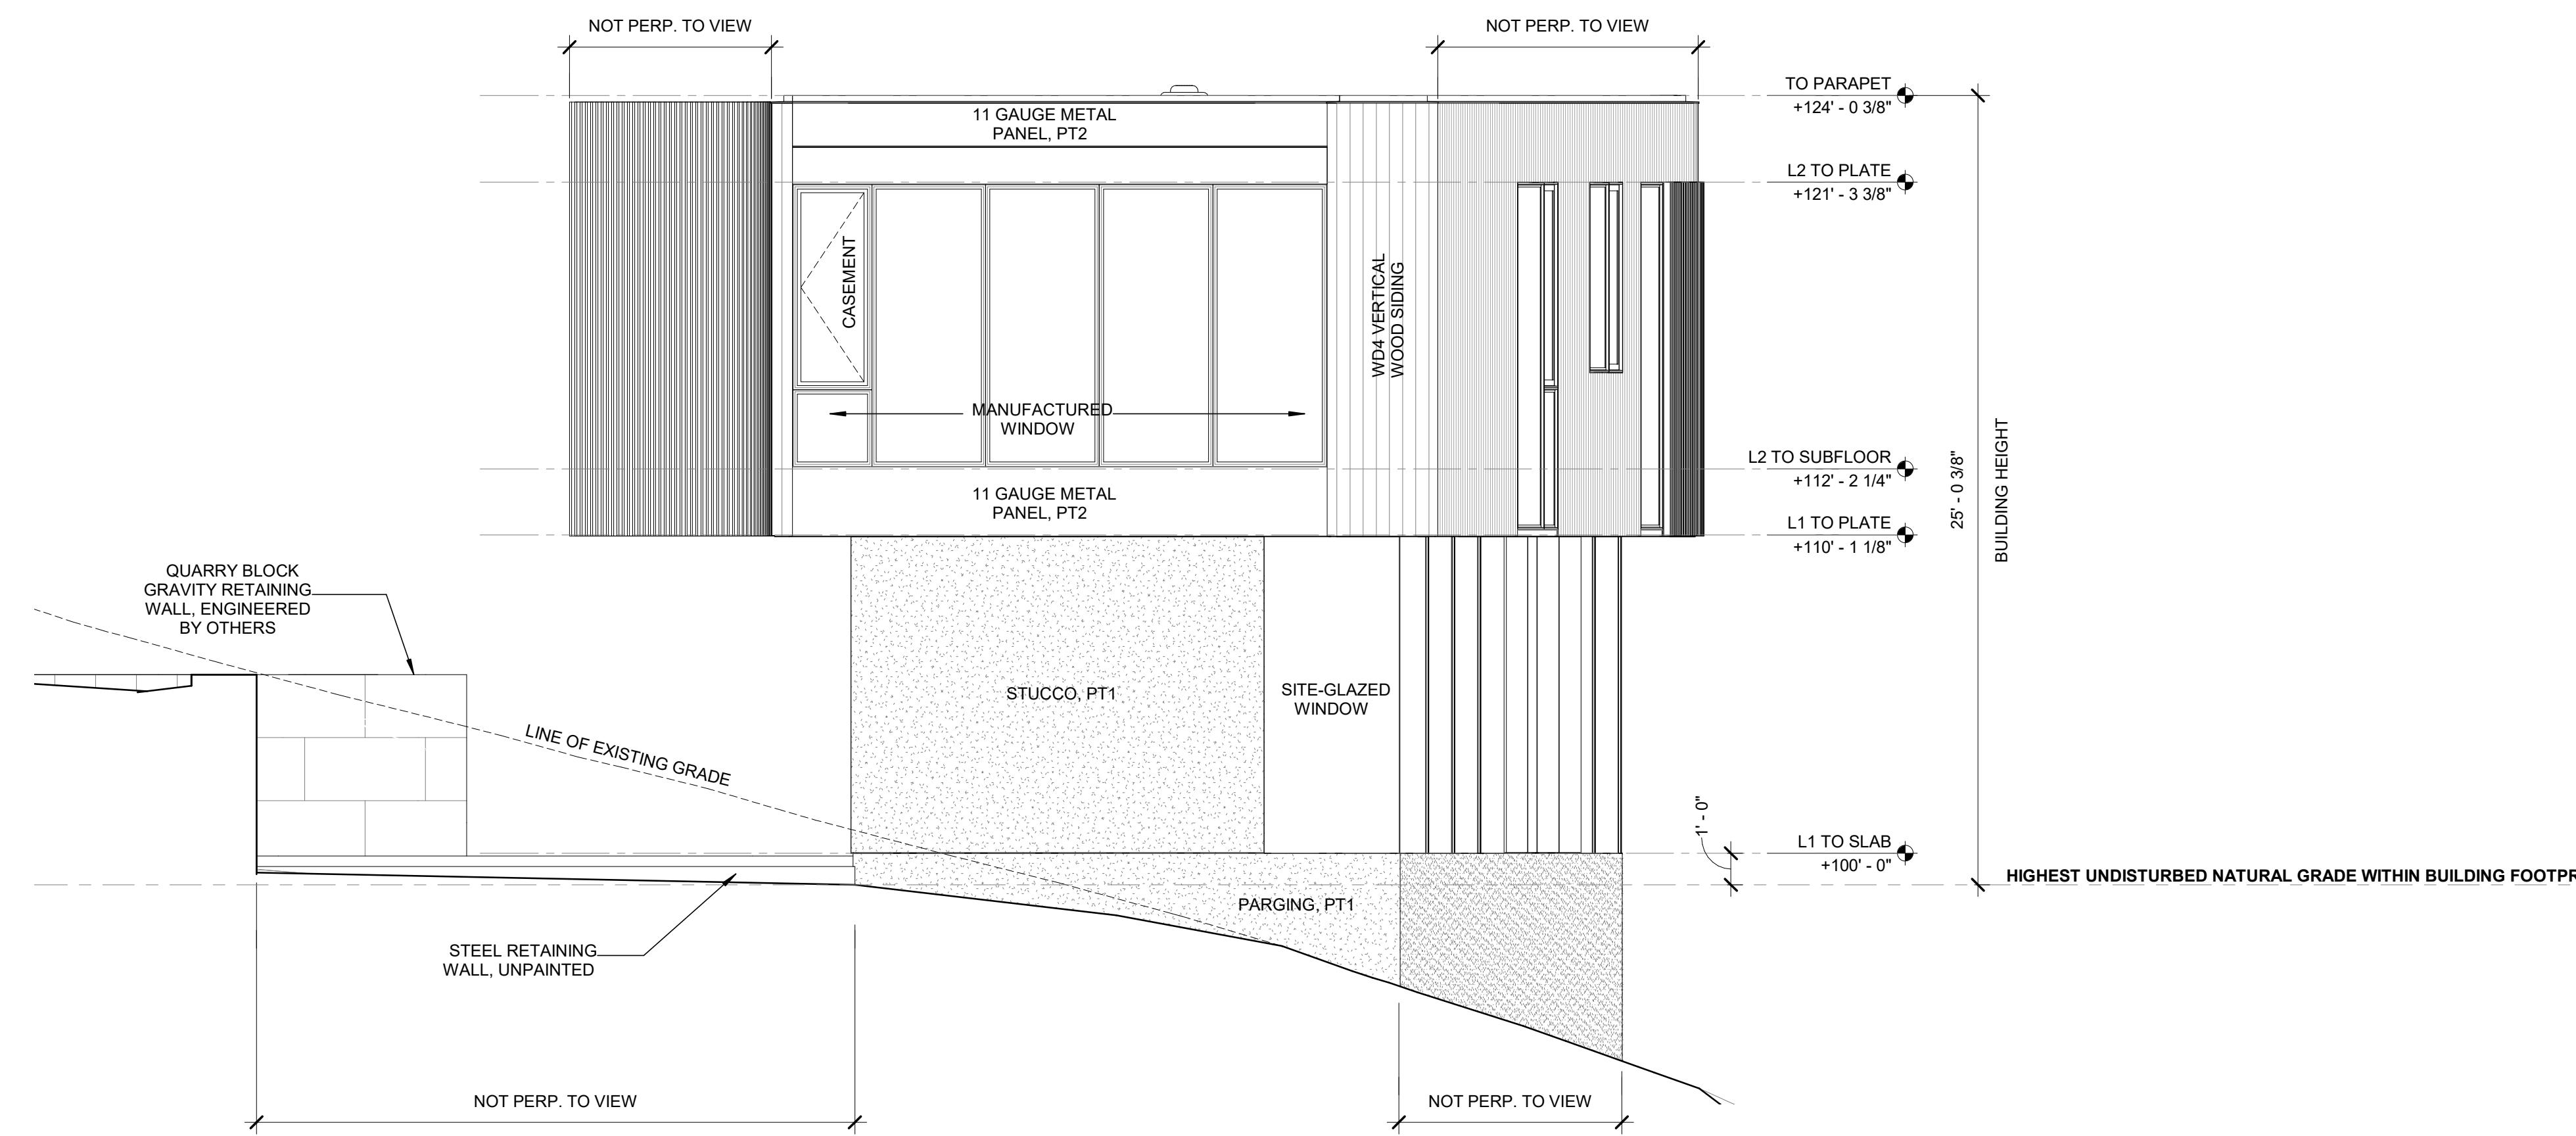


|   |                       |
|---|-----------------------|
| 2 | <i>east elevation</i> |
|   | $1/4" = 1'-0"$        |

OTED SCALE WHEN PRINTED ON 12X18.  
CALE DRAWINGS.  
ARCHITECT IN CASE OF DISCREPANCIES.  
IT IS ONLY ONE COMPONENT OF THE  
UMENT PACKAGE WHICH CONSISTS OF  
NCS AND SPECIFICATIONS.

## *elevations*


# A4.12

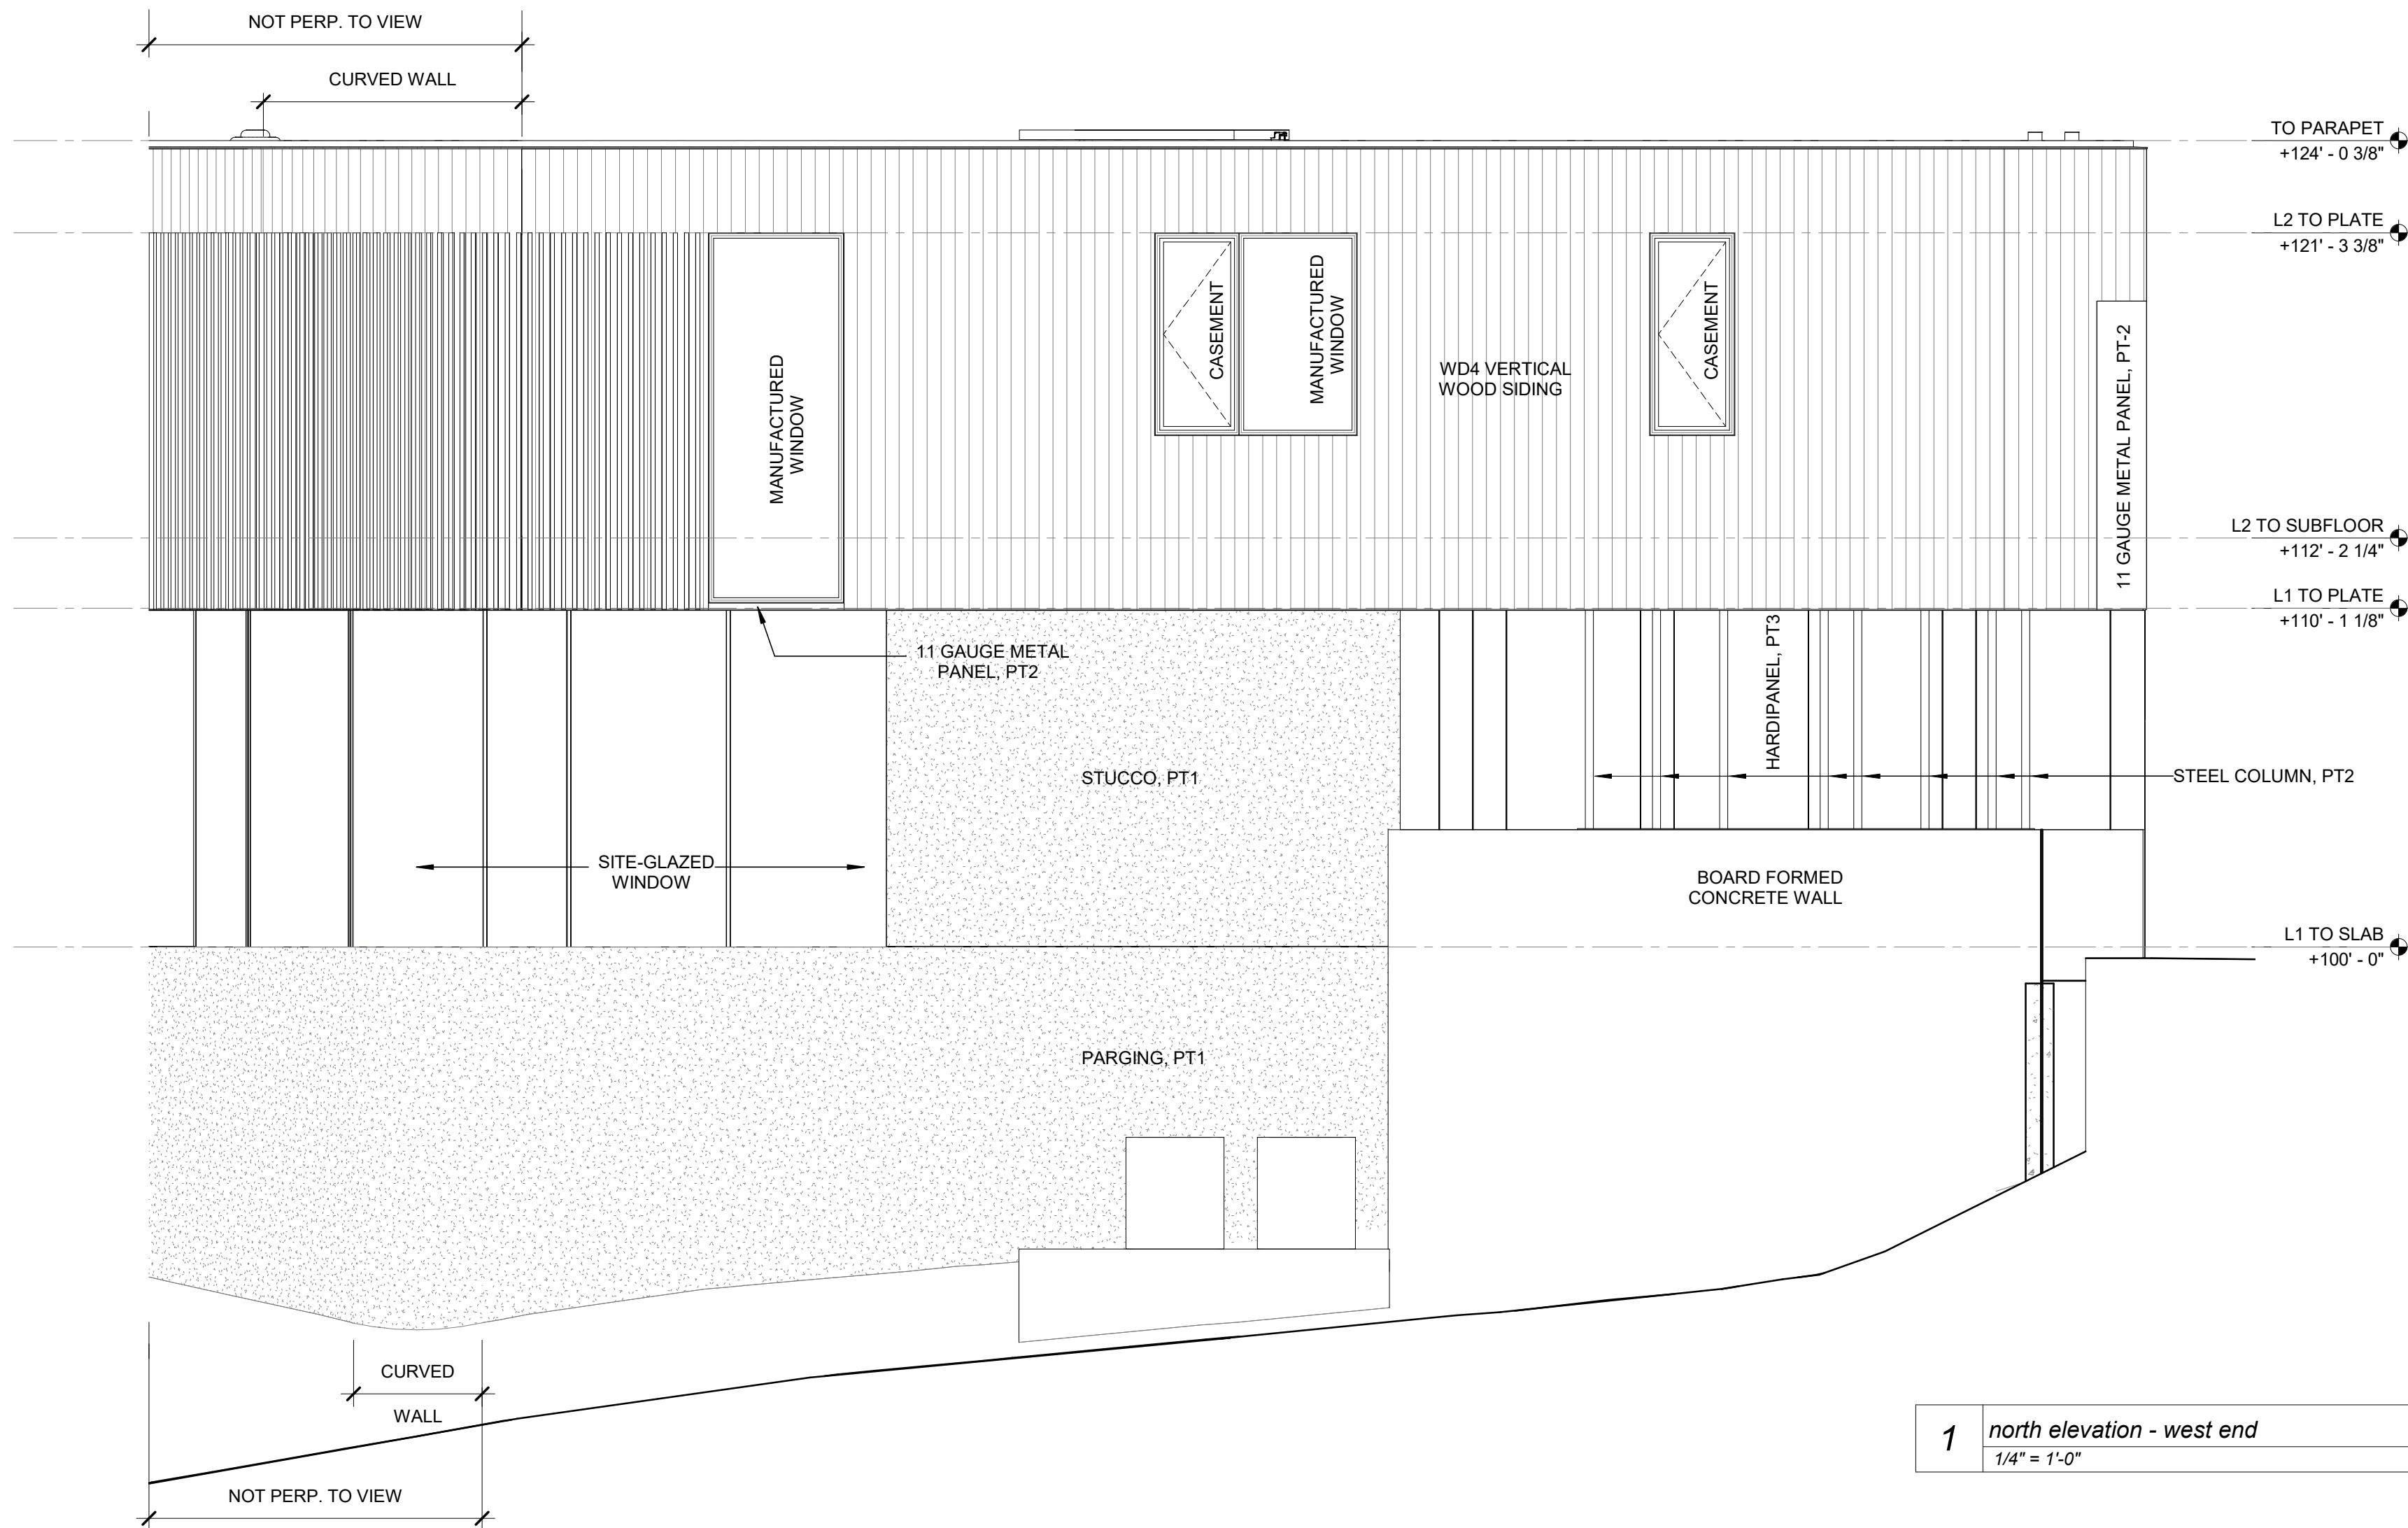

1 north elevation - west end  
1/4" = 1'-0"

**kos**  
**residence**

17363 E Reed Parks Rd.  
Jonestown, Texas 78645

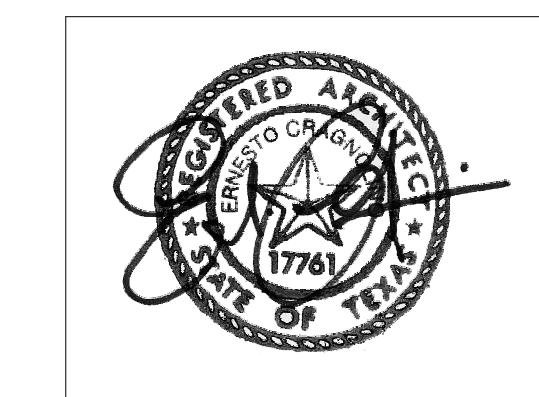


**alterstudio**  
architecture LLP

1801 lavaca st #106  
austin, texas 78701  
512 499 8007

DD PRICING SET 06.16.2023  
BUILDING PERMIT 12.15.2023

4 elevation - I2 fin - south  
1/4" = 1'-0"

3 elevation - I2 fin - north  
1/4" = 1'-0"

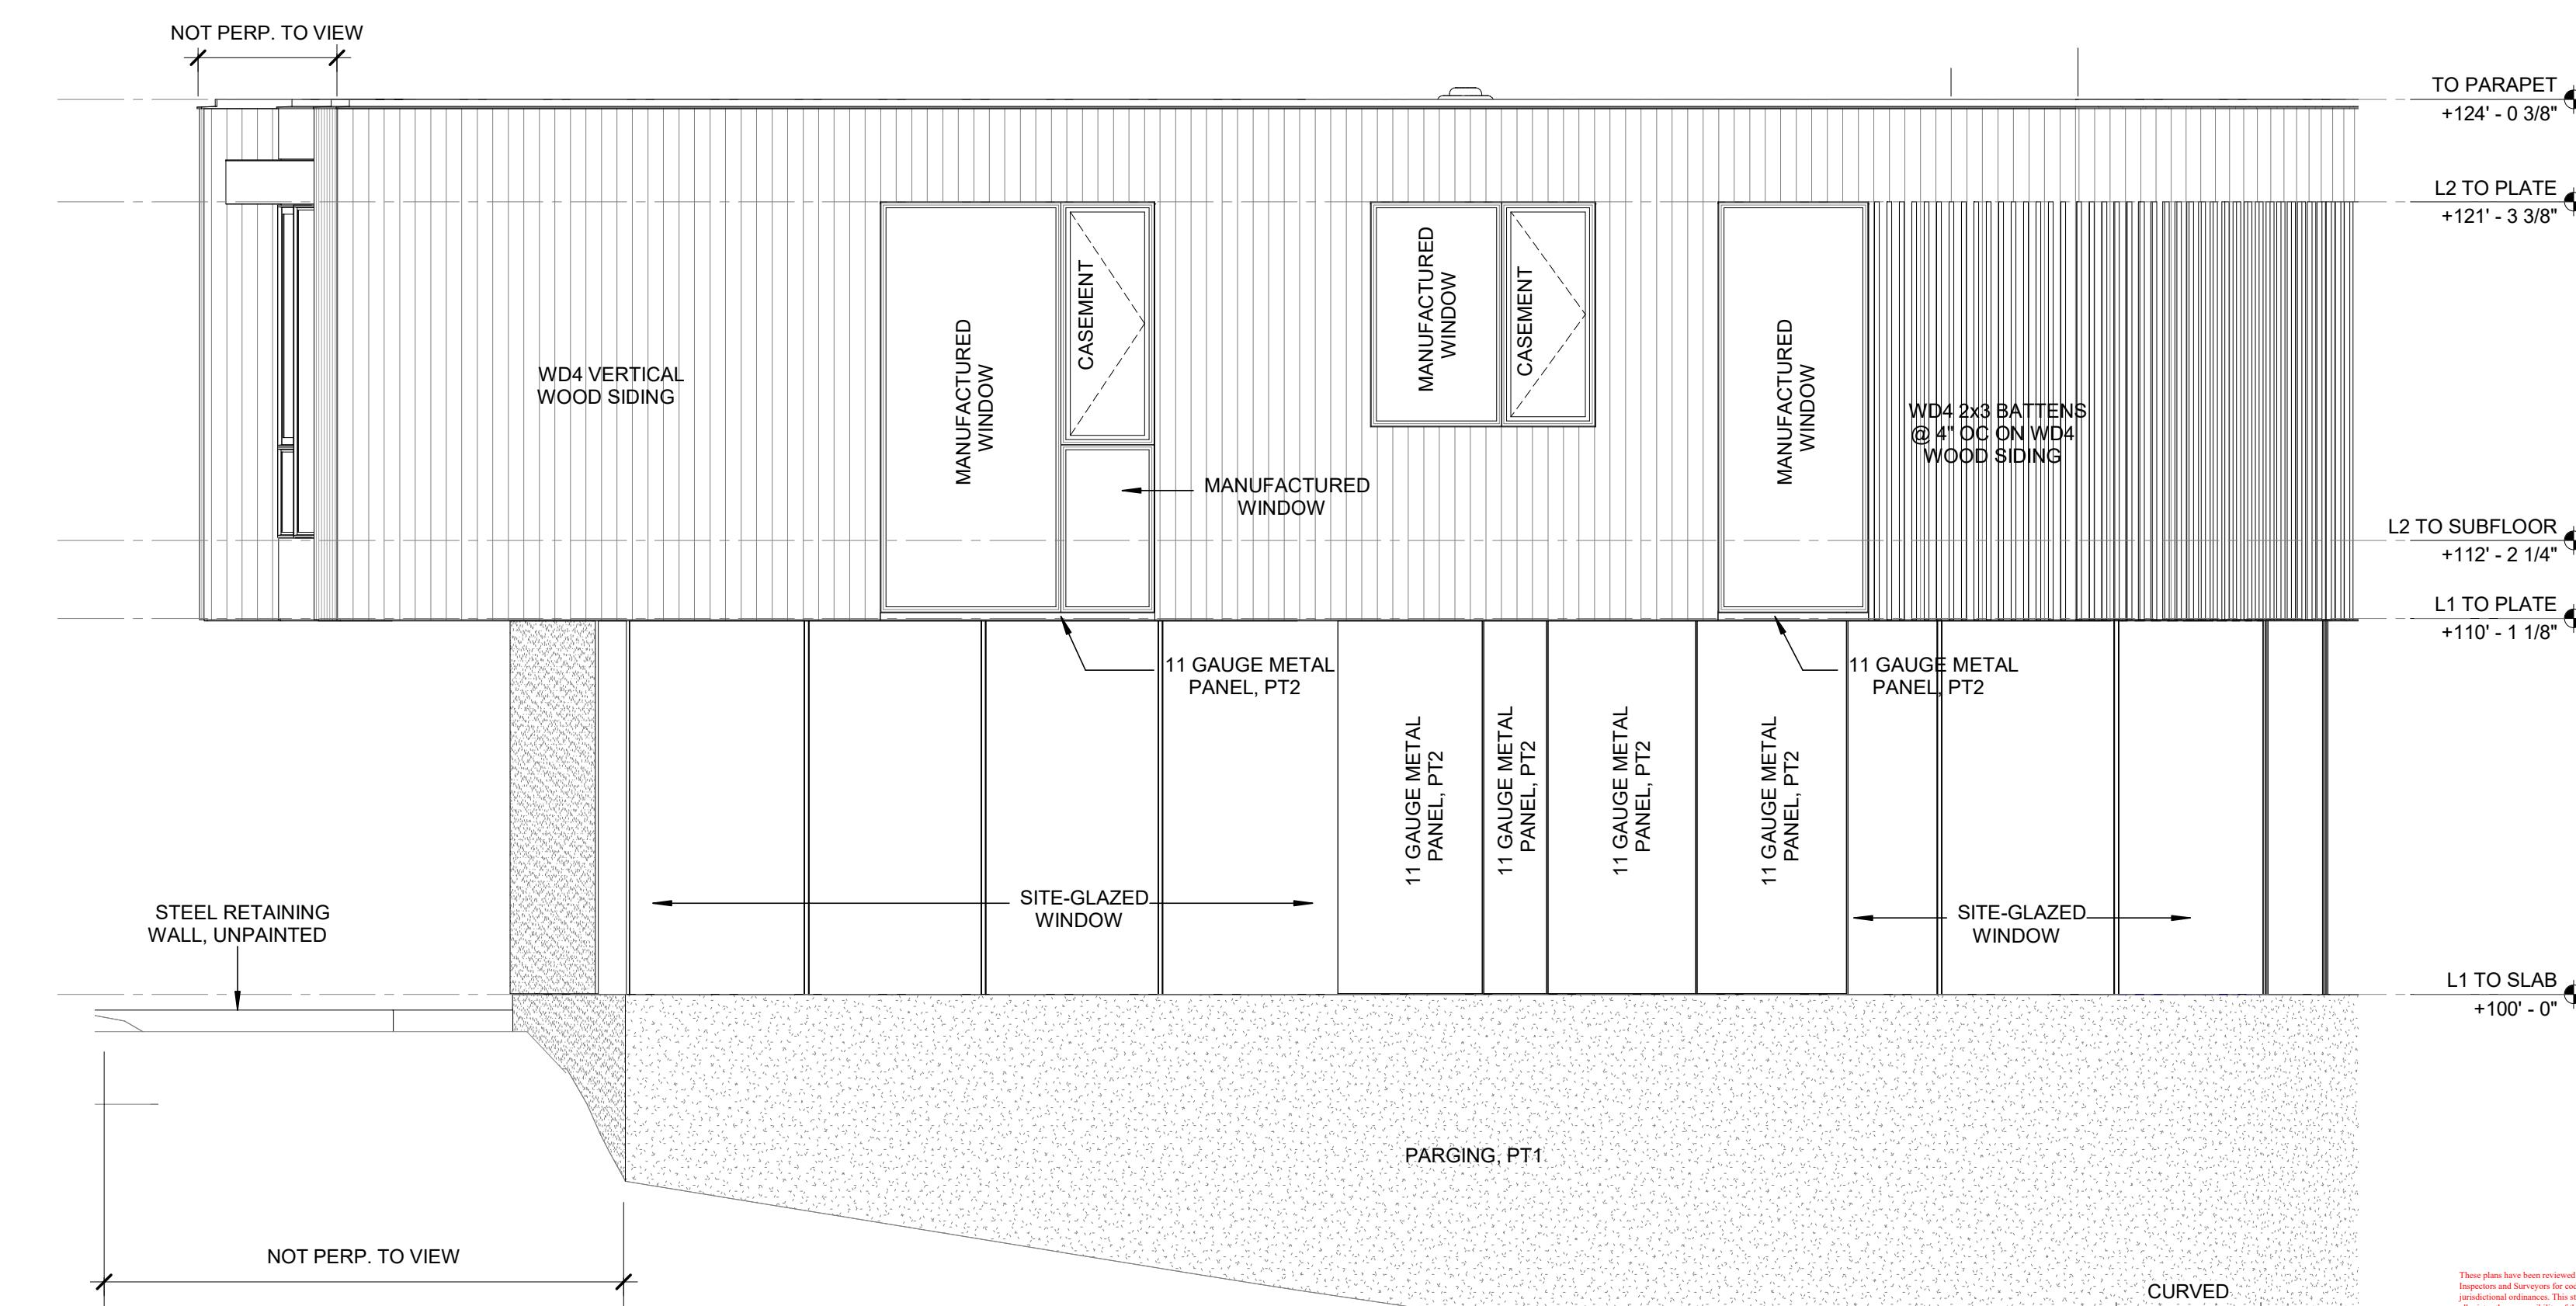

Scale: 1/4" = 1'-0"  
HALF OF NOTED SCALE WHEN PRINTED ON 12X18.  
DO NOT SCALE DRAWINGS.  
CONTACT ARCHITECT IN CASE OF DISCREPANCIES.  
THIS SHEET IS ONLY ONE COMPONENT OF THE  
TOTAL DRAWINGS AND SPECIFICATIONS.  
Copy or reproduction of this sheet without the  
written consent of the architect is illegal.

**elevations**

**A4.13**

2 north elevation - east end  
1/4" = 1'-0"



## GENERAL

- Dimensions refer to rough surfaces. The contractor must verify all dimensions and elevations prior to start of construction. The engineer of record is not liable for any discrepancies or inconsistencies.
- All drawings are considered part of the contract documents. The contractor shall be responsible for review and coordination of all drawings and specifications prior to start of construction. Any discrepancies that occur shall be brought to the attention of the engineer prior to the start of construction so that clarifications can be issued. Any work in conflict with contract documents or any code requirement shall be corrected by the contractor at his own expense and at no expense to the owner or structural engineer.
- All work shall conform to the minimum standards of the building code as well as any other regulating authority or specifications.
- The engineer shall not control and shall not be responsible for construction means, methods, techniques, sequences, or procedures; for safety precautions and programs in connection with the work, for the acts or omissions of the contractor, subcontractor, or for any persons performing the work, or for the failure of any of them.
- Site observations shall be made by the engineer for the purpose of determining if the work of the contractor is proceeding in accordance with structural contract drawings. This limited site observation should not be construed as exhaustive or continuous to check the quality of the work, but rather an effort to guard the owner against defects or deficiencies in the work of the contractor.
- All structures require periodic maintenance to extend life span and to ensure structural integrity from exposure to the environment. A planned program of maintenance shall be established by the building owner. This program shall include items such as painting of structural steel, protective coating for concrete, sealants, caulk joints, inspection for signs of cracks in concrete.
- Refer to Architectural, Mechanical, Electrical and Plumbing drawings for additional information not shown in the structural drawings. Notify engineer of any discrepancies.
- Contractor shall coordinate the requirements for building equipment supported on or from the structure. Submittals identify all equipment supported on or from the structure. Submittals identify all equipment including size, dimensions, clearances, accessibility, weights, and reactions. Any deviations from specified equipment shall be submitted in writing.
- Shop drawings shall be prepared for all structural items and submitted for review by the Engineer. Contract Drawings shall not be reproduced and used as shop drawings. All items deviating from the Contract Drawings or from previously submitted shop drawings shall be noted.
- The details designated as "Typical Details" apply generally to the Drawings in all areas where conditions are similar to those described in the details.
- The design and provision of all temporary supports required for the execution of the contract such as guys, braces, shores, resholes, fakewalls, supports and anchors are not included in these drawings and shall be the responsibility of the Contractor. Temporary supports shall not result in the overstress or damage to the structure.

## REQUIRED SUBMITTALS

- CONCRETE REBAR SHOP DRAWINGS
- CAST-IN-PLACE HOLD DOWN ANCHORS
- STRUCTURAL EMBEDS
- STEEL STRUCTURAL SHOP DRAWINGS
- PRE-ENGINEERED WOOD TRUSS SHOP DRAWINGS

## REQUIRED OBSERVATIONS BY ENGINEER OF RECORD

The structural engineer of record, or his designate, shall provide structural observation of the structural system for general conformance to the approved plans and specifications at significant construction stages:

- PREPOUR OF FOUNDATION
- STEEL FRAMING
- WOOD FRAMING, PRIOR TO BUILDING WRAP

The structural observation is an integral component of the oversight of the construction of the project. If the observations are not performed due to negligence of the owner or contractor, or the contractor does not address the issues raised by the engineer of record at the structural observation, the engineer of record is released of any claims regarding the structural design.

## SUBSTITUTIONS

All requests for substitutions of materials or details shown in the contract documents shall be submitted for approval during the bidding period. Once bids are accepted, proposed substitutions will be considered only when they are officially submitted with an identified savings to be deducted from the contract.

## BEYOND SCOPE OF STRUCTURAL ENGINEER

The following items are beyond the scope of the structural engineer and are therefore the responsibility of others. The client is responsible for arranging for the design of these systems. Any mention of these items on these drawings is for information purposes only and does not relieve the client of these responsibilities.

- Drainage systems including surface drainage, any area inlets, grate drains, french drains, and subgrade drainage pipes.
- Waterproofing systems including vapor barriers, roofing, flashing, waterproofing, and drip edges.
- Ventilation of crawlspace and attic
- Glazing design and attachment

## CODES

All work shall be performed in accordance with applicable sections of the 2015 edition of the International Residential Code (IRC 2015), and all referenced codes, specifications, and standards listed below.

- Structural Concrete: ACI 318-19 "Building Code Requirements for Reinforced Concrete"; American Concrete Institute dated April 26, 2023.
- Structural Steel: ANSI/ISC 360-16 "Specification for Structural Steel Buildings", as published in the Manual of Steel Construction 15th Edition; American Institute of Steel Construction.
- Wood Framing: ANSI/AWC NDS-2018 "National Design Specification for Wood Construction with 2018 Supplement"; American Forest and Paper Association.
- Brick and Concrete Masonry: TMS 402-2016 "Building Code Requirements for Masonry Structures"; Masonry Standards Joint Committee.

## LOADS

- Wind Loads – Main Wind Force Resisting System:

| Wind Load Design Variables            | Value    |
|---------------------------------------|----------|
| Basic Wind Speed (3 second gust, mph) | 108      |
| Exposure Category                     | B        |
| Internal Pressure Coefficient, Cpi    | +/- 0.18 |
| Topographic Factor, Kzt               | 1.0      |

- Earthquake Loads – Seismic design lateral Loads on structural frames are based on the following:

|                                           |        |
|-------------------------------------------|--------|
| a. Seismic Impact Factor                  | 1.0    |
| b. Mapped Spectral Response Accelerations | 0.064g |
| c. Site Class                             | S1     |
| d. Spectral Response Coefficients         | 0.032g |
| e. Seismic Design Category                | D      |

- Live Loads – Single Family

| Location/Element                                 | Live Load (psf)  | Remarks & Footnotes (c)                                                  |
|--------------------------------------------------|------------------|--------------------------------------------------------------------------|
| Handrails & Pedestrian Guardrails                | 50 psf or 200 lb | (a)                                                                      |
| Residential                                      | 40               |                                                                          |
| Balconies & Decks                                | ---              | 1.5 times the live load for area served. Not req'd to exceed 100 psf.    |
| Stairs & Exits – one + two family dwellings only | 40 psf or 300 lb | Stair treads per note (b)                                                |
| Roofs                                            | 20 psf or 300 lb | Area load is reducible. Point load per note (b). See below for Snow Load |
| Roof Decks/Gardens/Assembly                      | 100              | Live load (Reducible) is separate from landscape materials.              |

- Top rail shall be designed to resist 50 PLF line load or 200 lb point load applied in any direction at any point. Intermediate rails (all those except the handrail), balusters and panel/fillers shall be designed to withstand a horizontally applied normal load of 50 LB on an area not to exceed 1 ft square. These three loads are to be considered separately with worst case used for design.
- Place 300 lb concentrated load over 2'x2' area at any point to produce maximum stress. Area load and concentrated load are to be considered separately with worst case used for design.
- Unless otherwise noted, point loads to be distributed over a 2.5ft x 2.5ft area and located to produce maximum load effects on structural members.

- Dead Loads:

| Location/Element                  | Dead Load (psf)            | Remarks                                      |
|-----------------------------------|----------------------------|----------------------------------------------|
| Roofing (TPO)                     | 8                          |                                              |
| Roofing (Metal)                   | 5                          |                                              |
| Wood Softi                        | 10                         |                                              |
| Roof Total Top Chord Bottom Chord | 15 psf<br>10 psf<br>5 psf  | For pre-fabricated wood roof truss design.   |
| Roof Total Top Chord Bottom Chord | 25 psf<br>15 psf<br>10 psf | For open web steel joist design, 500 lb (a). |
| Brick Veneer                      | 50                         |                                              |
| Floor Dead (Finish)               | 25                         |                                              |
| Gypcrete Topping                  | 15                         | 1 1/2" per Architect                         |
| Concrete Topping                  | 38                         | 3" per Architect                             |

(a) Point load to be applied at any panel point on the top or bottom chord of each open web steel joist (wherever it produces the highest stress).

- Snow Loads:

| Snow Load Design Variables | Value |
|----------------------------|-------|
| Flat Roof Snow Load, psf   | 20    |
| Ground Snow Load, psf      | 5     |
| Snow Importance Factor     | 1.0   |

## BUILDING PAD (REMOVE & REPLACE)

- Building pad preparation information is based on a geotechnical report provided by Capital Geotechnical Services PLLC dated April 26, 2023.
- Prior to excavating the building pads or placing any fill soils, all organic materials, existing pavements, and other excavated materials shall be removed from planned building areas to a depth of 6" below grade. Site stripping shall include the limits of any proposed building and abutting sidewalks or flatwork, plus a horizontal distance of 3 feet beyond.
- Concrete slab to be built over a minimum of 12" of select compacted fill.
- Bottom of exterior grade beams shall be founded on 24" BELOW Grade on the downslope side of the building and 12" below Grade at other locations, unless noted otherwise on the foundation details.
- Bottom of exterior grade beams shall be free of loose deleterious fill material including topsoil, loose rocks, crushed rock, base material, water, or moist soil.
- Place imported select fill in approximately 8-inch loose lifts, watered as required and compacted to 95 percent of maximum dry density (as defined in ASTM D 698) at a moisture content within -3 to +3 percent of optimum moisture content. Compacted thickness of each lift should not exceed 6 inches.
- Gravel aggregate shall be established with a maximum size of 1 1/2" in accordance with the X-100 standard and specifications for 24" Top A, Grade 4 (Crushed Limestone Base Material). All structural fill shall be placed on prepared surfaces in lifts not to exceed eight inches loose measure with compacted thickness not to exceed six inches. The fill shall be compacted to at least 95 percent of the ASTM D 698 maximum dry density at a moisture content ranging between -2 and +3 percent of optimum moisture content.
- Where not covered by concrete flatwork or pavements, provide 2-foot-thick clay caps at overburden areas along the perimeters of slabs-on-grade over building pads, to protect from moisture intrusion. Caps shall slope away from the building.
- Provide 10-mil vapor barrier placed according to manufacturer's recommendations between the bottom of slab and the top of the fill select. Moisture barrier shall not be draped continuous across the bottom of grade beams.
- Foundation slab concrete should be placed within 2 weeks of the completion of trench excavations and the moisture barrier should be installed before any notable rainfall event. If the bearing soils are softened by surface water intrusion or disturbance, the softened soils must be removed from the foundation excavation bottom prior to concrete placement. Failure to do so may weaken the soils at the grade beam bearing level if the foundation excavation is not backfilled for an extended duration.

## CONCRETE FOOTINGS

- Foundations have been designed based on a geotechnical report provided by Capital Geotechnical Services PLLC dated April 26, 2023.
- Concrete foundation is based on the following allowable net bearing capacities:
 

|                                                   |           |
|---------------------------------------------------|-----------|
| a. Bearing 18" minimum into compacted select fill | 2,500 psf |
| b. Bearing 6" minimum into limestone              | 3,750 psf |
- Bearing stratum shown on the footing details is 30" minimum embedment into existing grade.
- Footings not specifically located on the plan shall be located on centerline of pilaster or column above. Where no pilaster or column occurs, locate on centerline of wall or beam.
- Elevation of top of footings, unless noted otherwise on drawings, is at the bottom of the deepest intersecting footings.
- Footings shall be to neat lines and shall be free of loose or wet materials.
- Concrete should be placed within 2 weeks of the completion of footings excavation and the moisture barrier should be installed before any notable rainfall event. If the bearing soils are softened by surface water intrusion or disturbance, the softened soils must be removed from the foundation excavation bottom prior to concrete placement. Failure to do so may weaken the soils at the grade beam bearing level if the foundation excavation is not backfilled for an extended duration.
- Footings shall be inspected by a representative of Fort Structures in order to ensure that the proposed bearing material has been reached in accordance with the plans and that the footing has been constructed to specified size, with detailed reinforcing, and to specified tolerances.

## CAST IN PLACE CONCRETE

- Comply with the provisions of the following latest codes, specifications, and standards, except as otherwise shown or specified:
  - ACI 301 "Specifications for Structural Concrete for Buildings".
  - ACI 311 "Recommended Practice for Concrete Inspection".
  - ACI 318 "Building Code Requirements for Reinforced Concrete".
  - ACI 347 "Recommended Practice for Concrete Footings".
  - ACI 304 "Recommended Practice for Measuring, Mixing, Transporting and Placing Concrete".
  - Concrete Reinforcing Steel Institute, "Manual of Standard Practice".
- Cast in place concrete shall meet the following requirements:

| Use/Location         | Strength f'c (psf) | Testing Age (days) | Max Aggregate Size | Exposure Class | Type | Slump |
|----------------------|--------------------|--------------------|--------------------|----------------|------|-------|
| Drilled Piers        | 3000               | 28                 | 1"                 | -              | C33  | 3"-5" |
| Footings             | 3000               | 28                 | 1"                 | -              | C33  | 3"-5" |
| Slabs on Grade       | 3000               | 28                 | 1"                 | A              | C33  | 3"-5" |
| Basement Walls       | 3000               | 28                 | 1"                 | A              | C33  | 3"-5" |
| Site Retaining Walls | 3000               | 28                 | 1"                 | A              | C33  | 3"-5" |

- Provide 3 percent plus or minus 1 1/2 percent of entrained air in concrete permanently exposed to the weather.
- Contractor shall develop and submit a hot weather concreting plan for approval. Follow ACI 305 recommendations in developing hot weather concreting plan.
- Proper consolidation shall be achieved through externally vibrating the forms, vibrating the wet concrete or by other appropriate means.
- Embedding conduits, pipes, and sleeves shall meet the requirements of ACI 318-19, Section 6.3, including the following:
  - Conduits and pipes embedded within a slab, wall, or beam (other than those passing through) shall not be larger in exterior dimension than 1/3 the overall thickness of the slab, wall, or beam in which they are embedded.
  - Conduits, pipes, and sleeves shall not be spaced closer than three diameters on center.
- Concrete pours shall not exceed 8000 square feet or 100 linear feet on each side without prior approval by the Architect for each pour or noted on plan.
- Submit: Submit proposed mix designs in accordance with ACI 301, chapter 3.9. Each proposed mix design shall be accompanied by a record of past performance based on at least 30 consecutive strength tests, or by three laboratory trial mixtures and confirmation tests.
- Contractor shall coordinate all key documents with architectural finish and specifications. Contractor shall submit concrete placing procedure for all architecturally exposed concrete.
- The contractor is responsible for correction of concrete work which does not conform to the specified requirements, including strength, tolerances, and finishes. Correct deficient concrete as directed by the architect.

## CONCRETE REINFORCEMENT

- Reinforcing steel shall be deformed new billet steel bars in accordance with ASTM A615 Grade 60.
- Detailing of reinforcing steel shall conform to the American Concrete Institute Detailing Manual.
- All hooks and bends in reinforcing bars shall conform to ACI detailing standards unless otherwise specified.
- Provide reinforcing bars in accordance with the bar bending diagram if bar types are specified. In unschedulated beams, slabs, columns, and walls detail reinforcing as follows:
  - Lap top reinforcing bars at mid span.

- Lap bottom reinforcing bars at the supports.
- Provide all vertical bars in columns and walls only at floor lines, unless noted otherwise.
- Reinforcing steel splice schedule for splice length requirement.
- Reinforcing steel labeled as continuous shall be lap spliced 38 bar diameters as a minimum, unless otherwise noted.
- Provide standard hooks in top bars at cantilever and discontinuous ends of beams, walls, and slabs.
- Provide corner bars are not required if top, bottom, or horizontal bars are hooked.
- Welding of reinforcing steel will not be permitted.
- Heat shield not be required for the fabrication or installation of reinforcement.
- Reinforcing steel clear cover shall be as follows:
 

|                                         |        |
|-----------------------------------------|--------|
| a. Concrete cast against earth          | 3"     |
| b. Concrete exposed to earth or weather | 2"     |
| c. Ties in columns and beams            | 1 1/2" |
| d. Bars in slabs                        | 3/4"   |
| e. Bars in walls                        | 3/4"   |
- Submit: Submittal shop drawings for fabrication, bending, and placement of concrete reinforcement. Comply with ACI 315 "Details and Detailing of Concrete Reinforcement". Do not reproduce the Contract Drawings for use as shop drawings.

## STRUCTURAL STEEL

- Structural Steel shall conform to ASTM A392 or A572, grade 50 except where A36 is noted on plan, except

| FORT STRUCTURES<br>SHEET SERIES LEGEND |                                |
|----------------------------------------|--------------------------------|
| SHEET SERIES                           | DESCRIPTION                    |
| S0                                     | STRUCTURAL NOTES               |
| S1                                     | AXONOMETRIC VIEWS              |
| S2                                     | PLANS                          |
| S3                                     | ELEVATIONS & BUILDING SECTIONS |
| S4                                     | FOUNDATION DETAILS             |
| S5                                     | ELEVATED CONCRETE DETAILS      |
| S6                                     | CMU DETAILS/3D PRINTED DETAILS |
| S7                                     | STEEL DETAILS                  |
| S8                                     | WOOD DETAILS                   |
| S9                                     | COLD-FORMED STEEL DETAILS      |

| STRUCTURAL SHEET LIST (23005) |                                                |
|-------------------------------|------------------------------------------------|
| SHEET NUMBER                  | SHEET NAME                                     |
| S0.01                         | STRUCTURAL GENERAL NOTES                       |
| S0.03                         | ABBREVIATIONS & LEGENDS                        |
| S1.01                         | AXONOMETRIC VIEWS                              |
| S2.02                         | FOUNDATION PLAN                                |
| S2.03                         | LEVEL 02 FRAMING PLAN                          |
| S2.04                         | ROOF FRAMING PLAN                              |
| S3.01                         | WIND BRACING PLAN                              |
| S4.01                         | TYPICAL FOUNDATION DETAILS                     |
| S4.10                         | FOUNDATION DETAILS                             |
| S4.20                         | FOUNDATION DETAILS                             |
| S7.01                         | TYPICAL BASE PLATE & HSS COLUMNS STEEL DETAILS |
| S7.02                         | TYPICAL STEEL TO WOOD DETAILS                  |
| S8.01                         | TYPICAL WOOD DETAILS                           |
| S8.02                         | TYPICAL WOOD DETAILS                           |
| S8.03                         | TYPICAL WOOD DETAILS                           |
| S8.05                         | TYPICAL WOOD SHEAR WALL DETAILS                |
| S8.10                         | WOOD FRAMING                                   |
| S8.11                         | WOOD FRAMING DETAILS                           |


Sheet Total: 18

| FORT STRUCTURES DRAWING LEGEND |                                                                        |        |                                       |
|--------------------------------|------------------------------------------------------------------------|--------|---------------------------------------|
| TAG                            | DESCRIPTION                                                            | SYMBOL | DESCRIPTION                           |
| GB1.0                          | GRADE BEAM<br>(REFER TO GRADE BEAM SCHEDULE)                           | ◀+     | POST-TENSIONED LIVE END               |
| F2.0                           | FOOTING<br>(REFER TO FOOTING SCHEDULE)                                 | —+—    | POST-TENSIONED DRAPE                  |
| SF2.0                          | STRIP FOOTING<br>(REFER TO FOOTING SCHEDULE)                           | —+—    | POST-TENSIONED DEAD END               |
| P24                            | DRILLED STRAIGHT SHAFT PIER<br>(REFER TO SCHEDULE)                     | —+—    | MATCHLINE                             |
| P24/UR48                       | DRILLED STRAIGHT SHAFT PIER WITH UNDERREAM<br>(REFER TO SCHEDULE)      | ↑      | SHORING INDICATION                    |
| SDP6                           | STEEL DRIVEN PILE<br>(REFER TO PLANS & DETAILS)                        | [A]    | ABOVE INDICATION                      |
| (PC-X)                         | PIER/PILE CAP<br>(REFER TO SCHEDULE)                                   | @      | "AT" SYMBOL WHEN INDICATING A SPACING |
| [S]                            | FOOTING/GRADE BEAM STEP                                                | ↖      | CENTERLINE INDICATION                 |
| BT-XX                          | POST-TENSIONED GRADE BEAM W/ TENDON LENGTH<br>(REFER TO SCHEDULE)      | ∅      | DIAMETER INDICATION                   |
| ST-XX                          | POST-TENSIONED SLAB ON GRADE W/ TENDON LENGTH<br>(REFER TO SCHEDULE)   | [E]    | EXISTING INDICATION                   |
| CS-WSP                         | CONTINUOUSLY SHEATHED-WOOD STRUCTURAL PANEL<br>(REFER TO SCHEDULE)     | ▶      | MOMENT CONNECTION                     |
| HD-X 4'-0" HD-X                | 4'-0" SHEAR WALL POINTS TO NAILING PATTERN SIDE<br>(REFER TO SCHEDULE) | ±      | PLUS OR MINUS INDICATION              |
| XXXX [E]type Name              | STEEL/CONCRETE COLUMN<br>(REFER TO SCHEDULE)                           | FLUSH  | FLUSH FLOOR INDICATION                |
| BP-X                           | BASEPLATE<br>(REFER TO DETAIL SCHEDULE)                                | ↙      | SLOPE/RAMP DOWN INDICATION            |
| SP-X                           | SADDLE PLATE<br>(REFER TO DETAIL SCHEDULE)                             | ↗      | SLOPE/RAMP UP INDICATION              |
| (SR-X)                         | STUD RAIL<br>(REFER TO DETAILS)                                        | ↗X     | STEP DOWN INDICATION                  |
| 1TB                            | REINFORCEMENT TYPE<br>(REFER TO SCHEDULE)                              | ↙      | ROOF RIDGE INDICATION                 |
| MD-X                           | METAL DECK SPAN DIRECTION<br>(REFER TO SCHEDULE)                       | ↙      | ROOF VALLEY INDICATION                |
| RT-X                           | RIM TRACK<br>(REFER TO SCHEDULE)                                       |        |                                       |
| T/XXX = X'-X"                  | TOP ELEVATION OF ELEMENT                                               |        |                                       |
| B/XXX = X'-X"                  | BOTTOM ELEVATION OF ELEMENT                                            |        |                                       |
| XX/SX.XX                       | SECTION VIEW<br>(DETAIL NUMBER/SHEET NUMBER)                           |        |                                       |
| XX/SX.XX                       | CALLOUT VIEW<br>(DETAIL NUMBER/SHEET NUMBER)                           |        |                                       |
| XX/SX.XX                       | ELEVATION VIEW<br>(DETAIL NUMBER/SHEET NUMBER)                         |        |                                       |
| ⚠                              | REVISION DELTA<br>(REFER TO REVISION SCHEDULE)                         |        |                                       |


| FORT STRUCTURES MATERIAL PATTERN LEGEND |                                                       |  |                                            |  |                                     |
|-----------------------------------------|-------------------------------------------------------|--|--------------------------------------------|--|-------------------------------------|
|                                         | ADDITIONAL LOADING<br>(PLANS)                         |  | GRADING (PLANS/DETAILS)                    |  | PLYWOOD (DETAILS)                   |
|                                         | CFS BEARING WALL<br>(PLANS)                           |  | GRADING UNDISTURBED<br>(PLANS/DETAILS)     |  | POUR STRIP (PLANS)                  |
|                                         | CFS NON-BEARING WALL<br>(PLANS)                       |  | GRATING (PLANS)                            |  | PRECAST CONCRETE<br>(PLANS/DETAILS) |
|                                         | CMU BEARING<br>(PLANS/DETAILS)                        |  | GRAVEL (DETAILS)                           |  | ROCK (DETAILS)                      |
|                                         | CMU NON-BEARING<br>(PLANS/DETAILS)                    |  | GROUT (DETAILS)                            |  | STEEL (DETAILS)                     |
|                                         | CAST-IN-PLACE CONCRETE BEARING<br>(PLANS/DETAILS)     |  | 3D PRINTED BEARING WALL<br>(PLANS/DETAILS) |  | WOOD BEARING WALL<br>(PLANS)        |
|                                         | CAST-IN-PLACE CONCRETE NON-BEARING<br>(PLANS/DETAILS) |  | 3D PRINTED CORE (PLANS)                    |  | WOOD NON-BEARING WALL<br>(PLANS)    |
|                                         | EXISTING (PLANS/DETAILS)                              |  | MASONRY BEARING<br>(PLANS/DETAILS)         |  |                                     |
|                                         | FILL (DETAILS)                                        |  | OVER-FRAMING (PLANS)                       |  |                                     |

| FORT STRUCTURES ABBREVIATIONS |                            |
|-------------------------------|----------------------------|
| AB                            | ANCHOR BOLT                |
| ADDL                          | ADDITIONAL                 |
| ADH                           | ADHESIVE                   |
| ADJ                           | ADJACENT                   |
| ALT                           | ALTERNATE                  |
| APPROX                        | APPROXIMATE(LY)            |
| AR                            | ANCHOR ROD                 |
| ARCH                          | ARCHITECTURAL              |
| B or BOT                      | BOTTOM                     |
| B/                            | BOTTOM OF                  |
| BCB                           | BOTTOM CHORD BEARING       |
| BF                            | BACK FACE                  |
| BFM                           | BRACE FRAME                |
| BL                            | BUILDING LINE              |
| BLDG                          | BUILDING                   |
| BLKG                          | BLOCKING                   |
| BLO                           | BLOCK-OUT                  |
| BP                            | BASE PLATE                 |
| BRDG                          | BRIDGING                   |
| BRG                           | BEARING                    |
| BRL                           | BRICK LEDGE                |
| BTW                           | BETWEEN                    |
| BWL                           | BRACE WALL LINE            |
| C                             | CAMBER                     |
| CANT                          | CANTILEVER                 |
| CBORE                         | COUNTERBORE                |
| CG                            | CENTER OF GRAVITY          |
| CIP                           | CAST-IN-PLACE              |
| CJ                            | CONSTRUCTION JOINT         |
| CJP                           | COMPLETE JOINT PENETRATION |
| CLG                           | CEILING                    |
| CLR                           | CLEARANCE                  |
| CLT                           | CROSS-LAMINATED TIMBER     |
| CMU                           | CONCRETE MASONRY UNIT      |
| COL                           | COLUMN                     |
| COM                           | COMPRESSION                |
| CONC                          | CONCRETE                   |
| COND                          | CONDITION                  |
| CONST                         | CONSTRUCTION               |
| CONT                          | CONTINUOUS                 |
| CONX                          | CONNECTION(S)              |
| COORD                         | COORDINATE                 |
| CP                            | COVER PLATE                |
| CRZ                           | Critical Root Zone         |
| CSINK                         | COUNTERSINK                |
| CTJ                           | CONTROL JOINT              |
| CTR'D                         | CENTERED                   |
| DR BEAM                       | DROPPED(ED) BEAM           |
| DBA                           | DEFORMED BAR ANCHOR(S)     |
| DBL                           | DOUBLE                     |
| DEMO                          | DEMOLISH                   |
| DEV                           | DEVELOPMENT                |
| DFIR                          | DOUGLAS FIR                |
| DIAG                          | DIAGONAL                   |
| DIM                           | DIMENSION(S)               |
| DIST                          | DISTRIBUTED                |
| DL                            | DEAD LOAD                  |
| DN                            | DOWN                       |
| DP                            | DEPTH/DEEP                 |
| DTL                           | DETAIL(S)D                 |
| DWG                           | DRAWING(S)                 |
| DWL                           | DOWEL(S)                   |
| EA                            | EACH                       |
| EF                            | EACH FACE                  |
| EJ                            | EXPANSION JOINT            |
| EL                            | ELEVATION                  |
| ELEC                          | ELECTRICAL                 |
| ELEV                          | ELEVATOR                   |
| EMBED                         | EMBEDMENT                  |
| ENG                           | ENGINEER(ED)               |
| EOR                           | ENGINEER OF RECORD         |
| EQ                            | EQUAL                      |
| EQPT                          | EQUIPMENT                  |
| EW                            | EACH WAY                   |
| EXIST                         | EXISTING                   |
| EXP                           | EXPANSION                  |
| EXT                           | EXTERIOR                   |
| F/                            | FACE OF                    |
| FAB                           | FABRICATE(ION)ED           |
| FD                            | FLOOR DRAIN                |
| FF                            | FINISHED FLOOR             |
| FIN                           | FINISHED(ED)               |
| FL                            | FLOOR                      |
| FLG                           | FLANGE                     |
| FND                           | FOUNDATION                 |
| FP                            | FIREPROOFING               |
| FRM                           | FRAMING                    |
| FRT                           | FIRE RETARDANT TREATED     |
| FS                            | Far Side                   |
| FSTN                          | FASTEN(ER)ED               |
| FTF                           | FACE TO FACE               |
| FTG                           | FOOTING                    |
| GAGE                          | GAGE                       |
| GALV                          | GALVANIZED(ED)             |
| GC                            | GENERAL CONTRACTOR         |
| GEN                           | GENERAL                    |
| GEO                           | GEOTECHNICAL               |
| GL                            | GLUE LAMINATED TIMBER      |
| GR                            | GRADE                      |
| GR BEAM                       | GRADE BEAM                 |
| GYP                           | GYPSUM BOARD               |
| H                             | RADIUS                     |
| RCP                           | REINFORCED CONCRETE PIPE   |
| RD                            | ROOF DRAIN                 |
| RECT                          | RECTANGULAR                |
| REF                           | REFER/REFERENCE            |
| REINF                         | REINFORCING(ED)MENT        |
| REM                           | REMAINDER                  |
| REQ                           | REQUIRED                   |
| RET                           | RETAINING                  |
| RF                            | ROOF                       |
| RND                           | ROUND                      |
| RO                            | ROUGH OPENING              |
| RT                            | RIM TRACK                  |
| SCHED                         | SCHEDULE(D)                |
| SDP                           | STEEL DRIVEN PILE          |
| SP                            | SQUARE FOOT                |
| SHTHG                         | SHEATHING                  |
| SIM                           | SIMILAR                    |
| SLBB                          | SHORT LEG BACK TO BACK     |
| SMF                           | SPECIAL MOMENT FRAME       |
| SOG                           | SLAB ON GRADE              |
| SPD                           | SADDLE PLATE               |
| SPA                           | SPACE(D)ING)               |
| SPEC                          | SPECIFICATIONS             |
| SPED                          | SPECIFIED                  |
| SPINE                         | SOUTHERN PINE              |
| SQ                            | SQUARE                     |
| SR                            | STUDRAIL                   |
| SS                            | STAINLESS STEEL            |
| STAGG                         | STAGGERED                  |
| STD                           | STANDARD                   |
| STIFF                         | STIFFENER                  |
| STIR                          | STIRRUPS                   |
| STL                           | STEEL                      |
| STR                           | STRAIGHT                   |
| STRUCT                        | STRUCTURE(AL)              |
| SUPT                          | SUPPORT(S)                 |
| T                             | TOP                        |
| T/                            | TOP OF                     |
| T&B or TB                     | TOP AND BOTTOM             |
| TC AX LD                      | TOP CHORD AXIAL LOAD       |
| TCB                           | TOP CHORD BEARING          |
| TCX                           | TOP CHORD EXTENSION        |
| TDS                           | TIE DOWN SYSTEM            |
| T&G                           | TONGUE AND GROOVE          |
| THK                           | THICKNESS                  |
| THRD                          | THREADED                   |
| TPG                           | TOPPING                    |
| TRANSV                        | TRANSVERSE                 |
| TYP                           | TYPIICAL                   |
| UBC                           | UNIFORM BUILDING CODE      |
| UMU                           | UNREINFORCED MASONRY UNIT  |
| UNO                           | UNLESS NOTED OTHERWISE     |
| UR                            | UNDER-REAM                 |
| V                             | Shear Force                |
| VERT                          | Vertical                   |
| VIF                           | VERIFY IN FIELD            |
| VOL                           | VOLUME                     |
| W                             | WIDE                       |
| W/                            | WITH                       |
| WB                            | WIND BRACE                 |
| WHS                           | WELDED HEADED STUD         |
| WL                            | WIND LOAD                  |
| W/O                           | WITHOUT                    |
| WP                            | WORK POINT                 |
| WPR                           | WATER PROOFING             |
| WS                            | WATER STOP                 |
| WWF                           | WELDED WIRE FABRIC         |
| XS                            | EXTRA STRONG               |
| XXS                           | EXTRA EXTRA STRONG         |
| P                             | AXIAL LOAD                 |
| PAF                           | POWER ACTUATED FASTENER    |
| PC                            | PIER/PILE CAP              |
| P/C                           | PRECAST CONCRETE           |
| P/CY                          | POUNDS PER CUBIC FOOT      |
| PCY                           | POUNDS PER CUBIC YARD      |
| PEN                           | PENETRATION                |
| PERP                          | PERFORATED                 |
| PERP.                         | PERPENDICULAR              |
| PJP                           | PARTIAL JOINT PENETRATION  |
| PL                            | PLATE                      |
| PLF                           | POUNDS PER LINEAR FOOT     |
| PLYWD                         | PLYWOOD                    |
| PREFAB                        | PREFABRICATED              |
| PRELIM                        | PRELIMINARY                |
| PSF                           | POUNDS PER SQUARE FOOT     |
| PSI                           | POUNDS PER SQUARE INCH</td |

**AXONOMETRIC VIEWS**  
Axonometric views are for **REFERENCE ONLY** and are  
provided solely as a **VISUAL AID**. All structural information  
shall **ONLY** be obtained from the plans and details.

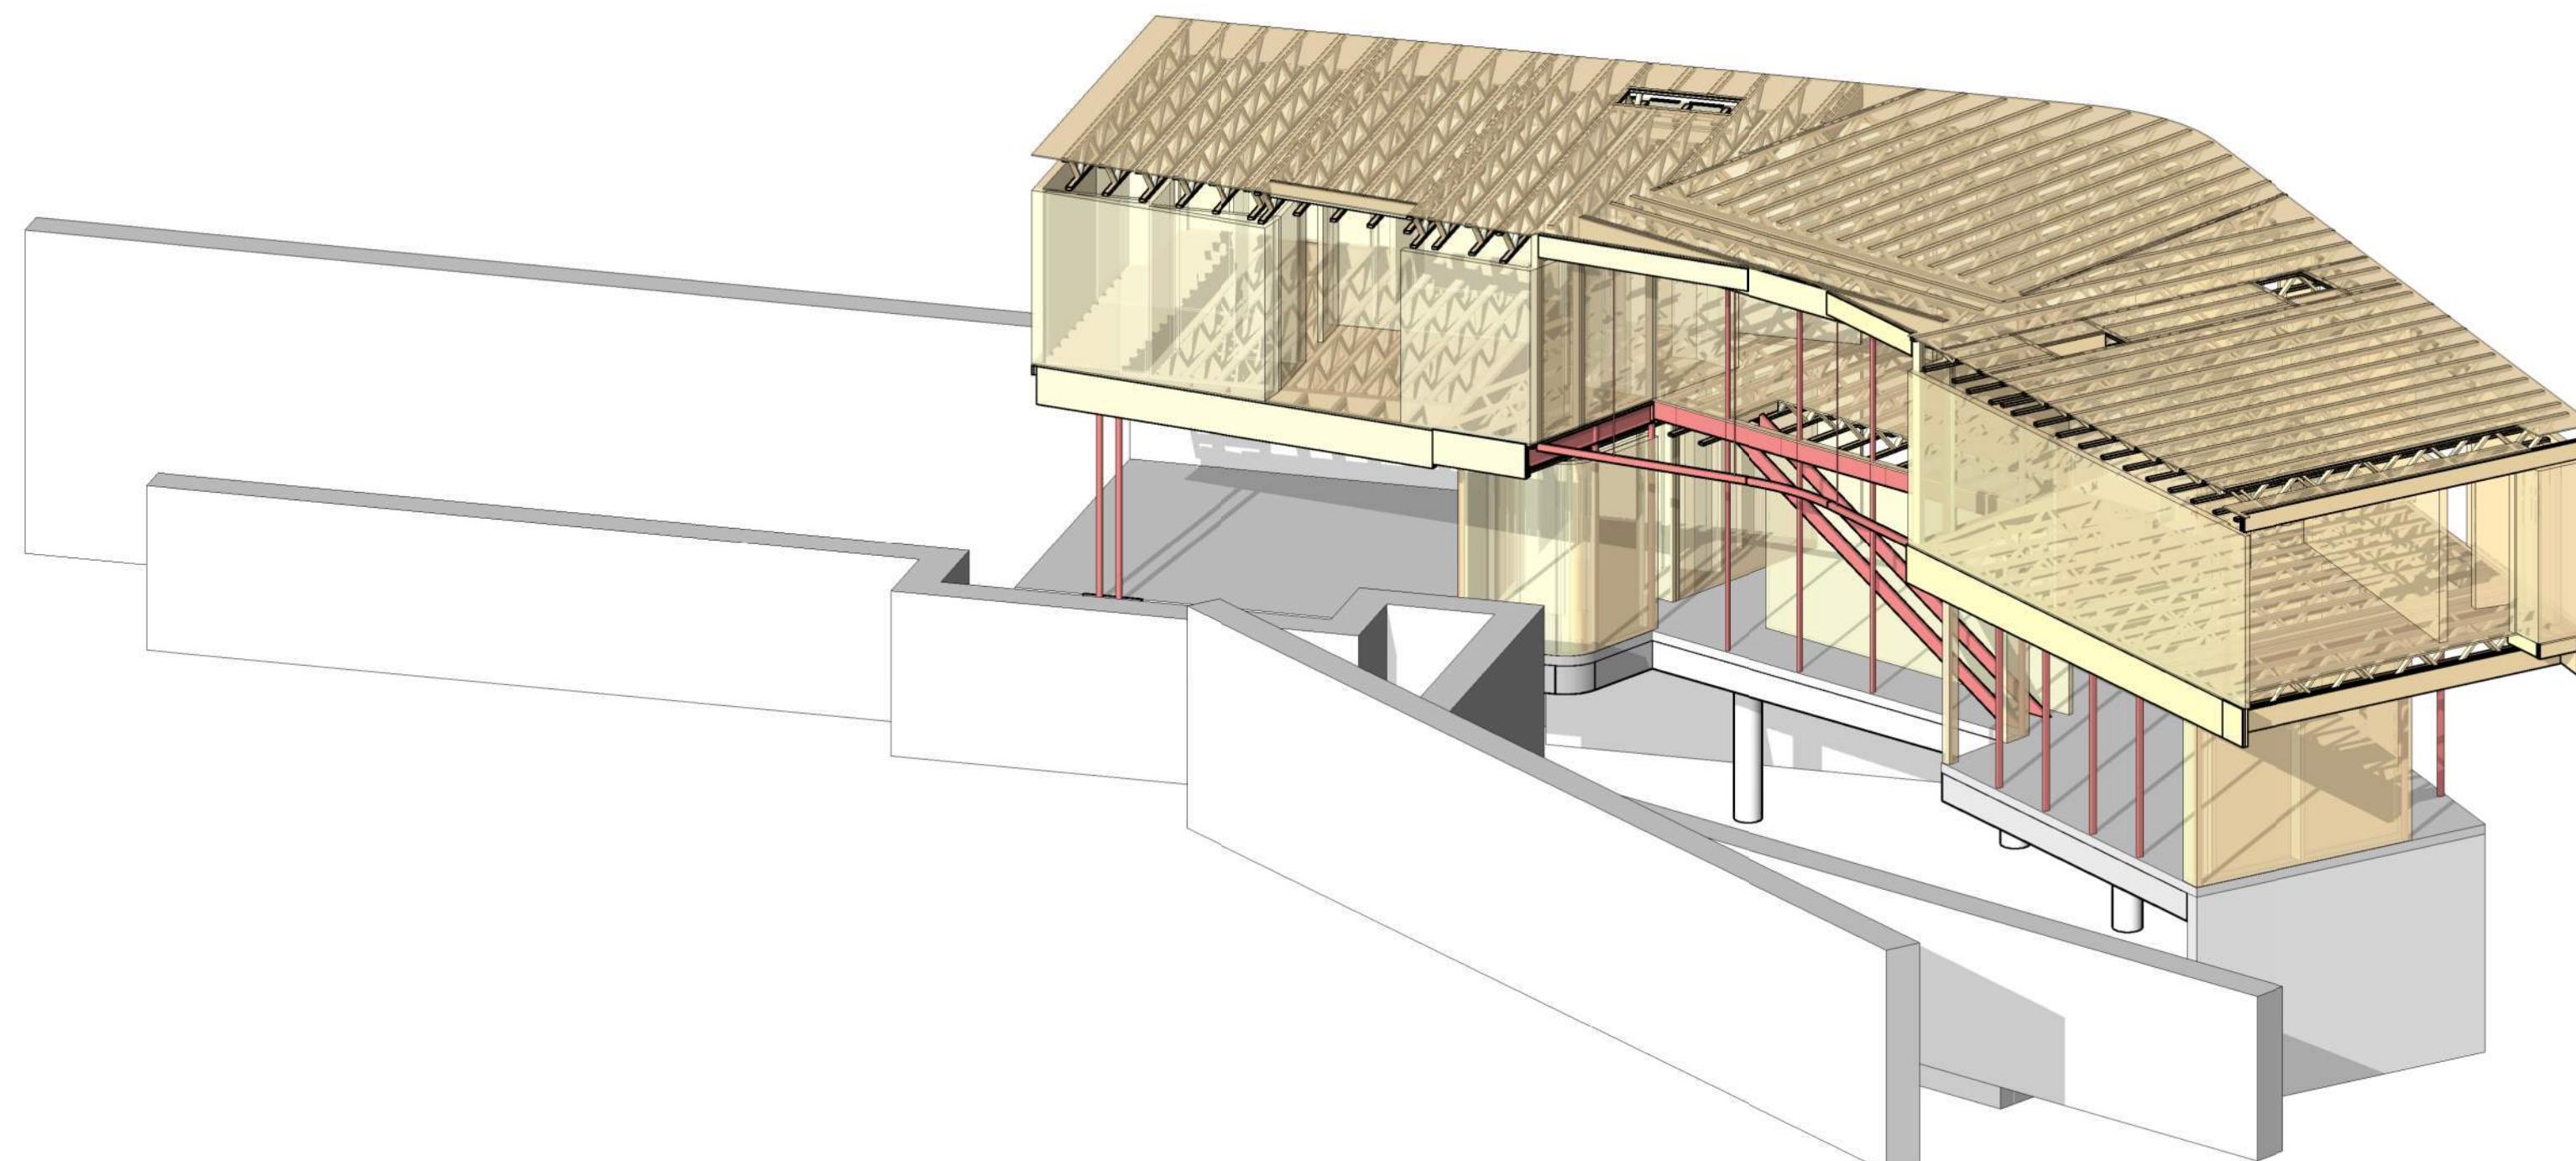

AXONOMETRIC 01  
SCALE: NTS

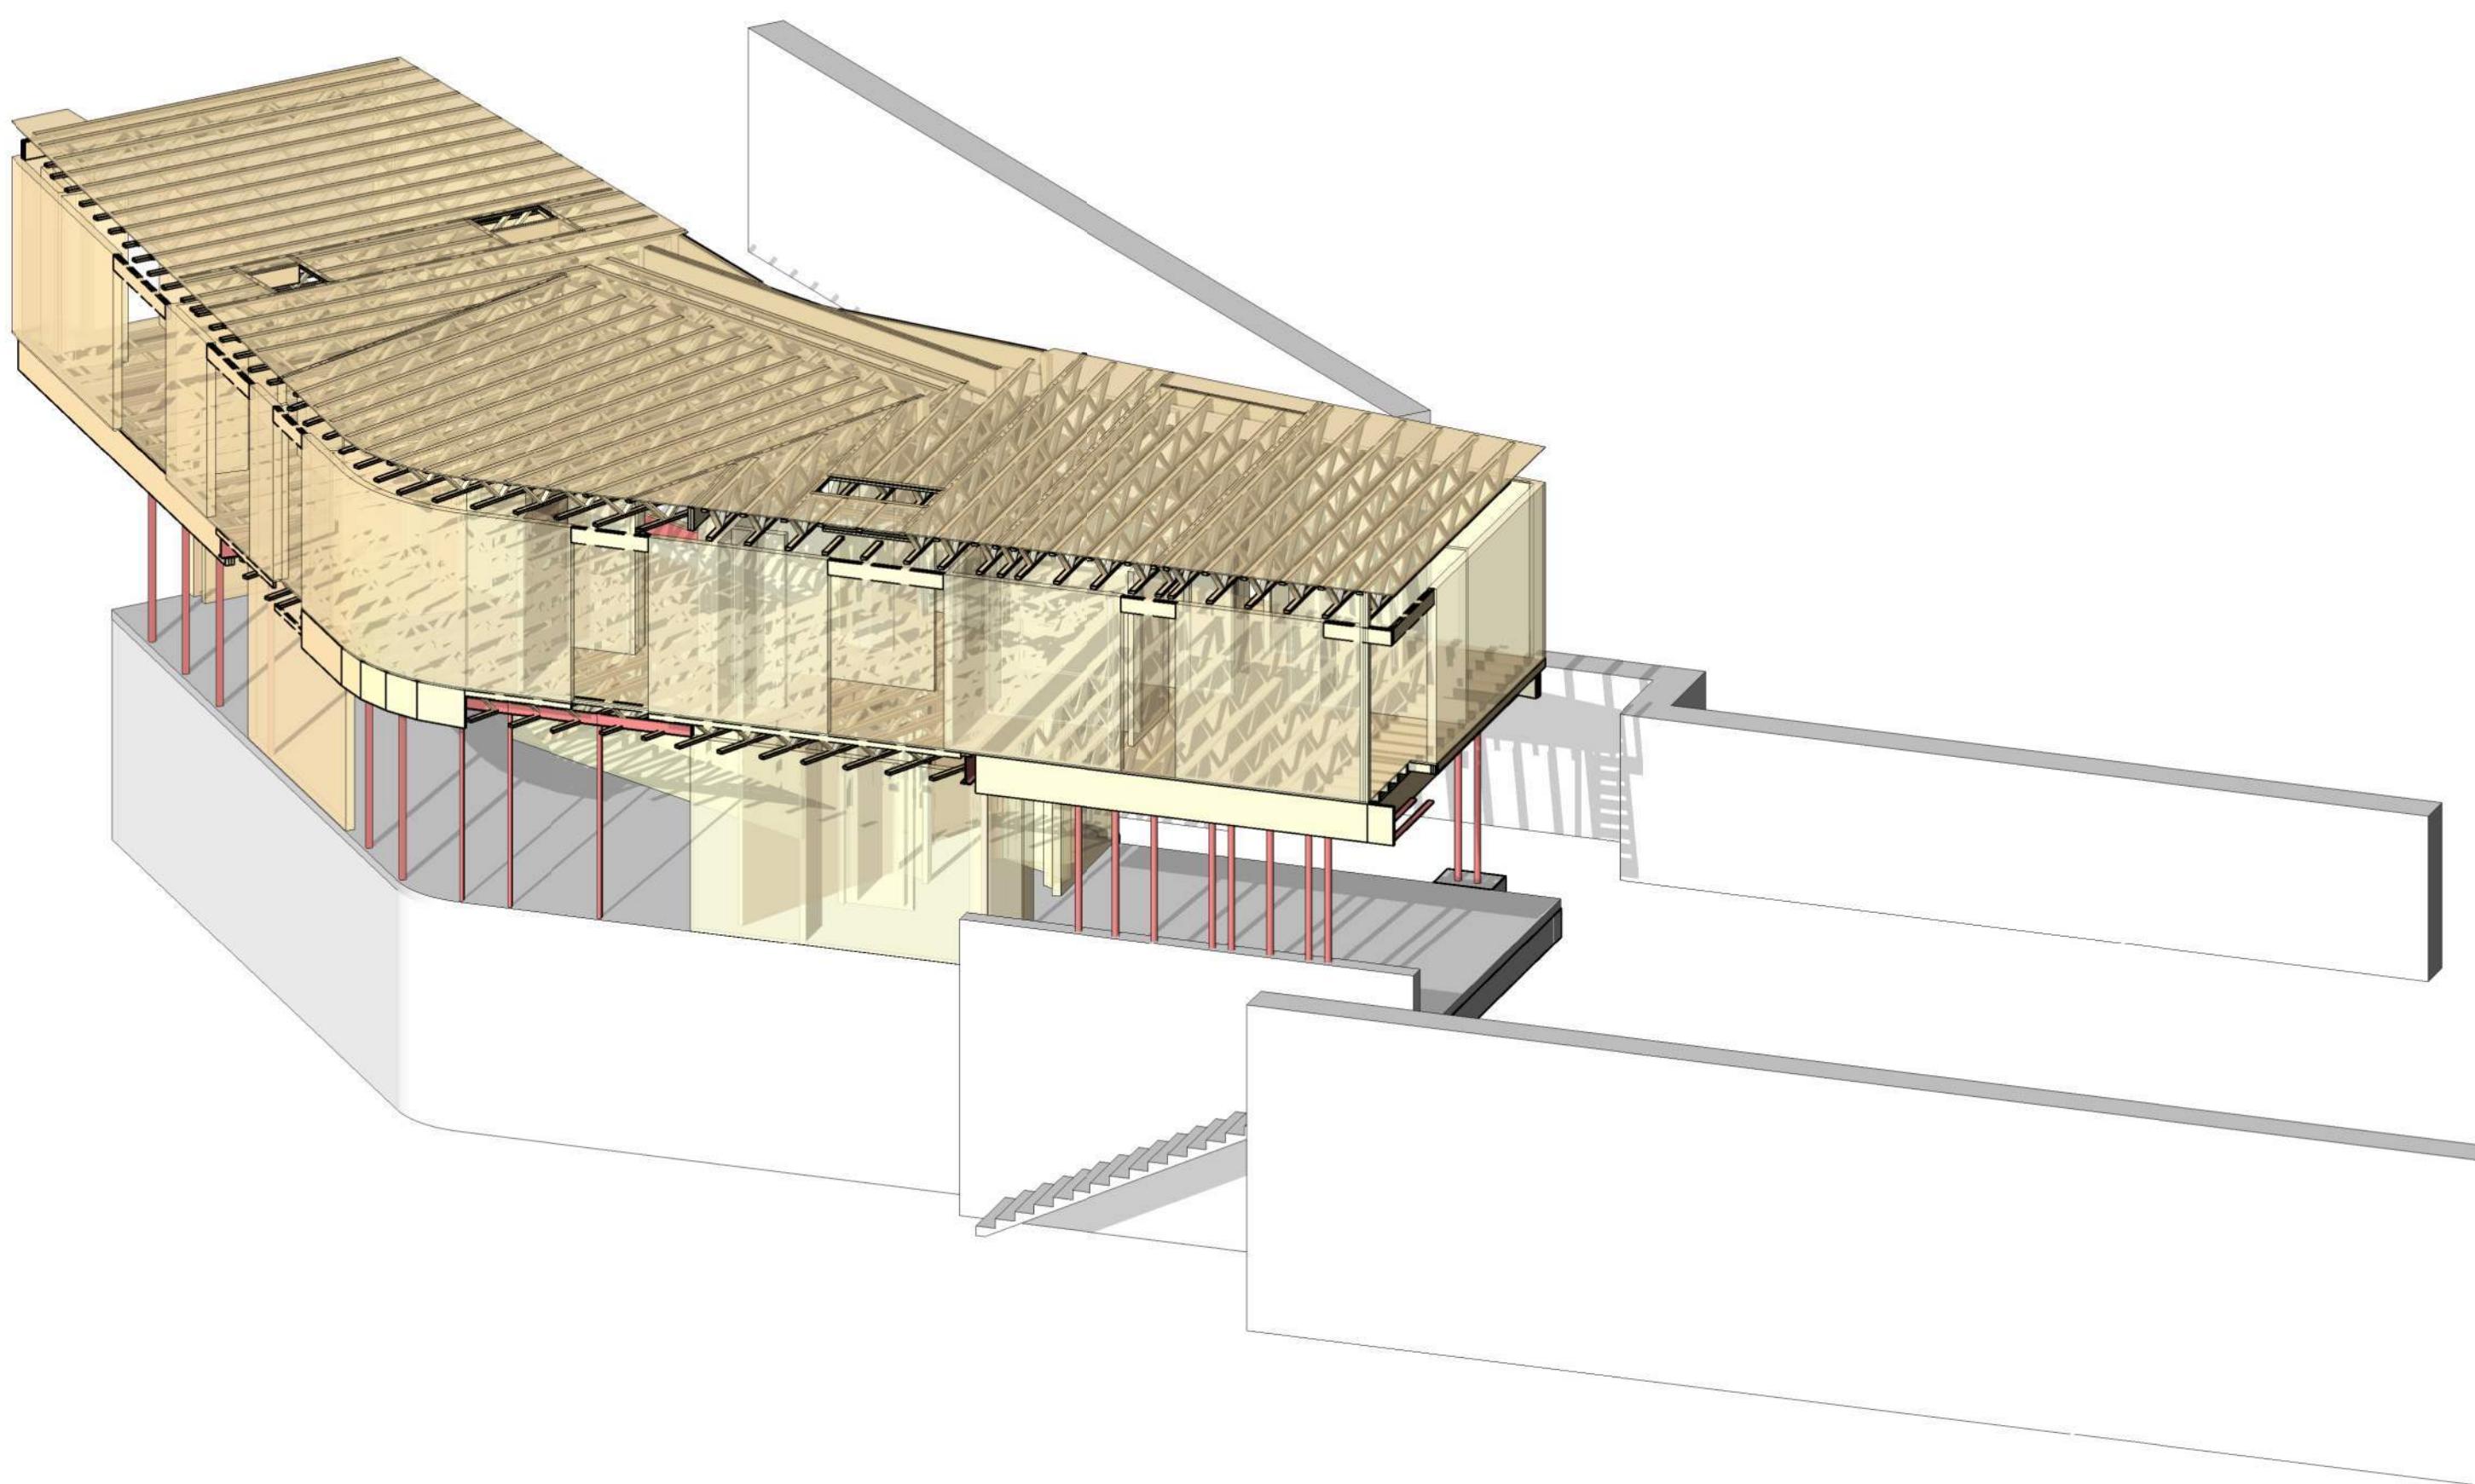

AXONOMETRIC 02  
SCALE: NTS

PERMIT DOCUMENTS

**S1.01**


SHEET NUMBER

| NO                 | ISSUE | DATE |
|--------------------|-------|------|
| PM: S. Young       |       |      |
| ENG: S. Young      |       |      |
| BIM PM: C Lawrence |       |      |
| QA/QC: S Covey     |       |      |

If printed on 22x34 or 24x36 sheet,  
the scale is as indicated.  
If printed on an 11x17 or 12x18  
sheet, the scale is reduced by half. **SCALE**

**AXONOMETRIC VIEWS**

SHEET TITLE

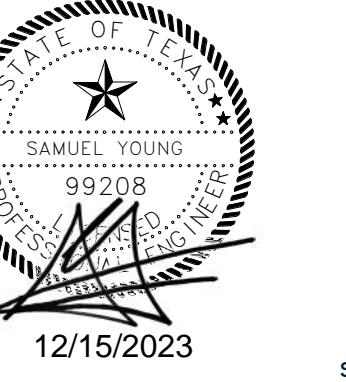

5/2023

— 1 —

**ALTERSTUDIO  
ARCHITECTURE LLP**  
301 Lavaca Street  
Suite 106  
Austin, Texas 78701


ARCHITECT

---

7363 E Reed Parks Rd  
Jonestown, Texas 78645

PERMIT SET  
12.15.2023

# PERMIT SE

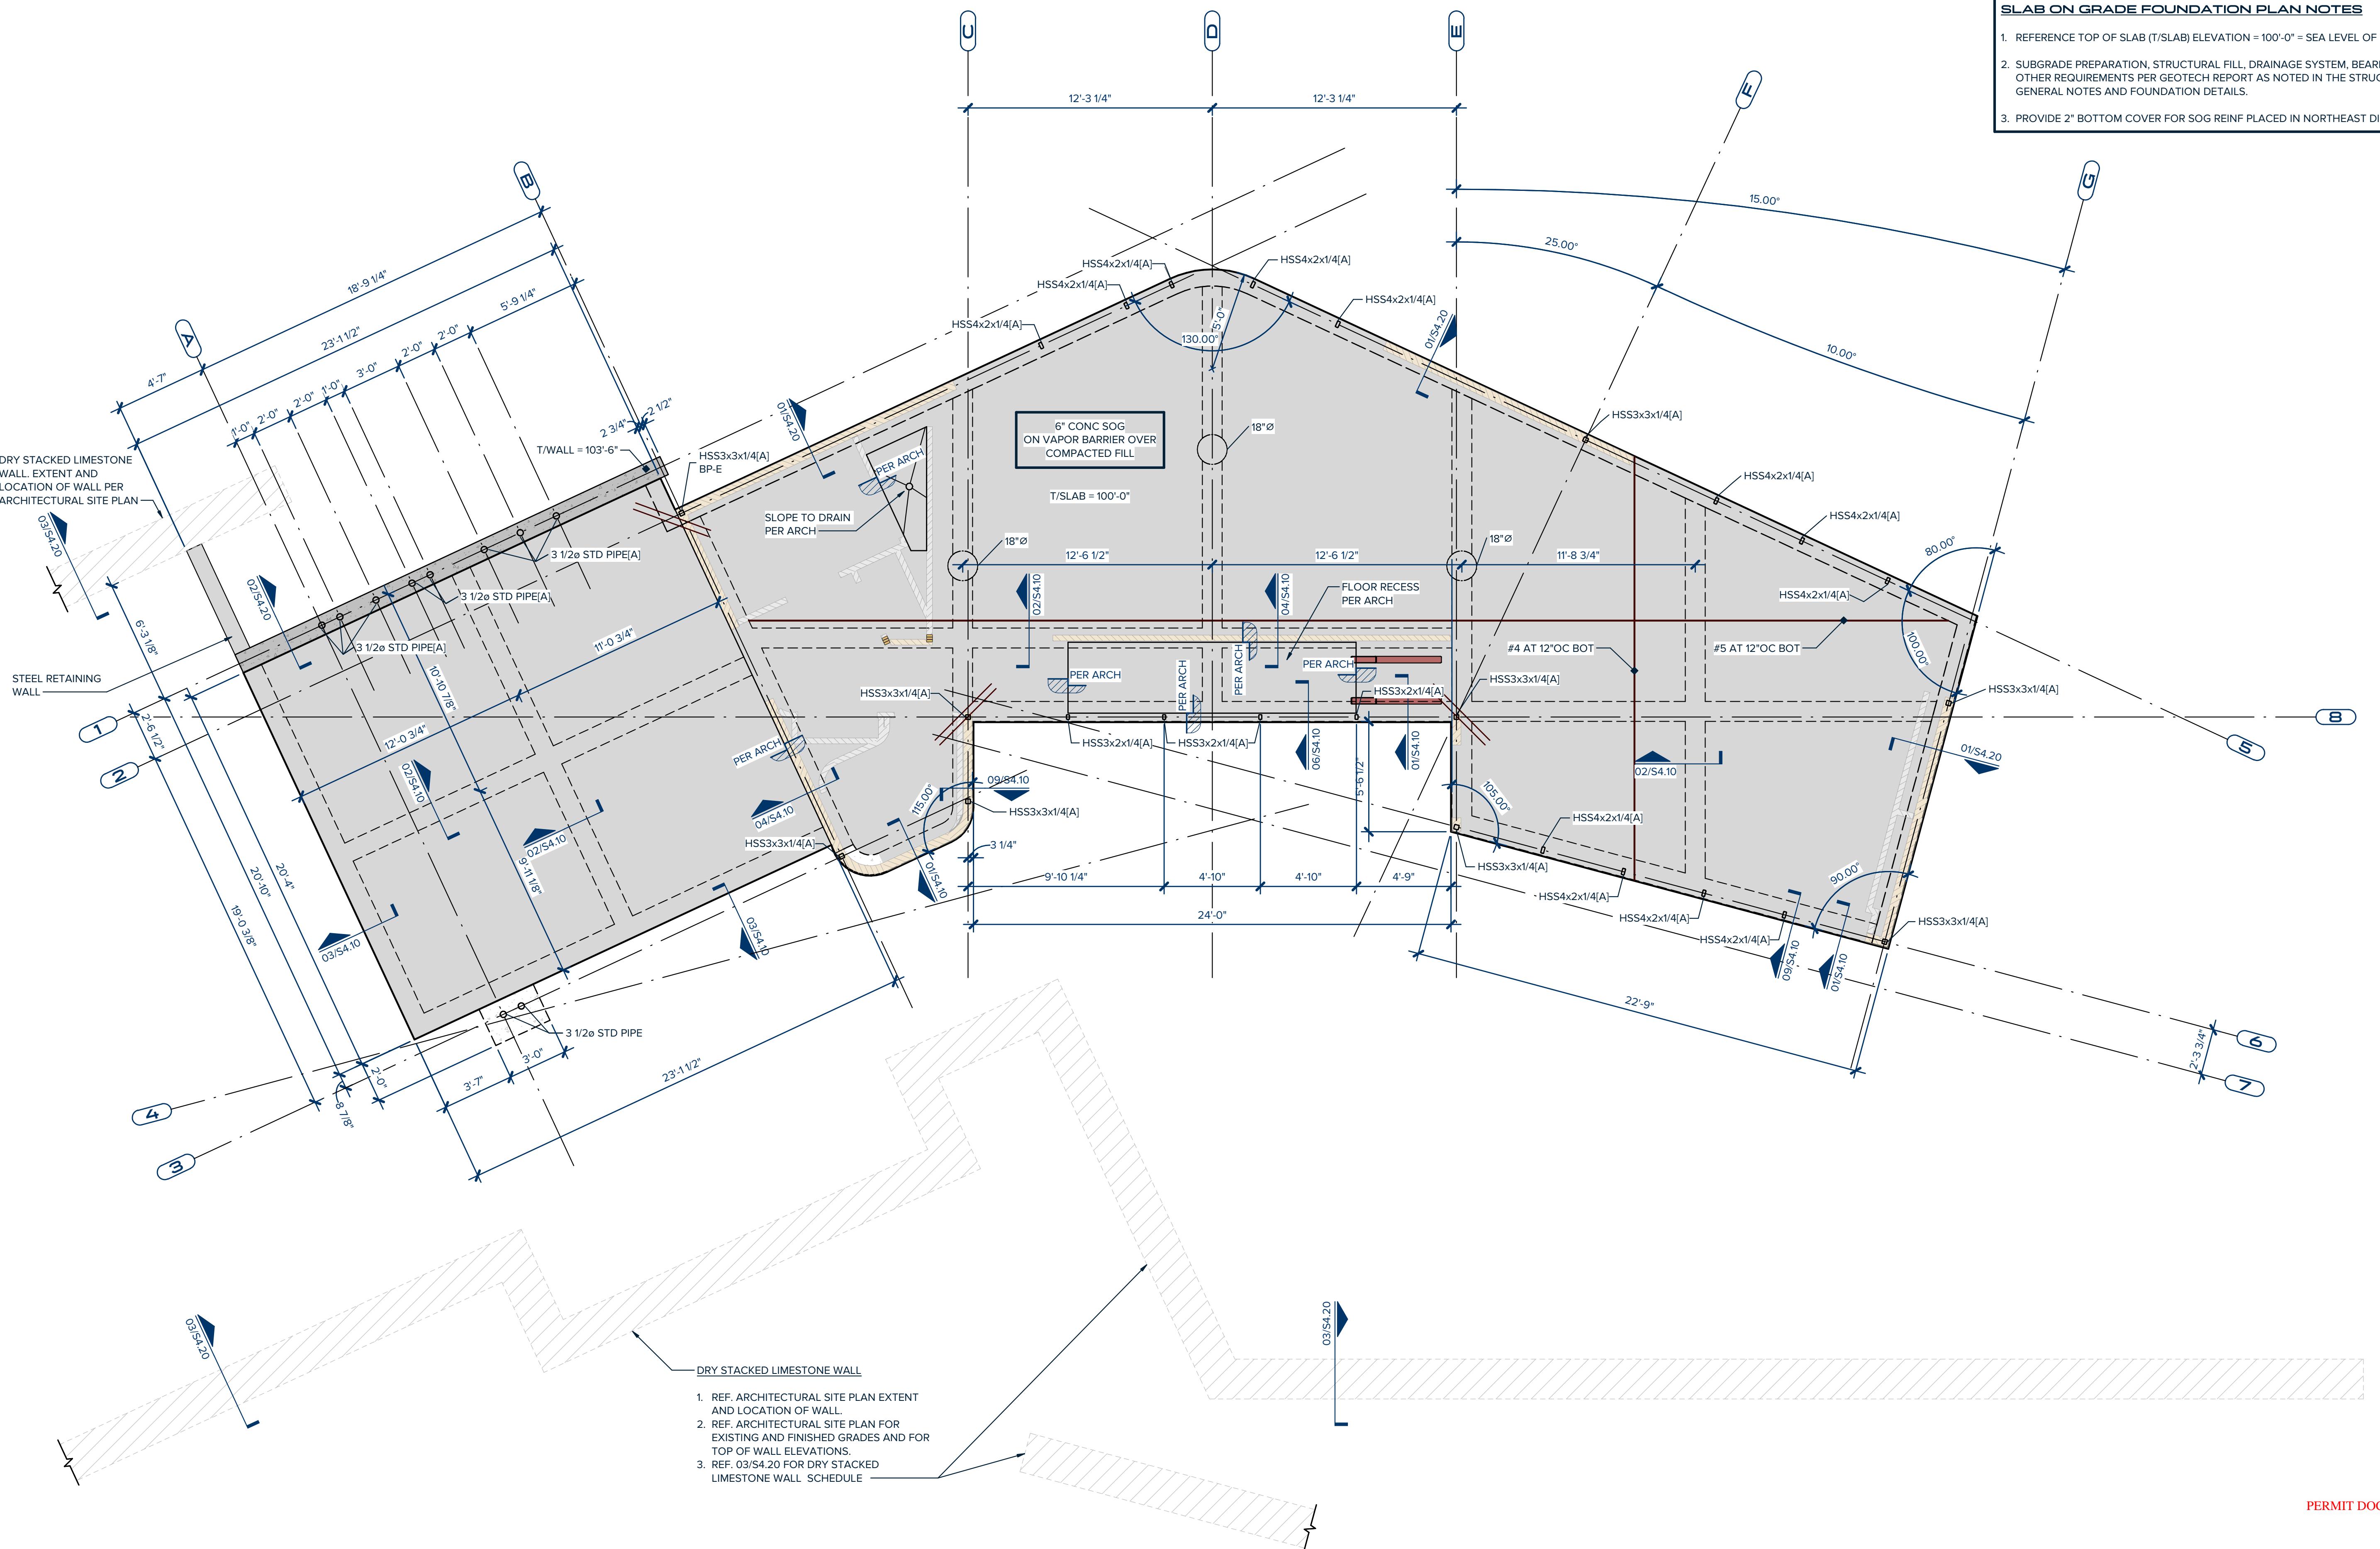

## PERMIT DOCUMENTS

| NO                 | ISSUE | DATE |
|--------------------|-------|------|
| PM: S. Young       |       |      |
| ENG: S. Young      |       |      |
| BIM PM: C Lawrence |       |      |
| QA/QC: S Covey     |       |      |

sheet, the scale is reduced by half. SCALE

## FOUNDATION PLAN

## FOUNDATION PLAN

## FOUNDATION PLAN

---

SHEET TITLE

62 63


52.02

SHEET NUMBER

## FOUNDATION PLAN

LE : 1/4" = 1'-0"

COPYRIGHT © 2023 FORT STRUCTURES

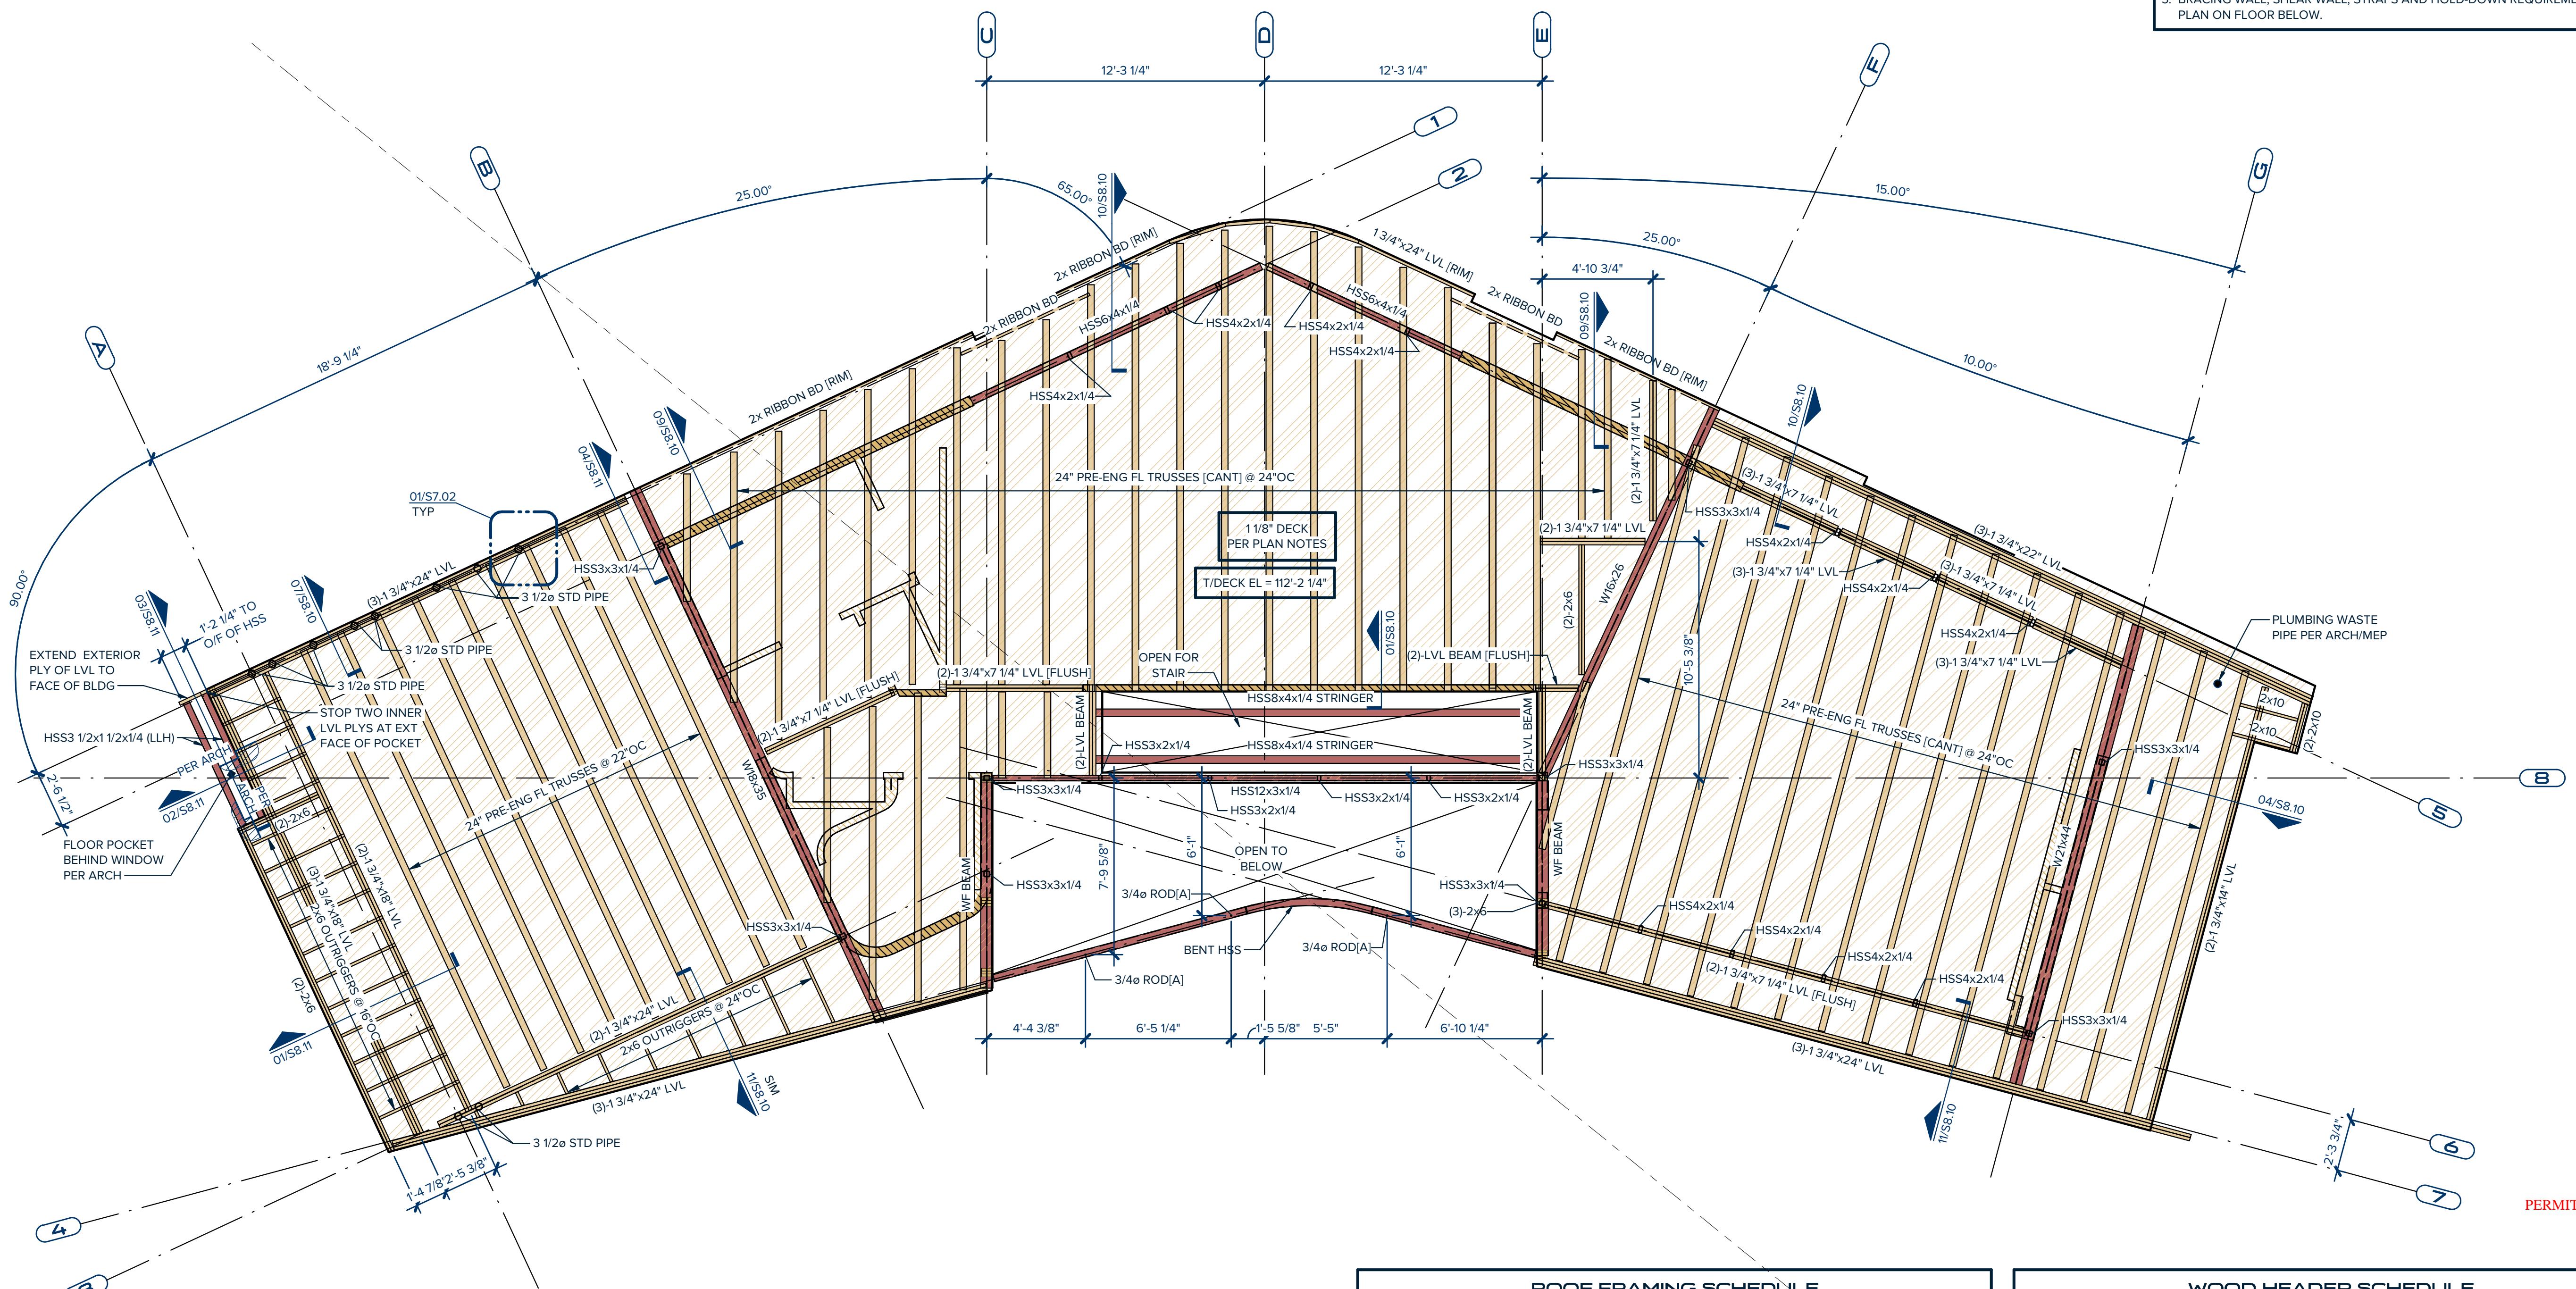

COMMON PLAN NOTES

- STRUCTURAL GENERAL NOTES, ABBREVIATIONS, AND LEGEND PER S1 SHEET SERIES.
- VERIFY ALL DIMENSIONS, ELEVATIONS, FINISH SURFACES, SLOPES, DRAINS, DEPRESSIONS, CURBS, PENETRATIONS, ETC. WITH ARCHITECTURAL AND OTHER CONSULTANT DRAWINGS PRIOR TO CONSTRUCTION.
- ALL DUCTS, CHASES AND PIPES SHALL BE PER MECHANICAL, PLUMBING, ELECTRICAL AND SPRINKLER DRAWINGS.

WOOD FRAMING PLAN NOTES

- PRE-ENGINEERED TRUSSES TO BE DESIGNED BY TRUSS MANUFACTURER AND SHALL COORDINATE TRUSS DESIGN AND PROFILES WITH HVAC UNIT SIZES AND LOCATIONS. SUBMITTAL INFORMATION, DESIGN CRITERIA, RIM JOIST AND BLOCKING REQUIREMENTS PER STRUCTURAL GENERAL NOTES.
- DECK AND ATTACHMENT PER PLAN AND STRUCTURAL GENERAL NOTES.
- ALL WOOD EXPOSED TO CONCRETE, WEATHER, OR WITHIN 8" OF FINISHED GRADE SHALL BE PRESSURE-TREATED.
- REFERENCE TYPICAL WOOD DETAILS FOR HANGER SCHEDULE.
- BRACING WALL, SHEAR WALL, STRAPS AND HOLD-DOWN REQUIREMENTS PER BRACING PLAN ON FLOOR BELOW.

ALTERSTUDIO  
ARCHITECTURE LLP  
1801 Lavaca Street  
Ste 106  
Austin, Texas 78701

ARCHITECT  
KOS RESIDENCE

17363 E Reed Parks Rd  
Jonestown, Texas 78645

PERMIT SET  
12.15.2023

ROOF FRAMING SCHEDULE

| MEMBER TYPE  | MEMBER SIZE | SPACING | ADDITIONAL INFORMATION |
|--------------|-------------|---------|------------------------|
| RAFTERS      | 2x8         | 24"OC   | UNO, XX-X MAX SPAN     |
| RIDGE        | 2x10        | -       | UNO, XX-X MAX SPAN     |
| HIPS/VALLEYS | 2x10        | -       | UNO                    |

NOTES

- SPAN IS CLEAR SPAN BETWEEN SUPPORTS.

WOOD HEADER SCHEDULE

| SUPPORTING | SPAN < 3'-6"                               | SPAN 3'-6" - 6'-0"                         | ADDITIONAL INFORMATION                                      |
|------------|--------------------------------------------|--------------------------------------------|-------------------------------------------------------------|
| ROOF       | 2x4 WALL - (2)-2x6<br>2x6 WALL - (3)-2x6   | 2x4 WALL - (2)-2x8<br>2x6 WALL - (3)-2x8   | • ALL HEADERS TO BE SUPPORTED BY (2)-2x STUD PACK, MINIMUM. |
| FLOOR      | 2x4 WALL - (2)-2x10<br>2x6 WALL - (3)-2x10 | 2x4 WALL - (2)-2x12<br>2x6 WALL - (3)-2x12 | • HDR ON PLAN INDICATES SCHEDULED HEADERS                   |

NOTES

- SPAN IS CLEAR SPAN BETWEEN SUPPORTS.

WOOD CEILING JOIST SCHEDULE

| SPAN     | MEMBER SIZE | SPACING | ADDITIONAL INFORMATION |
|----------|-------------|---------|------------------------|
| < 9'-0"  | 2x6         | 24"OC   | TYP, UNO               |
| < 12'-0" | 2x8         | 24"OC   | TYP, UNO               |
| < 14'-0" | 2x10        | 24"OC   | TYP, UNO               |

NOTES

- SPAN IS CLEAR SPAN BETWEEN SUPPORTS.
- ALL CEILING JOISTS ARE NOT DESIGNED TO SUPPORT ATTIC LOADING OR MECHANICAL LOADING.

WOOD STUD WALL SCHEDULE

| WALL TYPE | HEIGHT < 10'-0" | 10'-0" > HEIGHT < 12'-0" | 12'-0" > HEIGHT < 14'-0" | ADDITIONAL INFORMATION |
|-----------|-----------------|--------------------------|--------------------------|------------------------|
| EXT WALLS | 2x6 @ 16"OC     | 2x6 @ 12"OC              | 13/4x5 1/2"LSL @ 16"OC   | TYP, UNO               |
| INT WALLS | 2x4 @ 16"OC     | 2x4 @ 12"OC              | 2x6 @ 16"OC              | TYP, UNO               |

NOTES

- ALL LOAD BEARING WALLS ARE INDICATED ON FRAMING PLANS.
- ALL LOAD BEARING WALL STUDS SHALL BE GRADE NO2 SOUTHERN PINE OR DOUGLAS-FIR, MINIMUM.
- ALL OTHER NON-BEARING WALL STUDS SHALL BE 2x4 @ 16"OC, STUD GRADE SOUTHERN PINE OR DOUGLAS-FIR.

S2.03






ALTERSTUDIO  
ARCHITECTURE LLP  
1801 Lavaca Street  
Ste 106  
Austin, Texas 78701

ARCHITECT  
KOS RESIDENCE

17363 E Reed Parks Rd  
Jonestown, Texas 78645

PERMIT SET  
12.15.2023

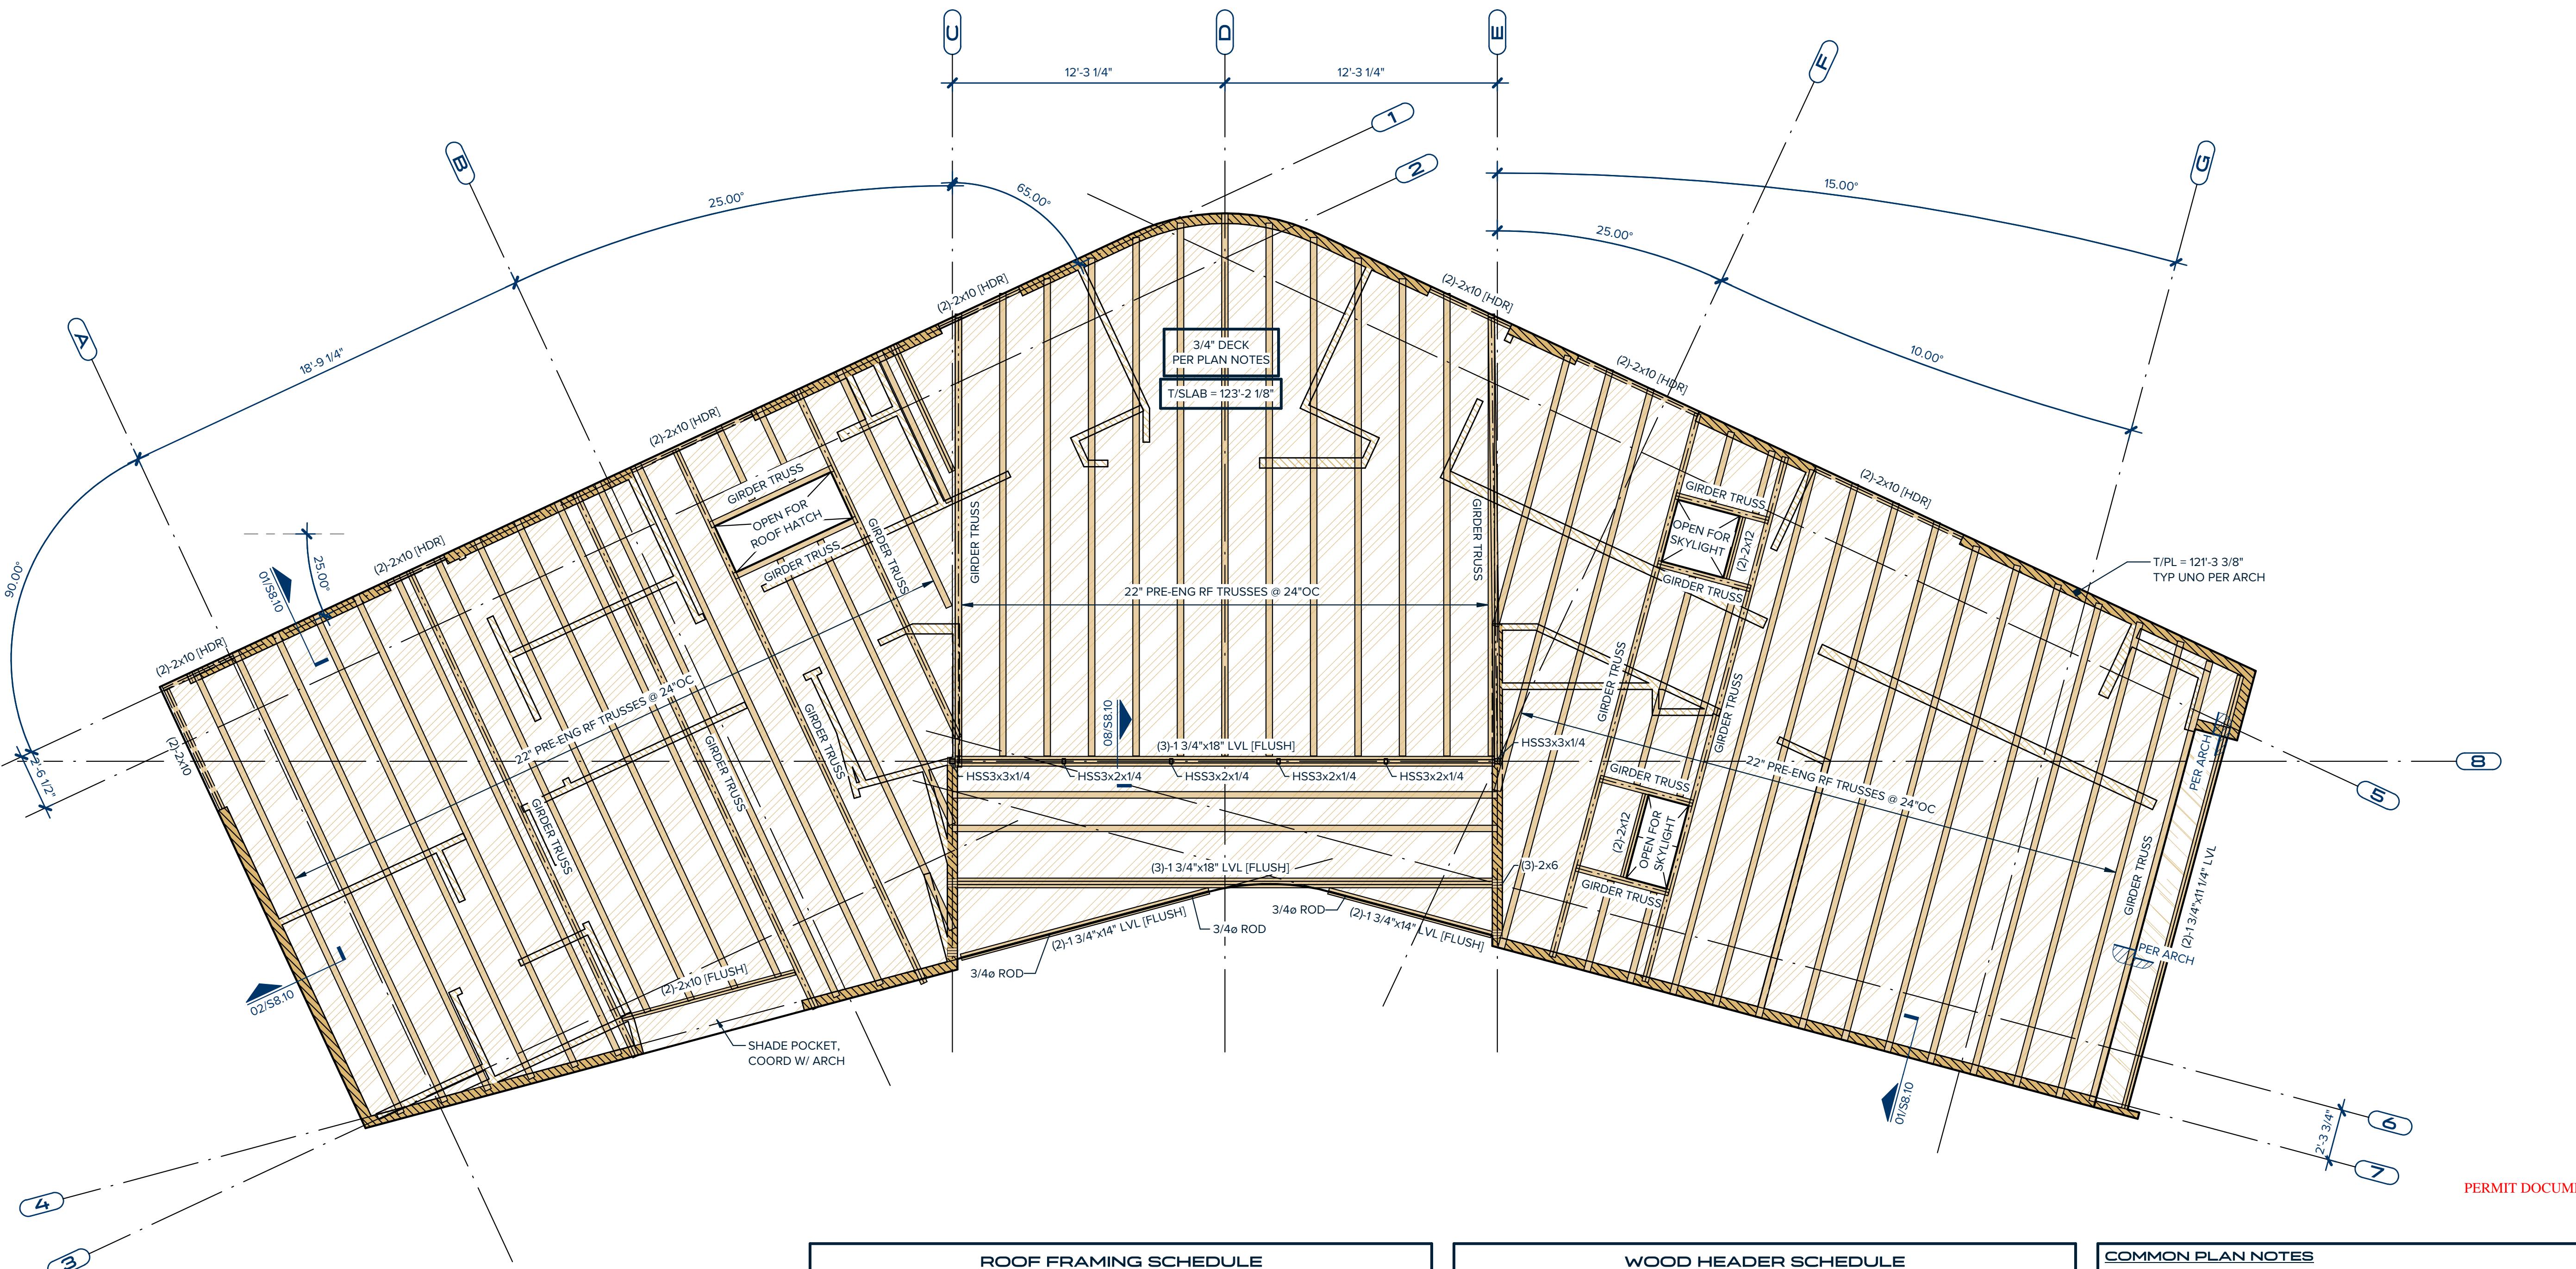

| ROOF FRAMING SCHEDULE |             |         |                        |
|-----------------------|-------------|---------|------------------------|
| MEMBER TYPE           | MEMBER SIZE | SPACING | ADDITIONAL INFORMATION |
| RAFTERS               | 2x8         | 24"OC   | UNO, XX-X" MAX SPAN    |
| RIDGE                 | 2x10        | -       | UNO, XX-X" MAX SPAN    |
| HIPS/VALLEYS          | 2x10        | -       | UNO                    |

NOTES  
1. SPAN IS CLEAR SPAN BETWEEN SUPPORTS.

| WOOD CEILING JOIST SCHEDULE |             |         |                        |
|-----------------------------|-------------|---------|------------------------|
| SPAN                        | MEMBER SIZE | SPACING | ADDITIONAL INFORMATION |
| < 9'-0"                     | 2x6         | 24"OC   | TYP, UNO               |
| < 12'-0"                    | 2x8         | 24"OC   | TYP, UNO               |
| < 14'-0"                    | 2x10        | 24"OC   | TYP, UNO               |

NOTES  
1. SPAN IS CLEAR SPAN BETWEEN SUPPORTS.  
2. ALL CEILING JOISTS ARE NOT DESIGNED TO SUPPORT ATTIC LOADING OR MECHANICAL LOADING.

| WOOD HEADER SCHEDULE |                                            |                                            |                                                             |
|----------------------|--------------------------------------------|--------------------------------------------|-------------------------------------------------------------|
| SUPPORTING           | SPAN < 3'-6"                               | SPAN > 6'-6"                               | ADDITIONAL INFORMATION                                      |
| ROOF                 | 2x4 WALL - (2)-2x6<br>2x6 WALL - (3)-2x6   | 2x4 WALL - (2)-2x8<br>2x6 WALL - (3)-2x8   | • ALL HEADERS TO BE SUPPORTED BY (2)-2x STUD PACK, MINIMUM. |
| FLOOR                | 2x4 WALL - (2)-2x10<br>2x6 WALL - (3)-2x10 | 2x4 WALL - (2)-2x12<br>2x6 WALL - (3)-2x12 | • HDR ON PLAN INDICATES SCHEDULED HEADERS                   |

NOTES  
1. SPAN IS CLEAR SPAN BETWEEN SUPPORTS.

| WOOD STUD WALL SCHEDULE |                 |                          |                          |                        |
|-------------------------|-----------------|--------------------------|--------------------------|------------------------|
| WALL TYPE               | HEIGHT < 10'-0" | 10'-0" > HEIGHT < 12'-0" | 12'-0" > HEIGHT < 14'-0" | ADDITIONAL INFORMATION |
| EXT WALLS               | 2x6 @ 16"OC     | 2x6 @ 12"OC              | 13/4x5 1/2"LSL @16"OC    | TYP, UNO               |
| INT WALLS               | 2x4 @ 16"OC     | 2x4 @ 12"OC              | 2x6 @ 16"OC              | TYP, UNO               |

NOTES  
1. ALL LOAD BEARING WALLS ARE INDICATED ON FRAMING PLANS.  
2. ALL LOAD BEARING WALL STUDS SHALL BE GRADE NO2 SOUTHERN PINE OR DOUGLAS-FIR, MINIMUM.  
3. ALL OTHER NON-BEARING WALL STUDS SHALL BE 2x4 @ 16"OC, STUD GRADE SOUTHERN PINE OR DOUGLAS-FIR.

| COMMON PLAN NOTES                                                                                                                                                                     |  |  |  |
|---------------------------------------------------------------------------------------------------------------------------------------------------------------------------------------|--|--|--|
| 1. STRUCTURAL GENERAL NOTES, ABBREVIATIONS, AND LEGEND PER S1 SHEET SERIES.                                                                                                           |  |  |  |
| 2. VERIFY ALL DIMENSIONS, ELEVATIONS, FINISH SURFACES, SLOPES, DRAINS, DEPRESSIONS, CURBS, PENETRATIONS, ETC. WITH ARCHITECTURAL AND OTHER CONSULTANT DRAWINGS PRIOR TO CONSTRUCTION. |  |  |  |
| 3. ALL DUCTS, CHASES AND PIPES SHALL BE PER MECHANICAL, PLUMBING, ELECTRICAL AND SPRINKLER DRAWINGS.                                                                                  |  |  |  |

| WOOD FRAMING PLAN NOTES                                                                                                                                                                                                                                     |  |  |  |  |
|-------------------------------------------------------------------------------------------------------------------------------------------------------------------------------------------------------------------------------------------------------------|--|--|--|--|
| 1. PRE-ENGINEERED TRUSSES TO BE DESIGNED BY TRUSS MANUFACTURER AND SHALL COORDINATE TRUSS DESIGN AND PROFILES WITH HVAC UNIT SIZES AND LOCATIONS. SUBMITTAL INFORMATION, DESIGN CRITERIA, RIM JOIST AND BLOCKING REQUIREMENTS PER STRUCTURAL GENERAL NOTES. |  |  |  |  |
| 2. DECK AND ATTACHMENT PER PLAN AND STRUCTURAL GENERAL NOTES.                                                                                                                                                                                               |  |  |  |  |
| 3. ALL WOOD EXPOSED TO CONCRETE, WEATHER, OR WITHIN 8" OF FINISHED GRADE SHALL BE PRESSURE- TREATED.                                                                                                                                                        |  |  |  |  |
| 4. REFERENCE TYPICAL WOOD DETAILS FOR HANGER SCHEDULE.                                                                                                                                                                                                      |  |  |  |  |
| 5. BRACING WALL, SHEAR WALL, STRAPS AND HOLD-DOWN REQUIREMENTS PER BRACING PLAN ON FLOOR BELOW.                                                                                                                                                             |  |  |  |  |

| NO                 | ISSUE | DATE |
|--------------------|-------|------|
| PM: S. Young       |       |      |
| ENG: S. Young      |       |      |
| BIM PM: C Lawrence |       |      |
| QA/QC: S Covey     |       |      |

If printed on 22x34 or 24x36 sheet,  
the scale is as indicated.  
If printed on an 11x17 or 12x18  
sheet, the scale is reduced by half. SCALE

ROOF FRAMING PLAN  
SHEET TITLE

| SHEAR WALL SCHEDULE |                      |                      |                               |                           |
|---------------------|----------------------|----------------------|-------------------------------|---------------------------|
| TYPE MARK           | SHEATHING ①          | EDGE NAILING (PEN) ② | SILL PLATE NAILING (2)-ROWS ③ | ANCHOR BOLTS W/ WASHERS ④ |
| CS-WSP (TYP @ EXT)  | 15/32" APA RATED CDX | 8d @ 6"OC            | 16d @ 6"OC                    | 1/2"Øx8" @ 48"OC          |
| LIB <sup>5</sup>    | 1x4 OR 1 1/4"x18 GA  | (2)-8d @ EA STUD     | (2)-8d @ EA STUD              | 1/2"Øx8" @ 48"OC          |
| ▼ <sup>6</sup>      | 15/32" APA RATED CDX | 8d @ 6"OC            | 16d @ 6"OC                    | 1/2"Øx8" @ 48"OC          |
| ▼ <sup>7</sup>      | 15/32" APA RATED CDX | 8d @ 4"OC            | 16d @ 6"OC                    | 1/2"Øx8" @ 36"OC          |

**NOTES**


- PRIOR TO CONSTRUCTION OF SHEAR WALLS, REVIEW LATEST ARCHITECTURAL DRAWINGS AND NOTIFY STRUCTURAL ENGINEER OF ANY LOCATIONS WHERE MINIMUM SHEAR WALL LENGTHS ARE NOT MET. MINIMUM LENGTHS BASED ON OUTSIDE FACE TO OUTSIDE FACE OF TIEDOWN POSTS.
- FIELD NAILING TO BE 8d @ 12"OC AT SHEAR WALL PLYWOOD PANELS, TYPICAL.
- SEE PLANS FOR SHEAR WALL TIEDOWNS, SIZES AND LOCATIONS.
- PLACE SHEATHING ON SIDE OF WALL WHERE SHEAR WALL SYMBOL OCCURS.
- HORIZONTAL PLYWOOD SPLICES TO OCCUR AT RIBBON BAND, WHERE WALL HEIGHT DICTATES HORIZONTAL SPLICE AT WALL, PROVIDE 2x BLOCKING, DO NOT SPLICE AT DOUBLE 2x TOP PLATE.
- USE 2x STUDS, DOUBLE TOP PLATE AND SINGLE SILL PLATE, UNO.
- INSTALL (2)-2x STUDS OR 3x STUD AT EDGE OF PLYWOOD PANELS WHERE EDGE NAILING IS LESS THAN 6"OC.
- LET-IN-BRACE (LIB) WALLS MUST HAVE 1/2" GYPSUM WALL BOARD INSTALLED ON SIDE OF WALL OPPOSITE THE BRACING MATERIAL. INSTALL STRAPPING AT 45° TO 60° PER DETAIL 03/S8.03.

| HOLD-DOWN SCHEDULE - FRAMING TO CONCRETE |                |                                             |          |
|------------------------------------------|----------------|---------------------------------------------|----------|
| TYPE MARK                                | HOLD-DOWN TYPE | HOLD-DOWN ANCHOR BOLT                       | END POST |
| HD-A                                     | SIMPSON HDU-5  | 5/8"Ø F1553 GR 35 ANCHOR BOLTS W/ 12" EMBED | (2)-2x6  |
| HD-B                                     | SIMPSON HDU-8  | 7/8"Ø F1553 GR 35 ANCHOR BOLTS W/ 12" EMBED | (3)-2x6  |
| HD-C                                     | SIMPSON HDU-11 | 1"Ø F1553 GR 35 ANCHOR BOLTS W/ 12" EMBED   | (4)-2x6  |

| HOLD-DOWN SCHEDULE - FRAMING TO WOOD |                    |                                                                                   |          |
|--------------------------------------|--------------------|-----------------------------------------------------------------------------------|----------|
| TYPE MARK                            | HOLD-DOWN TYPE     | HOLD-DOWN ANCHOR BOLT                                                             | END POST |
| HD-D                                 | SIMPSON LSTA36     | 18 GA x 1 1/4" x 36" STRAP, FSTN W/ (24)-10d SINKER NAILS                         | (2)-2x6  |
| HD-E                                 | SIMPSON MSTC52     | 16 GA x 3" x 52 1/4" STRAP, FSTN W/ (62)-16d SINKER NAILS                         | (2)-2x6  |
| HD-F                                 | (2)-SIMPSON MSTC52 | (2)-16 GA x 3" x 52 1/4" STRAP, FSTN W/ (62)-16d SINKER NAILS                     | (4)-2x6  |
| HD-G                                 | SIMPSON MSTC48B3   | 14 GA x 3" x 45" STRAP W/ 3" SEAT WRAPPED UNDER BM, FSTN W/ (38)-10d SINKER NAILS | (4)-2x6  |

**NOTES**

- SCHEDULED HOLD-DOWNS ARE PRE-DRILLED STEEL HOLD-DOWN ANCHORS BY "SIMPSON STRONG-TIE". INSTALL ACCORDING TO MANUFACTURER'S RECOMMENDATIONS.

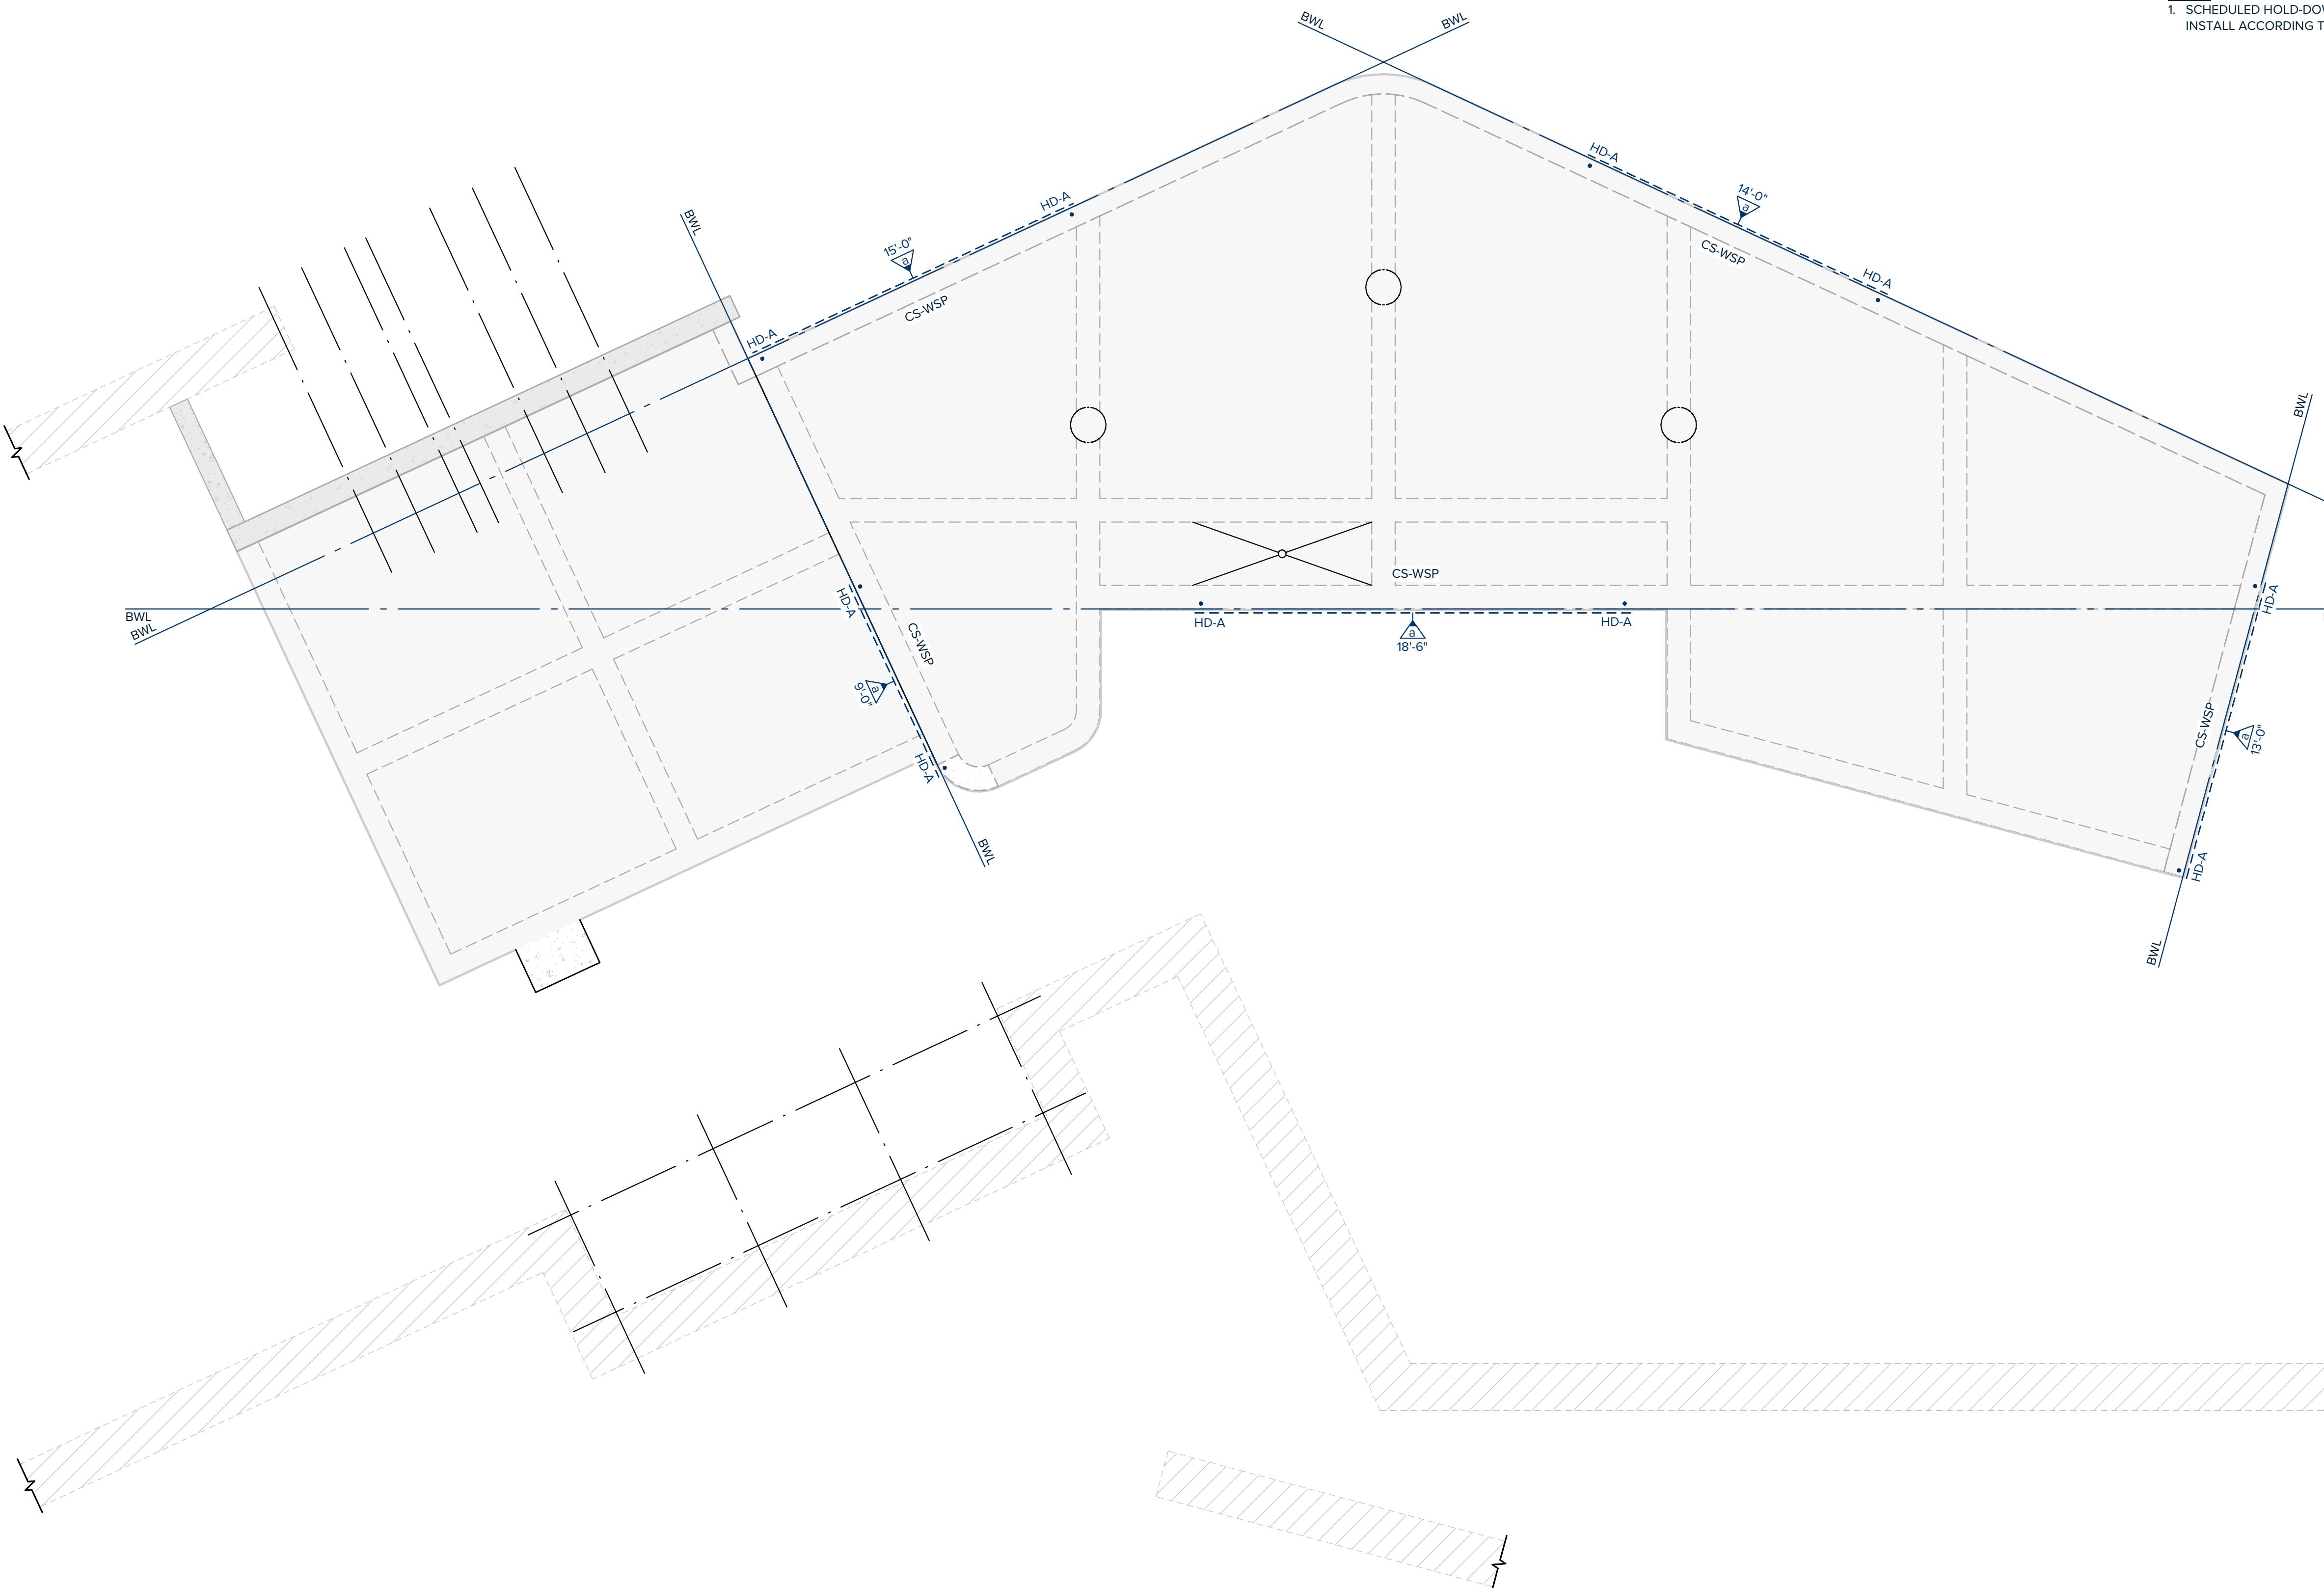

PERMIT DOCUMENTS

| NO                 | ISSUE | DATE |
|--------------------|-------|------|
| PM: S. Young       |       |      |
| ENG: S. Young      |       |      |
| BIM PM: C Lawrence |       |      |
| QA/QC: S Covey     |       |      |

If printed on 22x34 or 24x36 sheet, the scale is as indicated.  
If printed on an 11x17 or 12x18 sheet, the scale is reduced by half. SCALE

WIND BRACING PLAN

SHEET TITLE

SHEET NUMBER

LEVEL 01 LATERAL BRACING PLAN

S3.01




SCALE: 1/4" = 1'-0"

COPYRIGHT © 2023 FORT STRUCTURES

| REINFORCEMENT SPLICE LENGTH SCHEDULE |             |       |             |       |             |       |             |       |             |       |             |  |
|--------------------------------------|-------------|-------|-------------|-------|-------------|-------|-------------|-------|-------------|-------|-------------|--|
| CLASS                                | fc=3000 PSI |       | fc=4000 PSI |       | fc=5000 PSI |       | fc=6000 PSI |       | fc=7000 PSI |       | fc=8000 PSI |  |
|                                      | BAR SIZE    | "A"   | "B"         |  |
| #3                                   | 1-5"        | 1-10" | 1-3"        | 1-7"  | 1-1"        | 1-5"  | 1-0"        | 1-4"  | 1-0"        | 1-4"  | 1-4"        |  |
| #4                                   | 1-10"       | 2-5"  | 1-7"        | 2-1"  | 1-5"        | 1-10" | 1-4"        | 1-8"  | 1-3"        | 1-7"  | 1-2"        |  |
| #5                                   | 2-4"        | 3-0"  | 2-0"        | 2-7"  | 1-10"       | 2-4"  | 1-8"        | 2-1"  | 1-6"        | 2-0"  | 1-5"        |  |
| #6                                   | 2-9"        | 3-7"  | 2-5"        | 3-1"  | 2-2"        | 2-9"  | 2-0"        | 2-7"  | 1-10"       | 2-4"  | 1-8"        |  |
| #7                                   | 4-0"        | 5-3"  | 3-6"        | 4-6"  | 3-1"        | 4-1"  | 2-10"       | 3-8"  | 2-8"        | 3-5"  | 2-6"        |  |
| #8                                   | 4-7"        | 6-0"  | 4-0"        | 5-2"  | 3-7"        | 4-7"  | 3-3"        | 4-3"  | 3-0"        | 3-11" | 2-10"       |  |
| #9                                   | 5-2"        | 6-10" | 4-6"        | 5-10" | 4-0"        | 5-3"  | 3-8"        | 4-9"  | 3-5"        | 4-5"  | 3-2"        |  |
| #10                                  | 5-10"       | 7-8"  | 5-1"        | 6-7"  | 4-6"        | 5-10" | 4-1"        | 5-4"  | 3-10"       | 4-11" | 3-7"        |  |
| #11                                  | 6-6"        | 8-6"  | 5-7"        | 7-3"  | 5-0"        | 6-6"  | 4-7"        | 5-11" | 4-3"        | 5-6"  | 4-0"        |  |

**NOTES:**

1. WHERE SPLICE TYPE IS NOT INDICATED, USE CLASS "B" SPLICE.
2. LAP LENGTHS LISTED ABOVE APPLY UNDER THE FOLLOWING CONDITIONS:
  - A. BEAM AND COLUMN BARS ARE SPACED AT LEAST 1 BAR DIAMETER ON CENTER WITH CLEAR COVER NOT LESS THAN 1 BAR DIAMETER.
  - B. WALL AND SLAB BARS ARE SPACED AT LEAST 2 BAR DIAMETERS ON CENTER.
  - C. FOR UNCOATED AND ZINC-COATED (GALVANIZED) REINFORCEMENT.
  - D. FOR REINFORCEMENT THAT CONFORMS DEFORMED NEW BILLET STEEL BARS IN ACCORDANCE WITH ASTM A615 GRADE 60.
3. WHERE CLEAR COVER OR CLEAR SPACING FOR MASONRY REINFORCEMENT IS LESS THAN 5 BAR DIAMETERS, INCREASE SPLICE LENGTHS SHOWN BY MULTIPLYING LENGTHS BY MAXIMUM RATIO OF 5 BAR DIAMETERS TO CLEAR COVER OR SPACING.
4. FOR LIGHTWEIGHT CONCRETE, MULTIPLY TABULATIONS BY 1.3.
5. FOR HORIZONTAL TOP BARS WITH 12 INCHES OF CONCRETE CAST BELOW, MULTIPLY TABULATIONS BY 1.3.
6. WHERE A LARGER BAR LAPS A SMALLER BAR, THE SMALLER SCHEDULED LAP LENGTH APPLIES.
7. REFER TO "CONCRETE REINFORCEMENT" SECTION OF THE STRUCTURAL GENERAL NOTES FOR FURTHER INFORMATION.
8. FOR CMU REINFORCEMENT SPLICE LENGTH SCHEDULE, SEE CMU DETAILS.

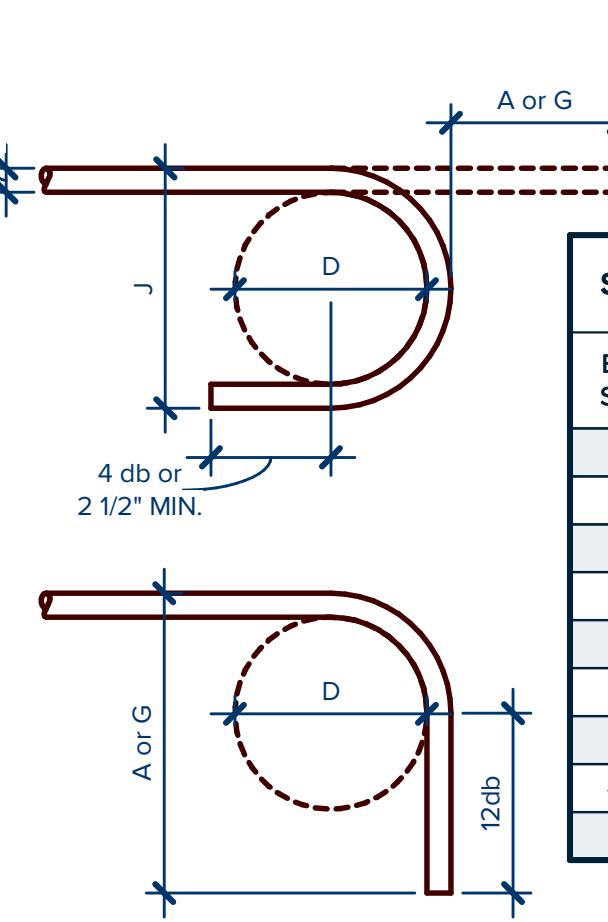

| STANDARD HOOK SCHEDULE |         |           |         |          |     |
|------------------------|---------|-----------|---------|----------|-----|
| BAR SIZE               | D       | 180° HOOK |         | 90° HOOK |     |
|                        |         | A or G    | J       | A or G   | 8"  |
| #3                     | 2 1/4"  | 5"        | 3"      | 6"       | 8"  |
| #4                     | 3"      | 6"        | 4"      | 8"       | 8"  |
| #5                     | 3 3/4"  | 7"        | 5"      | 10"      | 9"  |
| #6                     | 4 1/2"  | 8"        | 6"      | 11"      | 11" |
| #7                     | 5 1/4"  | 10"       | 7"      | 12"      | 10" |
| #8                     | 6"      | 11"       | 8"      | 14"      | 12" |
| #9                     | 9 1/2"  | 13"       | 11 3/4" | 17"      | 14" |
| #10                    | 10 3/4" | 15"       | 11 1/4" | 18"      | 16" |
| #11                    | 11 1/2" | 17"       | 12 3/4" | 20"      | 17" |

| HOOK DEVELOPMENT LENGTH SCHEDULE, LDH |          |          |          |          |          |
|---------------------------------------|----------|----------|----------|----------|----------|
| BAR SIZE                              | 3000 PSI | 4000 PSI | 5000 PSI | 6000 PSI | 7000 PSI |
| #3                                    | 9"       | 8"       | 7"       | 6"       | 6"       |
| #4                                    | 11"      | 10"      | 9"       | 8"       | 7"       |
| #5                                    | 12"      | 11"      | 10"      | 11"      | 11"      |
| #6                                    | 13"      | 12"      | 11"      | 12"      | 11"      |
| #7                                    | 14"      | 13"      | 12"      | 13"      | 12"      |
| #8                                    | 15"      | 14"      | 13"      | 14"      | 13"      |
| #9                                    | 16"      | 15"      | 14"      | 15"      | 14"      |
| #10                                   | 17"      | 16"      | 15"      | 16"      | 15"      |
| #11                                   | 18"      | 17"      | 16"      | 17"      | 16"      |

**NOTES:**

1. TABULATED VALUES ARE BASED ON GRADE 60 REINFORCEMENT BARS AND NORMAL WEIGHT CONCRETE.
2. TABULATED VALUES APPLY TO REINFORCEMENT BARS MEETING MINIMUM CONCRETE COVER PER STRUCTURAL GENERAL NOTES ONLY.
3. FOR EPOXY-COATED HOOKS, MULTIPLY THE TABULATED VALUES BY 1.2.
4. FOR LIGHTWEIGHT CONCRETE, MULTIPLY THE TABULATED VALUES BY 1.3.

## 01 TYPICAL LAP SPLICE SCHEDULE

SCALE : NTS


| DOWEL SCHEDULE |      |       |       |
|----------------|------|-------|-------|
| MARK           | SIZE | A     | B     |
| DWL A          | #4   | 8"    | 3'-0" |
| DWL B          | #4   | 2'-6" | 3'-0" |
| DWL C          | #4   | -     | 4'-0" |
| DWL D          | #4   | 8"    | 6'-0" |
| DWL E          | #4   | -     | 6'-0" |

**NOTES:**

1. SCHEDULED DOWELS ARE MARKED "DWL" ON SECTIONS AND DETAILS.
2. DOWEL SPACING TO MATCH SLAB OR WALL REINFORCEMENT UNLESS NOTED OTHERWISE.



## 03 TYPICAL STANDARD DOWEL SCHEDULE

SCALE : NTS

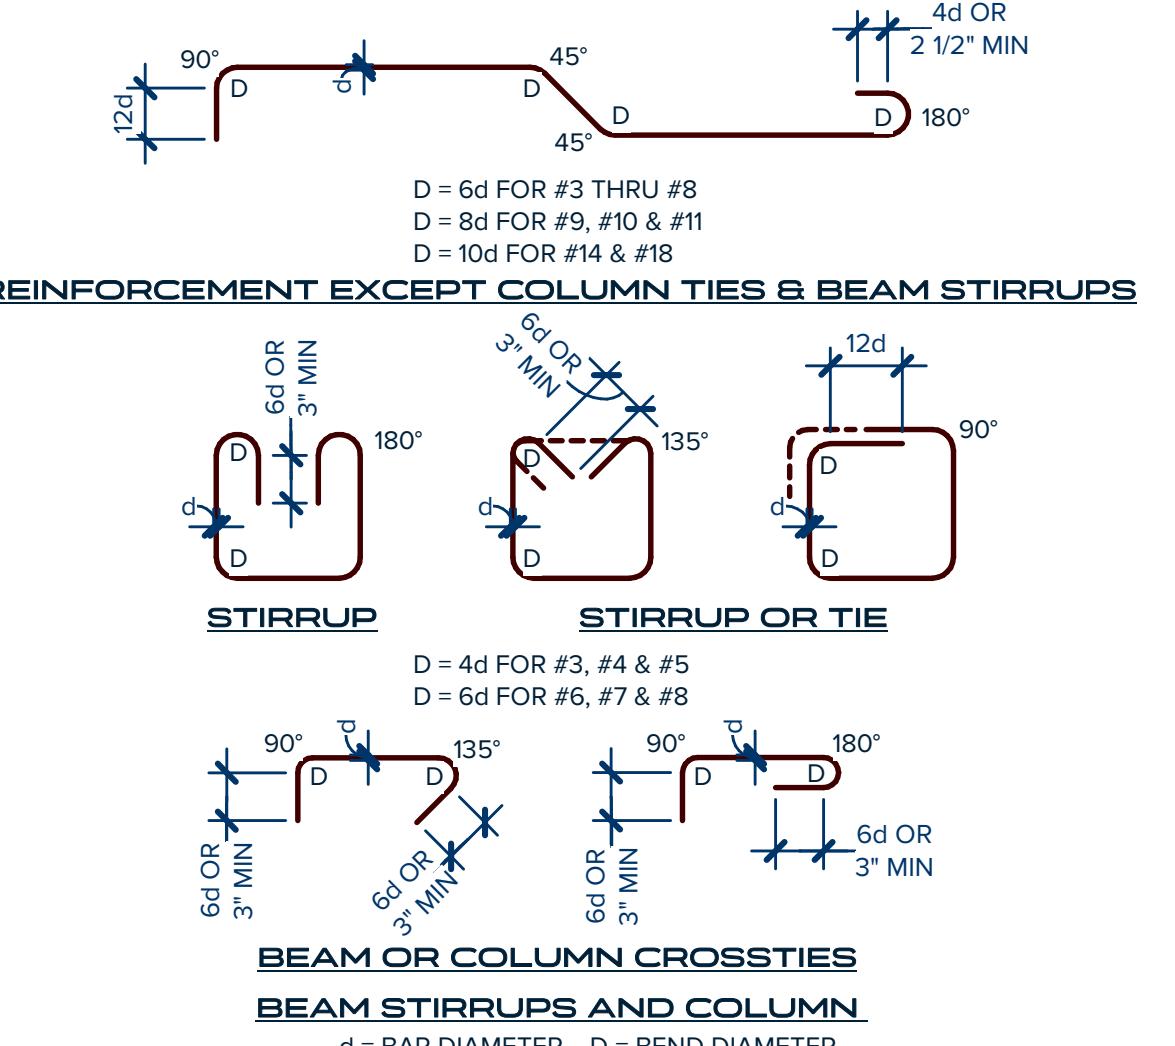

## 04 STANDARD HOOKS AND BENDS

SCALE : NTS

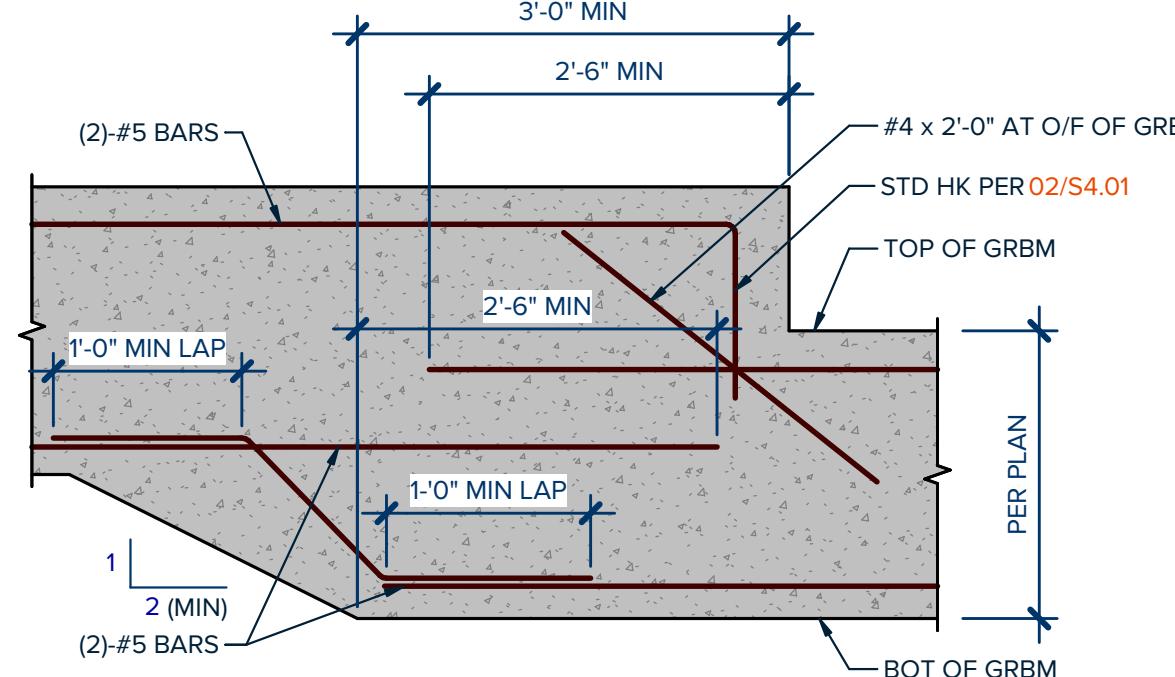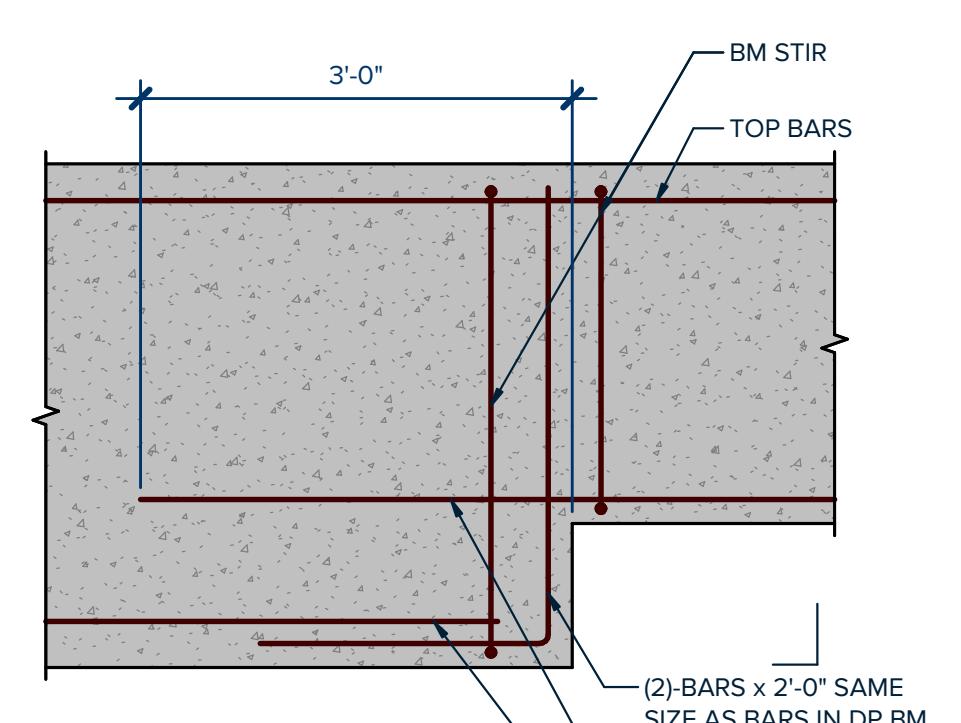


## 06 TYPICAL STEP IN BOTTOM GRADE BEAM

SCALE : NTS


## 02 TYPICAL STANDARD HOOK SCHEDULE

SCALE : NTS

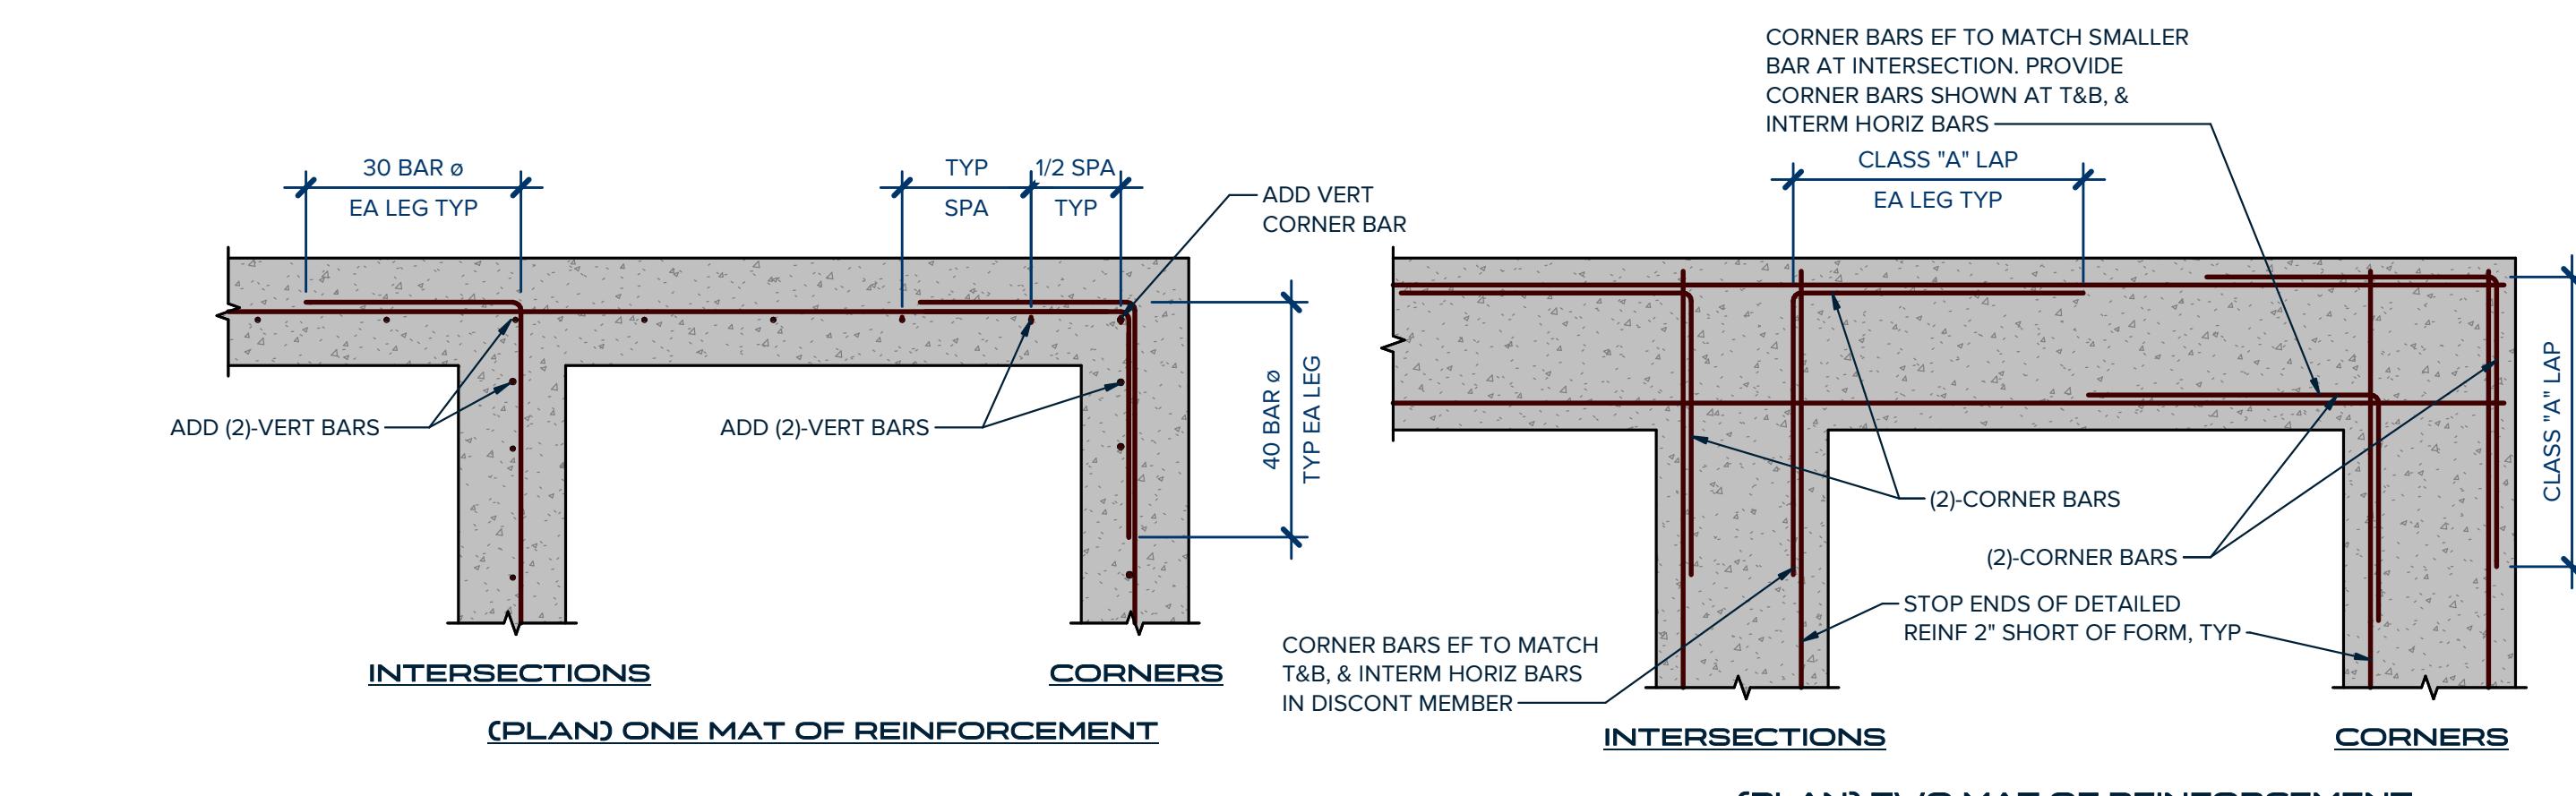

## 05 TYPICAL WALL OR GRADE BEAM REINFORCEMENT

SCALE : NTS

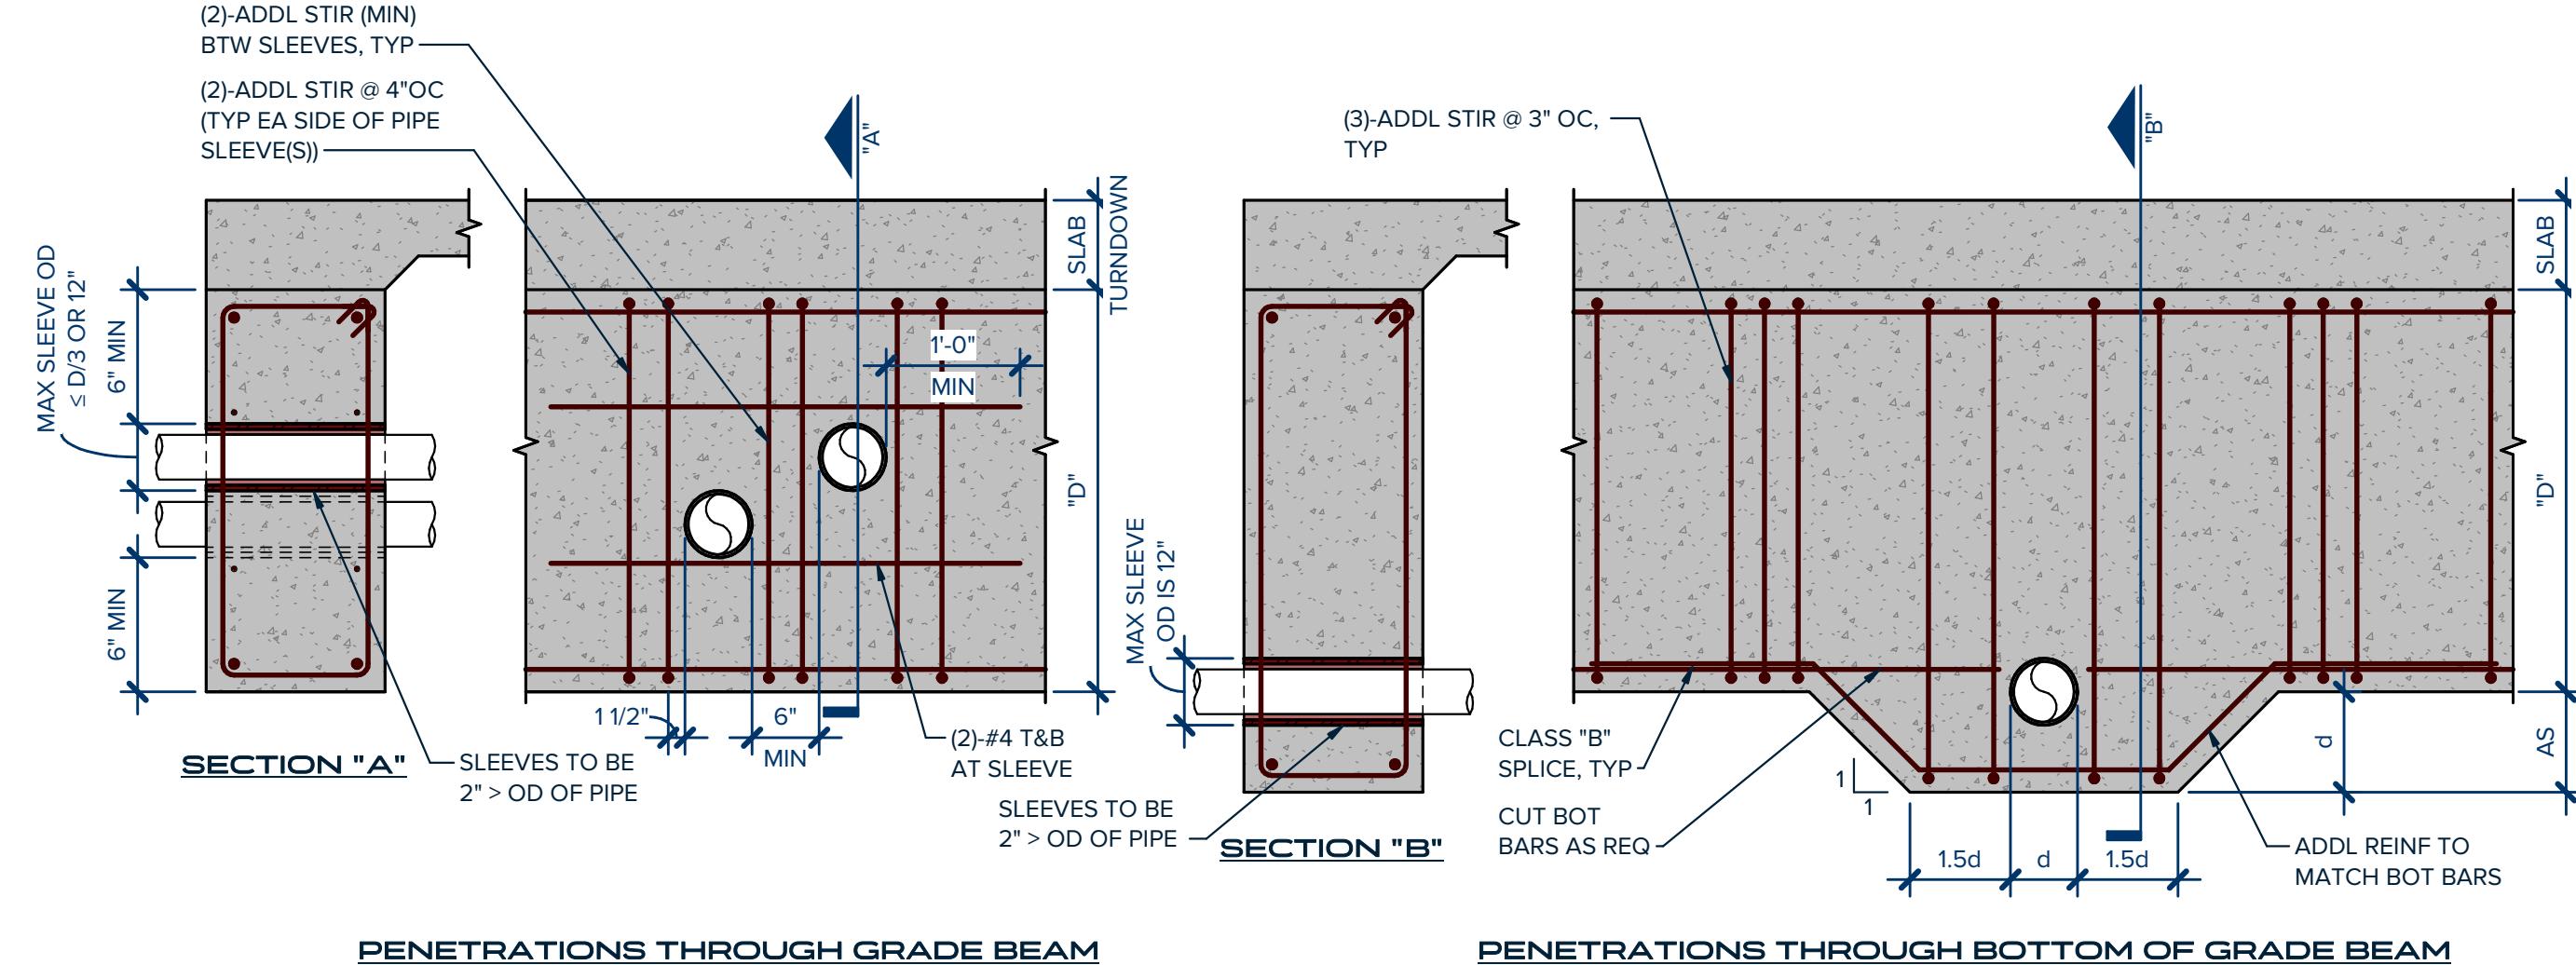

## 07 TYPICAL GRADE BEAM STEP

SCALE : NTS

## 08 TYPICAL HORIZONTAL PIPE PENETRATIONS

SCALE : NTS

NO ISSUE DATE  
PM: S. Young  
ENG: S. Young  
BIM PM: C. Lawrence  
QA/QC: S. Covey  
If printed on 22x34 or 24x36 sheet, the scale is as indicated.  
If printed on an 11x17 or 12x18 sheet, the scale is reduced by half.

**TYPICAL FOUNDATION DETAILS**


SHEET TITLE

SHEET NUMBER

**S4.01**


PERMIT DOCUMENTS

COPIRIGHT © 2023 FORT STRUCTURES

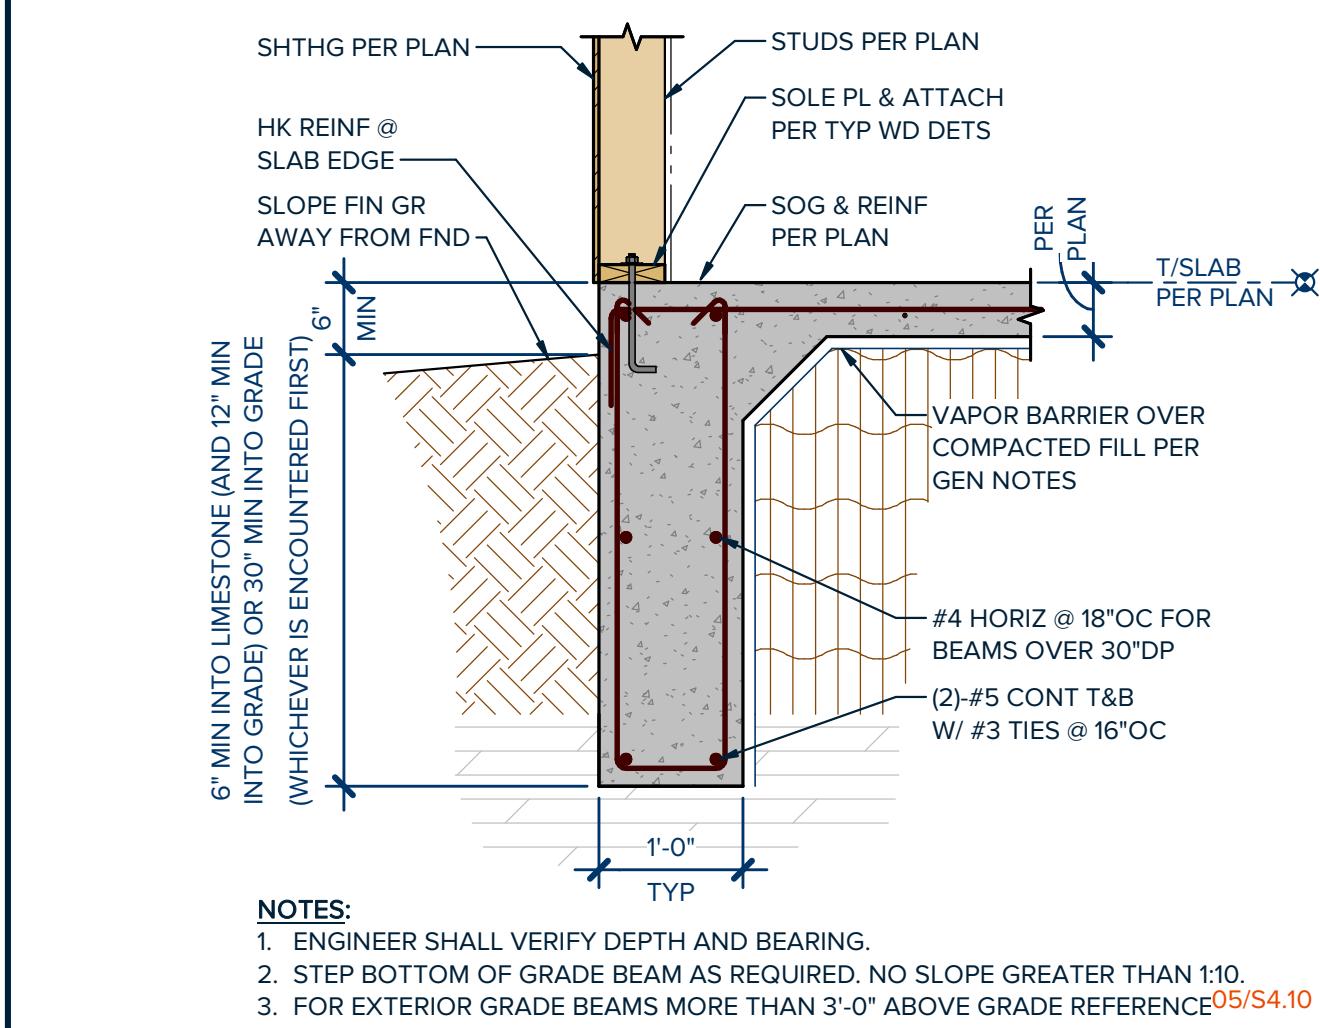


**01** TYPICAL EXTERIOR GRADE BEAM

SCALE : 3/4" = 1'-0"

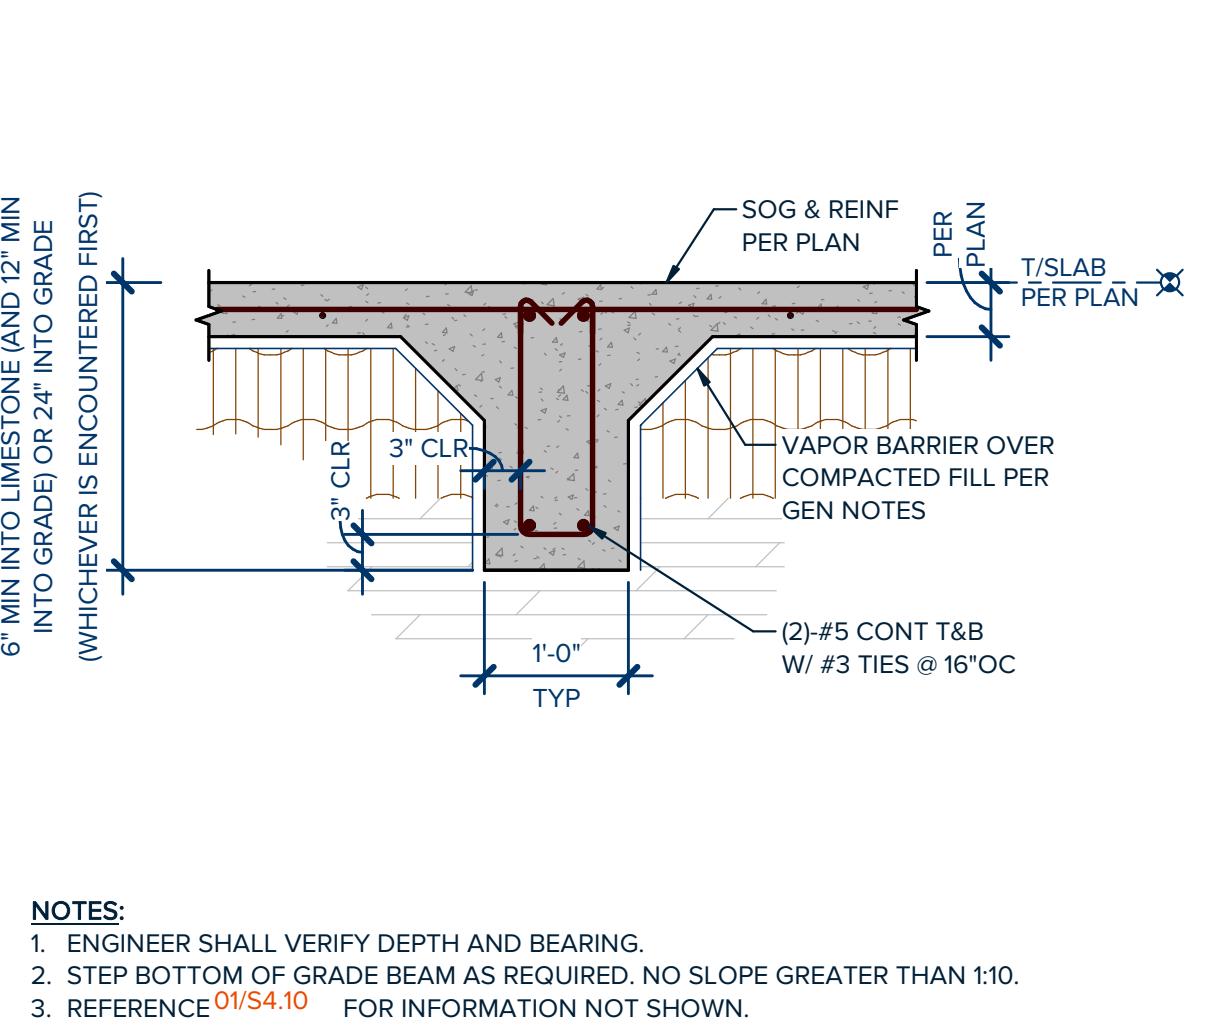


**02** TYPICAL INTERIOR GRADE BEAM

SCALE : 3/4" = 1'-0"

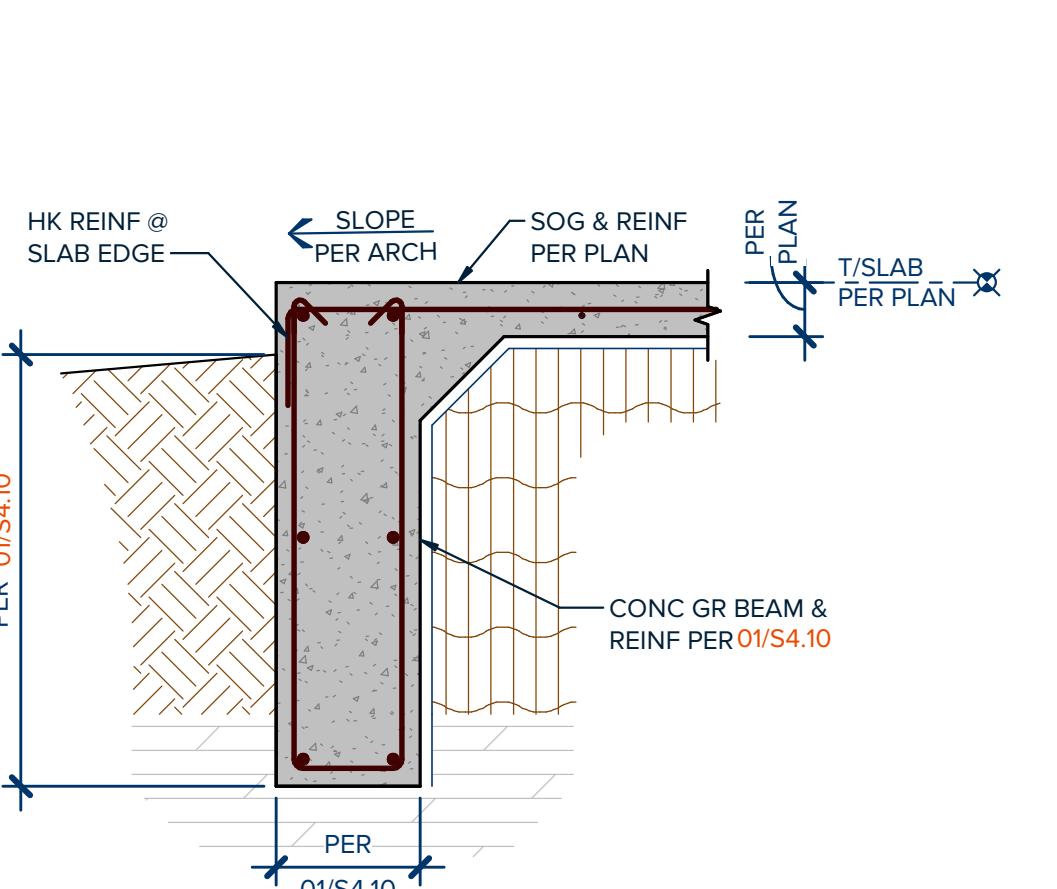


**03** EXTERIOR GRADE BEAM AT SLOPE

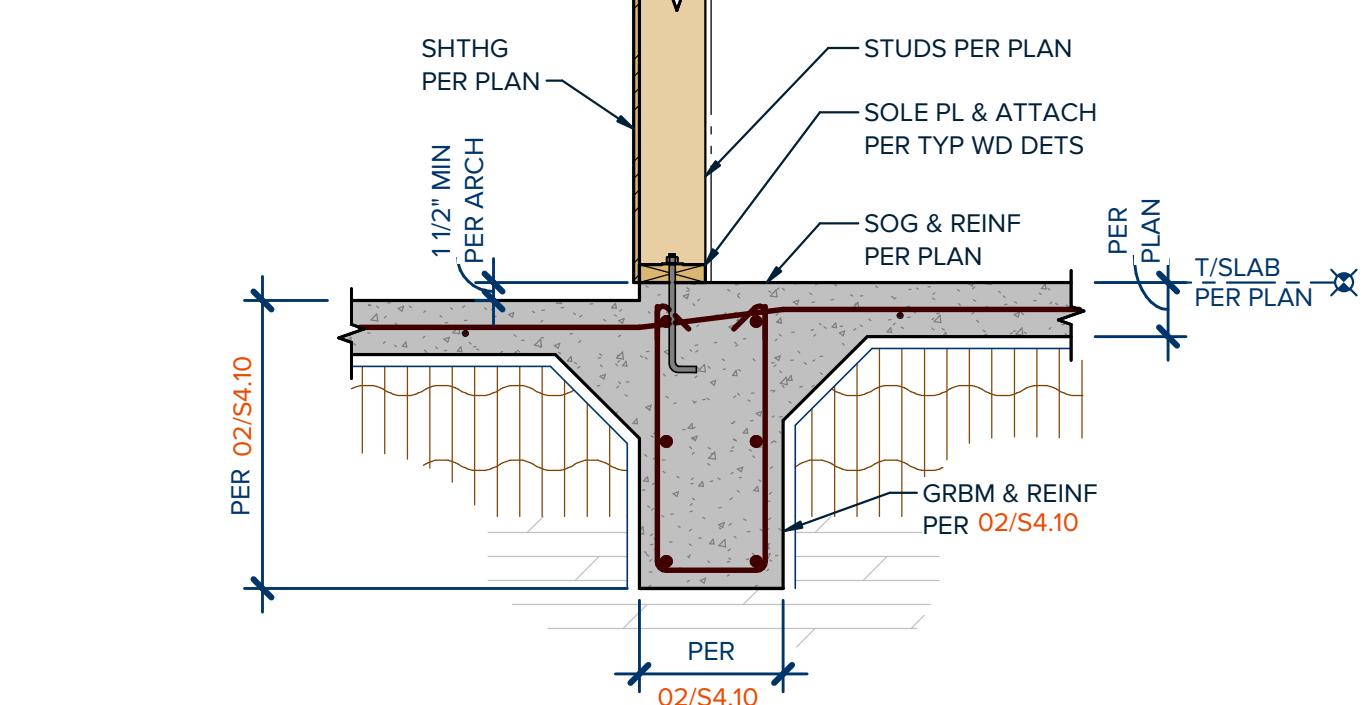


**04** INTERIOR GRADE BEAM AT STEP

SCALE : 3/4" = 1'-0"

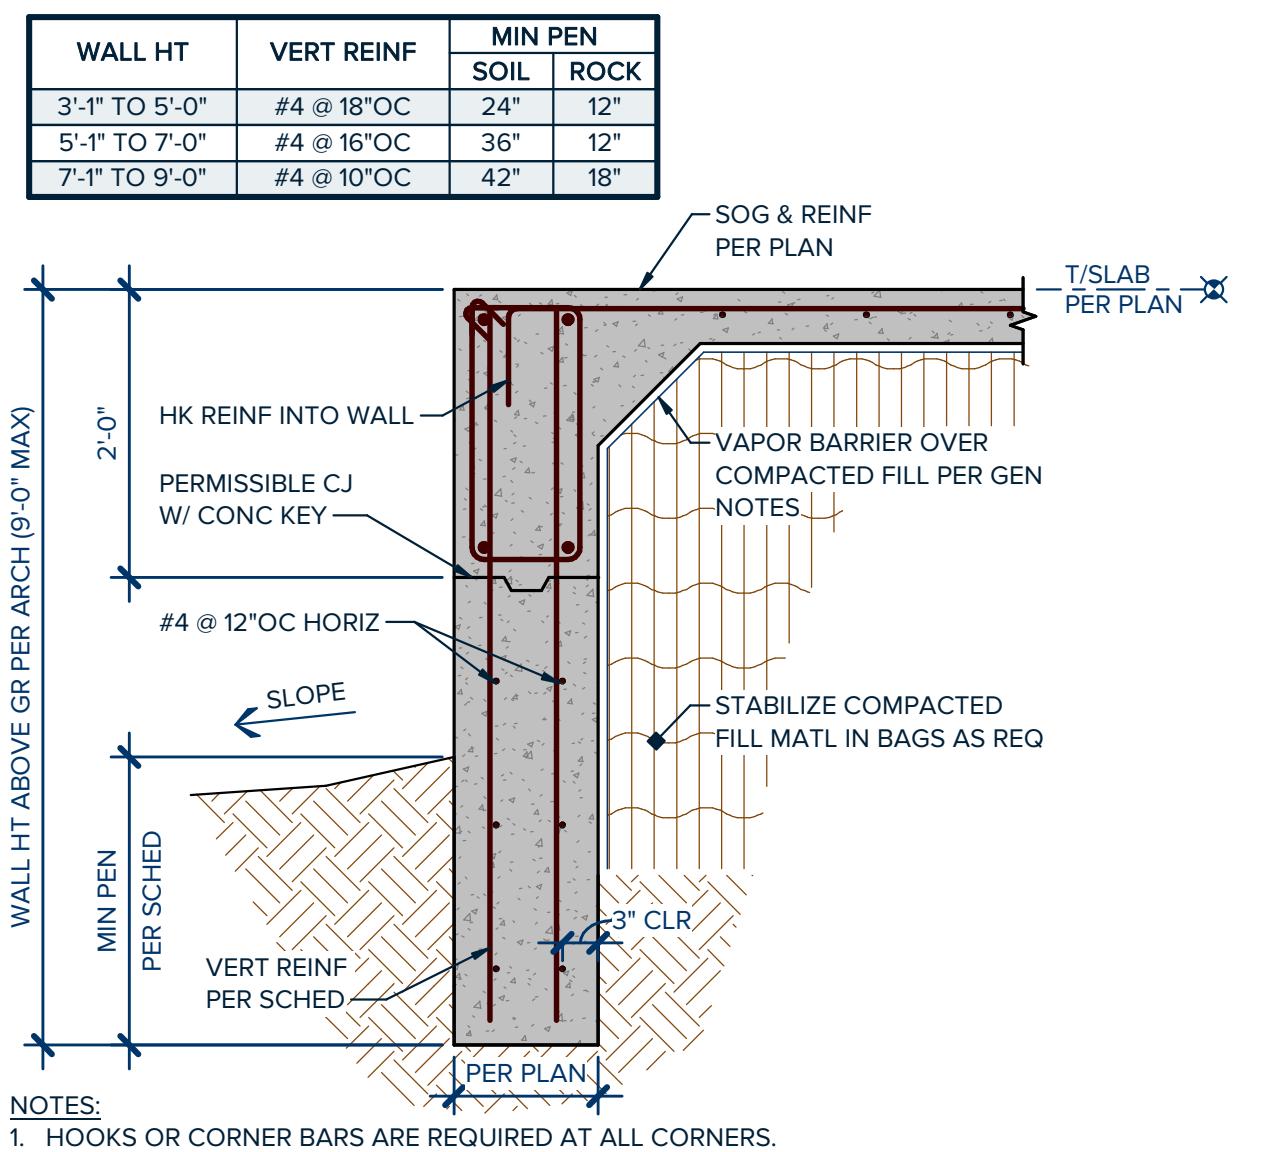


**05** TYPICAL DEEP EXTERIOR GRADE BEAM/WALL

SCALE : 3/4" = 1'-0"

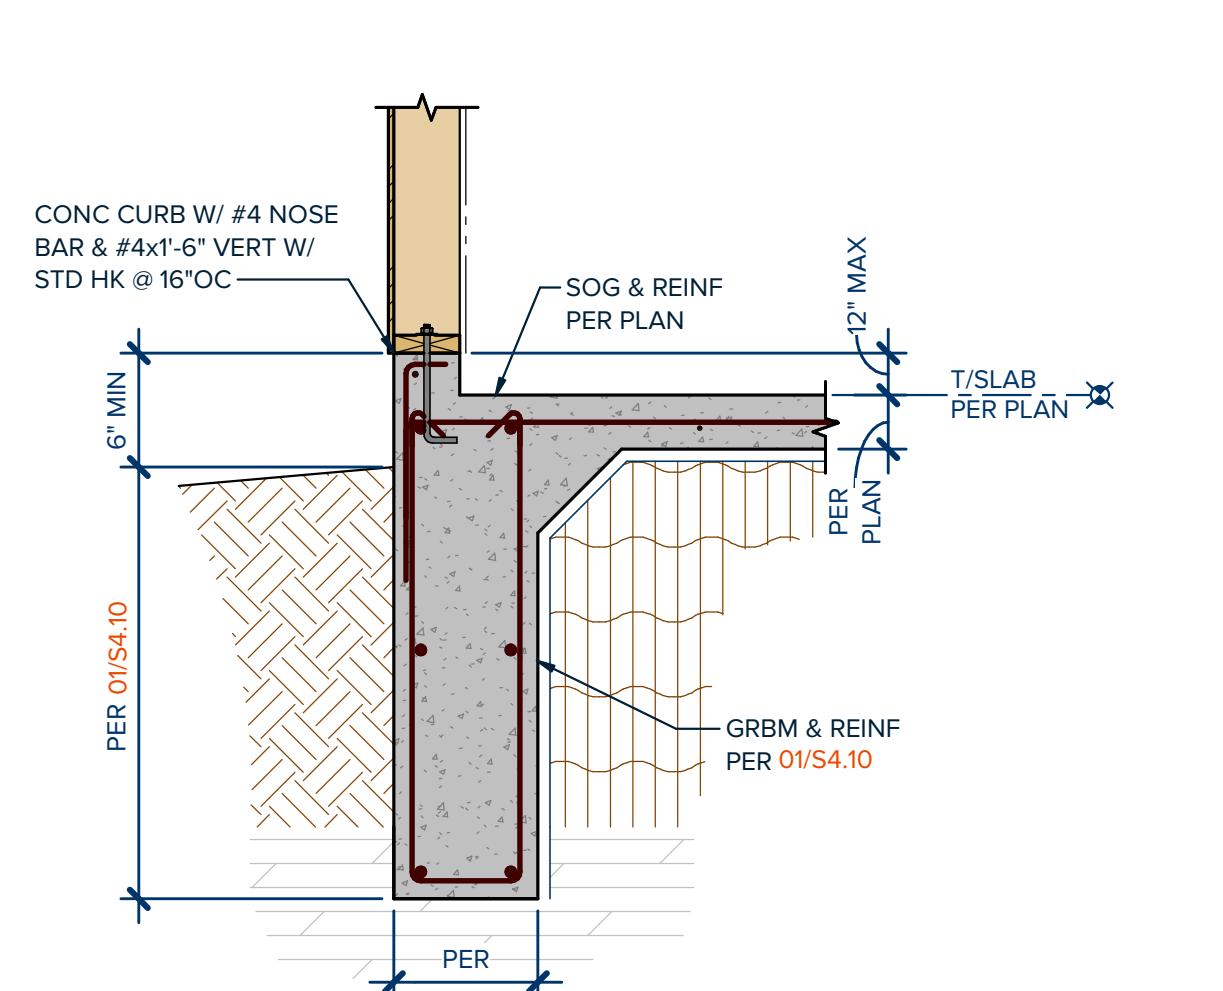


**06** TYPICAL EXTERIOR GRADE BEAM WITH CURB

SCALE : 3/4" = 1'-0"

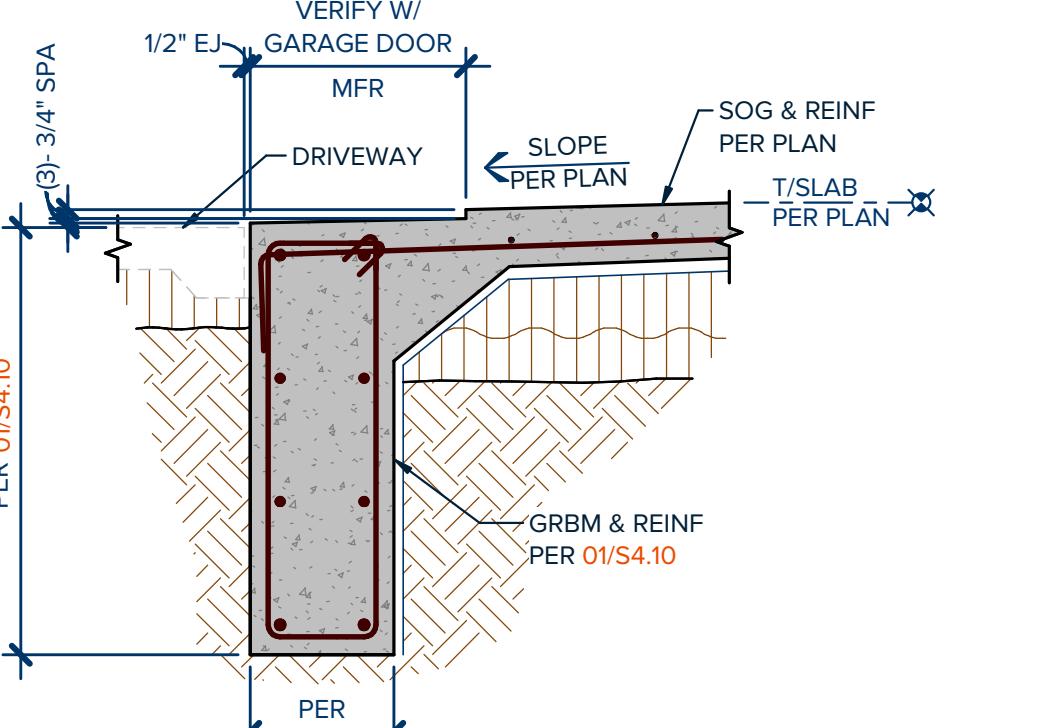


**07** EXTERIOR GRADE BEAM AT GARAGE DOOR

SCALE : 3/4" = 1'-0"

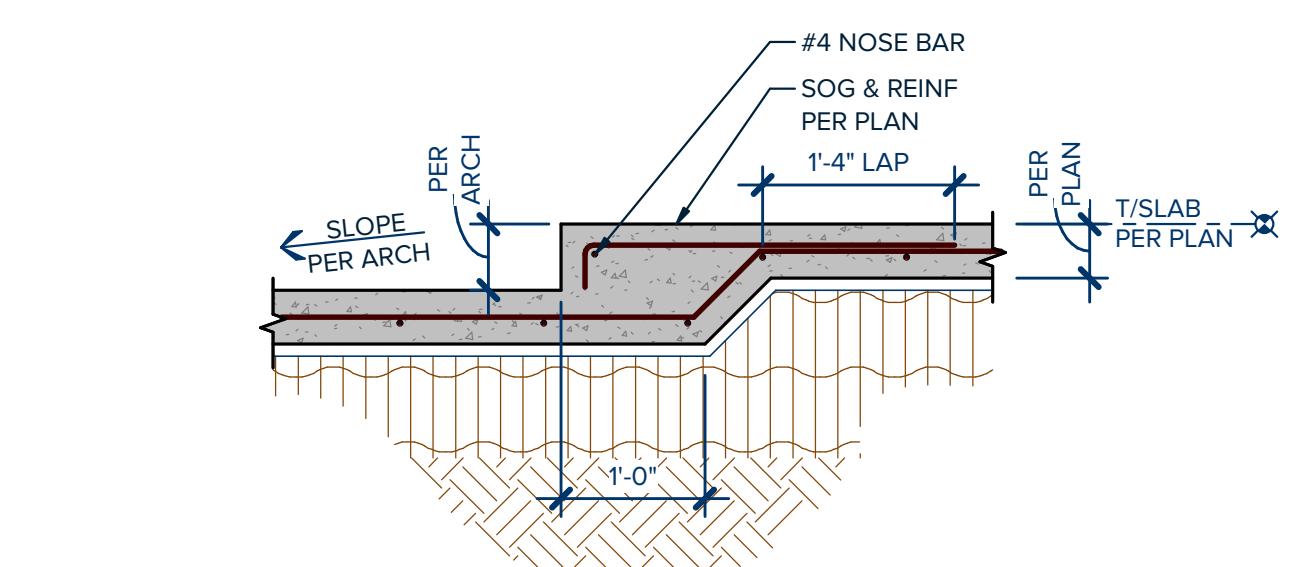


**08** TYPICAL SLAB STEP

SCALE : 3/4" = 1'-0"

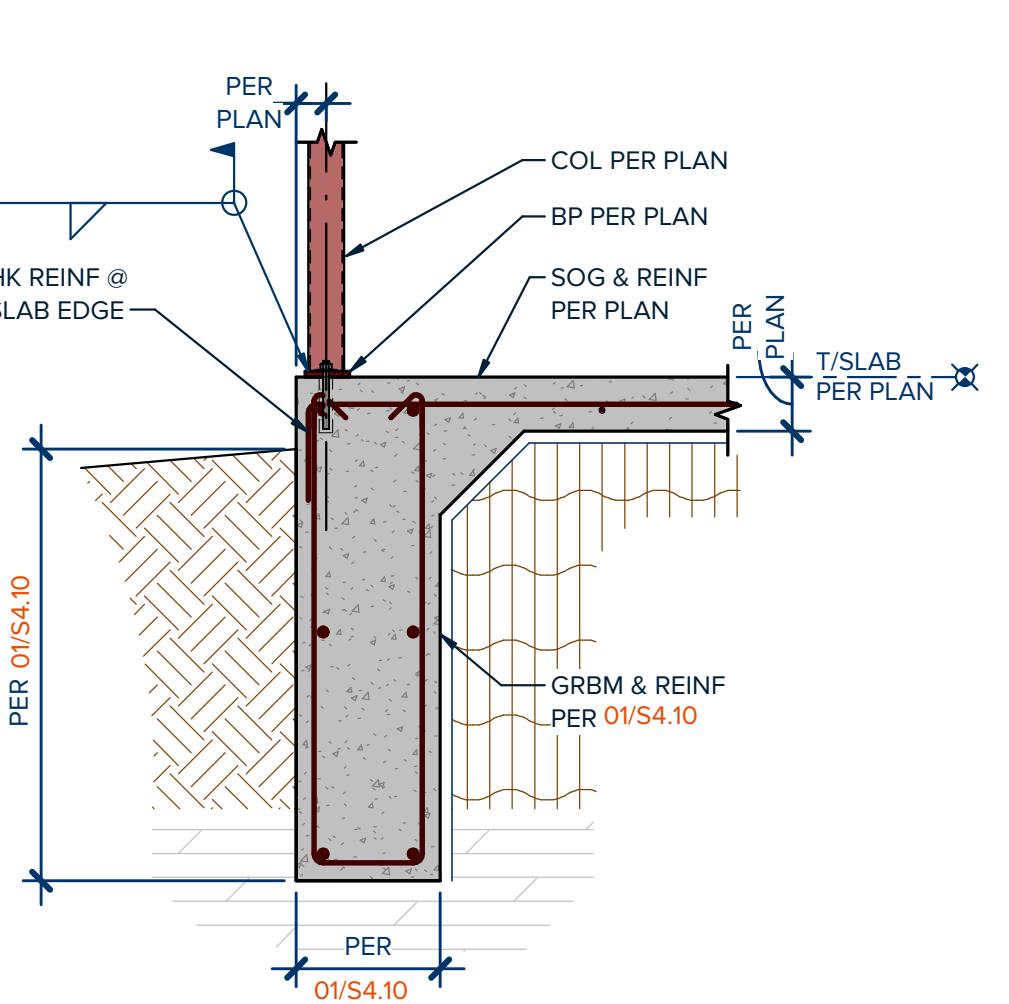


**09** EXTERIOR GRADE BEAM AT STEEL COLUMN

SCALE : 3/4" = 1'-0"

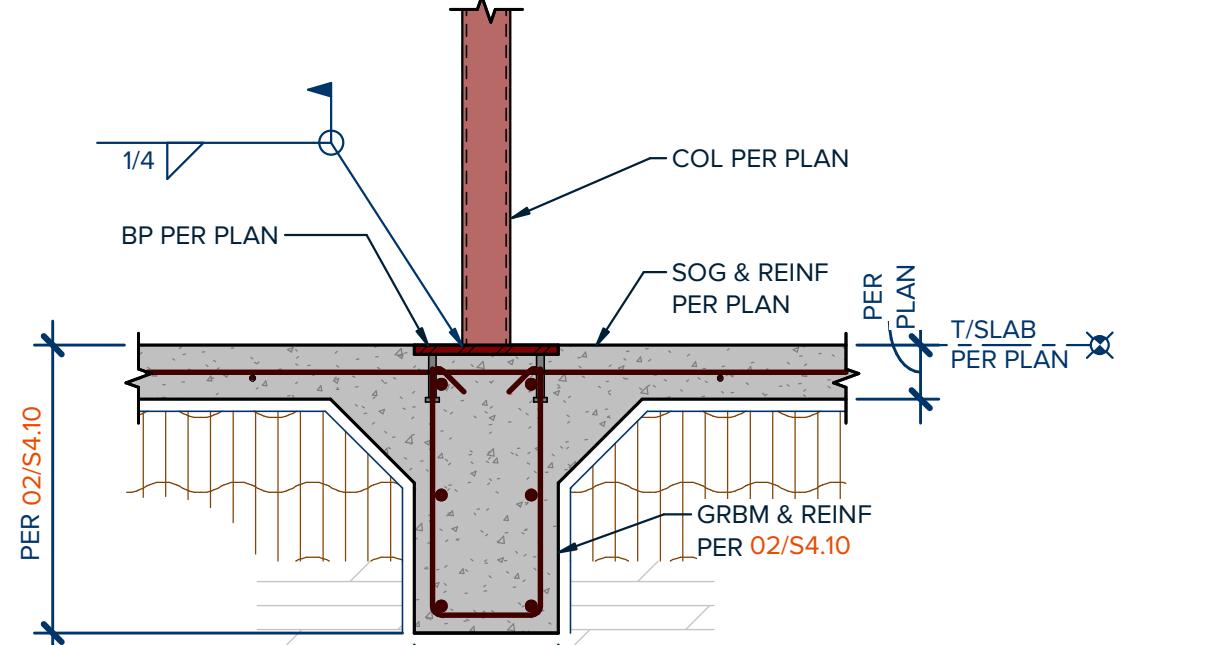

**10** INTERIOR GRADE BEAM WITH STEEL COLUMN

SCALE : 3/4" = 1'-0"

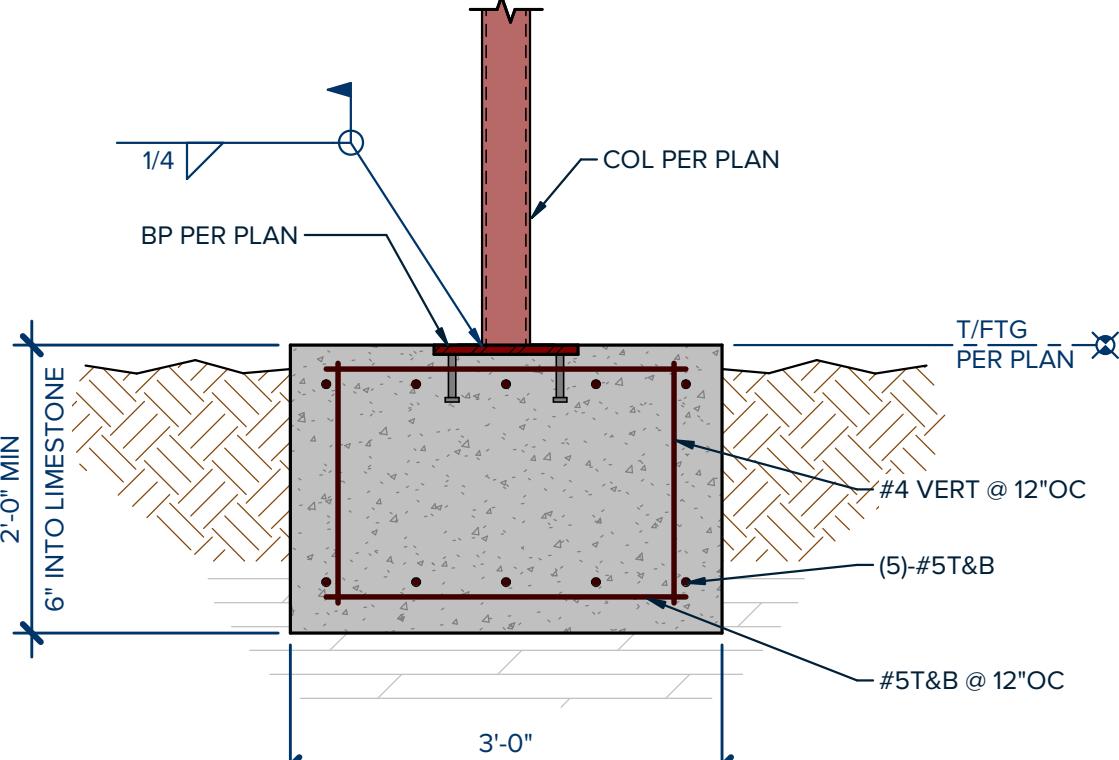

**11** SPREAD FOOTING AT STEEL COLUMN

SCALE : 3/4" = 1'-0"

PERMIT DOCUMENTS

| NO                 | ISSUE | DATE |
|--------------------|-------|------|
| PM: S. Young       |       |      |
| ENG: S. Young      |       |      |
| BIM PM: C Lawrence |       |      |
| QA/QC: S Covey     |       |      |

If printed on 22x34 or 24x36 sheet,  
the scale is as indicated.  
If printed on an 11x17 or 12x18  
sheet, the scale is reduced by half.


SCALE

FOUNDATION DETAILS

SHEET TITLE

**S4.10**


SHEET NUMBER

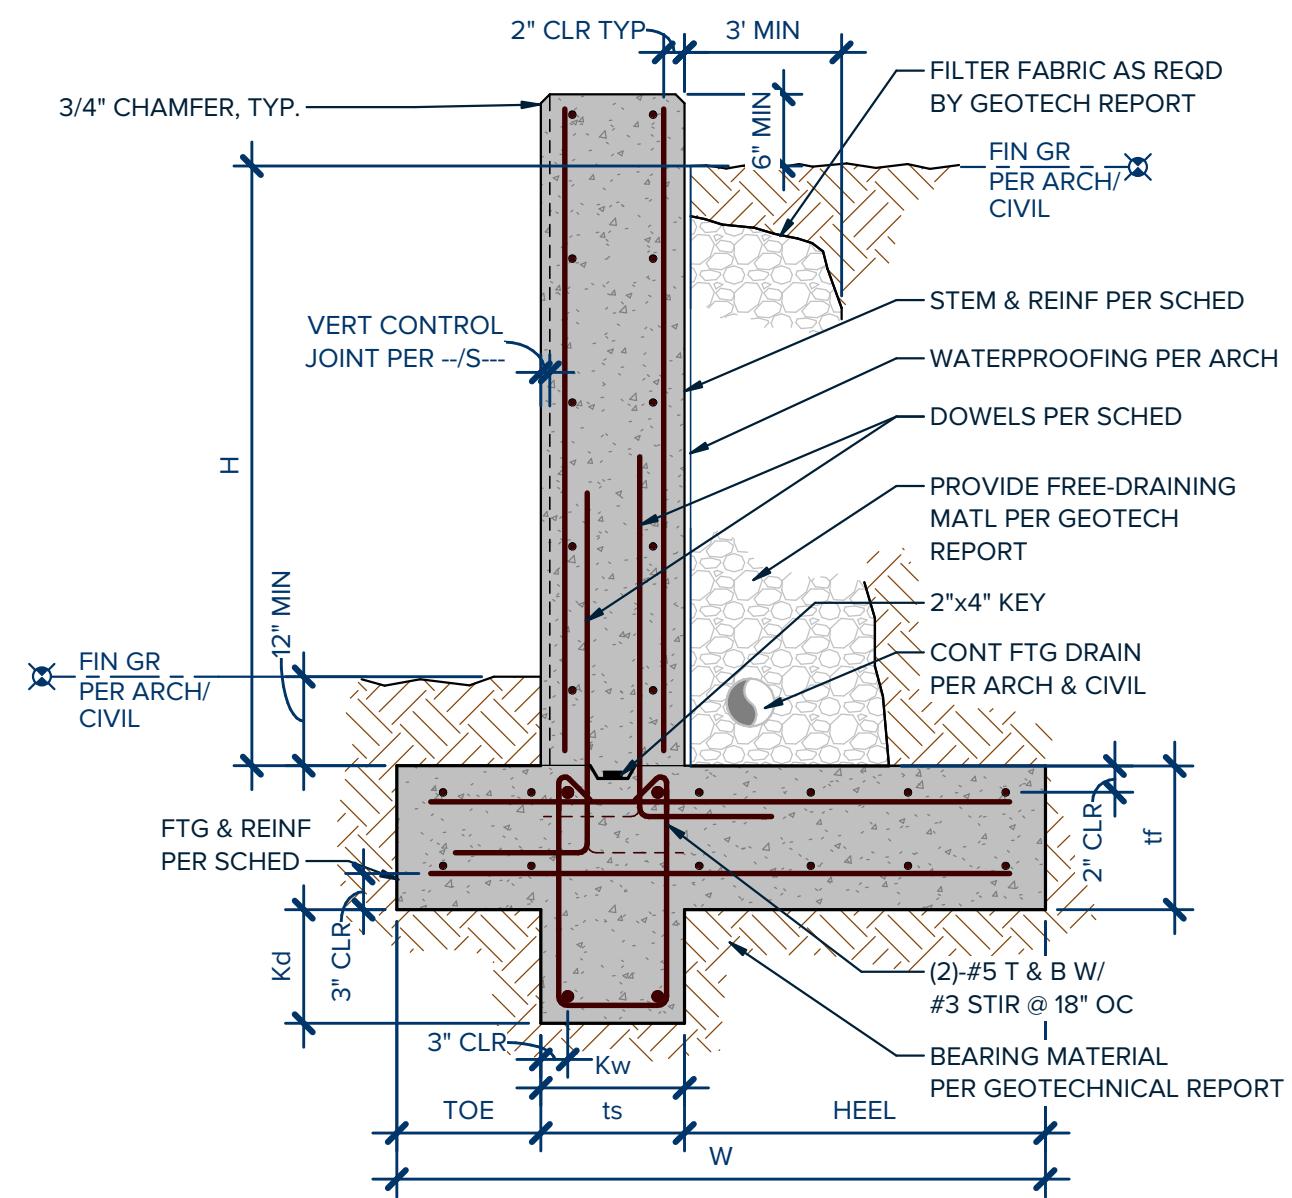

| RETAINING WALL & FOOTING SCHEDULE |                |       |               |        |       |                    |            |                        |                        |                    |            |
|-----------------------------------|----------------|-------|---------------|--------|-------|--------------------|------------|------------------------|------------------------|--------------------|------------|
| H                                 | STEM/KEY SIZES |       | FOOTING SIZES |        |       | STEM REINFORCEMENT |            | FOOTING REINFORCEMENT  |                        |                    |            |
|                                   | ts & Kw        | Kd    | TOE           | HEEL   | tf    | W                  | VERTICAL   | HORIZONTAL             | DOWELS FROM FOOTING    | T & B LONGITUDINAL |            |
| UP TO 6'-0"                       | 8"             | 1'-0" | 1'-0"         | 1'-10" | 1'-0" | 3'-6"              | #4 @ 12"OC | #4x3'-0"x1'-4" @ 12"OC | (3)-#4 EQ. SPACING     | #5 @ 12"OC         |            |
| 6'-1" - 8'-0"                     | 1'-0"          | 1'-0" | 1'-0"         | 2'-6"  | 1'-4" | 4'-6"              | #5 @ 12"OC | #4x4'-0"x1'-4" @ 12"OC | (4)-#4 EQ. SPACING     | #5 @ 12"OC         |            |
| 8'-1" - 10'-0"                    | 1'-0"          | 1'-0" | 2'-0"         | 4'-6"  | 1'-4" | 7'-0"              | #5 @ 12"OC | #5x4'-0"x1'-4" @ 12"OC | (4)-#4 EQ. SPACING     | #5 @ 12"OC         |            |
| 10'-1" - 12'-0"                   | 1'-4"          | 1'-6" | 2'-0"         | 5'-2"  | 1'-4" | 8'-6"              | #5 @ 10"OC | #4 @ 12"OC             | #5x4'-0"x1'-4" @ 10"OC | (5)-#4 EQ. SPACING | #5 @ 10"OC |
| 12'-1" - 14'-0"                   | 1'-4"          | 1'-6" | 2'-0"         | 6'-8"  | 1'-4" | 10'-0"             | #5 @ 10"OC | #4 @ 12"OC             | #5x4'-0"x1'-4" @ 10"OC | (7)-#4 EQ. SPACING | #5 @ 10"OC |
| 14'-1" - 16'-0"                   | 1'-4"          | 1'-6" | 2'-0"         | 8'-8"  | 1'-4" | 12'-0"             | #5 @ 10"OC | #4 @ 12"OC             | #5x4'-0"x1'-4" @ 10"OC | (8)-#4 EQ. SPACING | #5 @ 8"OC  |


## 01 TYPICAL RETAINING WALL WITH KEY

SCALE: 3/4" = 1'-0"

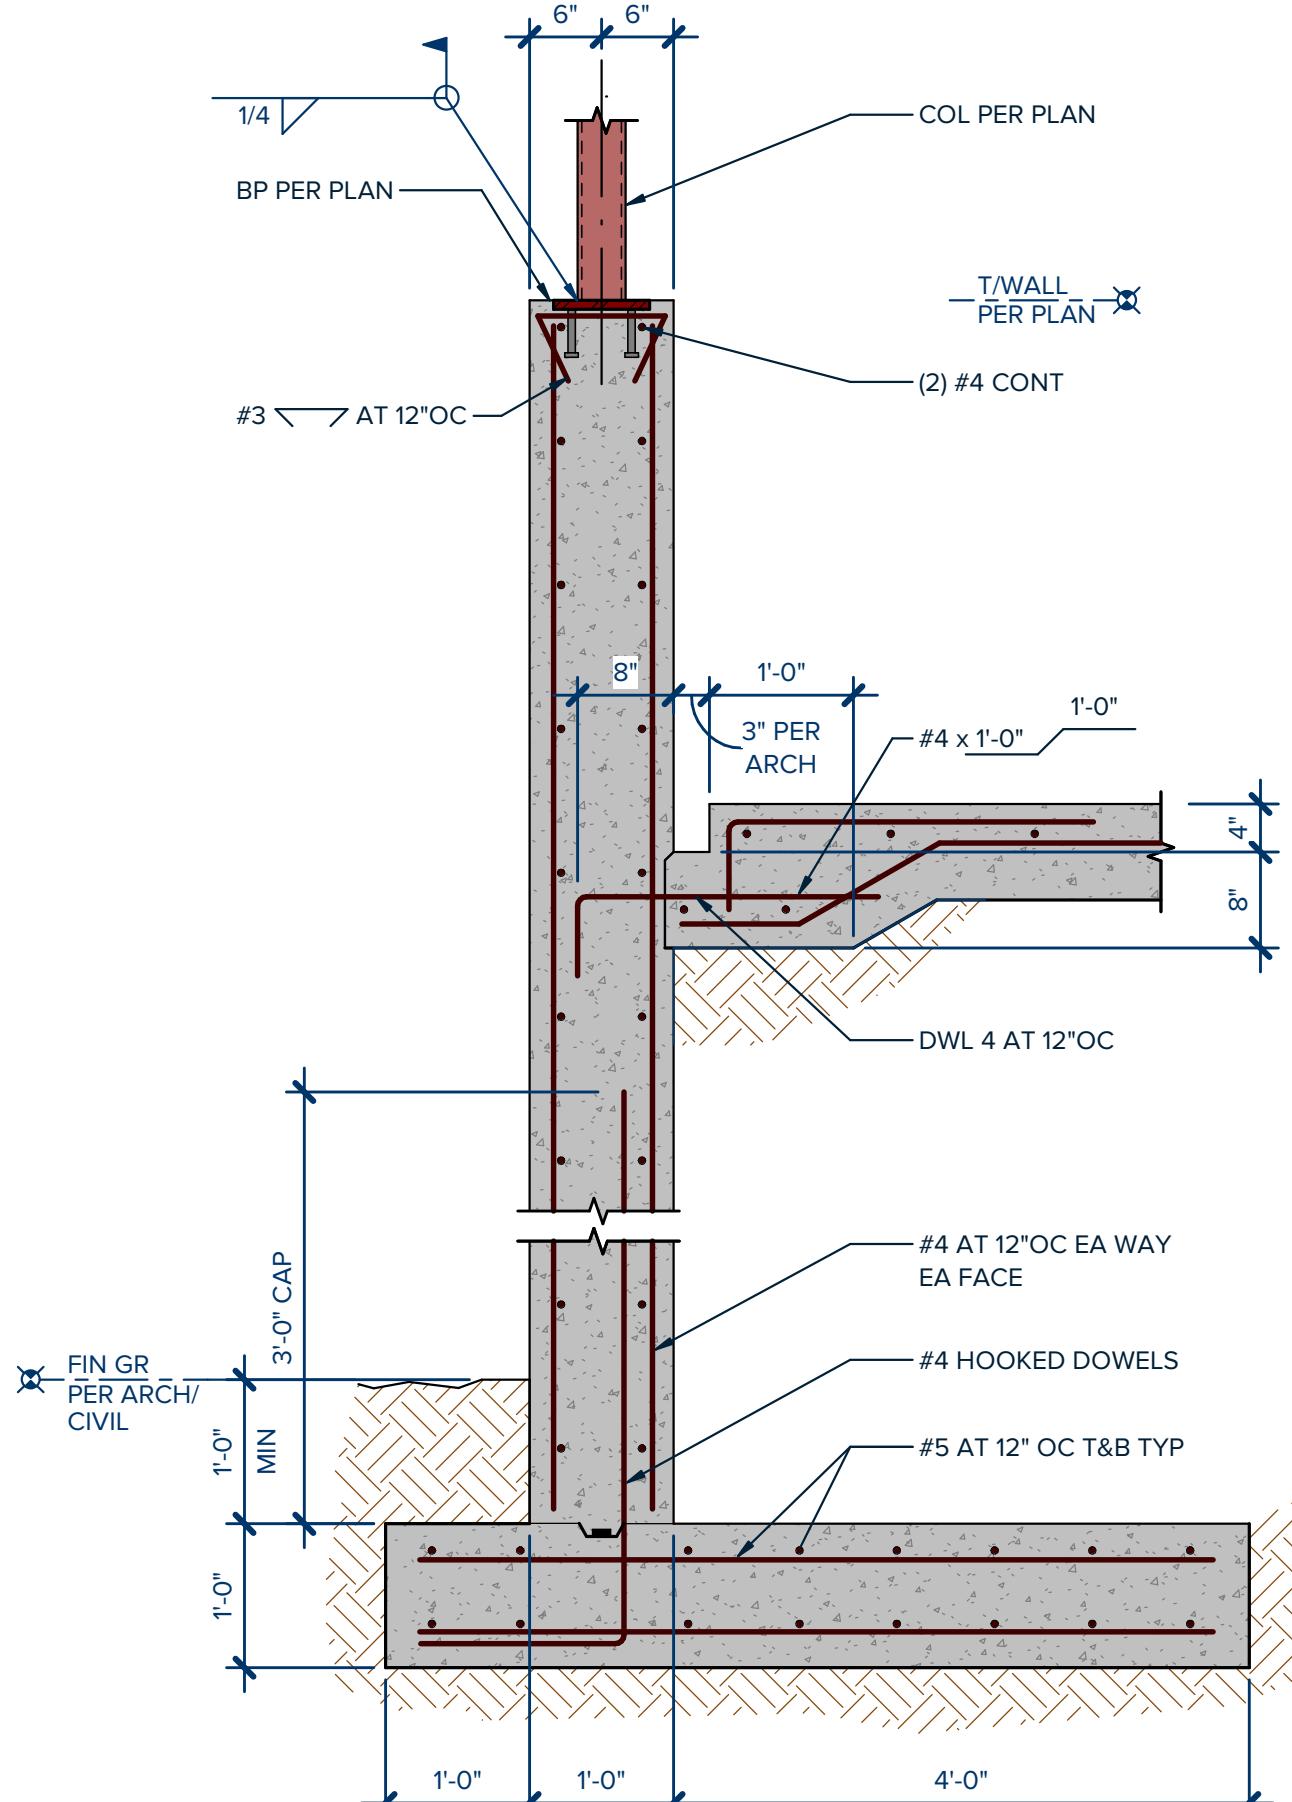

## 02 PORTCH RETAINING WALL DETAIL

SCALE: 3/4" = 1'-0"

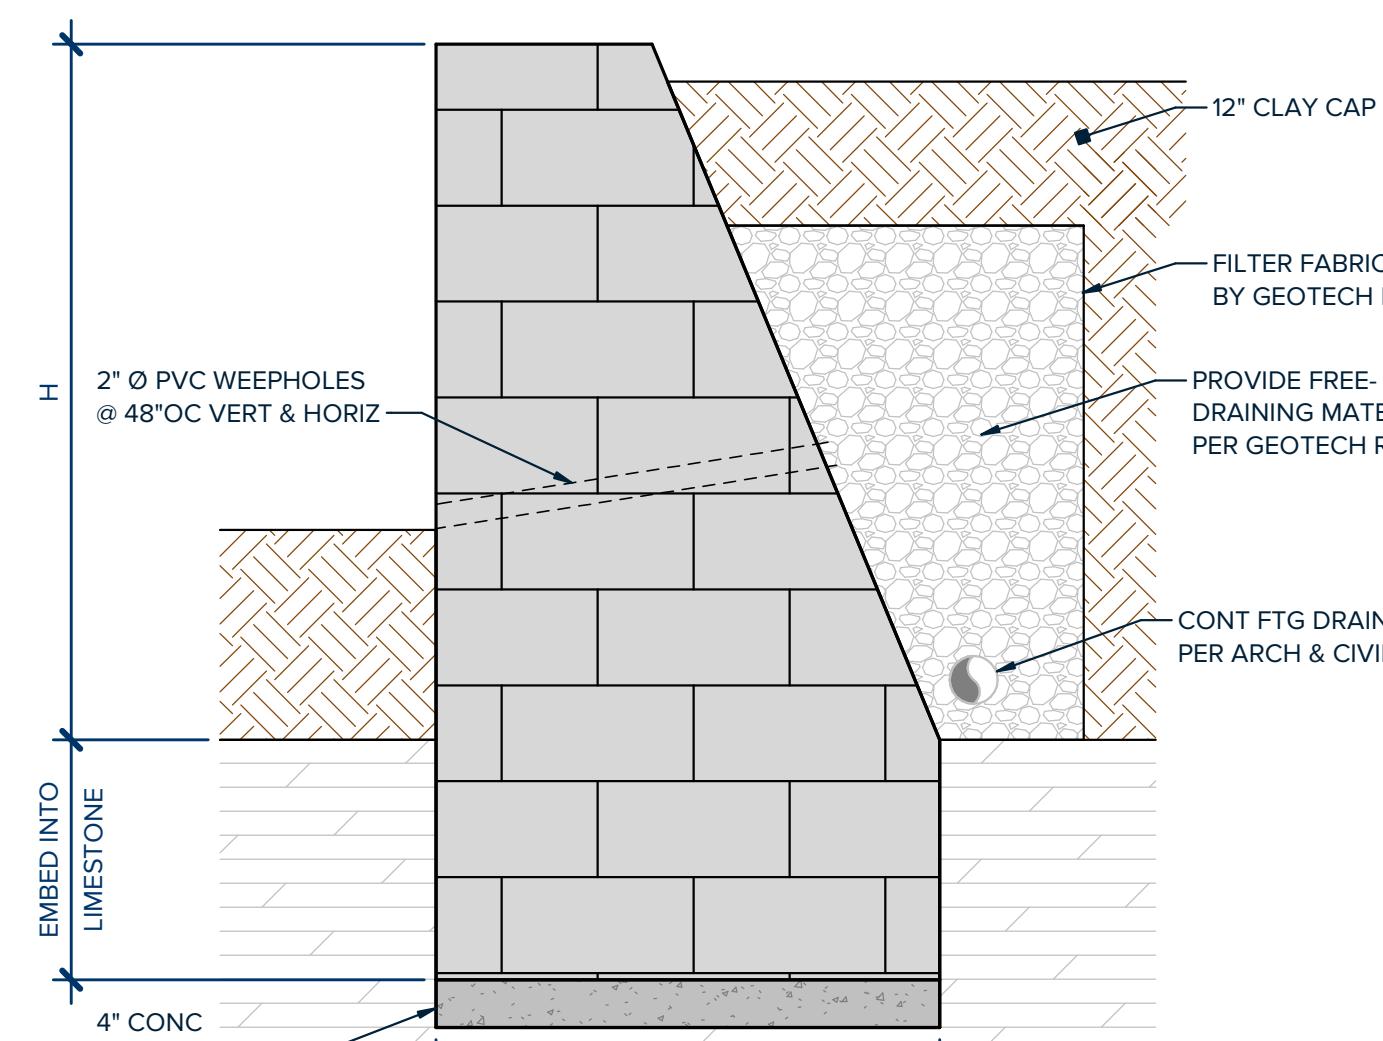

| LIMESTONE RETAINING WALL SCHEDULE |       |                      |
|-----------------------------------|-------|----------------------|
| H                                 | W     | EMBED INTO LIMESTONE |
| UP TO 5'-0"                       | 2'-0" | #5 @ 12"OC           |
| 6'-0"                             | 2'-6" | #5 @ 12"OC           |
| 7'-0"                             | 3'-0" | #5 @ 12"OC           |
| 8'-0"                             | 3'-6" | #5 @ 12"OC           |
| 9'-0"                             | 4'-0" | #6 @ 12"OC           |
| 10'-0"                            | 4'-6" | #6 @ 10"OC           |
| 11'-0"                            | 5'-0" | #5 @ 12"OC           |
| 12'-0"                            | 5'-6" | #5 @ 12"OC           |
| 13'-0"                            | 6'-0" | #5 @ 12"OC           |
| 14'-0"                            | 6'-8" | #5 @ 12"OC           |
| 15'-0"                            | 7'-0" | #6 @ 12"OC           |

## 03 DRY STACKED LIMESTONE WALL SCHEDULE

SCALE: 3/4" = 1'-0"

PERMIT DOCUMENTS

| NO                  | ISSUE | DATE |
|---------------------|-------|------|
| PM: S. Young        |       |      |
| ENG: S. Young       |       |      |
| BIM PM: C. Lawrence |       |      |
| QA/QC: S. Covey     |       |      |

If printed on 22x34 or 24x36 sheet, the scale is as indicated.  
If printed on an 11x17 or 12x18 sheet, the scale is reduced by half. SCALE

| FOUNDATION DETAILS |  |
|--------------------|--|
| SHEET TITLE        |  |

S4.20

SHEET NUMBER


COPYRIGHT © 2023 FORT STRUCTURES

ALTERSTUDIO  
ARCHITECTURE LLP  
1801 Lavaca Street  
Ste 106  
Austin, Texas 78701

ARCHITECT  
KOS RESIDENCE


17363 E Reed Parks Rd  
Jonestown, Texas 78645

PERMIT SET  
12.15.2023

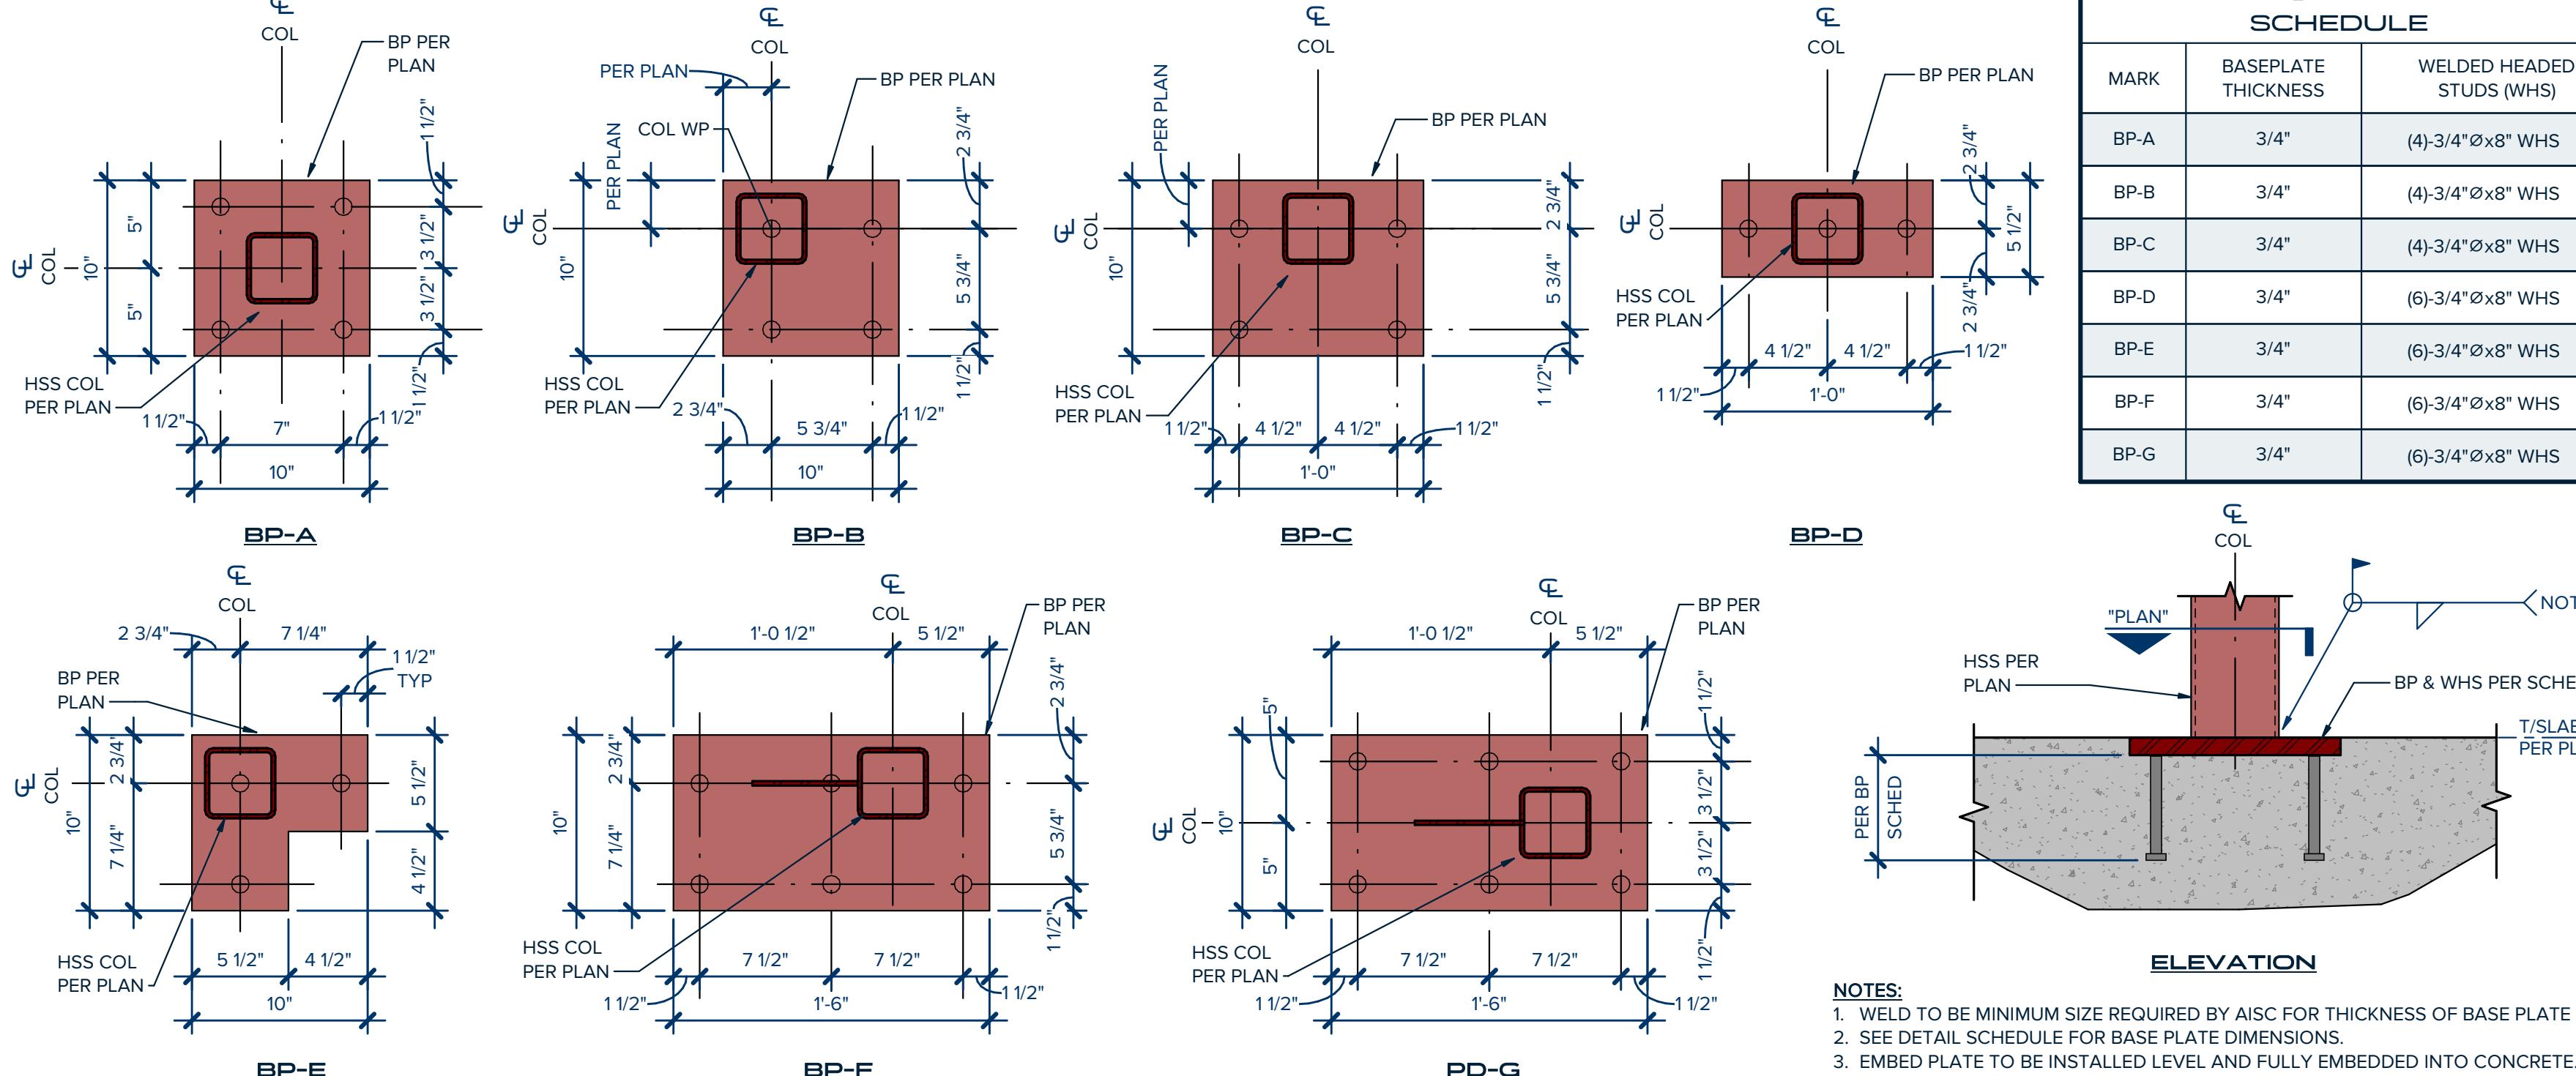


## 01 TYPICAL EMBEDDED BASEPLATE TO FOUNDATION CONNECTION (HSS COLUMN)

SCALE : 1 1/2" = 1'-0"

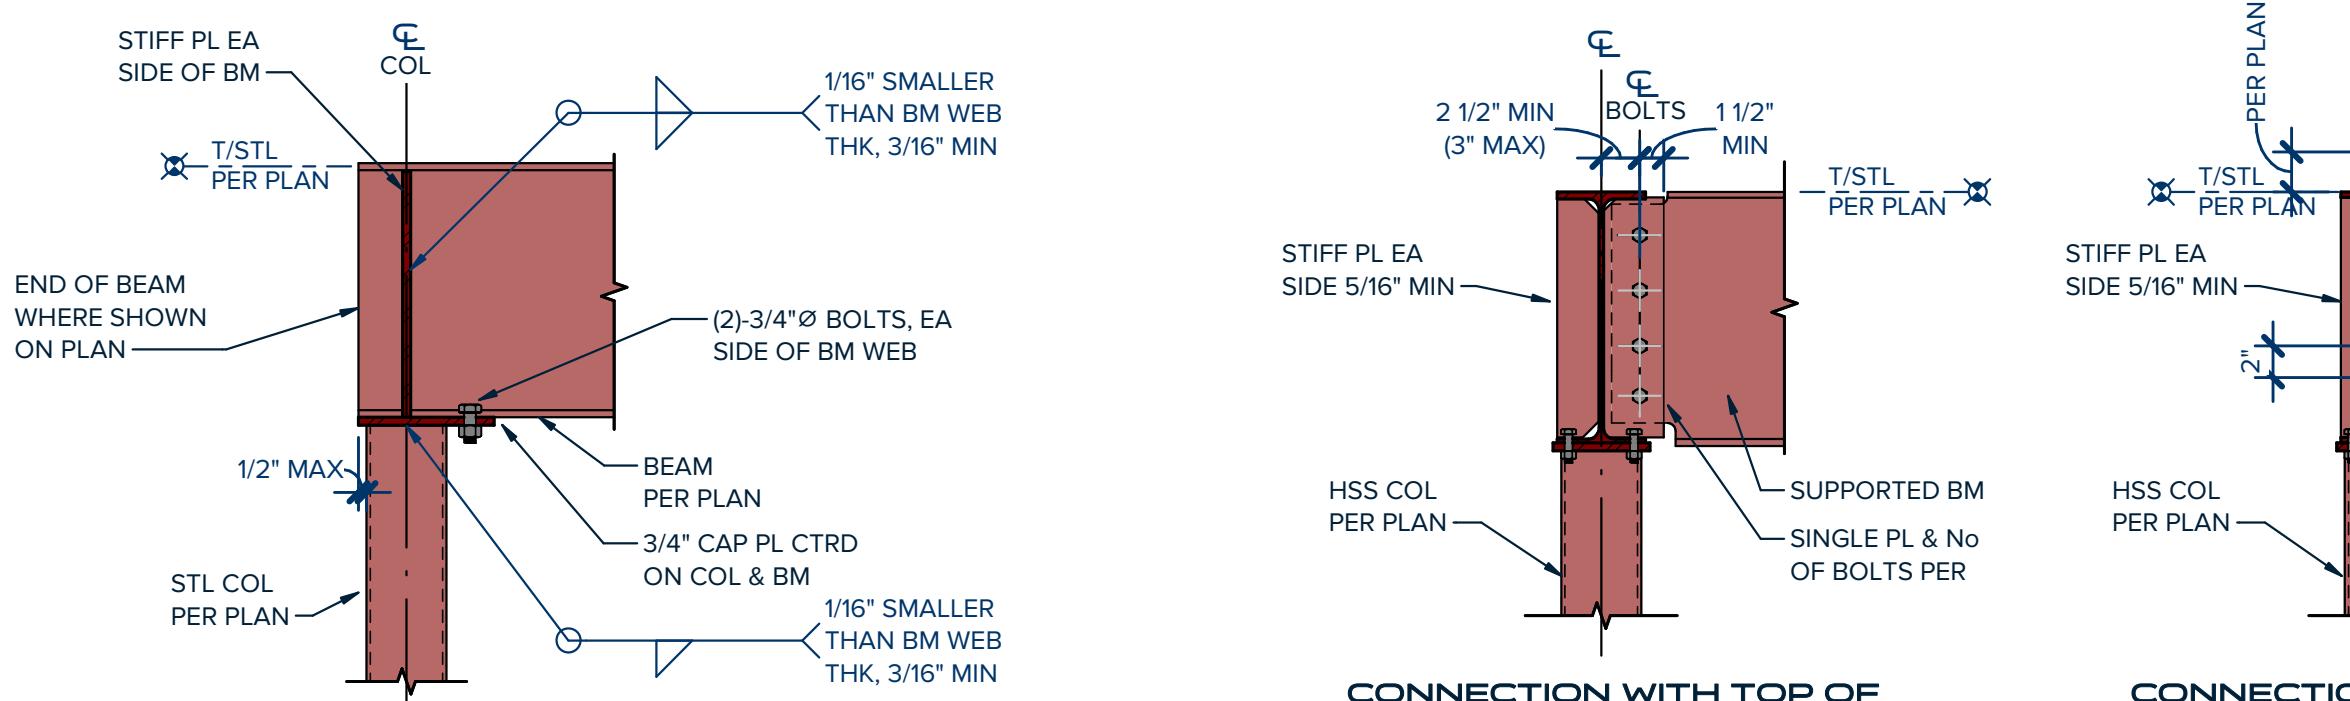

NOTES:  
1. SEE PLAN FOR ROOF SLOPE. SLOPE CAP PLATES ACCORDINGLY.  
2. STIFFENER PLATES SHALL BE EQUAL IN THICKNESS TO THE COLUMN WALL THICKNESS OR BEAM WEB THICKNESS, WHICHEVER IS GREATER.


3. CONNECT INTERSECTING BEAMS TO STIFFENER PLATES USING BOLTS IN SINGLE SHEAR DESIGNED FOR ECCENTRIC BEAM REACTION.

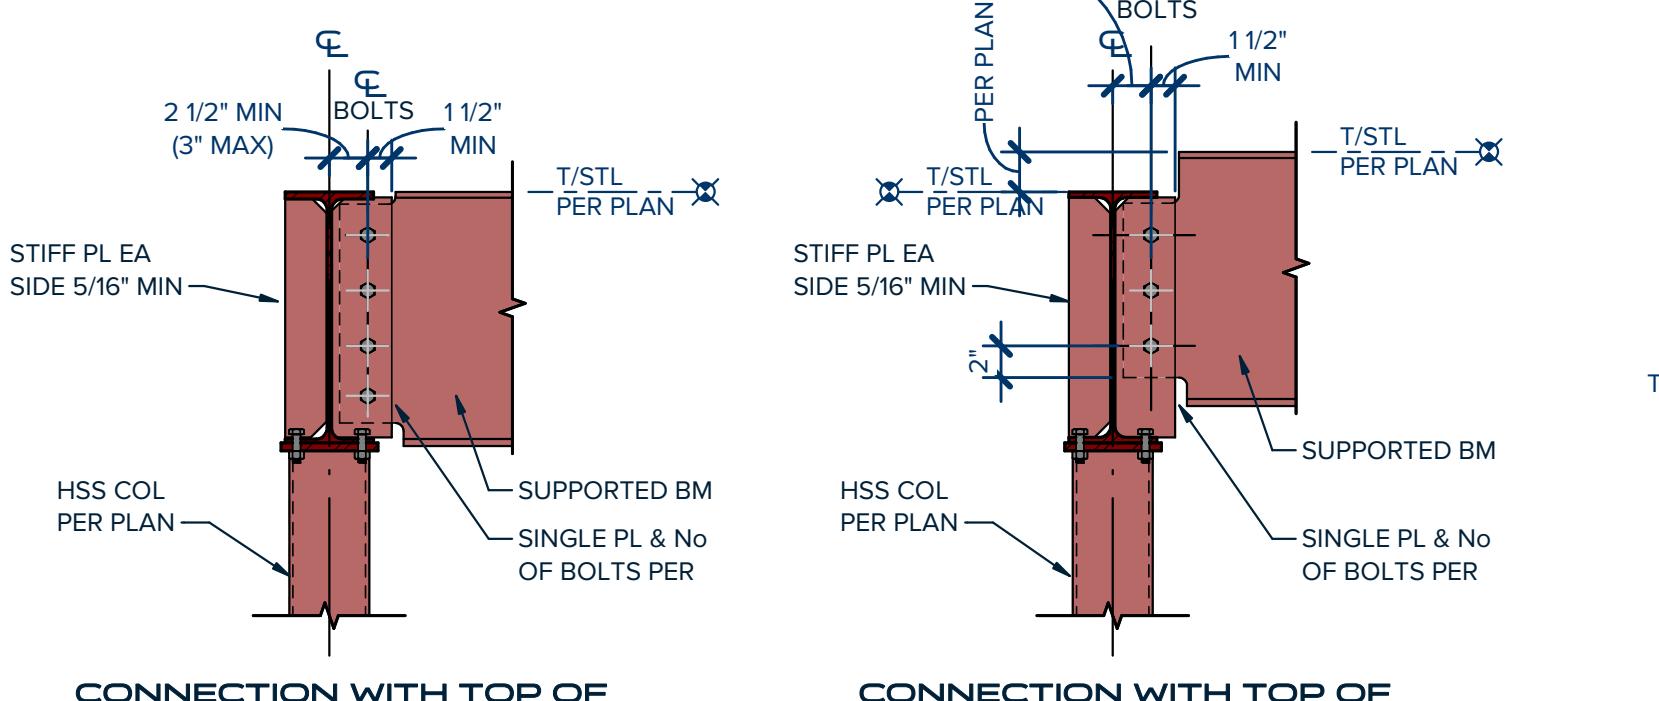

NOTES:  
1. SEE ROOF PLAN FOR ROOF SLOPE. SLOPE CAP PLATES ACCORDINGLY.  
2. STIFFENER PLATES SHALL BE EQUAL IN THICKNESS TO THE COLUMN WALL THICKNESS OR BEAM WEB THICKNESS, WHICHEVER IS GREATER.  
3. CONNECT INTERSECTING BEAMS TO STIFFENER PLATES USING BOLTS IN SINGLE SHEAR DESIGNED FOR ECCENTRIC BEAM REACTION.

## 03 CAP PLATE BOLTED CONNECTION

SCALE : 1" = 1'-0"

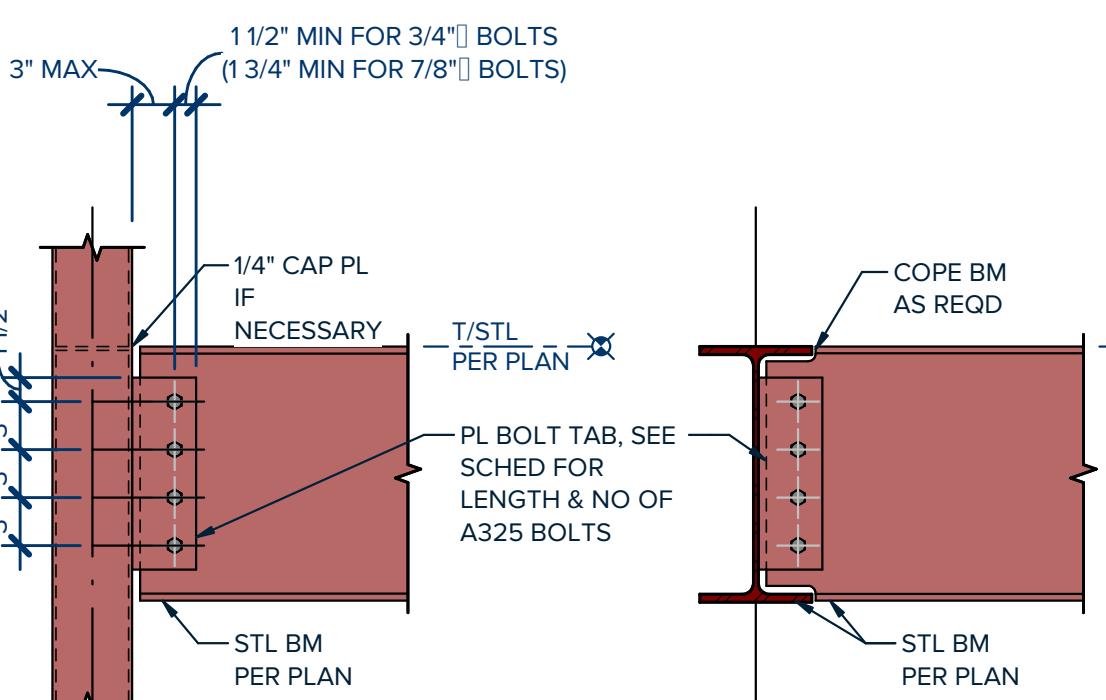

## 04 TYPICAL CONNECTION OF BEAMS OVER COLUMN

SCALE : 1" = 1'-0"

| SIMPLE SHEAR CONNECTION SCHEDULE |                        |               |                     |                 |                      |
|----------------------------------|------------------------|---------------|---------------------|-----------------|----------------------|
| BEAM SIZE                        | NO OF ROWS OF BOLTS(n) | BOLT DIAMETER | PLATE TAB THICKNESS | MIN. TAB LENGTH | WELD SIZE BOTH SIDES |
| W8                               | 2                      | 3/4"          | 5/16"               | 6"              | 1/4"                 |
| W10                              | 2                      |               |                     | 6"              |                      |
| W12                              | 3                      |               |                     | 9"              |                      |
| W14                              | 3                      |               |                     | 9"              |                      |
| W16                              | 4                      |               |                     | 12"             |                      |
| W18                              | 5                      |               |                     | 15"             |                      |
| W21                              | 6                      | 7/8"          | 3/8"                | 18"             |                      |
| W24                              | 7                      |               |                     | 21"             |                      |
| W27-W33                          | 8                      |               |                     | 24"             |                      |
| W36-W44                          | 10                     |               |                     | 30"             | 5/16"                |


NOTES:  
1. ALL OTHER CONNECTIONS DEVIATING FROM TYPICAL CONNECTIONS SHALL BE DESIGNED AND DETAILED BY A PROFESSIONAL ENGINEER WORKING UNDER THE GUIDANCE OF THE CONTRACTOR. REFERENCE GENERAL NOTES UNDER "STRUCTURAL STEEL CONNECTIONS."  
2. NOTED REACTIONS ARE FOR SERVICE LOADS.  
3. SCHEDULED SHEAR PLATE CONNECTIONS APPLY TO RIGHT ANGLE CONNECTIONS AND SKewed CONNECTIONS UP TO 30° FROM RIGHT ANGLE.  
4. WORKLINES ARE ON CENTERLINES OF BEAMS AND COLUMNS, UNLESS NOTED OTHERWISE.  
5. WELD CAPACITY BASED ON  $Ex = 70$  KSI.

## 07 SIMPLE SHEAR CONNECTION

SCALE : 1" = 1'-0"

## 02 CAP PLATE BOLTED CONNECTION

SCALE : 1" = 1'-0"

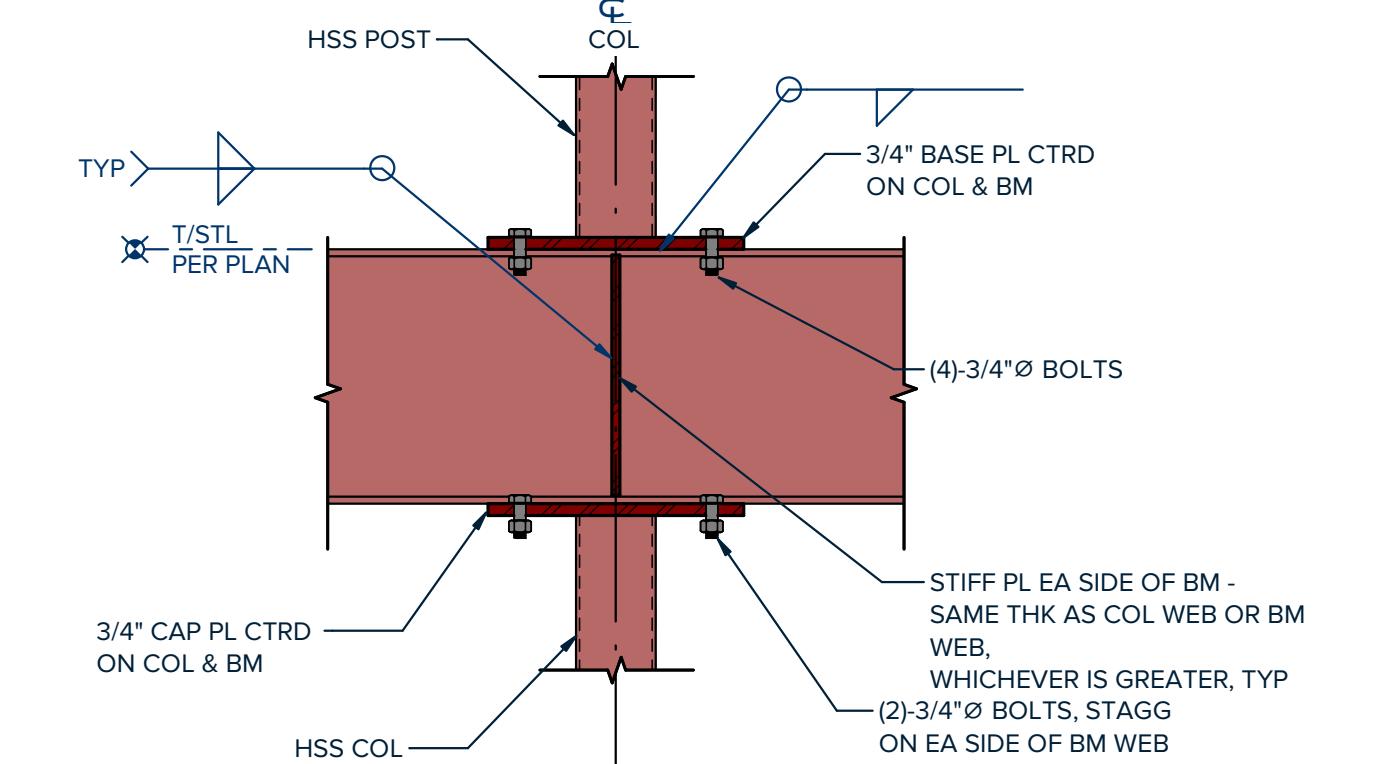

NOTES:  
1. CONNECT INTERSECTING BEAMS TO STIFFENER PLATES USING BOLTS IN SINGLE SHEAR DESIGNED FOR ECCENTRIC BEAM REACTION.

## 05 COLUMN SUPPORT ON BEAM CONNECTION

SCALE : 1" = 1'-0"



NOTES:  
1. CONNECT INTERSECTING BEAMS TO STIFFENER PLATES USING BOLTS IN SINGLE SHEAR DESIGNED FOR ECCENTRIC BEAM REACTION.

## 06 COLUMN SUPPORT ON BEAM CONNECTION

SCALE : 1" = 1'-0"

| NO                 | ISSUE | DATE |
|--------------------|-------|------|
| PM: S. Young       |       |      |
| ENG: S. Young      |       |      |
| BIM PM: C Lawrence |       |      |
| QA/QC: S Covey     |       |      |

If printed on 22x34 or 24x36 sheet,  
the scale is as indicated.  
If printed on an 11x17 or 12x18  
sheet, the scale is reduced by half.

SCALE  
TYPICAL BASE PLATE &  
HSS COLUMNS STEEL  
DETAILS

SHEET TITLE

PERMIT DOCUMENTS


S7.01

SHEET NUMBER

COPYRIGHT © 2023 FORT STRUCTURES


17363 E Reed Parks Rd  
Jonestown, Texas 78645

PERMIT SET  
12.15.2023

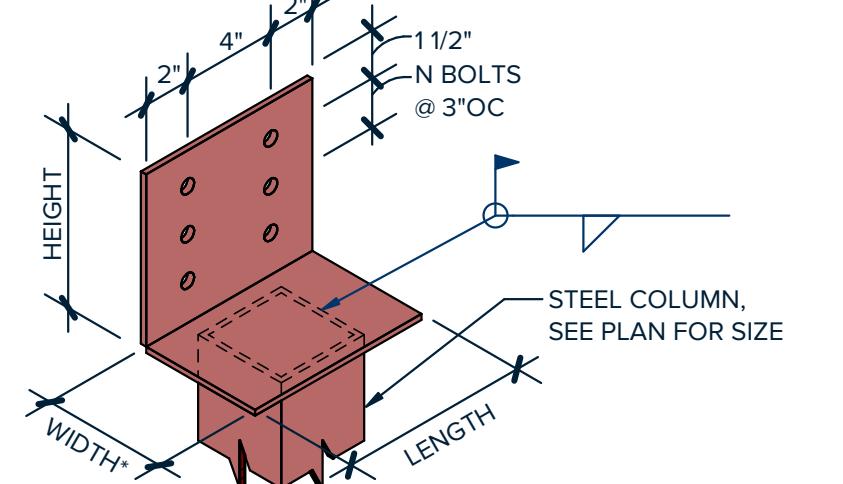

| BEAM SIZE                     | SADDLE DIMENSIONS |        |        | BOLT Specs           |
|-------------------------------|-------------------|--------|--------|----------------------|
|                               | HEIGHT            | WIDTH* | LENGTH |                      |
| (2)-2x8 TO (2)-2x12           | 6 1/2"            | 3"     | 8"     | (4)-5/8"Ø THRU BOLTS |
| (3)-2x8 TO (3)-2x12           | 6 1/2"            | 4 1/2" |        | (4)-5/8"Ø THRU BOLTS |
| (2)-5 1/2" LVL                | 4"                | 3 1/2" |        | (2)-5/8"Ø THRU BOLTS |
| (3)-5 1/2" LVL                | 4"                | 5 1/4" |        | (2)-5/8"Ø THRU BOLTS |
| (2)-7 1/4" LVL TO (2)-12" LVL | 6 1/2"            | 3 1/2" |        | (4)-5/8"Ø THRU BOLTS |
| (3)-7 1/4" LVL TO (3)-12" LVL | 6 1/2"            | 5 1/4" |        | (4)-5/8"Ø THRU BOLTS |
| (2)-14" LVL TO (2)-18" LVL    | 9 1/2"            | 3 1/2" |        | (6)-5/8"Ø THRU BOLTS |
| (3)-14" LVL TO (3)-18" LVL    | 9 1/2"            | 5 1/4" |        | (6)-5/8"Ø THRU BOLTS |
| (2)-20" LVL TO (2)-24" LVL    | 12 1/2"           | 3 1/2" |        | (8)-5/8"Ø THRU BOLTS |
| (3)-20" LVL TO (3)-24" LVL    | 12 1/2"           | 5 1/4" |        | (8)-5/8"Ø THRU BOLTS |

NOTES:  
1. WIDTH\*, INSIDE FACE TO INSIDE FACE OF PLATE SADDLE SHALL BE 1/4" THICK PLATE UNO.

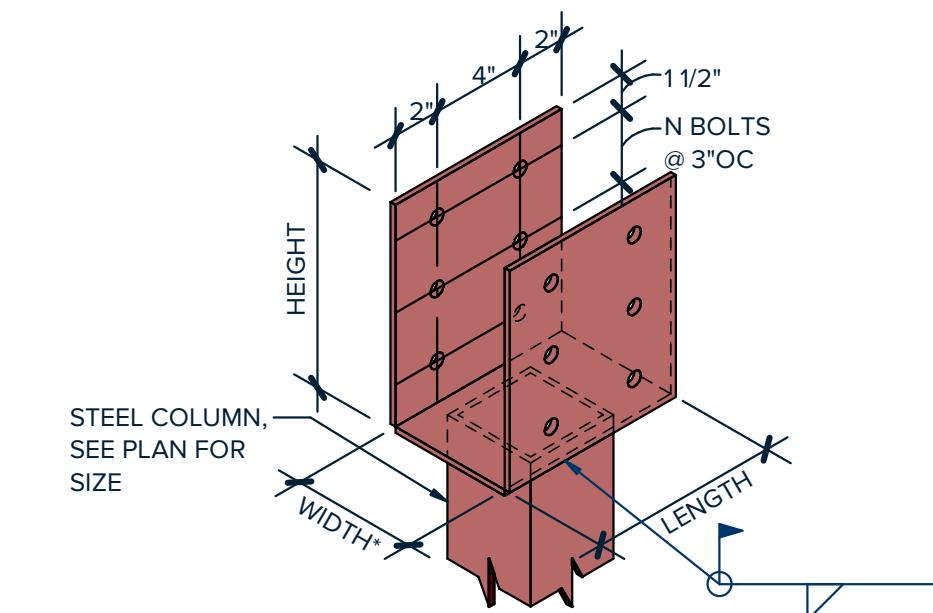

| BEAM SIZE                     | SADDLE DIMENSIONS |        |        | BOLT Specs           |
|-------------------------------|-------------------|--------|--------|----------------------|
|                               | HEIGHT            | WIDTH* | LENGTH |                      |
| (2)-2x8 TO (2)-2x12           | 6 1/2"            | 3"     | 8"     | (4)-5/8"Ø THRU BOLTS |
| (3)-2x8 TO (3)-2x12           | 6 1/2"            | 4 1/2" |        | (4)-5/8"Ø THRU BOLTS |
| (2)-5 1/2" LVL                | 4"                | 3 1/2" |        | (2)-5/8"Ø THRU BOLTS |
| (3)-5 1/2" LVL                | 4"                | 5 1/4" |        | (2)-5/8"Ø THRU BOLTS |
| (2)-7 1/4" LVL TO (2)-12" LVL | 6 1/2"            | 3 1/2" |        | (4)-5/8"Ø THRU BOLTS |
| (3)-7 1/4" LVL TO (3)-12" LVL | 6 1/2"            | 5 1/4" |        | (4)-5/8"Ø THRU BOLTS |
| (2)-14" LVL TO (2)-18" LVL    | 9 1/2"            | 3 1/2" |        | (6)-5/8"Ø THRU BOLTS |
| (3)-14" LVL TO (3)-18" LVL    | 9 1/2"            | 5 1/4" |        | (6)-5/8"Ø THRU BOLTS |
| (2)-20" LVL TO (2)-24" LVL    | 12 1/2"           | 3 1/2" |        | (8)-5/8"Ø THRU BOLTS |
| (3)-20" LVL TO (3)-24" LVL    | 12 1/2"           | 5 1/4" |        | (8)-5/8"Ø THRU BOLTS |

NOTES:  
1. WIDTH\*, INSIDE FACE TO INSIDE FACE OF PLATE SADDLE SHALL BE 1/4" THICK PLATE UNO.

## 01 OPEN SADDLE OVER COLUMN

SCALE : NTS

## 02 CLOSED SADDLE OVER COLUMN

SCALE : INTS

## 03 BEAM HANGER ON STEEL BEAM

SCALE : 1" = 1'-0"


## 04 LVL BEAM TO CANT WF BEAM CONNECTION

SCALE : 1" = 1'-0"

### LVL TO STL CONX SCHEDULE

| BEAM DEPTH  | SIMPSON HANGER |
|-------------|----------------|
| (4)-18" LVL | HGLTV418-2     |
| (3)-18" LVL | HGLTV5.518     |
| (2)-18" LVL | GLTV3.518      |
| (3)-16" LVL | GLTV5.516      |
| (2)-16" LVL | GLTV3.516      |
| (3)-14" LVL | GLTV5.514      |
| (2)-14" LVL | HW1414         |
| (3)-12" LVL | GLTV5.512      |
| (2)-12" LVL | HW1412         |

NOTES:  
1. INSTALL ACCORDING TO MANUFACTURER SPECIFICATIONS. SUBSTITUTION MUST MEET EQUIVALENT LOADING, AND CONFIRMED WITH ENGINEER.

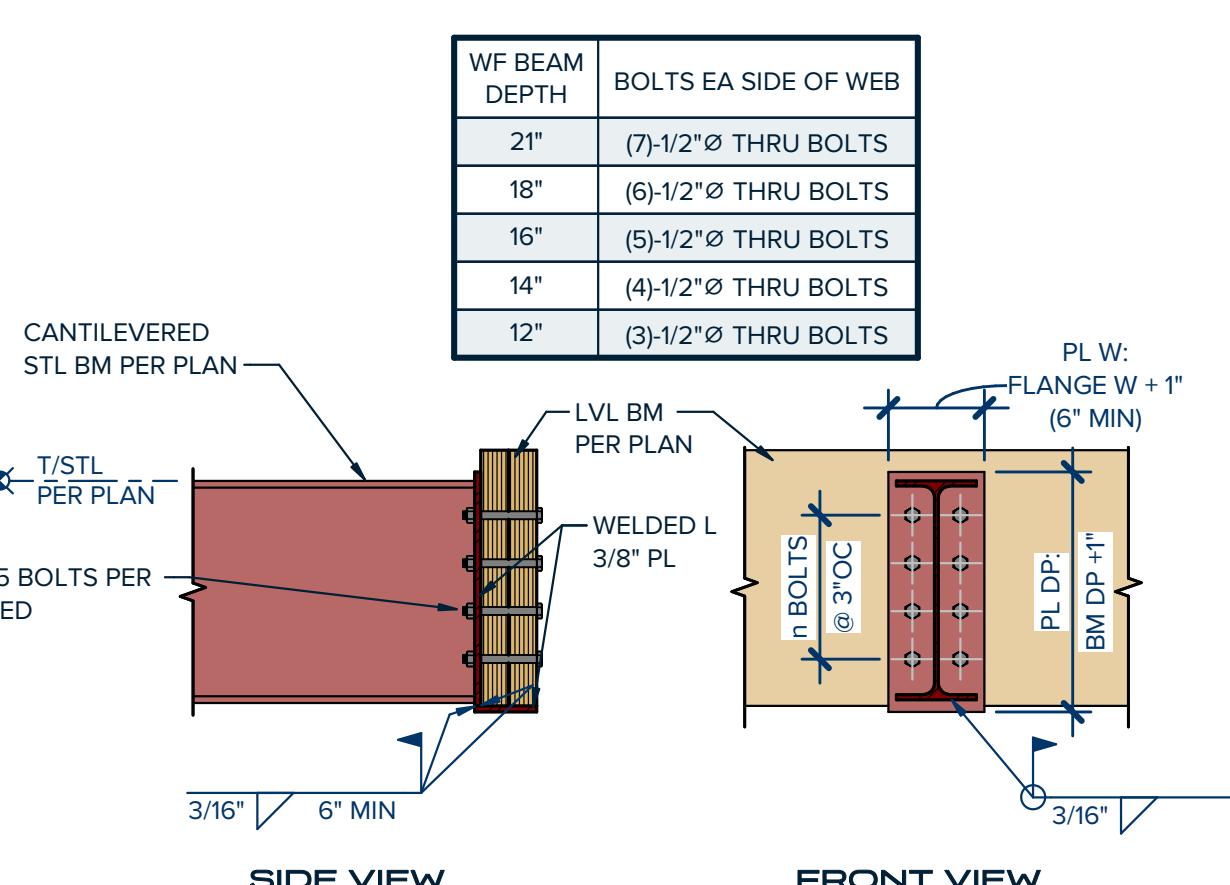

NOTES:  
1. DO NOT PLACE LVL BEAM JOINT AT LOCATION OF THIS CONNECTION.

## 05 LVL BEAM TO CANT WF BEAM CONNECTION

SCALE : 1" = 1'-0"

## 06 WF BEAM NAILER

SCALE : 1" = 1'-0"

## 07 WF BEAM NAILER AT TRUSS HANGERS

SCALE : 1" = 1'-0"

## 08 WEB PACKING

SCALE : 1" = 1'-0"

NOTES:  
1. DO NOT PLACE LVL BEAM JOINT AT LOCATION OF THIS CONNECTION.

NOTES:  
1. DO NOT PLACE LVL BEAM JOINT AT LOCATION OF THIS CONNECTION.

NOTES:  
1. DO NOT PLACE LVL BEAM JOINT AT LOCATION OF THIS CONNECTION.</p

STATE OF TEXAS  
SAMUEL YOUNG  
99208  
PROFESSOR OF  
ARCHITECTURE  
12/15/2023

ALTERSTUDIO  
ARCHITECTURE LLP  
1801 Lavaca Street  
Ste 106  
Austin, Texas 78701


ARCHITECT  
KOS RESIDENCE

17363 E Reed Parks Rd  
Jonestown, Texas 78645

PERMIT SET  
12.15.2023

| FASTENER SCHEDULE FOR STRUCTURAL MEMBERS |                                                                                   |                                                                                                 |                                                                                               |
|------------------------------------------|-----------------------------------------------------------------------------------|-------------------------------------------------------------------------------------------------|-----------------------------------------------------------------------------------------------|
| ROOF                                     |                                                                                   | SPACING OF FASTENERS                                                                            |                                                                                               |
| ITEM                                     | DESCRIPTION OF BUILDING ELEMENTS                                                  | NUMBER AND TYPE OF FASTENER                                                                     |                                                                                               |
| 1                                        | BLOCKING BETWEEN JOISTS OR RAFTERS TO TOP PLATE, TOE NAIL                         | (3)-8d (2 1/2" x 0.113") / (3)-3" x 0.131"                                                      | —                                                                                             |
| 2                                        | CEILING JOISTS TO PLATE, TOE NAIL                                                 | (3)-8d (2 1/2" x 0.113") / (3)-3" x 0.131"                                                      | —                                                                                             |
| 3                                        | CEILING JOISTS NOT ATTACHED TO PARALLEL RAFTER, LAPS OVER PARTITIONS, FACE NAIL   | (3)-10d (3" x 0.131")                                                                           | —                                                                                             |
| 4                                        | COLLAR TIE TO RAFTER, FACE NAIL OR 1/4" x 20 GAGE RIDGE STRAP                     | (3)-10d (3" x 0.128") / (4)-3" x 0.131"                                                         | —                                                                                             |
| 5                                        | RAFTER OR ROOF TRUSS TO PLATE, TOE NAIL                                           | (3)-16d BOX NAILS (3 1/2" x 0.135")<br>or (3)-10d COMMON NAILS (3" x 0.148")<br>(3)-3" x 0.131" | (2)-TOE NAILS ON ONE SIDE & (1)-TOE NAIL<br>ON opp SIDE OF EA RAFTER OR TRUSS                 |
| 6                                        | ROOF RAFTERS TO RIDGE, VALLEY OR HIP RAFTERS: TOE NAIL FACE NAIL                  | (4)-16d (3 1/2" x 0.135") / (4)-3" x 0.131"                                                     | TOE NAIL                                                                                      |
|                                          |                                                                                   | (3)-16d (3 1/2" x 0.135") / (3)-3" x 0.131"                                                     | END NAIL                                                                                      |
| WALL                                     |                                                                                   | SPACING OF FASTENERS                                                                            |                                                                                               |
| 7                                        | BUILT-UP STUDS-FACE NAIL                                                          | 10d (3" x 0.128") / 3" x 0.131"                                                                 | 24"OC / 16"OC                                                                                 |
| 8                                        | ABUTTING STUDS AT INTERSECTING WALL CORNERS, FACE NAIL                            | 16d (3 1/2" x 0.135") / 3" x 0.131"                                                             | 12"OC                                                                                         |
| 9                                        | BUILT-UP HEADER, TWO PIECES WITH 1/2" SPACER                                      | 16d (3 1/2" x 0.135")                                                                           | 16"OC ALONG EA EDGE                                                                           |
| 10                                       | CONTINUED HEADER, TWO PIECES                                                      | 16d (3 1/2" x 0.135")                                                                           | 16"OC ALONG EA EDGE                                                                           |
| 11                                       | CONTINUOUS HEADER TO STUD, TOE NAIL                                               | (4)-8d (2 1/2" x 0.113")                                                                        | —                                                                                             |
| 12                                       | DOUBLE STUDS, FACE NAIL                                                           | 10d (3" x 0.128")                                                                               | 24"OC                                                                                         |
| 13                                       | DOUBLE TOP PLATES, FACE NAIL                                                      | 16d (3" x 0.128") / 3" x 0.131"                                                                 | 16"OC                                                                                         |
| 14                                       | DOUBLE TOP PLATES, MINIMUM 24-INCH OFFSET OF END JOINTS, FACE NAIL IN LAPPED AREA | (8)-16d (3 1/2" x 0.135")<br>(12)-3" x 0.131"                                                   | —                                                                                             |
| 15                                       | SOLE PLATE TO JOIST OR BLOCKING, FACE NAIL                                        | 16d (3 1/2" x 0.135") / 3" x 0.131"                                                             | 16"OC / 12"OC                                                                                 |
| 16                                       | SOLE PLATE TO JOIST OR BLOCKING AT BRACED WALL PANELS                             | (3)-16d (3 1/2" x 0.135") / (4)-3" x 0.131"                                                     | (3)-EA @ 16"OC / (4)-EA @ 12"OC                                                               |
| 17                                       | STUD TO SOLE PLATE, TOE NAIL                                                      | (3)-8d (2 1/2" x 0.113")<br>(2)-16d (3 1/2" x 0.135")<br>(4)-3" x 0.131"                        | —                                                                                             |
| 18                                       | TOP OR SOLE PLATE TO STUD, END NAIL                                               | (2)-16d (3 1/2" x 0.135") / (3)-3" x 0.131"                                                     | —                                                                                             |
| 19                                       | TOP PLATES, LAPS AT CORNERS AND INTERSECTIONS, FACE NAIL                          | (2)-10d (3" x 0.128") / (3)-3" x 0.131"                                                         | —                                                                                             |
| 20                                       | 1" BRACE TO EACH STUD AND PLATE, FACE NAIL                                        | (2)-8d (2 1/2" x 0.113") (2)-STAPLES 1 3/4"                                                     | —                                                                                             |
| 21                                       | 1"x6" SHEATHING TO EACH BEARING, FACE NAIL                                        | (2)-8d (2 1/2" x 0.113") (2)-STAPLES 1 3/4"                                                     | —                                                                                             |
| 22                                       | 1"x8" SHEATHING TO EACH BEARING, FACE NAIL                                        | (2)-8d (2 1/2" x 0.113") (2)-STAPLES 1 3/4"                                                     | —                                                                                             |
| 23                                       | WIDER THAN 1"x8" SHEATHING TO EACH BEARING, FACE NAIL                             | (3)-8d (2 1/2" x 0.113") (4)-STAPLES 1 3/4"                                                     | —                                                                                             |
| FLOOR                                    |                                                                                   | SPACING OF FASTENERS                                                                            |                                                                                               |
| 24                                       | JOIST TO SILL OR GIRDER, TOE NAIL                                                 | (3)-8d (2 1/2" x 0.113") / (3)-3" x 0.131"                                                      | —                                                                                             |
| 25                                       | RIM JOIST TO TOP PLATE, TOE NAIL (ROOF APPLICATIONS ALSO)                         | 8d (2 1/2" x 0.113") / 3" x 0.131"                                                              | 4"OC / 6"OC                                                                                   |
| 26                                       | RIM JOIST OR BLOCKING TO SILL PLATE, TOE NAIL                                     | 8d (2 1/2" x 0.113") / 3" x 0.131"                                                              | 4"OC / 6"OC                                                                                   |
| 27                                       | 1"x6" SUBFLOOR OR LESS TO EACH JOIST, FACE NAIL                                   | (2)-8d (2 1/2" x 0.113") (2)-STAPLES 1 3/4"                                                     | —                                                                                             |
| 28                                       | 2" SUBFLOOR TO JOIST OR GIRDER, BLIND AND FACE NAIL                               | (2)-16d (3 1/2" x 0.135")                                                                       | —                                                                                             |
| 29                                       | 2" PLANKS (PLANK & BEAM - FLOOR & ROOF)                                           | (2)-16d (3 1/2" x 0.135")                                                                       | AT EA BEARING                                                                                 |
| 30                                       | BAND OR RIM JOIST TO JOIST, END NAIL                                              | (3)-10d (3" x 0.128") / (4)-3" x 0.131"                                                         | —                                                                                             |
| 31                                       | BUILT-UP GIRDERS AND BEAMS, 2" LUMBER LAYERS                                      | 10d (3" x 0.128") / (3)-3" x 0.131"                                                             | NAIL EA LAYER AS FOLLOWS: 24"OC @ T&B AND STAGG ON opp SIDES. (2)-NAILS @ ENDS & @ EA SPLICE. |
| 32                                       | LEDGER STRIP SUPPORTING JOISTS OR RAFTERS                                         | (3)-16d (3 1/2" x 0.135")                                                                       | AT EA JOIST OR RAFTER                                                                         |

NOTES:  
1. 3"x0.131" COLLATED FASTENERS ARE APPROPRIATE FOR USE WITH PNEUMATIC NAILERS.

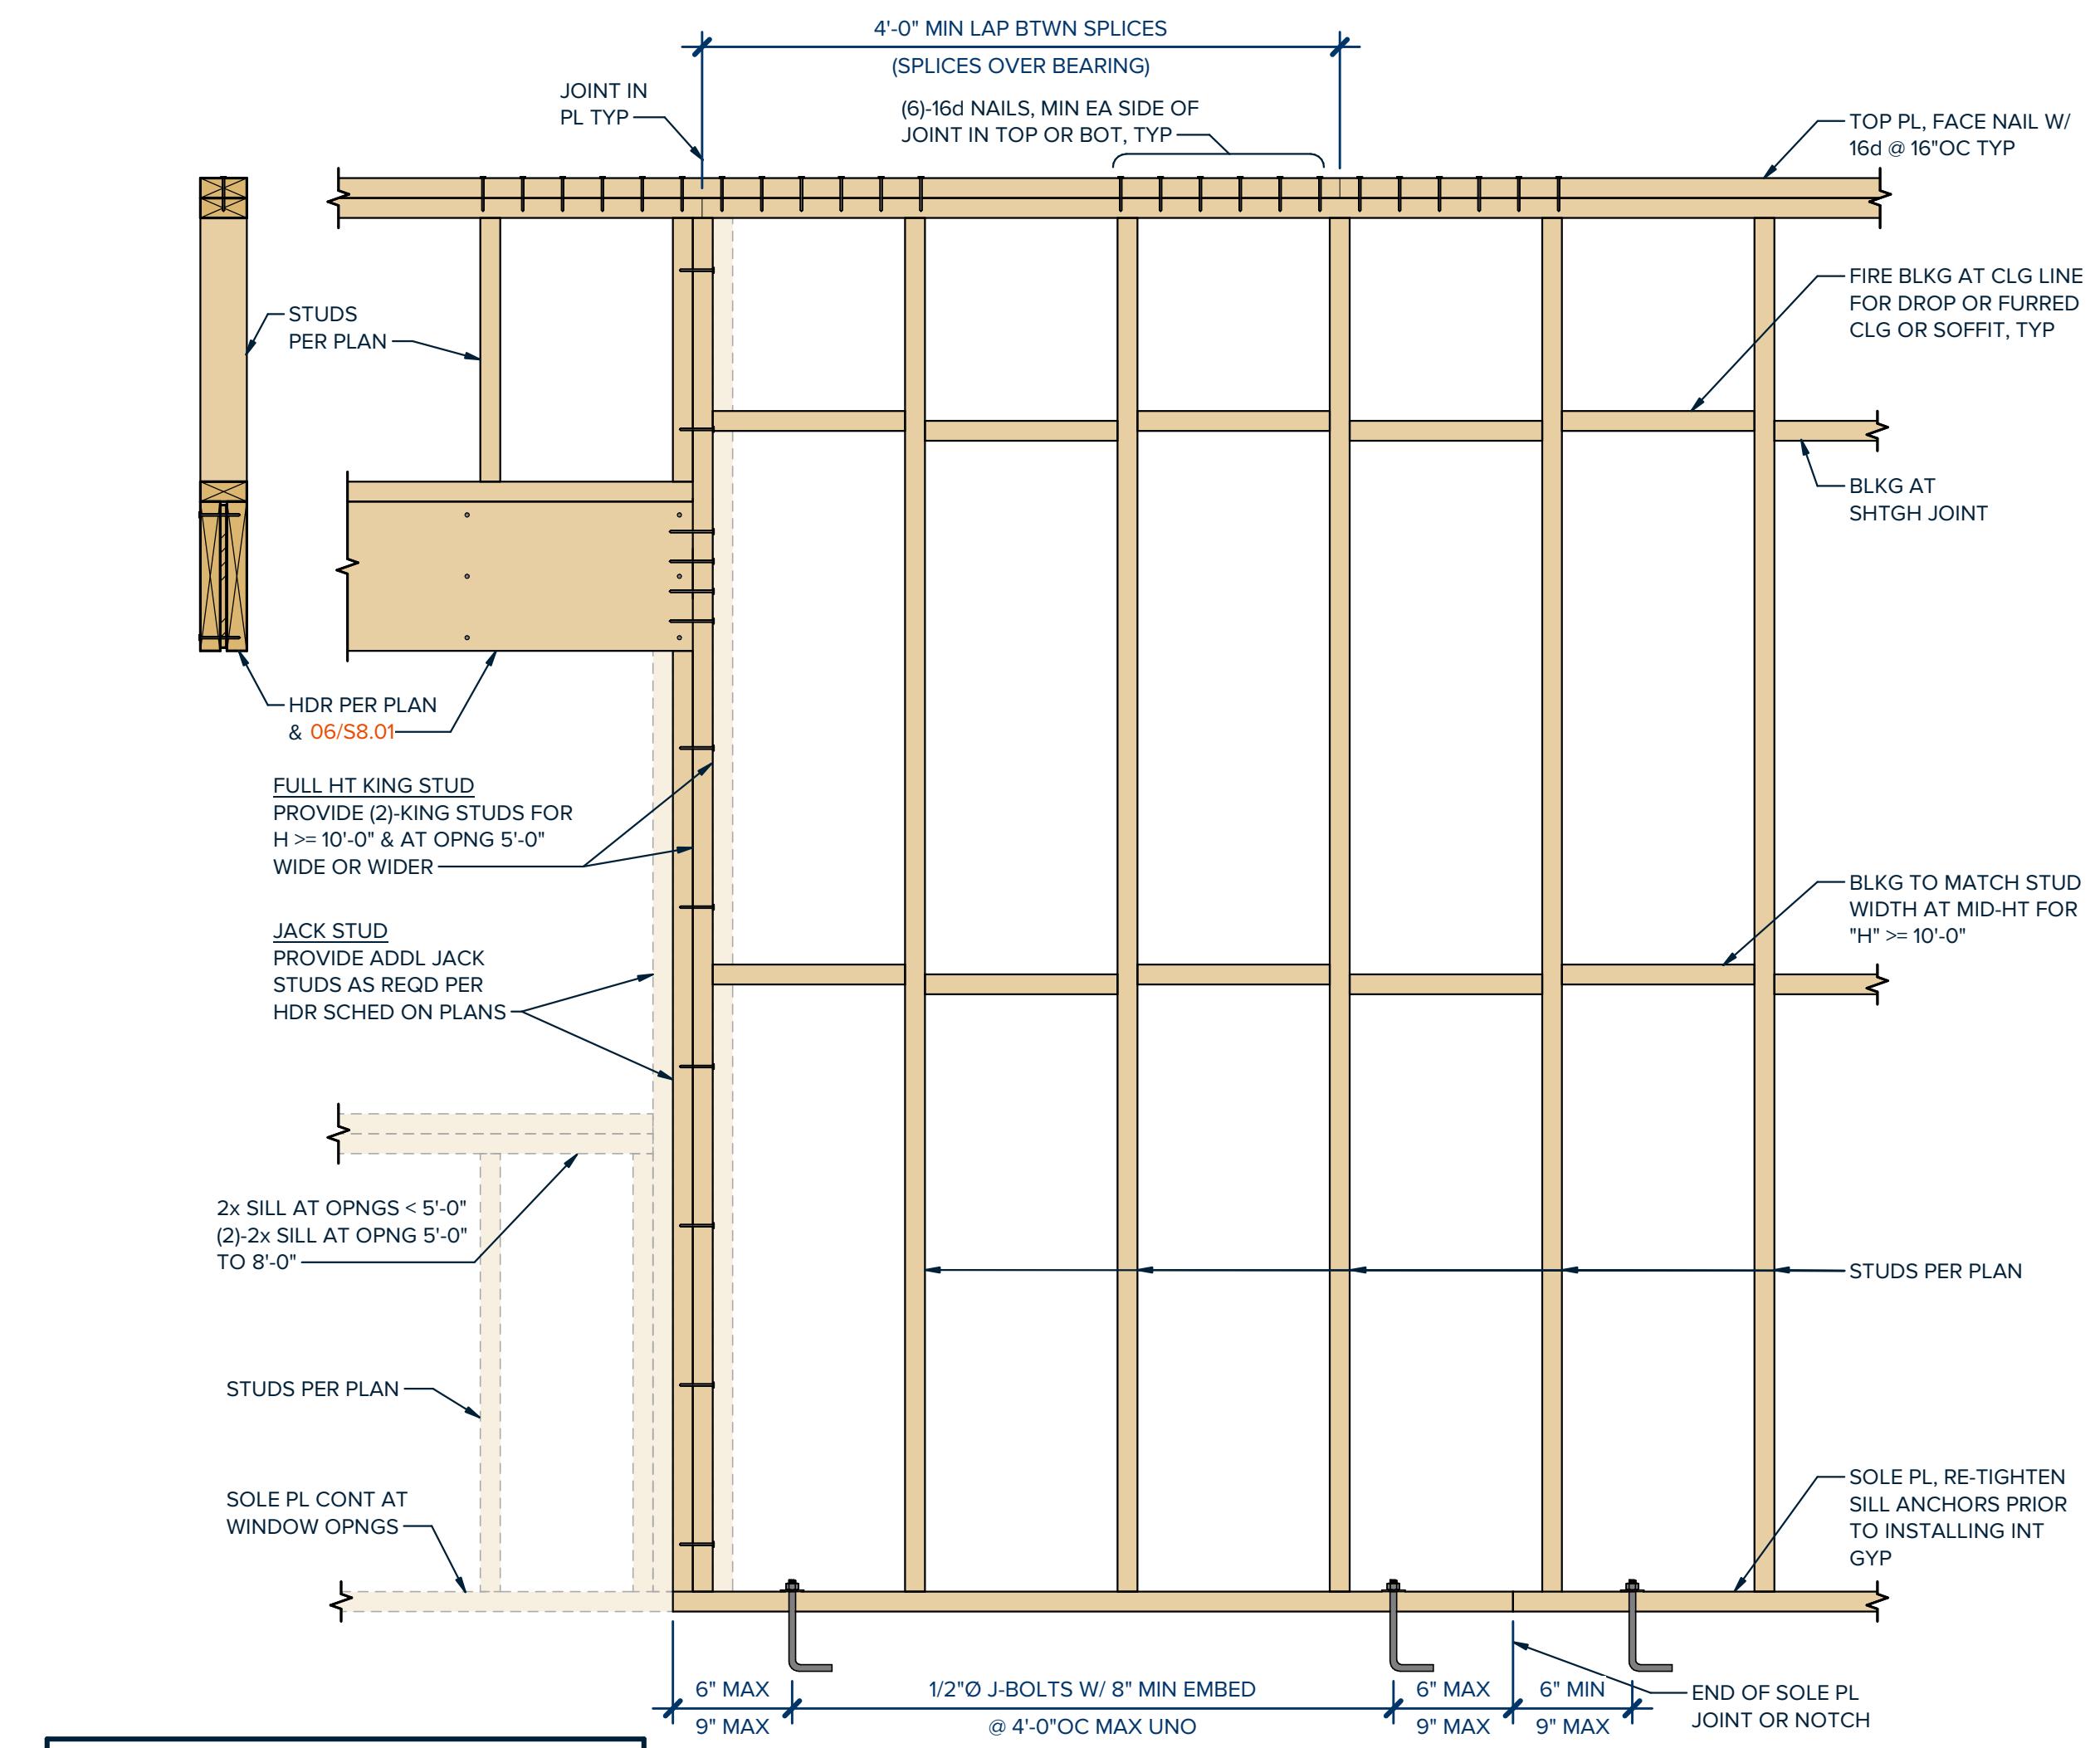

| STUD PACK SCHEDULE AT HEADERS |            |               |               |
|-------------------------------|------------|---------------|---------------|
| NUMBER OF STUDS               | KING STUDS | BEARING STUDS | OPENING WIDTH |
| (2)-2x                        | 1          | 1             | -             |
| (3)-2x                        | 1          | 2             | -             |
| (4)-2x                        | 2          | 2             | -             |
| (5)-2x                        | 2          | 3             | -             |


NOTES:  
1. SOLE PLATES FOR INTERIOR WALLS MAY BE ANCHORED BY USE OF 0.145"Ø POWDER-ACTUATED FASTENERS AT 32" ON CENTER MAXIMUM WITH 1 1/2" MINIMUM PENETRATION AT CONTRACTOR'S OPTION.  
2. OPTIONAL ANCHORS SHALL NOT BE USED IN CURBS, ADJACENT TO DEPRESSED SLABS, IN EXTERIOR WALLS, OR IN SHEAR WALLS.  
3. EACH SOLE PLATE PIECE SHALL HAVE (2)-BOLTS MINIMUM. HOLD-DOWN ANCHORS ARE NOT TO BE CONSIDERED AN ANCHOR BOLT.  
4. DO NOT DRILL OVERSIZE HOLES THRU SILL PLATE.  
5. CONTACT ENGINEER-OF-RECORD FOR POST-INSTALLED ANCHOR OPTIONS.

## 01 TYPICAL FASTENER SCHEDULE FOR WOOD STRUCTURAL MEMBERS

SCALE: NTS


| LUMBER HANGER SCHEDULE |                   |                          |                   |
|------------------------|-------------------|--------------------------|-------------------|
| MEMBER SIZE            | FACE MOUNT HANGER | MEMBER SIZE              | FACE MOUNT HANGER |
| 2x8                    | LUS 28            | 1 3/4" x 11 1/4" LVL     | LUS 210           |
| (2)-2x8                | LUS 28-2          | (2)-1 3/4" x 11 1/4" LVL | HU 412            |
| (3)-2x8                | LUS 28-3          | (3)-1 3/4" x 11 1/4" LVL | HU 612            |
| 2x10                   | LUS 210           | (2)-1 3/4" x 14" LVL     | HGUS 4110         |
| (2)-2x10               | LUS 210-2         | (3)-1 3/4" x 14" LVL     | HHUS 5.5/10       |
| (3)-2x10               | HU 210-3          | (2)-1 3/4" x 16" LVL     | HGUS 412          |
| 2x12                   | LUS 212           | (3)-1 3/4" x 16" LVL     | HHUS 5.5/10       |
| (2)-2x12               | HUS 212-2         | (2)-1 3/4" x 18" LVL     | HGUS 412          |
| (3)-2x12               | HU 212-3          | (3)-1 3/4" x 18" LVL     | HGUS 5.5/14       |

NOTES:  
1. HANGERS LISTED ABOVE ARE MANUFACTURED BY SIMPSON STRONG-TIE.  
2. INSTALL HANGERS ACCORDING TO MANUFACTURER'S GUIDELINES.  
3. USE HANGERS AS SCHEDULED ABOVE UNLESS OTHERWISE NOTED ON PLANS OR DETAILS.

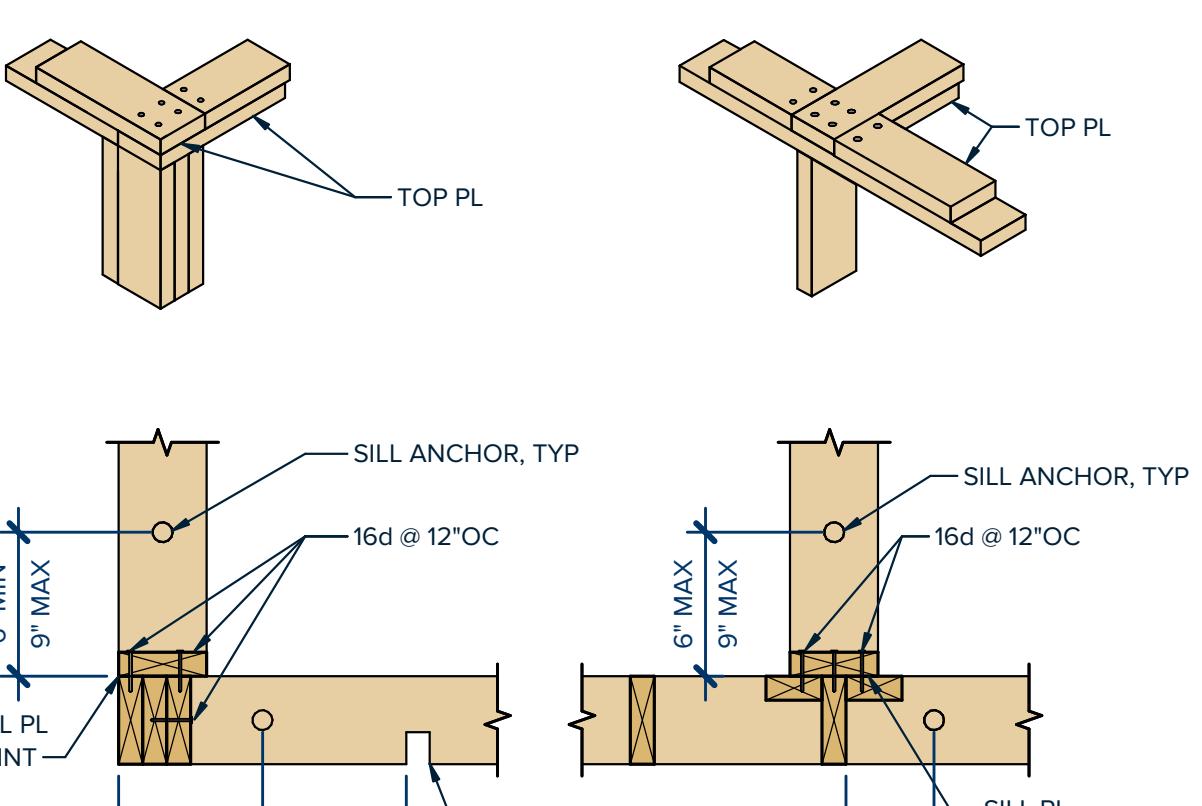

## 03 TYPICAL HANGER SCHEDULE FOR WOOD STRUCTURAL MEMBERS

SCALE: NTS

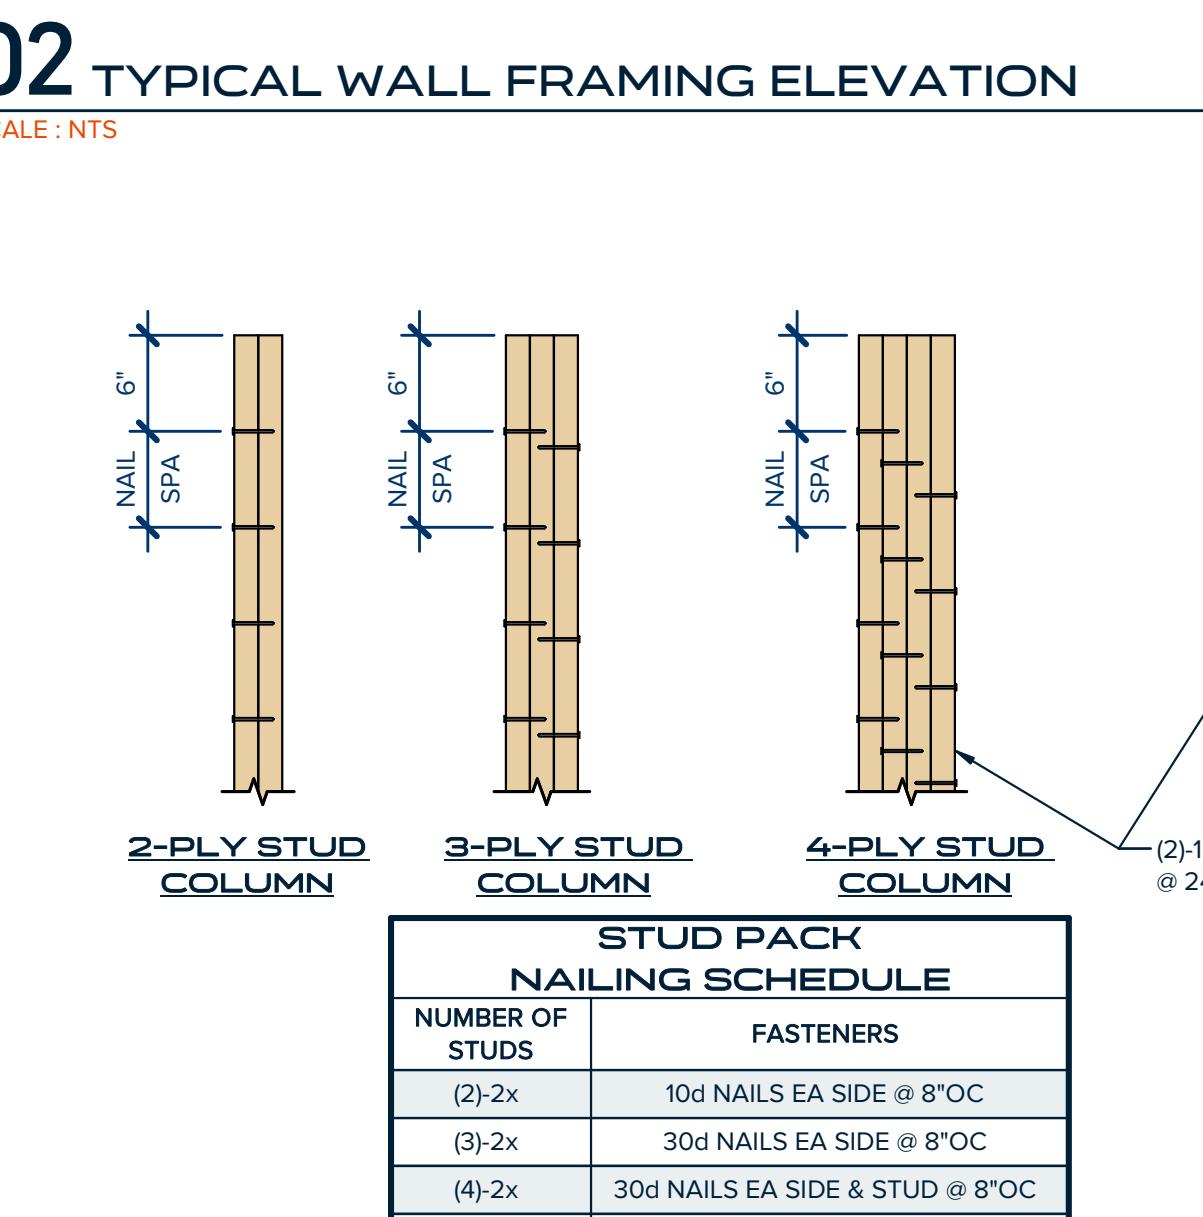


| STUD PACK NAILING SCHEDULE |                                 |
|----------------------------|---------------------------------|
| NUMBER OF STUDS            | FASTENERS                       |
| (2)-2x                     | 10d NAILS EA SIDE @ 8"OC        |
| (3)-2x                     | 30d NAILS EA SIDE @ 8"OC        |
| (4)-2x                     | 30d NAILS EA SIDE & STUD @ 8"OC |
| (5)-2x                     | 3/8"Ø THRU BOLTS @ 8"OC         |

NOTES:  
1. CONNECT CENTER TWO STUDS FIRST.

## 04 TYPICAL CORNERS & INTERSECTIONS AT 2X WOOD STUD WALLS

SCALE: NTS

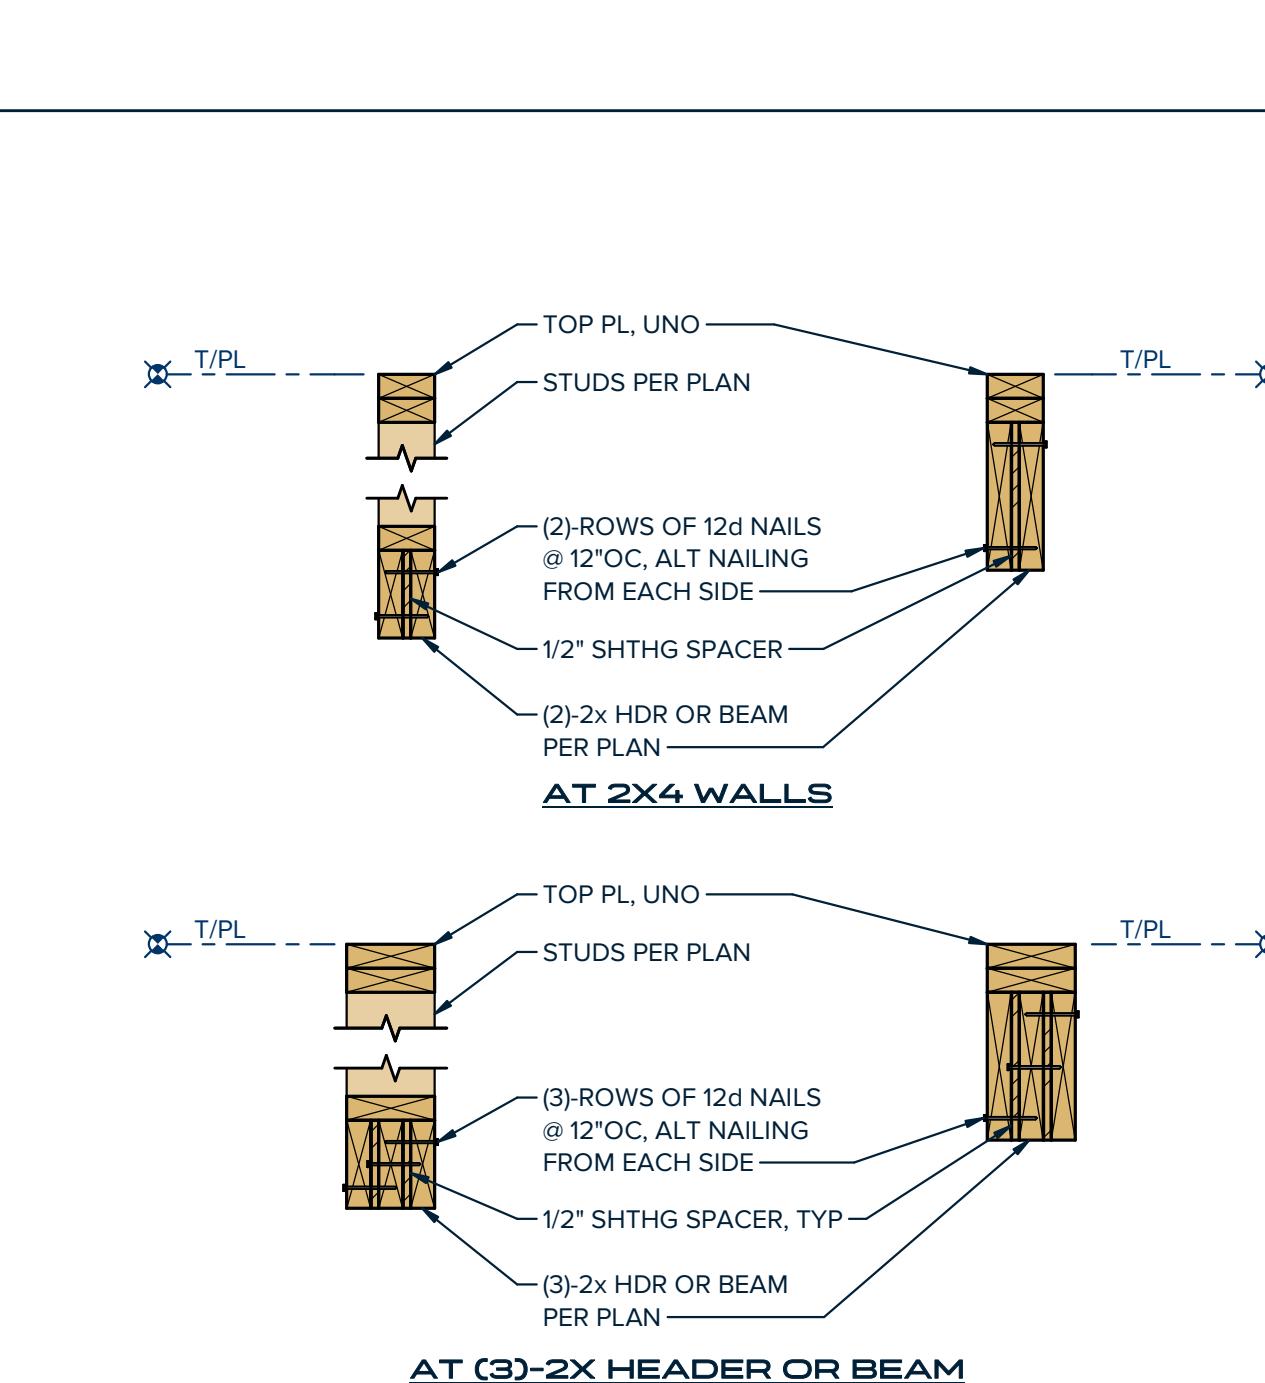

SCALE

| NO                 | ISSUE | DATE |
|--------------------|-------|------|
| PM: S. Young       |       |      |
| ENG: S. Young      |       |      |
| BIM PM: C Lawrence |       |      |
| QA/QC: S Covey     |       |      |


If printed on 22x34 or 24x36 sheet,  
the scale is as indicated.  
If printed on an 11x17 or 12x18  
sheet, the scale is reduced by half.

SHEET TITLE

SHEET NUMBER

## 05 TYPICAL BUILT-UP WOOD STUD COLUMNS

</div

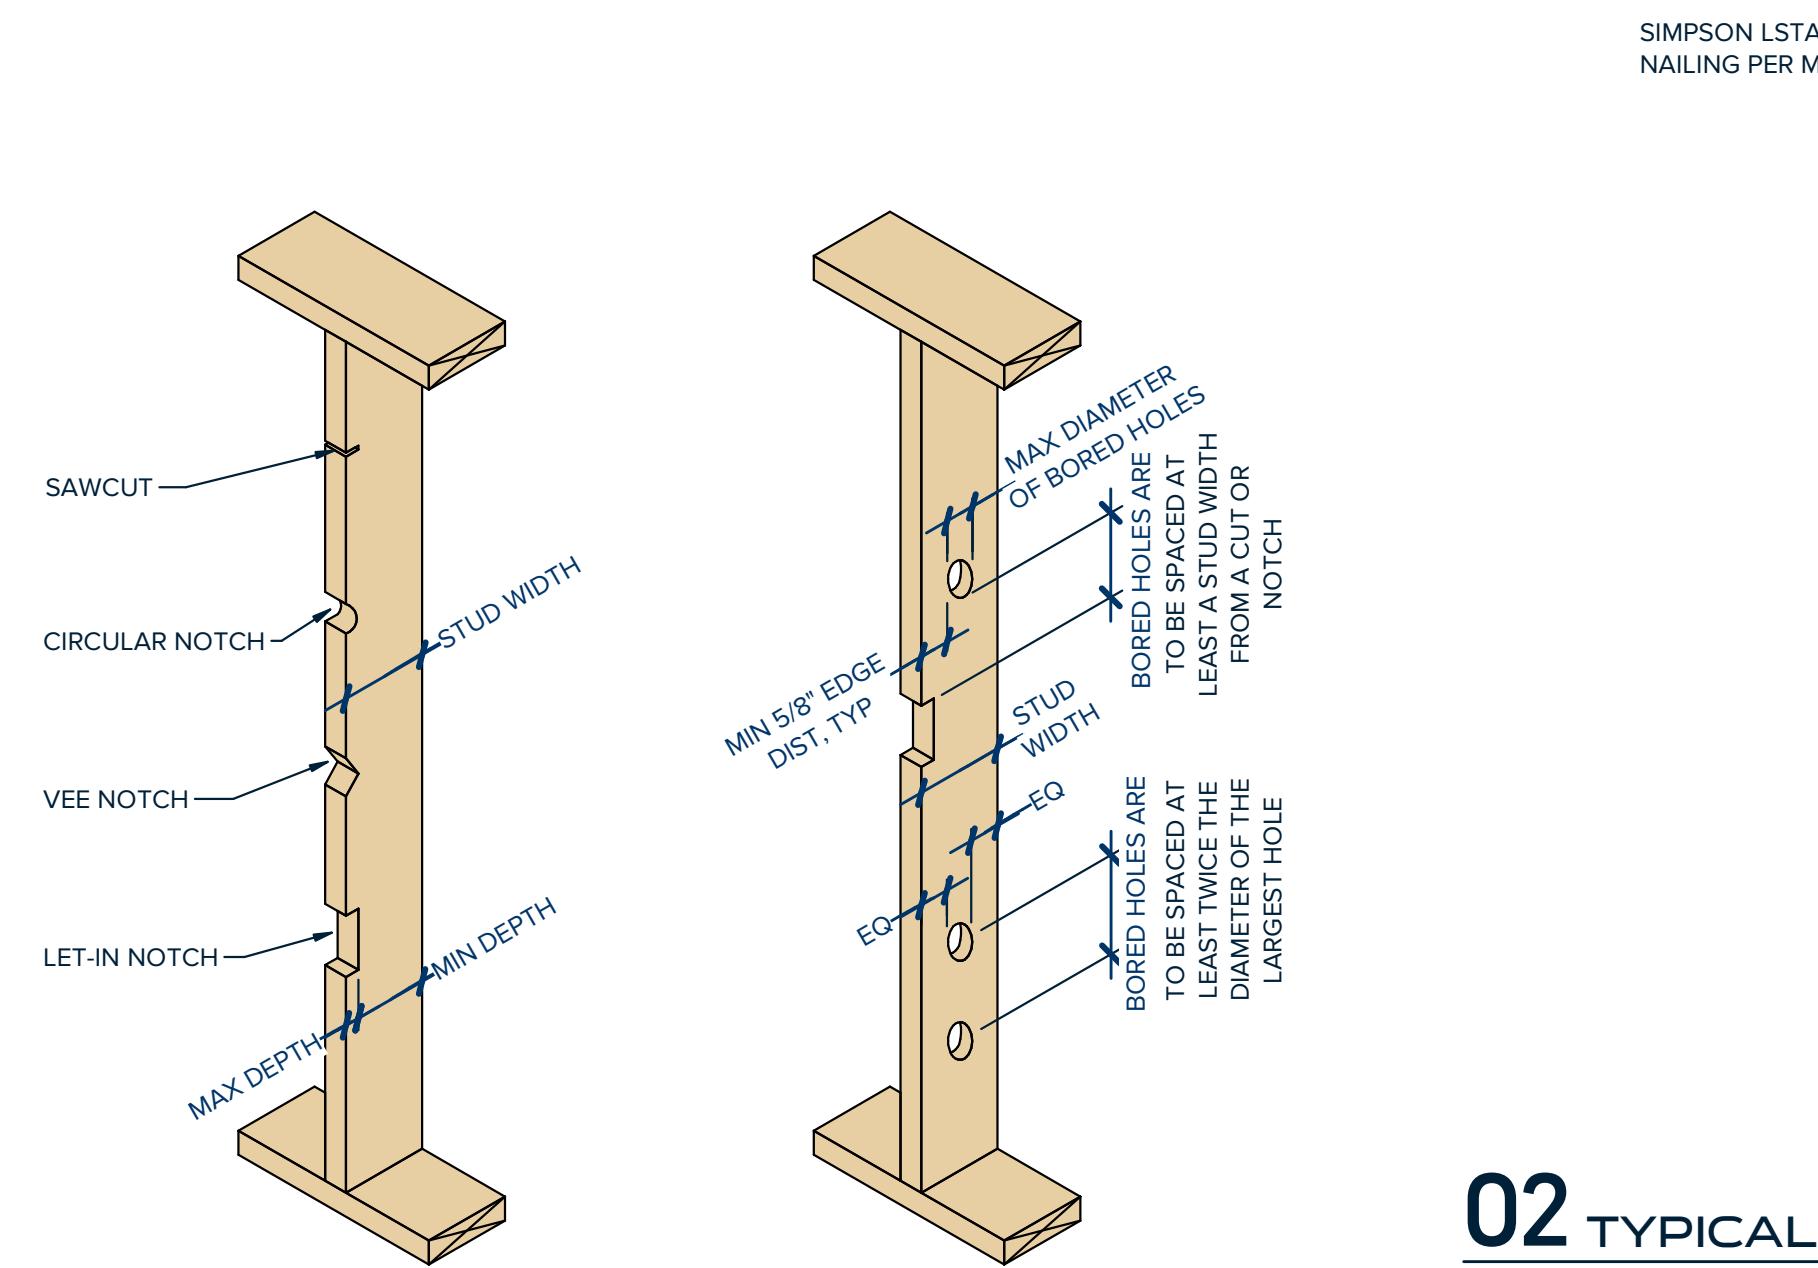

**CUTTING AND NOTCHING WOOD STUDS**  
**BORED HOLES IN WOOD STUDS**

| BEARING WALL STUDS |                                |                                        |
|--------------------|--------------------------------|----------------------------------------|
| STUD SIZE          | MAX DEPTH OF EDGE CUT OR NOTCH | MIN DEPTH REMAINING AFTER CUT OR NOTCH |
| 2x4                | 7/8"                           | 2 5/8"                                 |
| 2x6                | 1 3/8"                         | 4 1/8"                                 |

| BEARING WALL STUDS |                            |                                      |
|--------------------|----------------------------|--------------------------------------|
| STUD SIZE          | MAX DIAMETER OF BORED HOLE | MIN DEPTH REMAINING AFTER BORED HOLE |
| 2x4                | 1 3/8"                     | 5/8" EA SIDE OF HOLE                 |
| 2x6                | 2 3/16"                    | 5/8" EA SIDE OF HOLE                 |

NOTES:  
1. STUDS MAY NOT BE BORED IN EXCESS OF 40% OF THE STUD, IF STUDS ARE DOUBLED, BORINGS MAY BE INCREASED TO 60% OF STUD WIDTH PROVIDED NOT MORE THAN (2)-SUCCESSIVE STUDS ARE BORED. BORINGS SHALL NOT BE MADE AT THE SAME SECTION WHERE CUT OR NOTCH HAS BEEN MADE.

| NON-BEARING WALL STUDS |                                |                                        |
|------------------------|--------------------------------|----------------------------------------|
| STUD SIZE              | MAX DEPTH OF EDGE CUT OR NOTCH | MIN DEPTH REMAINING AFTER CUT OR NOTCH |
| 2x4                    | 1 3/8"                         | 2 1/8"                                 |
| 2x6                    | 2 3/16"                        | 3 3/8"                                 |

NOTES:  
1. DO NOT NOTCH MORE THAN THREE ADJACENT STUDS WITHOUT REVIEW BY ENGINEER.


NOTES:  
1. BORED HOLE NOT PERMITTED IN MORE THAN THREE ADJACENT STUDS WITHOUT REVIEW BY ENGINEER.  
2. STUDS MAY NOT BE BORED IN EXCESS OF 60% OF THE STUD. BORINGS SHALL NOT BE MADE AT THE SAME SECTION WHERE CUT OR NOTCH HAS BEEN MADE.

## 01 TYPICAL HOLES & NOTCHES IN WOOD STUDS

SCALE: NTS

## 05 ALLOWABLE TYPICAL MODIFICATIONS TO WOOD JOISTS


SCALE: NTS

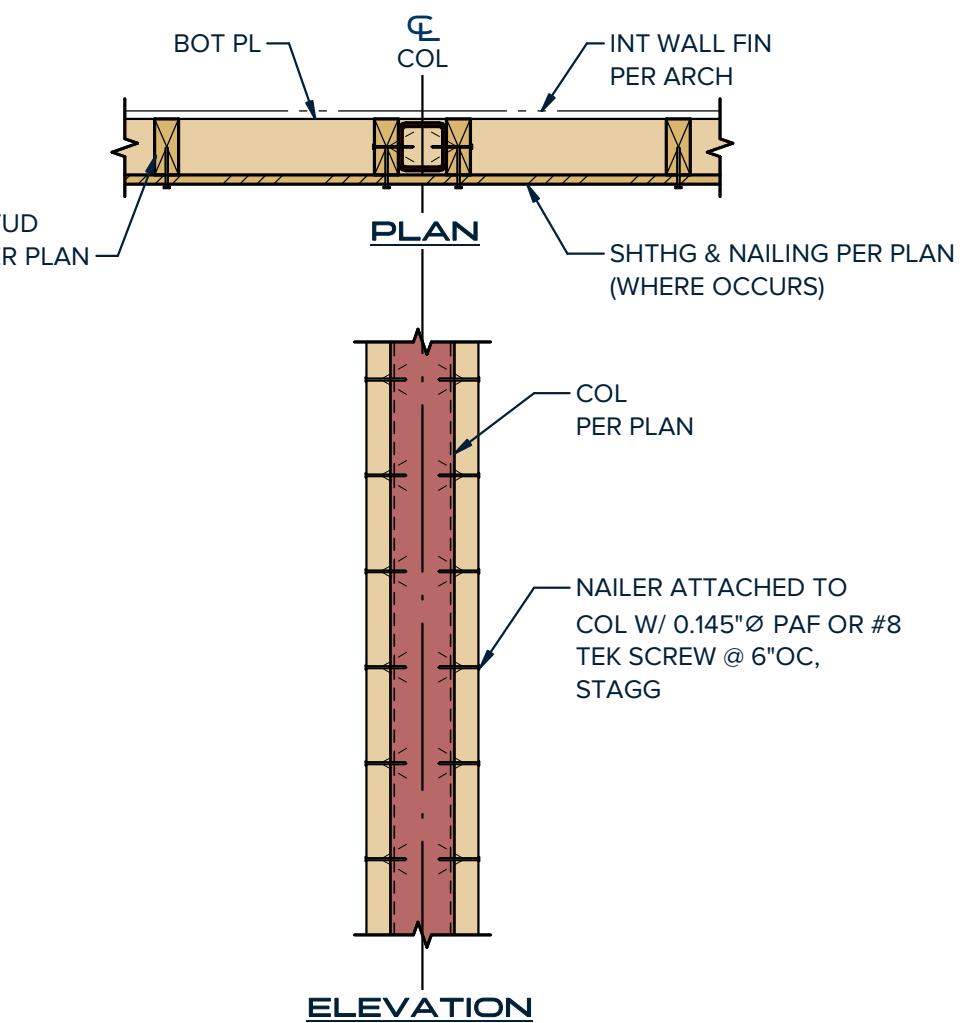

## 08 TYPICAL NAILER ATTACHMENT TO STEEL COLUMN


SCALE: NTS

| SIDE-LOADED MULTIPLE MEMBER CONNECTION SCHEDULE |                                        |                                              |                                             |
|-------------------------------------------------|----------------------------------------|----------------------------------------------|---------------------------------------------|
| ASSEMBLY TYPE                                   | NAILED CONNECTION                      | THROUGH BOLTED CONNECTION                    | STRUCTURAL WOOD SCREW CONNECTION            |
| ASSEMBLY "A"                                    | (3)-ROWS 12d COMMON WIRE NAILS @ 12"OC | (2)-ROWS 1/4"Ø A325 BOLTS W/ WASHERS @ 12"OC | (2)-ROWS 1/4"Ø x 3 1/2" LONG SCREWS @ 12"OC |
| ASSEMBLY "B"                                    | N/A                                    | (2)-ROWS 1/4"Ø A325 BOLTS W/ WASHERS @ 12"OC | N/A                                         |

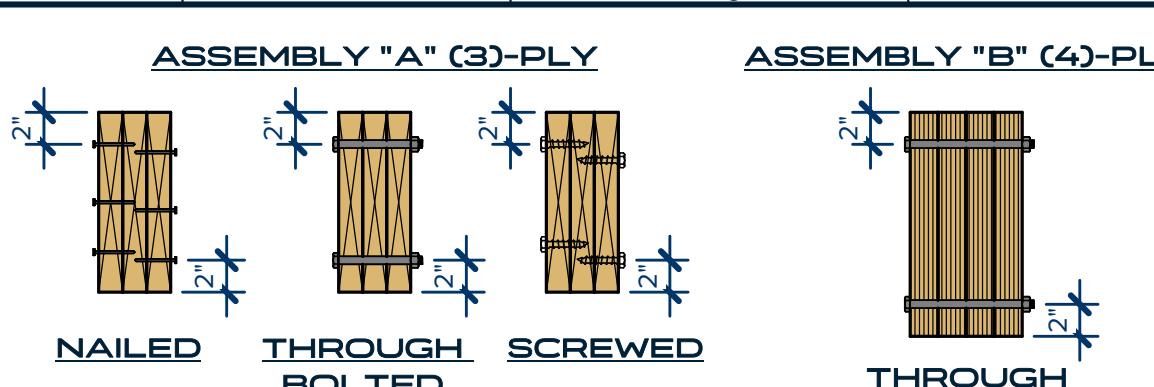


## 09 SIDE-LOADED MULTIPLE MEMBER CONNECTION SCHEDULE

SCALE: NTS

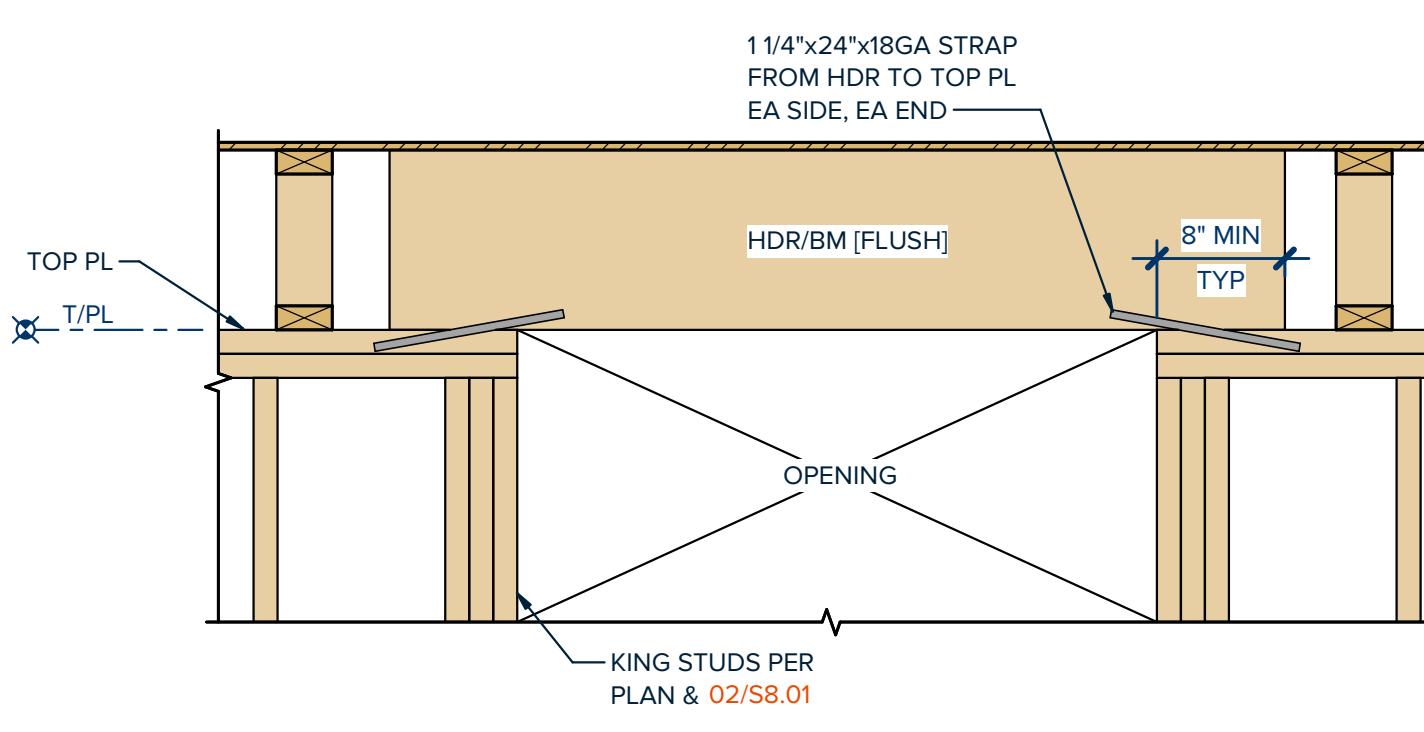



## 03 FLUSH HEADER DETAIL

SCALE: NTS

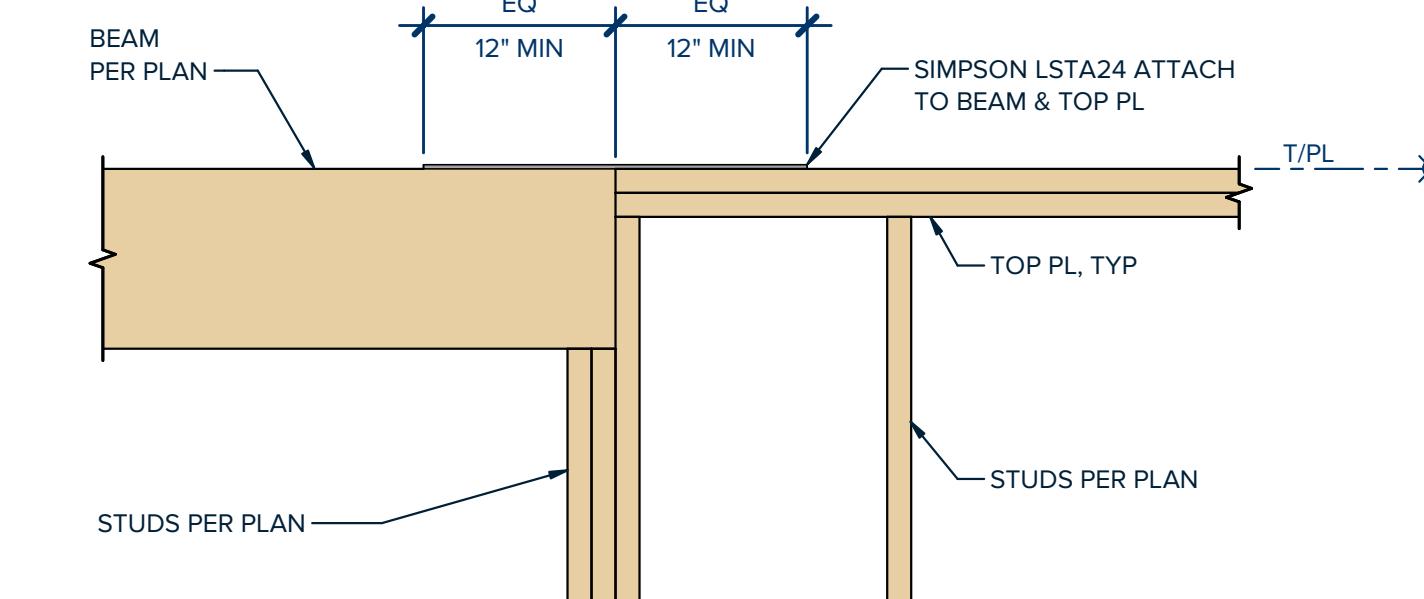

## 04 TYPICAL BEAM TO TOP PLATE SPLICE

SCALE: NTS

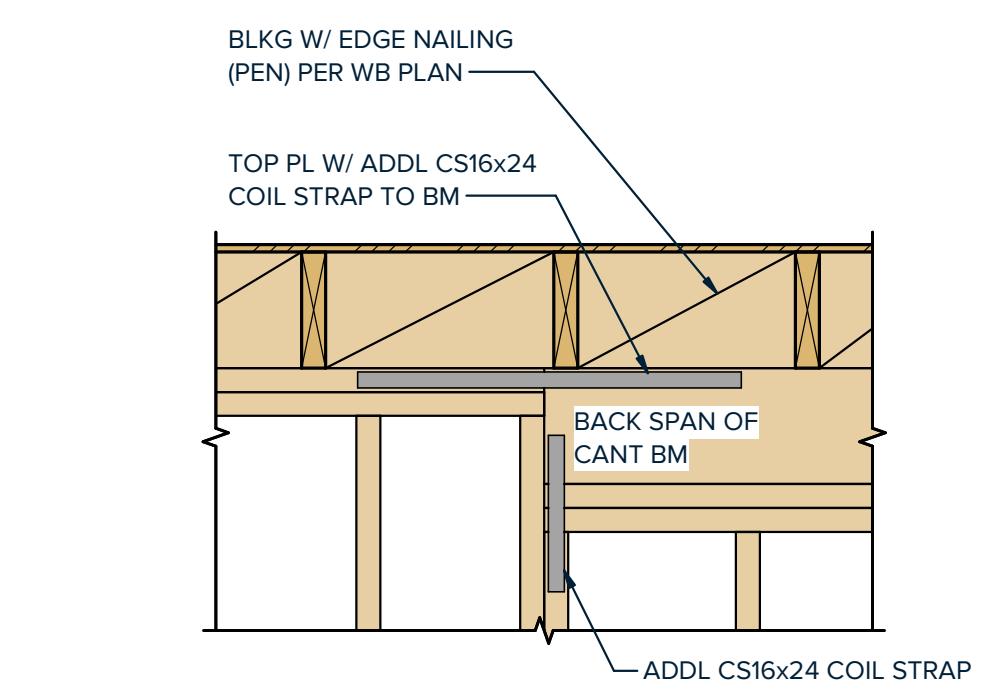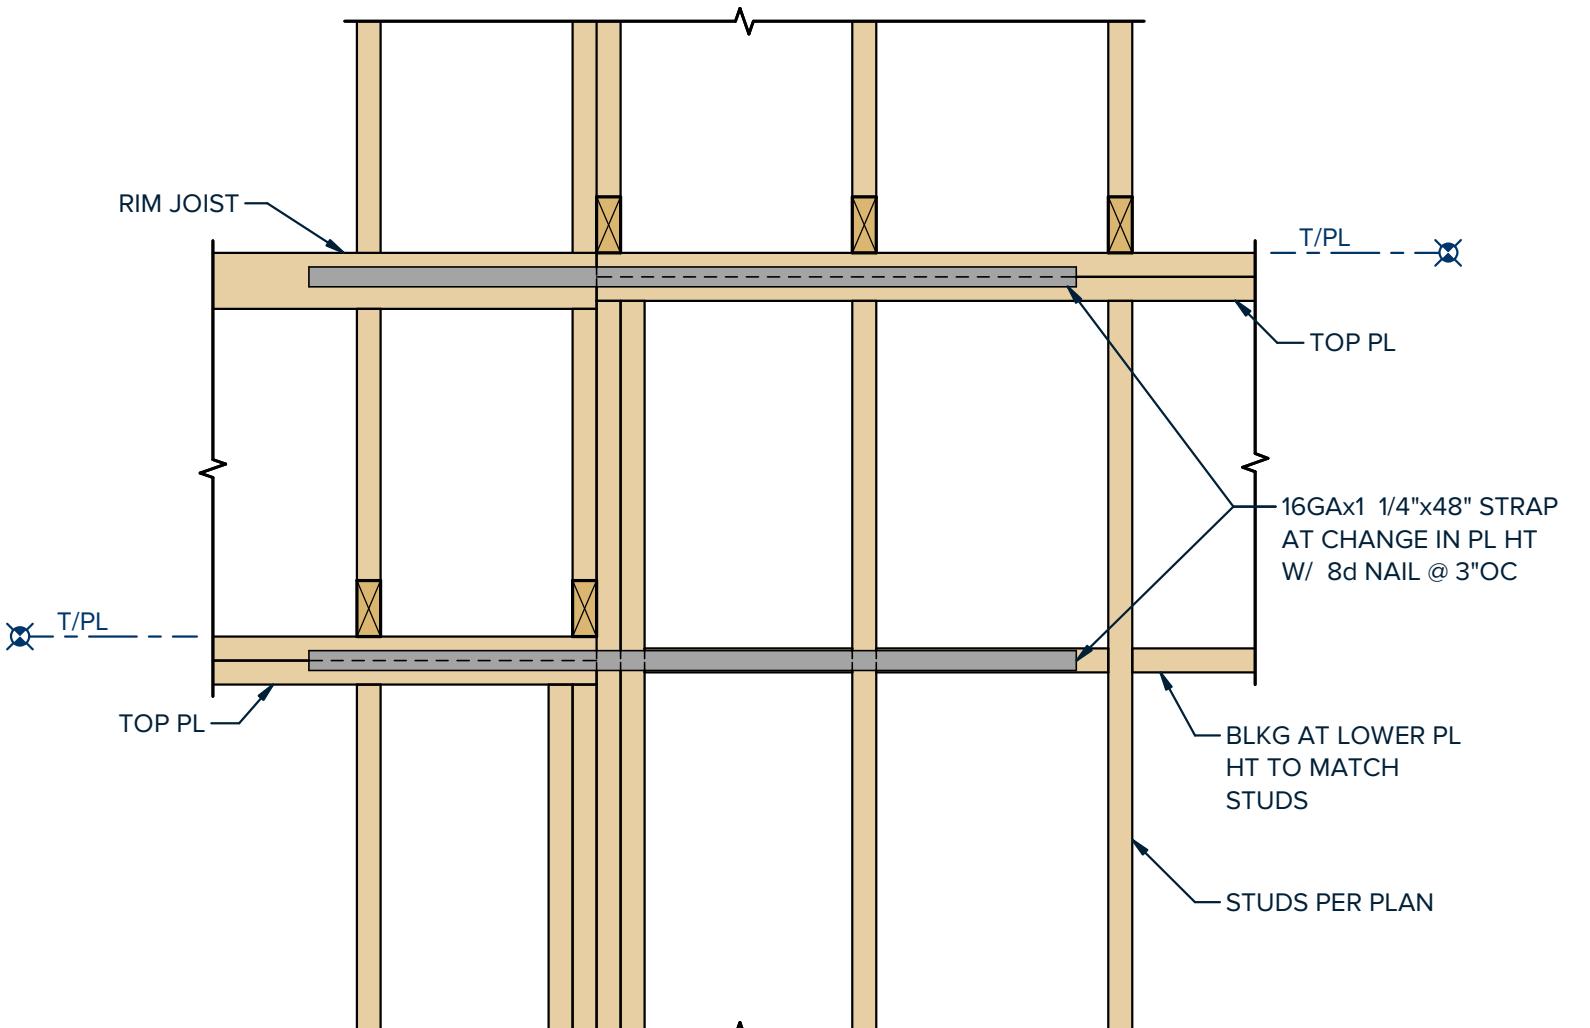

## 07 FRAMING DETAIL AT CANTILEVER BACK SPAN

SCALE: NTS

| NO                 | ISSUE | DATE |
|--------------------|-------|------|
| PM: S. Young       |       |      |
| ENG: S. Young      |       |      |
| BIM PM: C Lawrence |       |      |
| QA/QC: S Covey     |       |      |

If printed on 22x34 or 24x36 sheet, the scale is as indicated.  
If printed on an 11x17 or 12x18 sheet, the scale is reduced by half. SCALE


## TYPICAL WOOD DETAILS

SHEET TITLE

PERMIT DOCUMENTS


**S8.02**

SHEET NUMBER

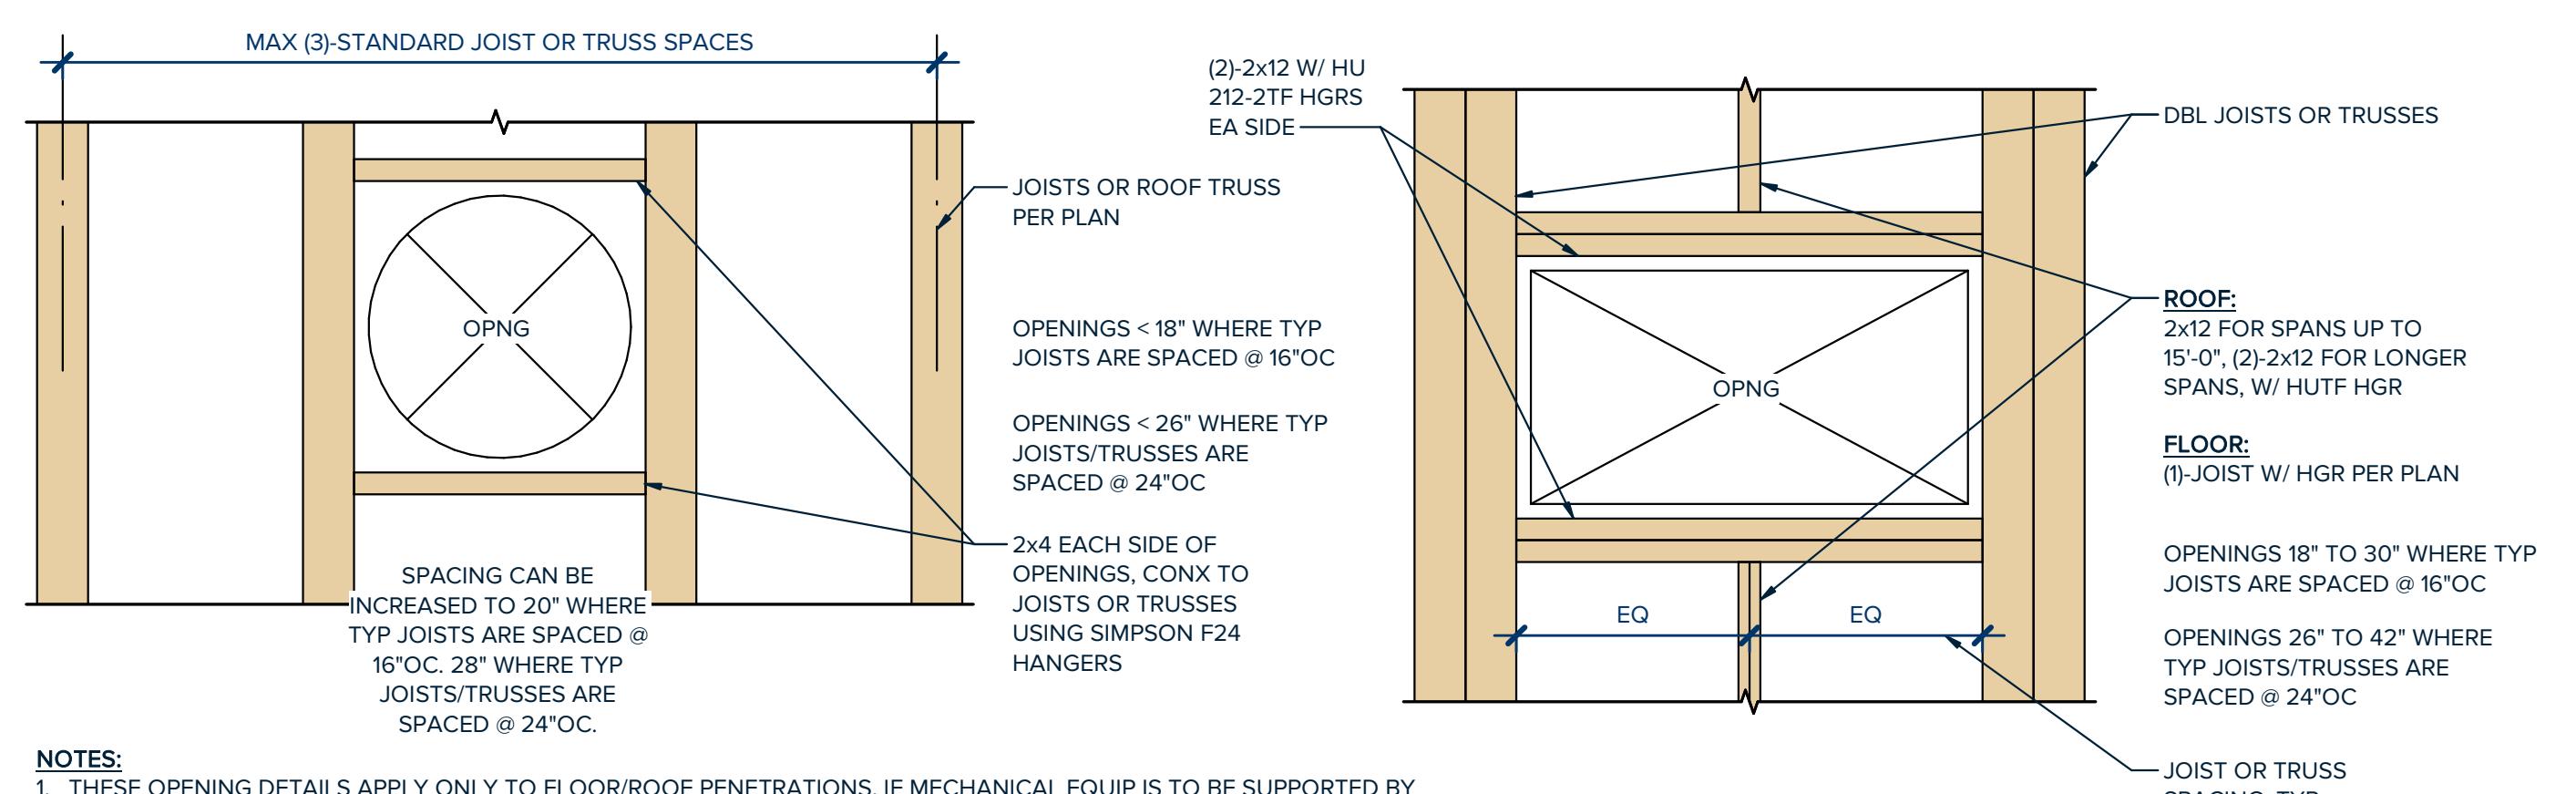


**01** TYPICAL FRAMING AT FLOOR/ROOF OPENINGS

SCALE : NTS

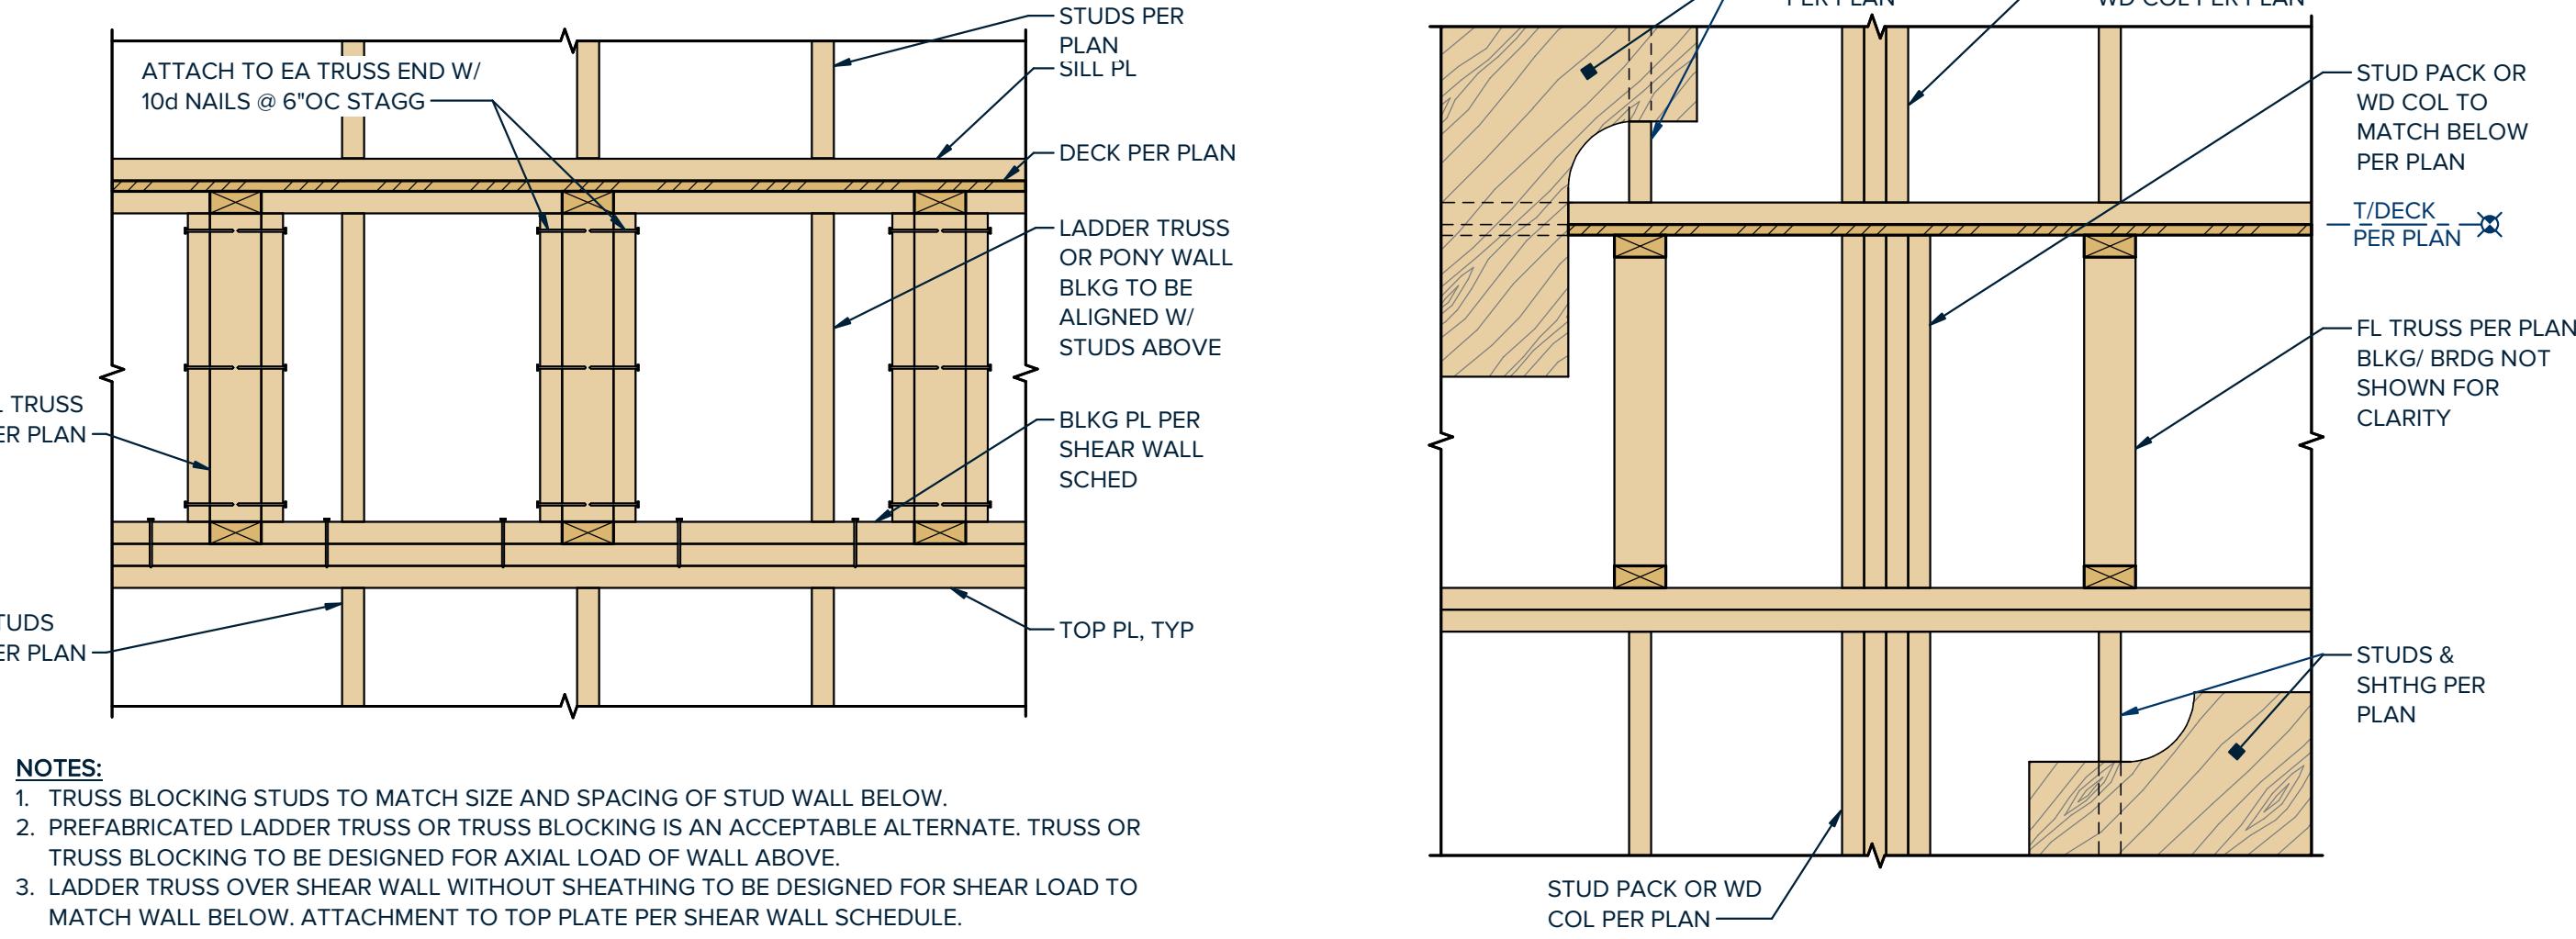


**02** STUD PACK  
CONTINUOUS TO FOUNDATION

SCALE : NTS

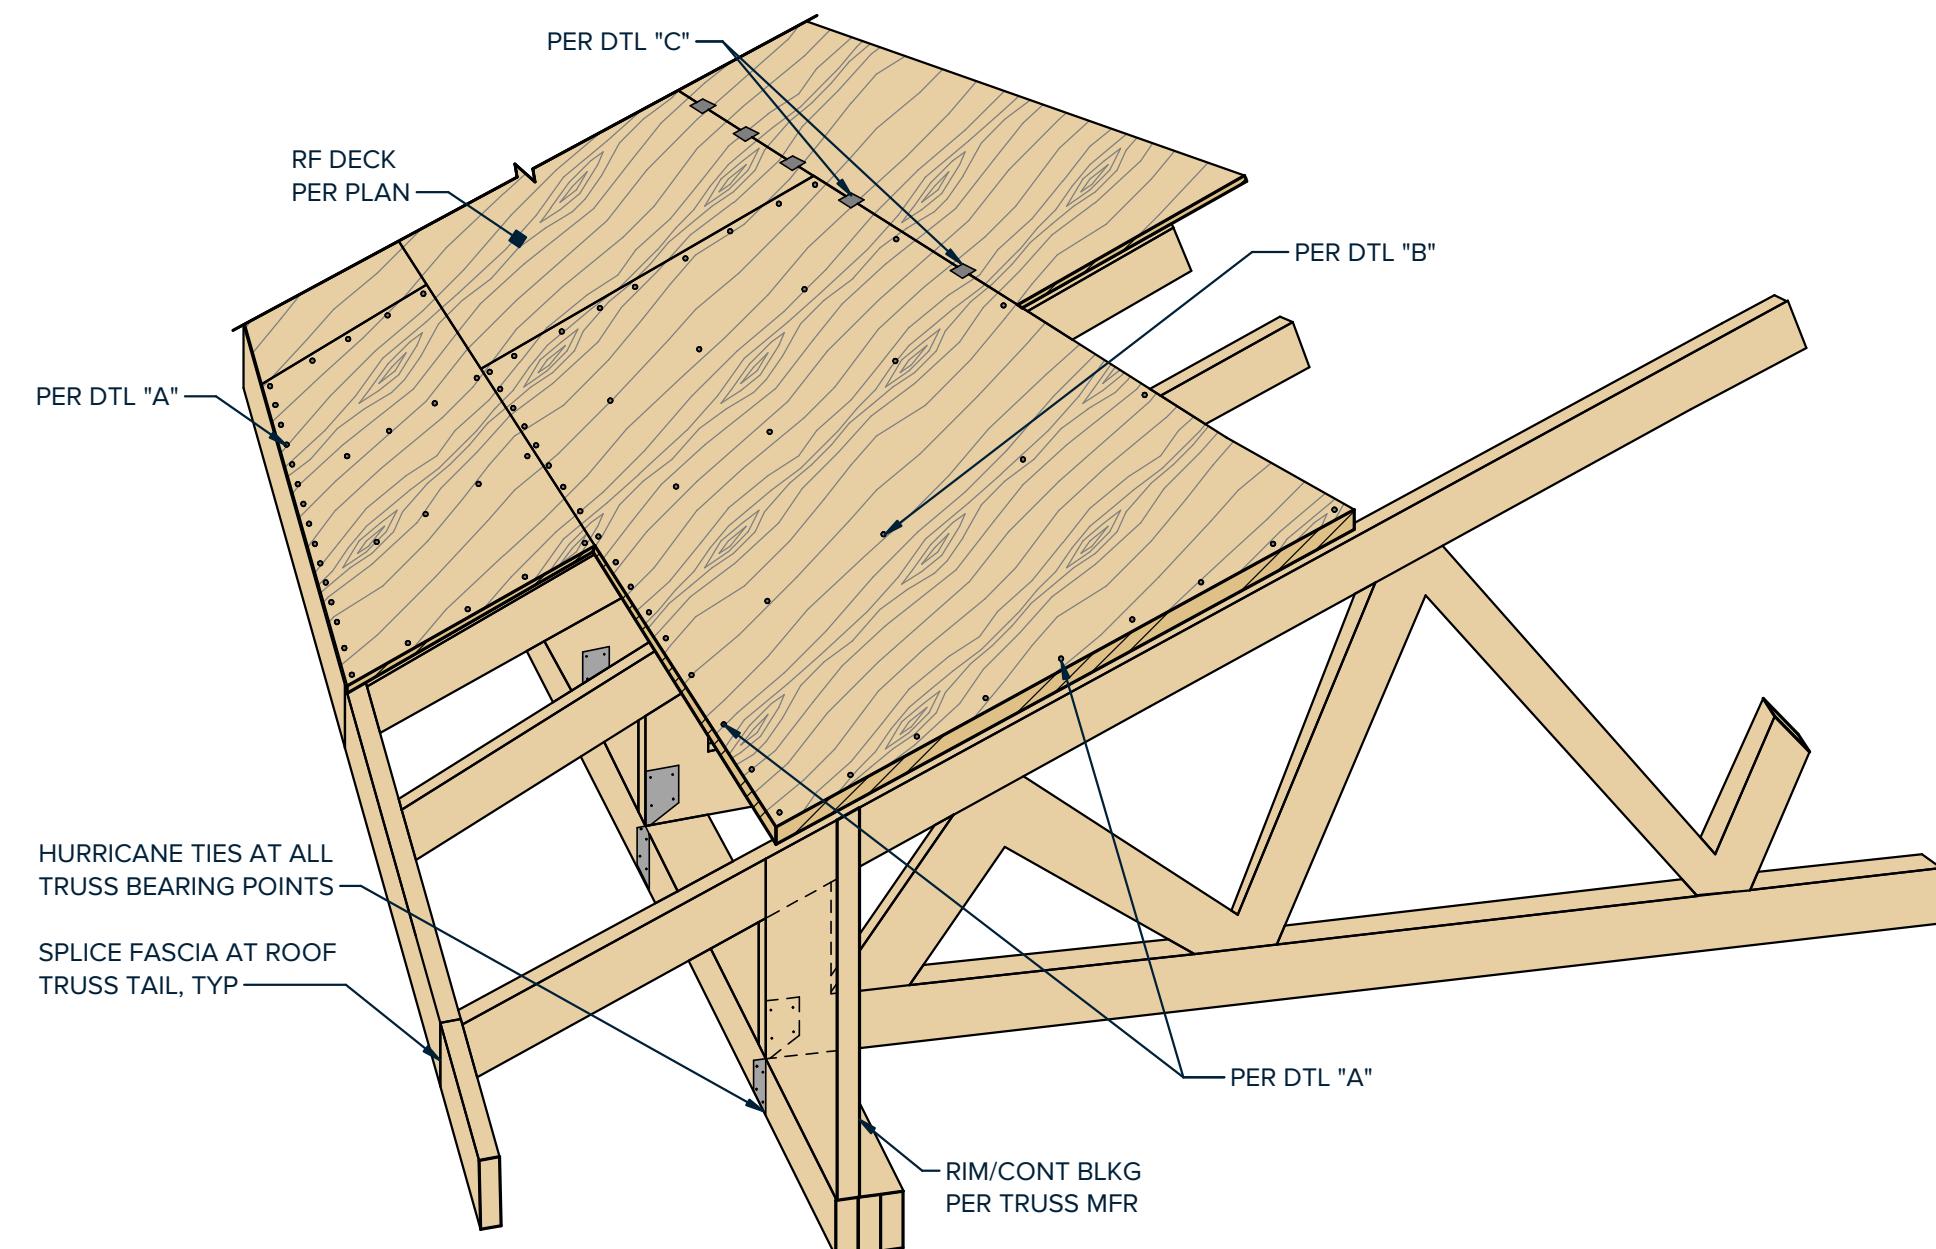


**04** TYPICAL SLOPED ROOF DIAGRAM

SCALE : NTS

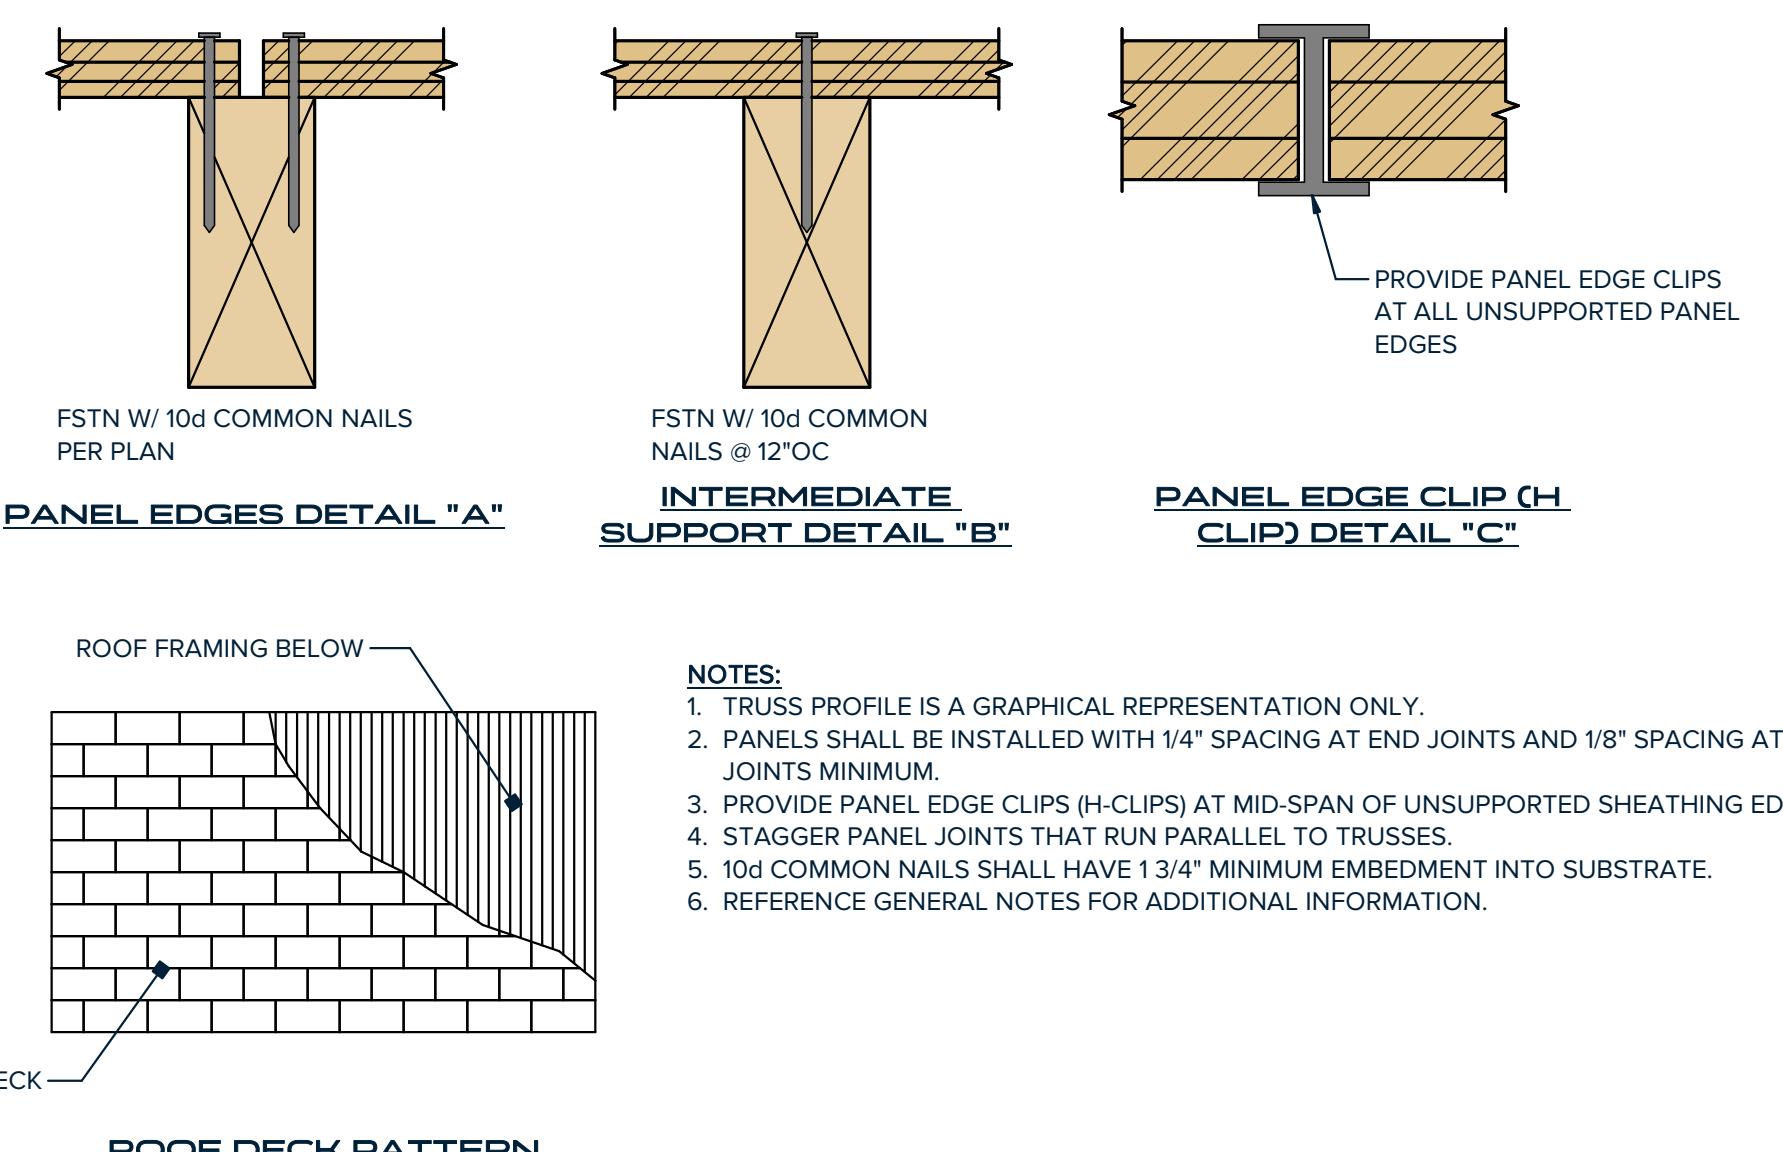


NOTES:  
1. TRUSS PROFILE IS A GRAPHICAL REPRESENTATION ONLY.  
2. PANELS SHALL BE INSTALLED WITH 1/4" SPACING AT END JOINTS AND 1/8" SPACING AT EDGE JOINTS MINIMUM.  
3. PROVIDE PANEL EDGE CLIPS (H-CLIPS) AT MID-SPAN OF UNSUPPORTED SHEATHING EDGES.  
4. STAGGER PANEL JOINTS THAT RUN PARALLEL TO TRUSSES.  
5. 10d COMMON NAILS SHALL HAVE 1 3/4" MINIMUM EMBEDMENT INTO SUBSTRATE.  
6. REFERENCE GENERAL NOTES FOR ADDITIONAL INFORMATION.

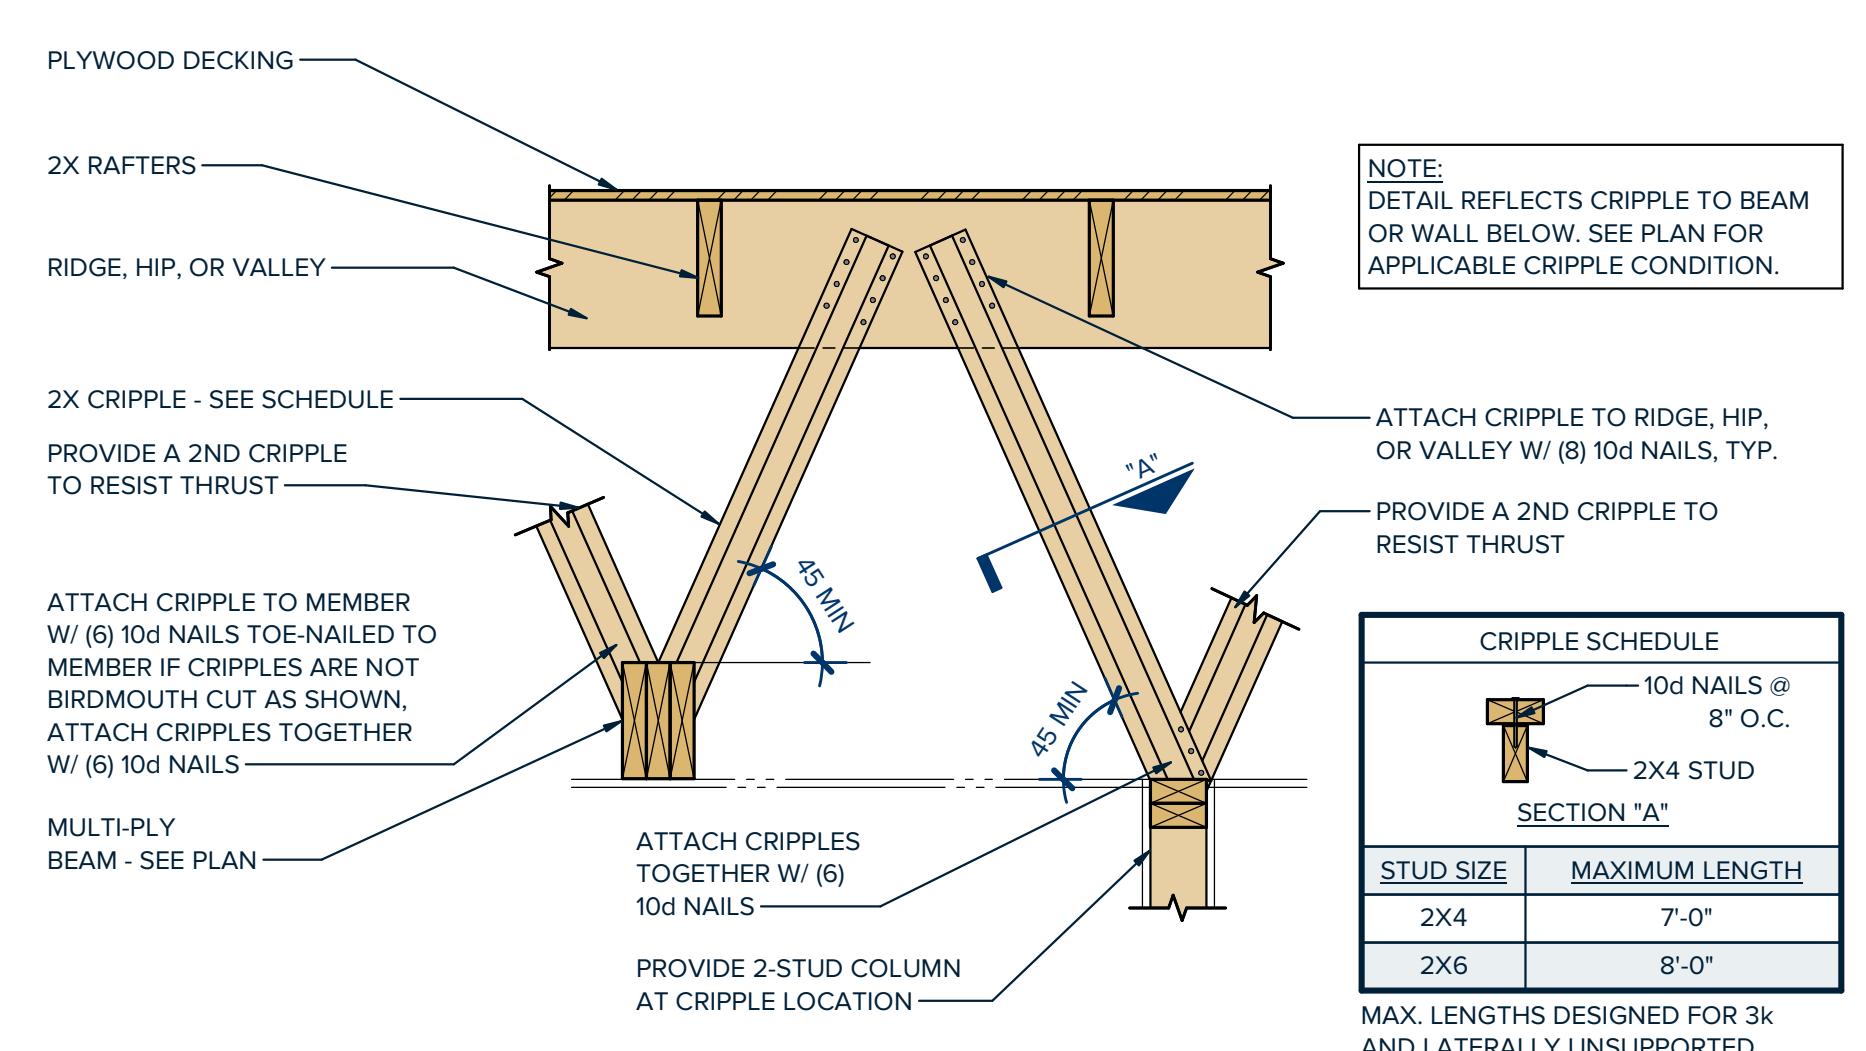

**05** TYPICAL STRONGBACK

SCALE : NTS

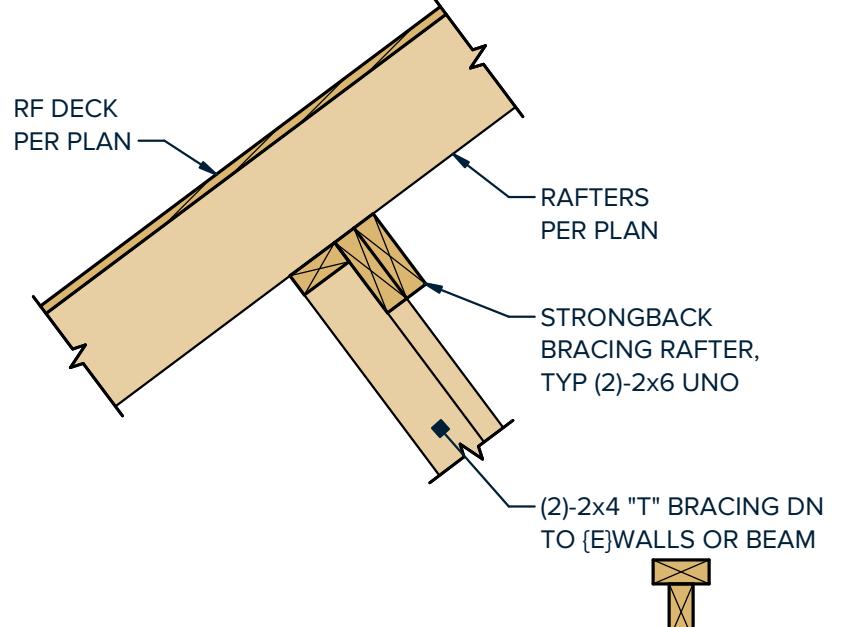

PERMIT DOCUMENTS

| NO                 | ISSUE | DATE |
|--------------------|-------|------|
| PM: S. Young       |       |      |
| ENG: S. Young      |       |      |
| BIM PM: C Lawrence |       |      |
| QA/QC: S Covey     |       |      |


If printed on 22x34 or 24x36 sheet, the scale is as indicated.  
If printed on an 11x17 or 12x18 sheet, the scale is reduced by half. SCALE

TYPICAL WOOD DETAILS

SHEET TITLE

**S8.03**

SHEET NUMBER



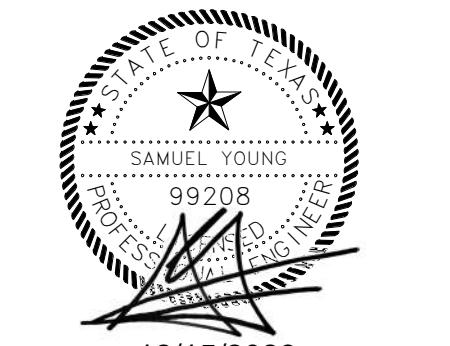


ALTERSTUDIO  
ARCHITECTURE LLP  
1801 Lavaca Street  
Ste 106  
Austin, Texas 78701


KOS RESIDENCE

17363 E Reed Parks Rd  
Jonestown, Texas 78645

PERMIT SET  
12.15.2023

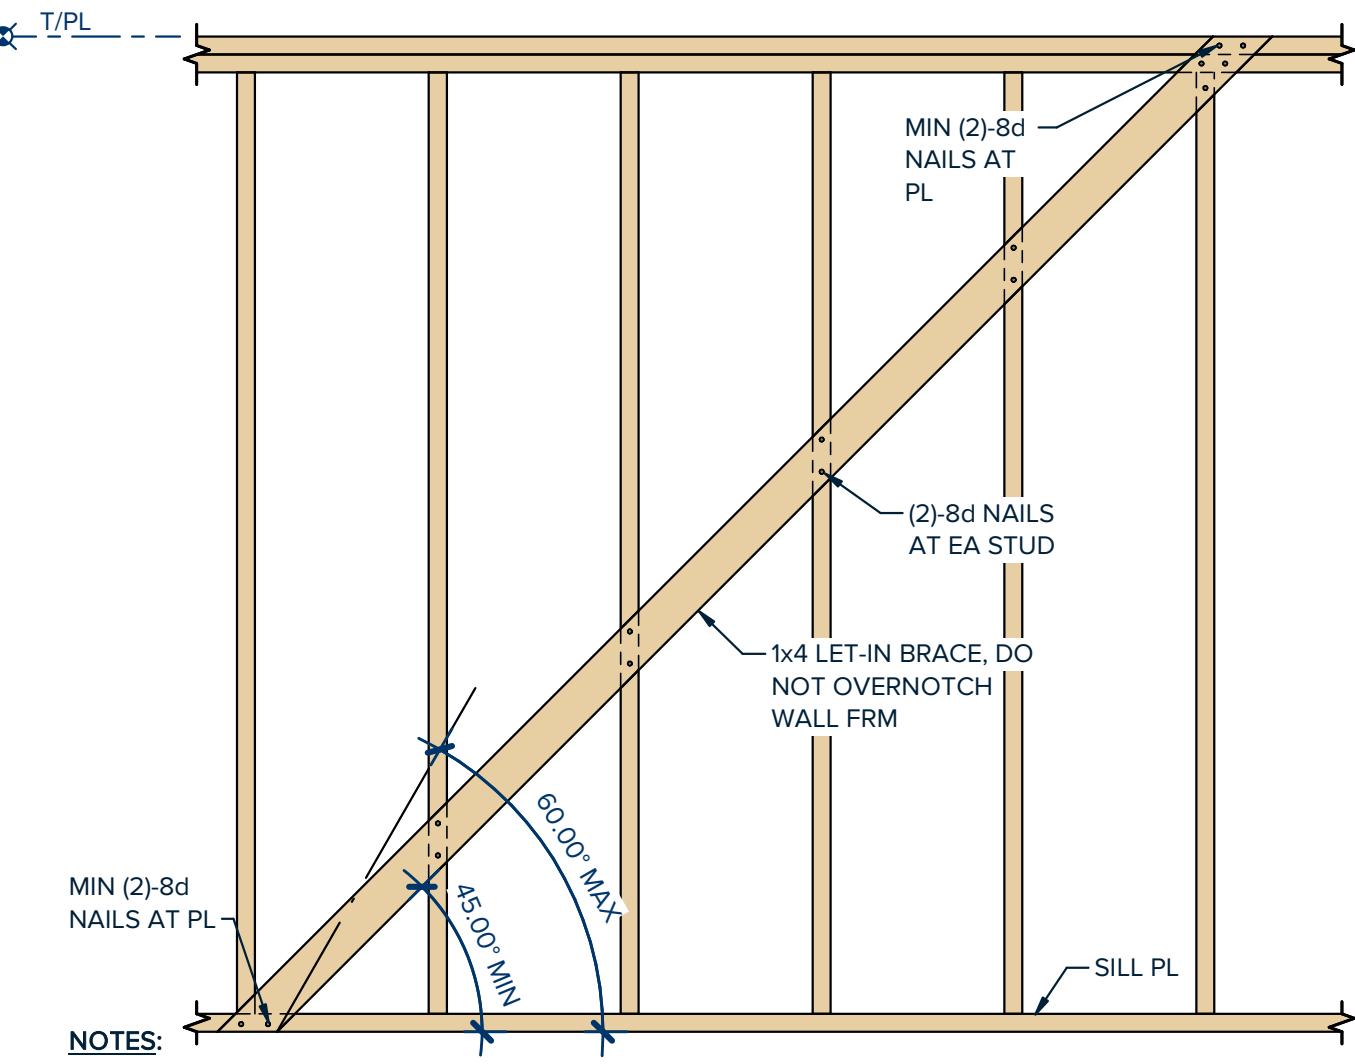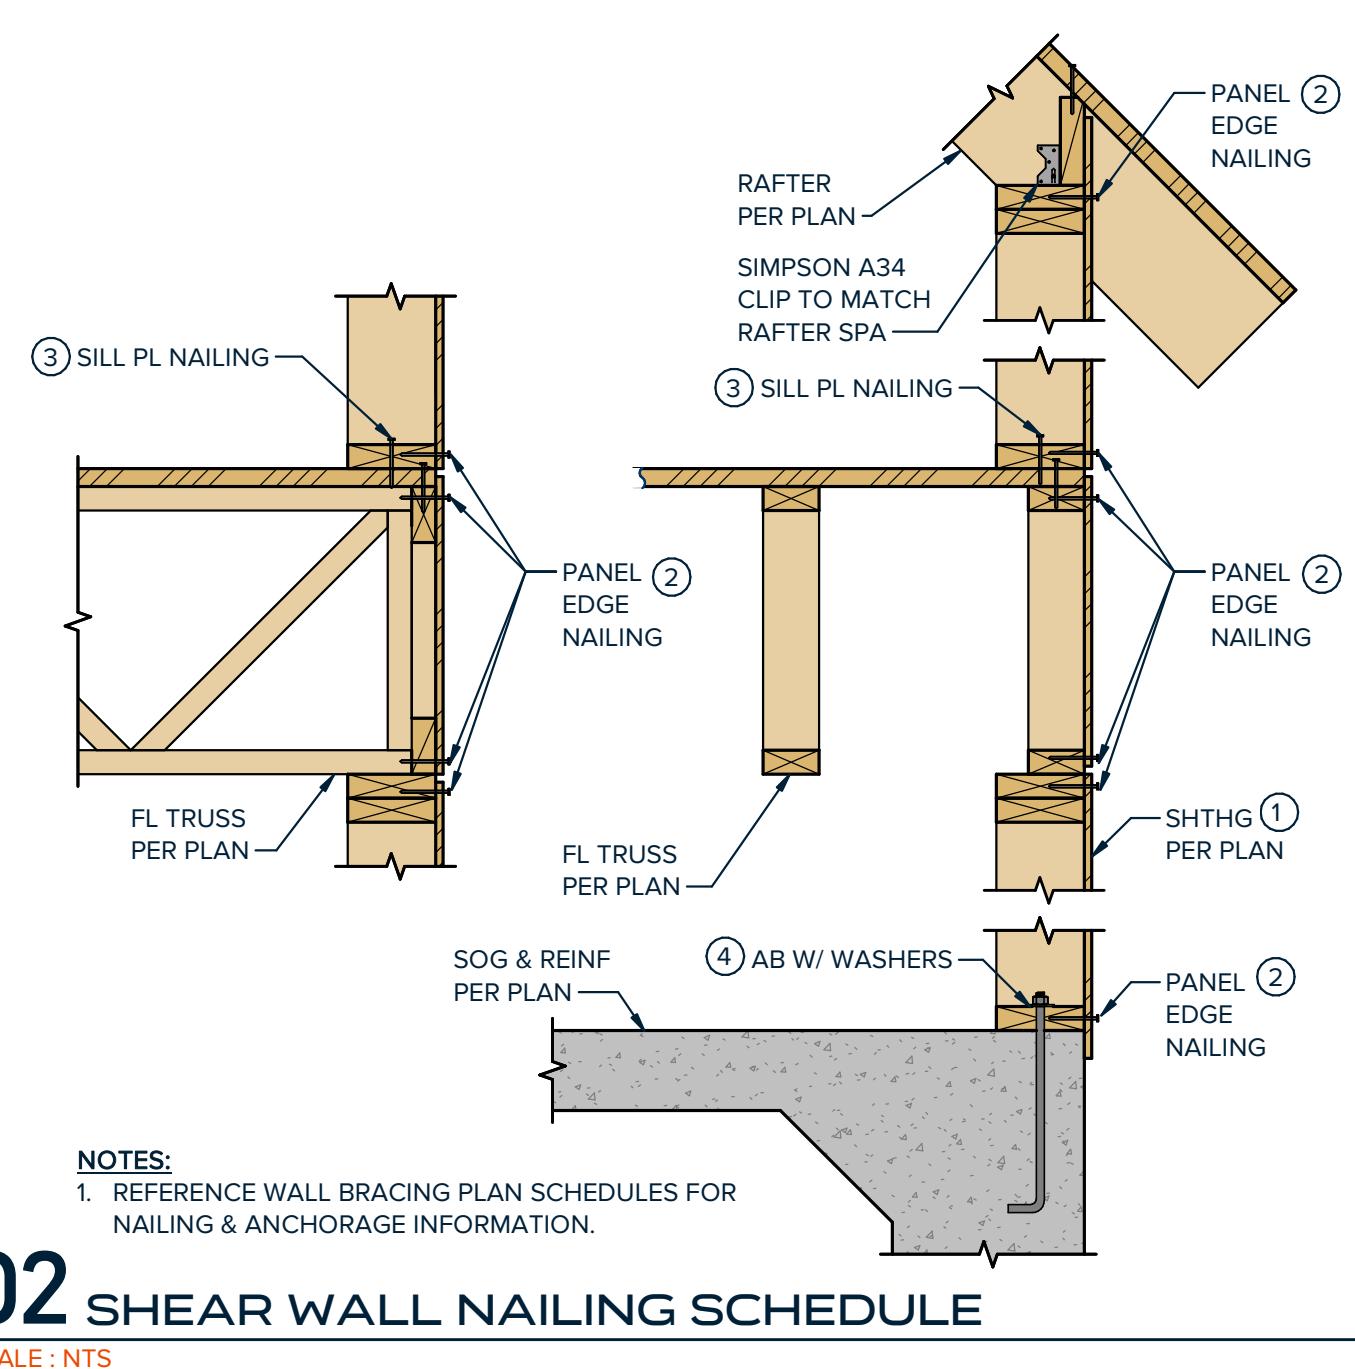
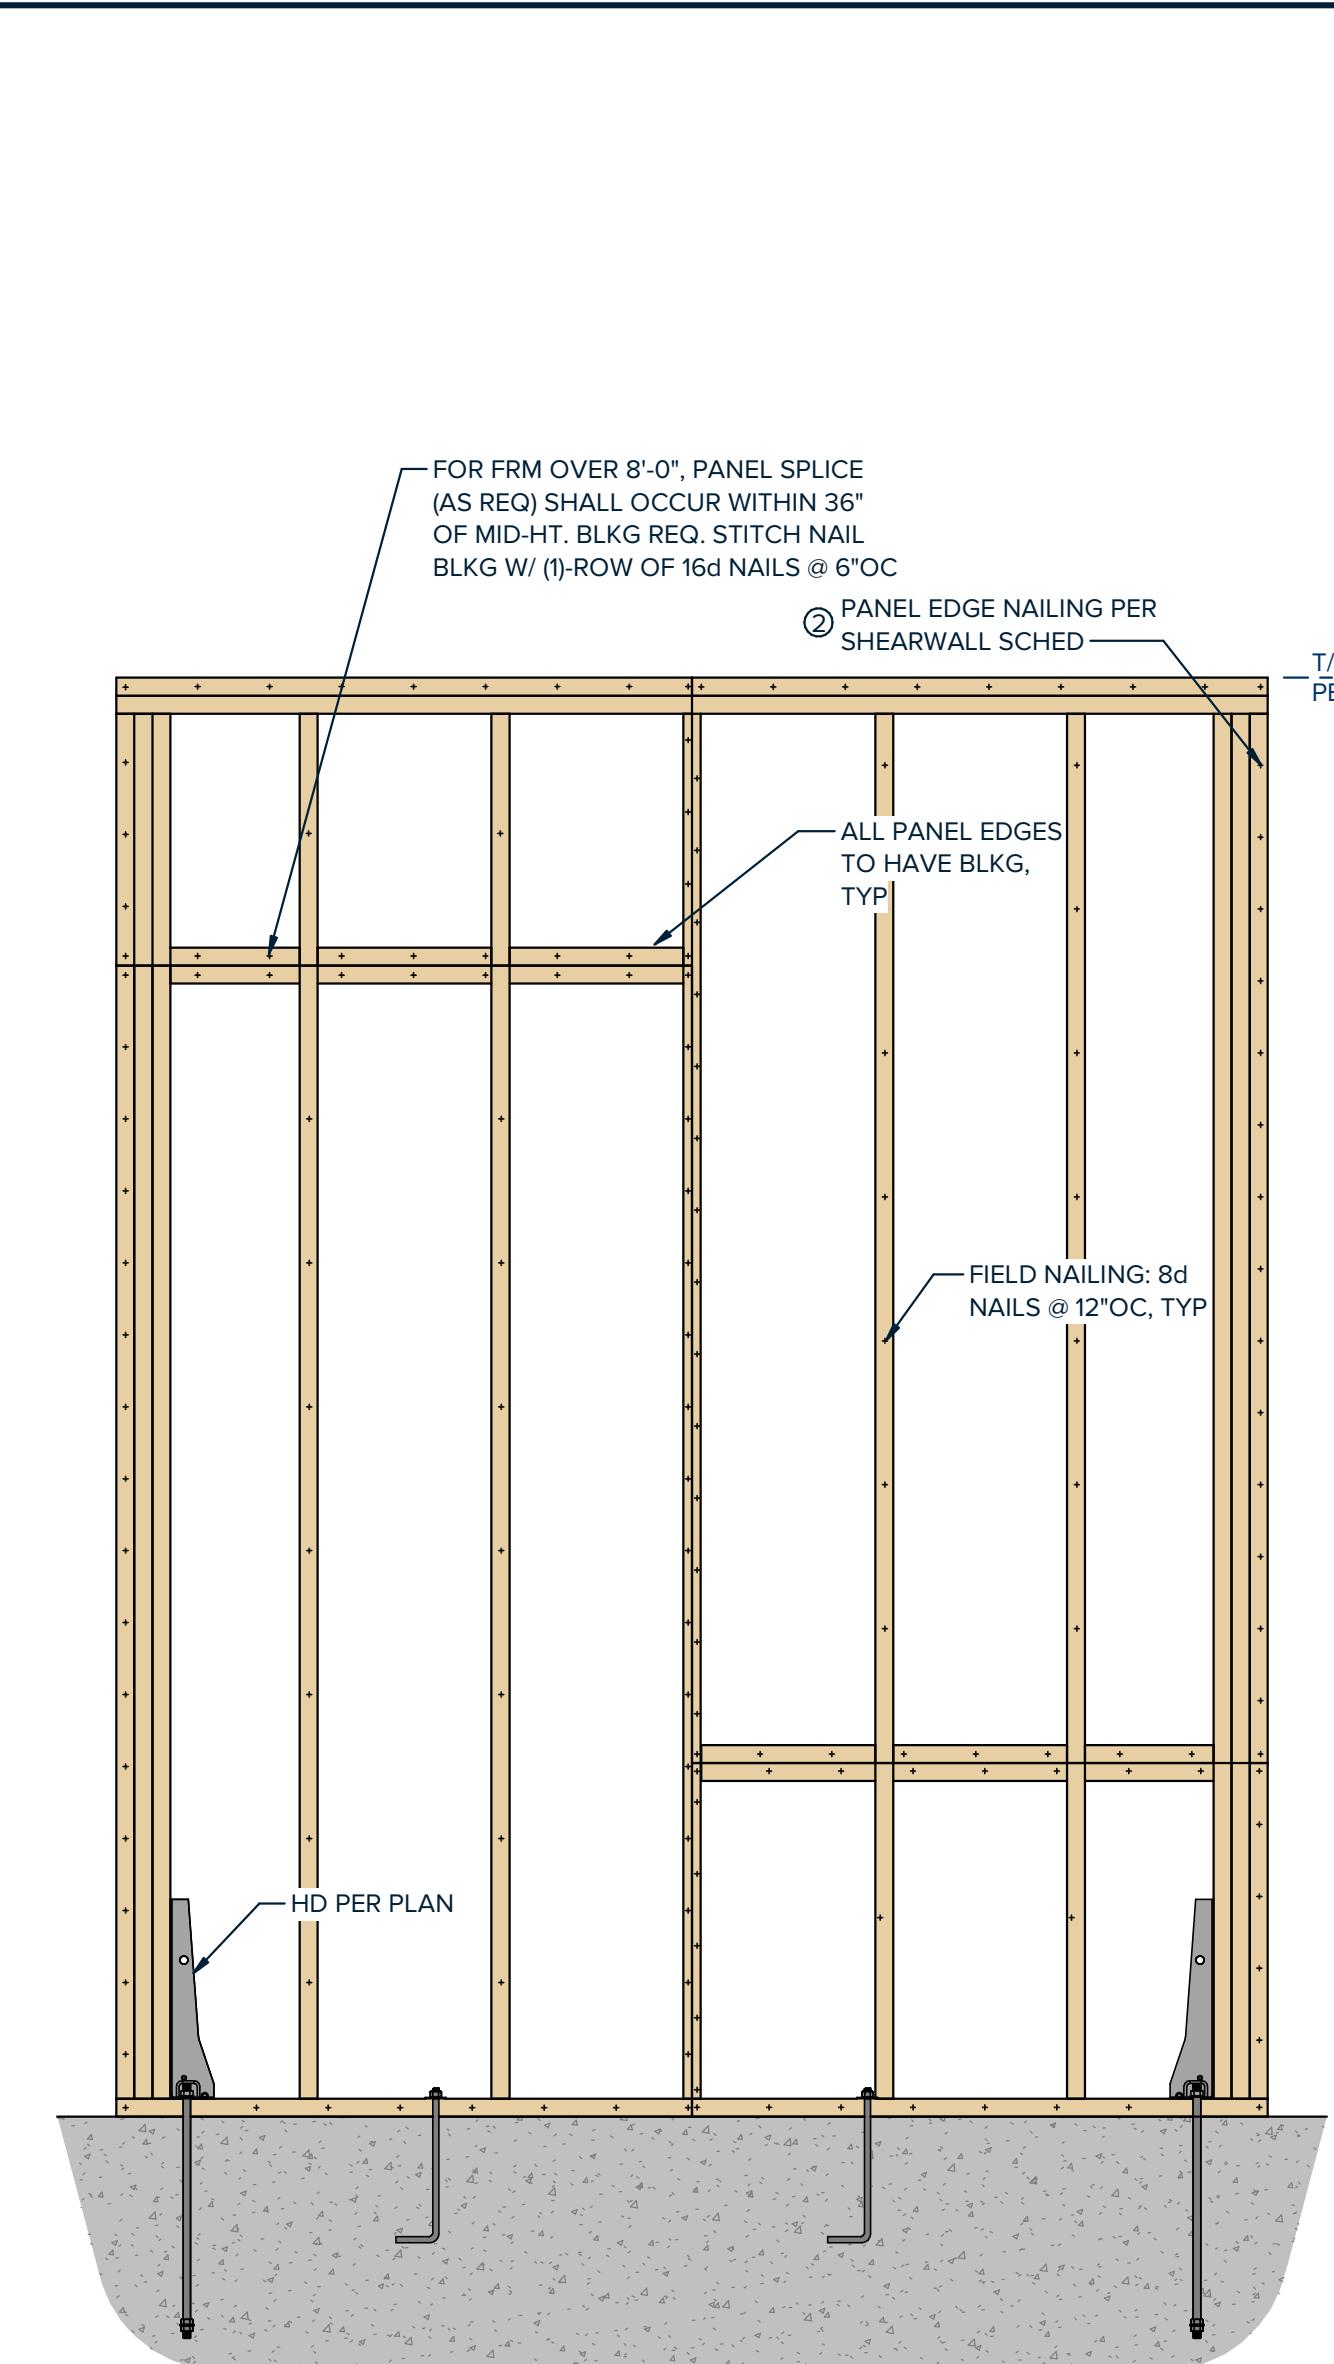


01 TYPICAL WOOD STRUCTURAL  
PANEL SHEAR WALL ELEVATION

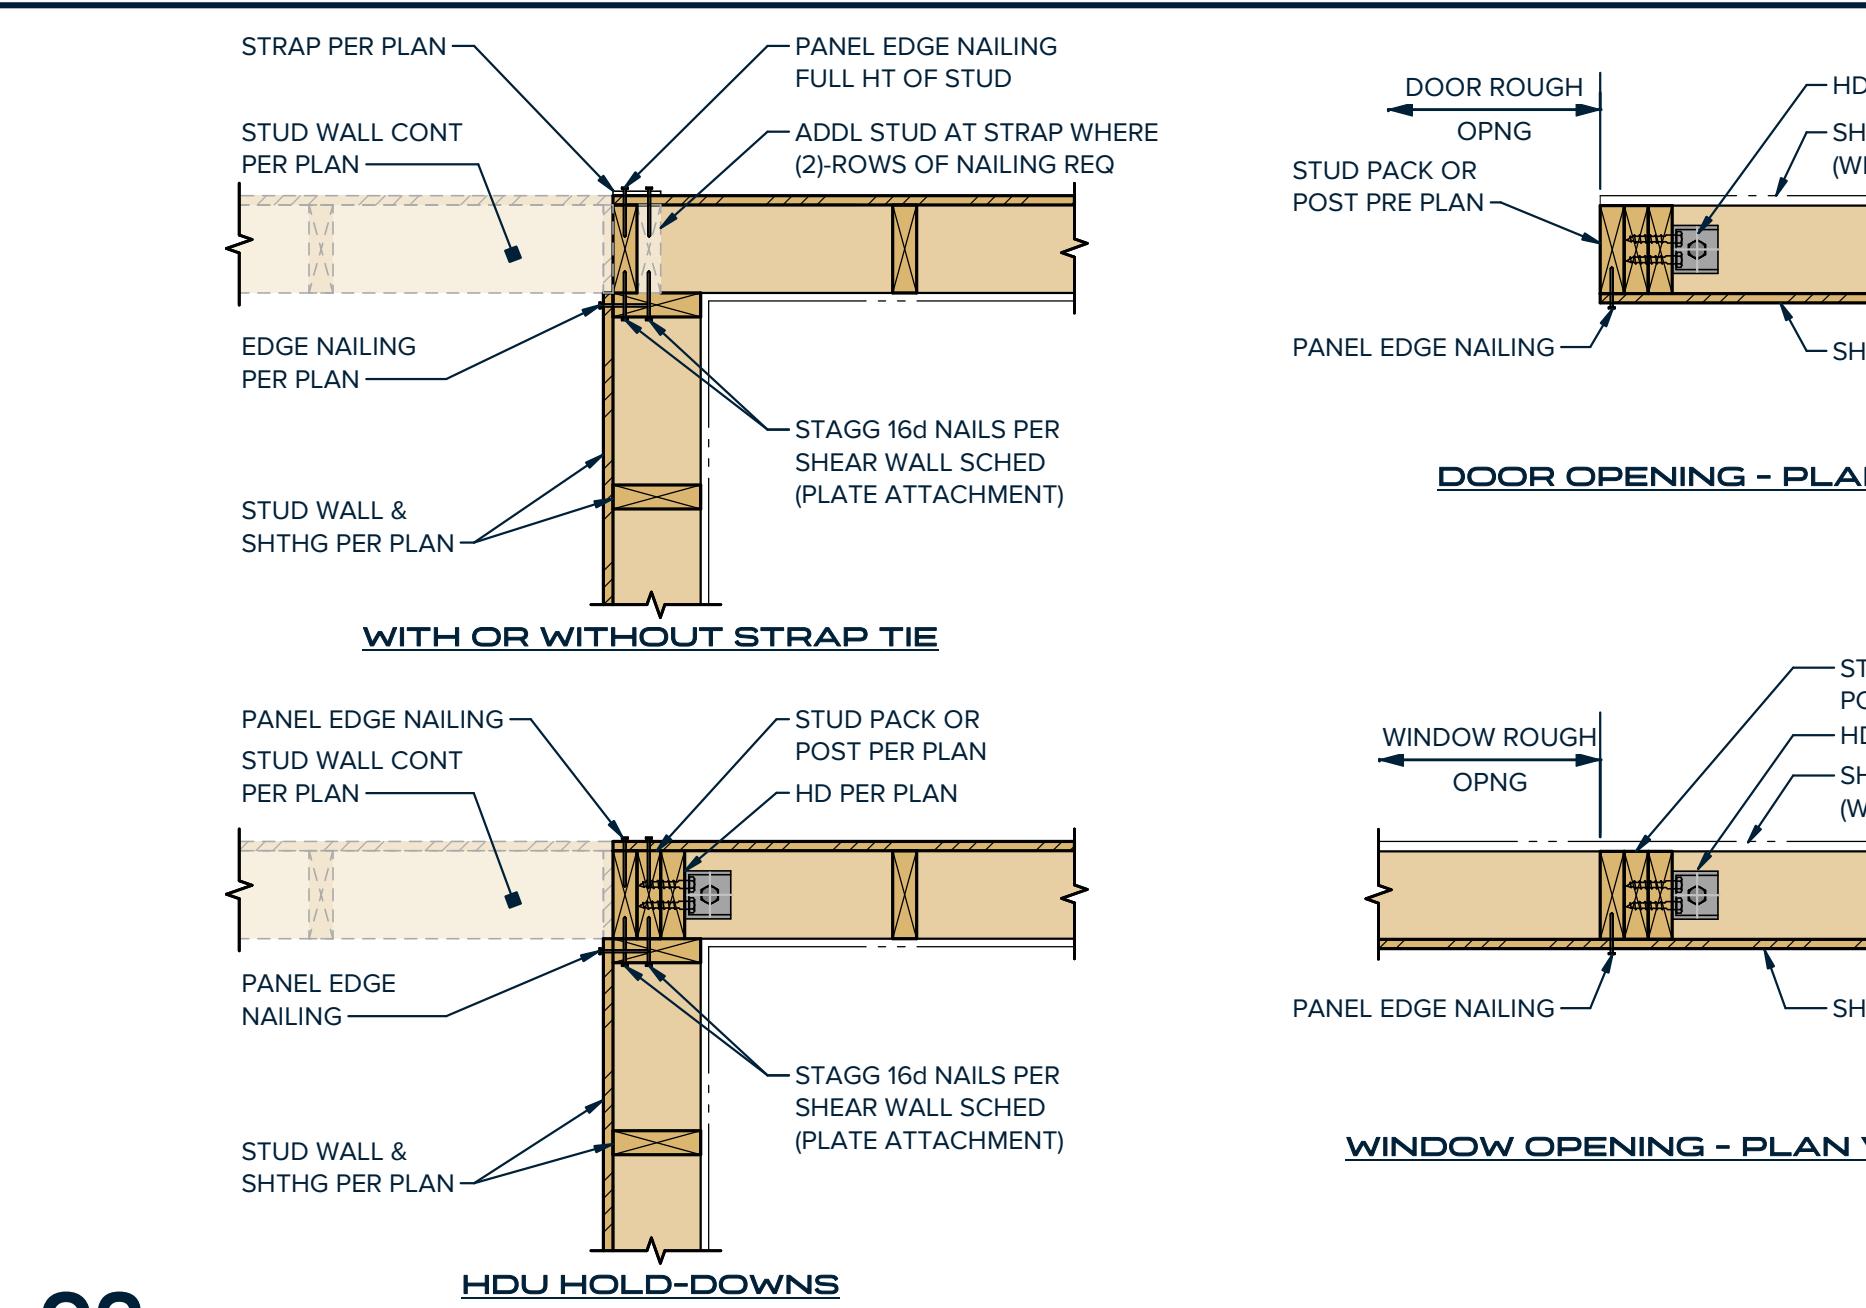

03 PLAN - INTERSECTING SHEAR WALLS



NOTES:  
1. REFERENCE WALL BRACING PLAN SCHEDULES FOR NAILING & ANCHORAGE INFORMATION.  
2. 1x4 LET-IN BRACE, DO NOT OVERNOTCH WALL FRM  
3. BRACE MAY BE INSTALLED ON OPPOSITE WALL FACE FROM THAT SHOWN ON PLAN FOR EASE OF INSTALLATION.

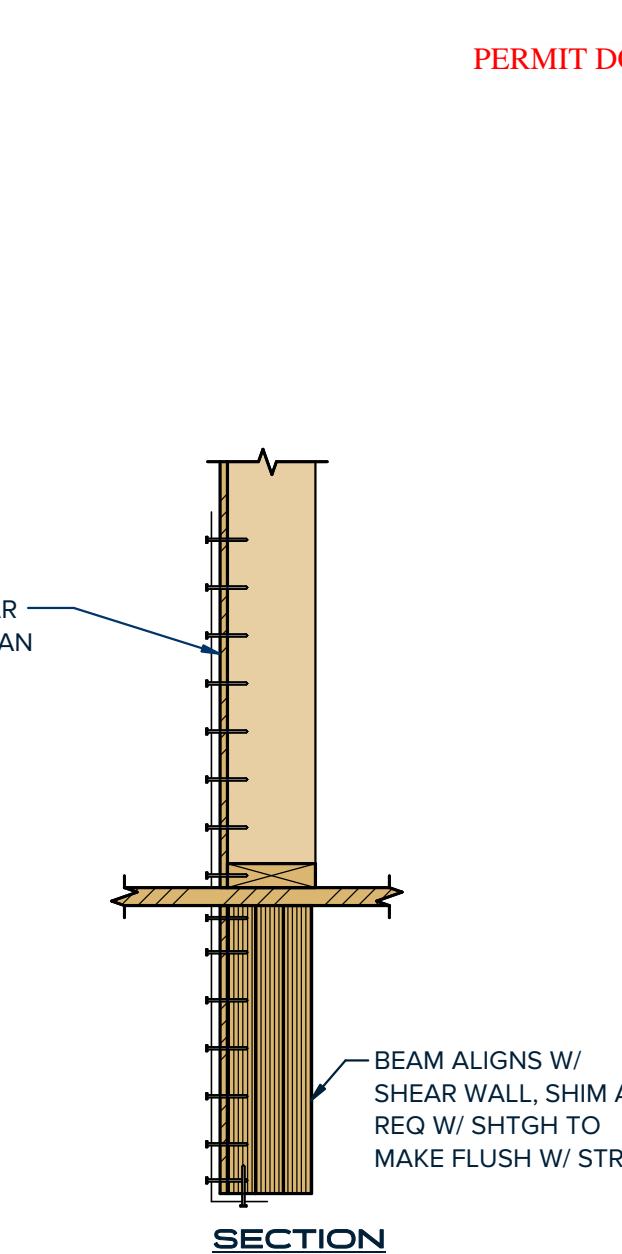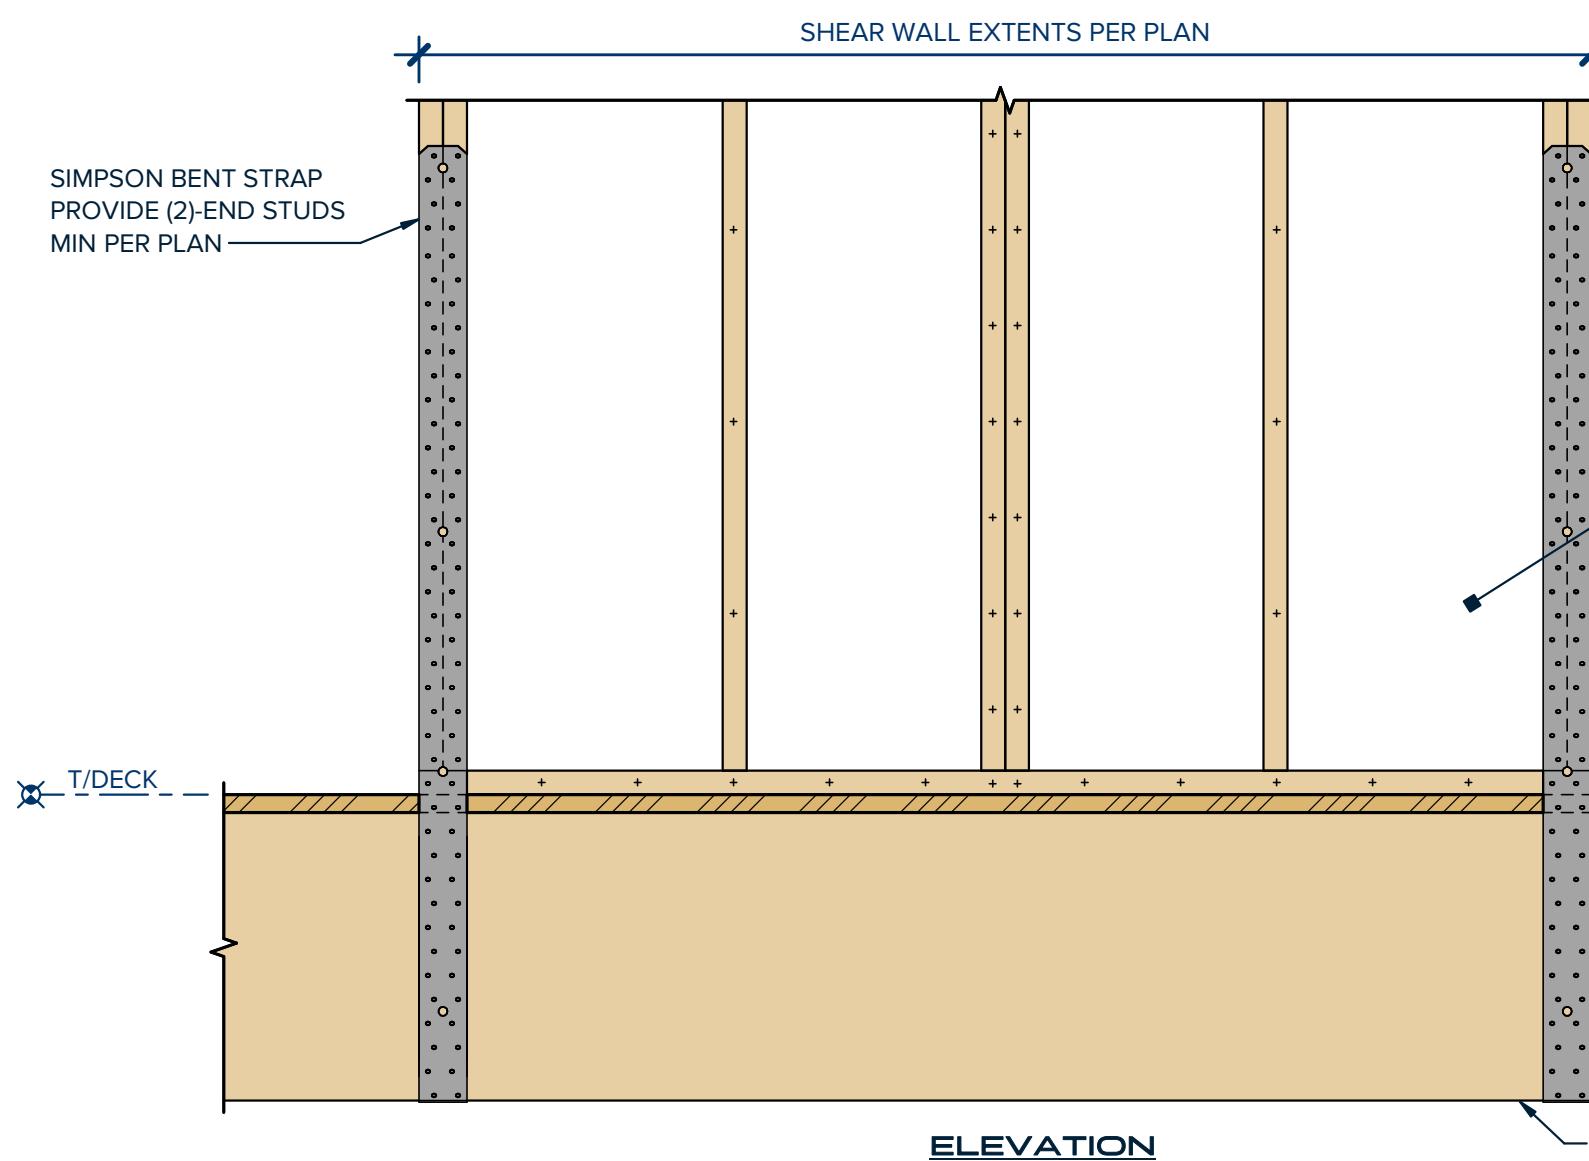

PERMIT DOCUMENTS

05 TYPICAL (2)-STORY SHEAR WALL (NOT STACKED)

NOTES:  
1. REFERENCE WALL BRACING PLAN SCHEDULES FOR NAILING & ANCHORAGE INFORMATION.  
2. 1x4 LET-IN BRACE, DO NOT OVERNOTCH WALL FRM  
3. BRACE MAY BE INSTALLED ON OPPOSITE WALL FACE FROM THAT SHOWN ON PLAN FOR EASE OF INSTALLATION.

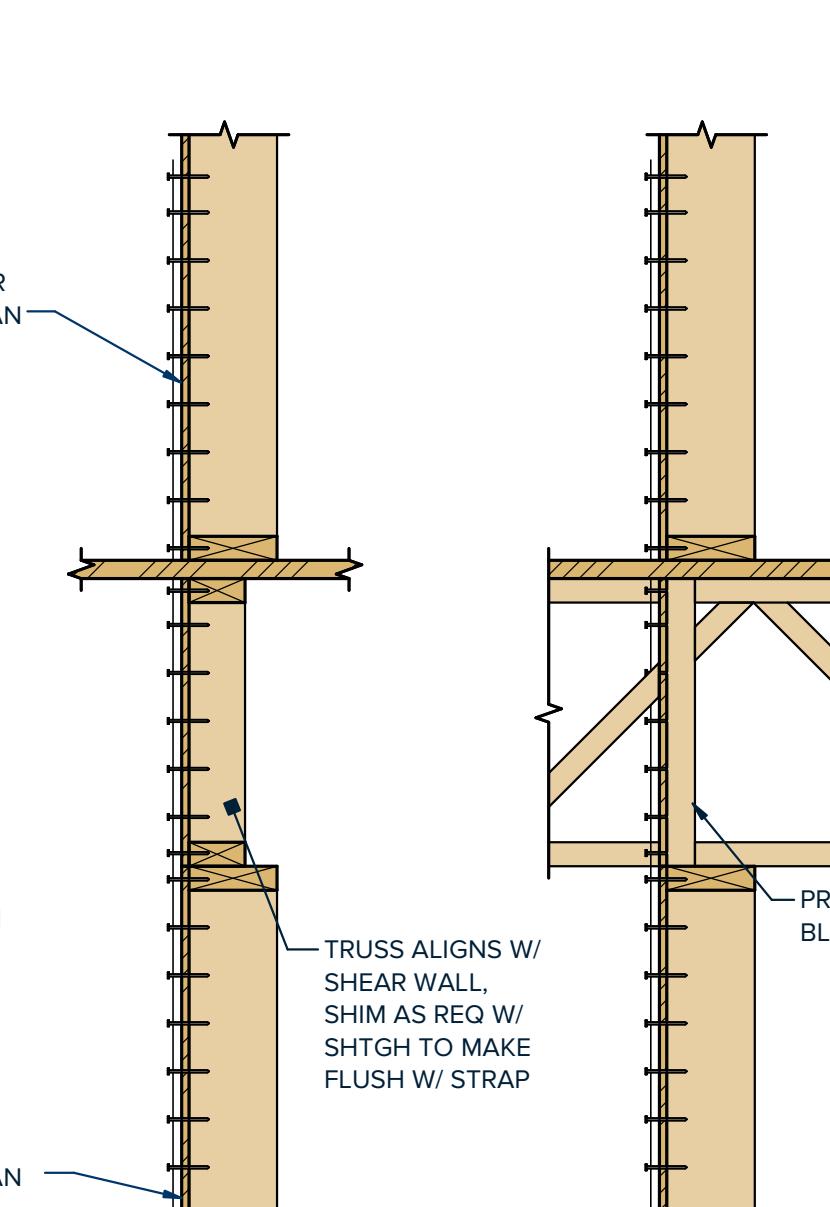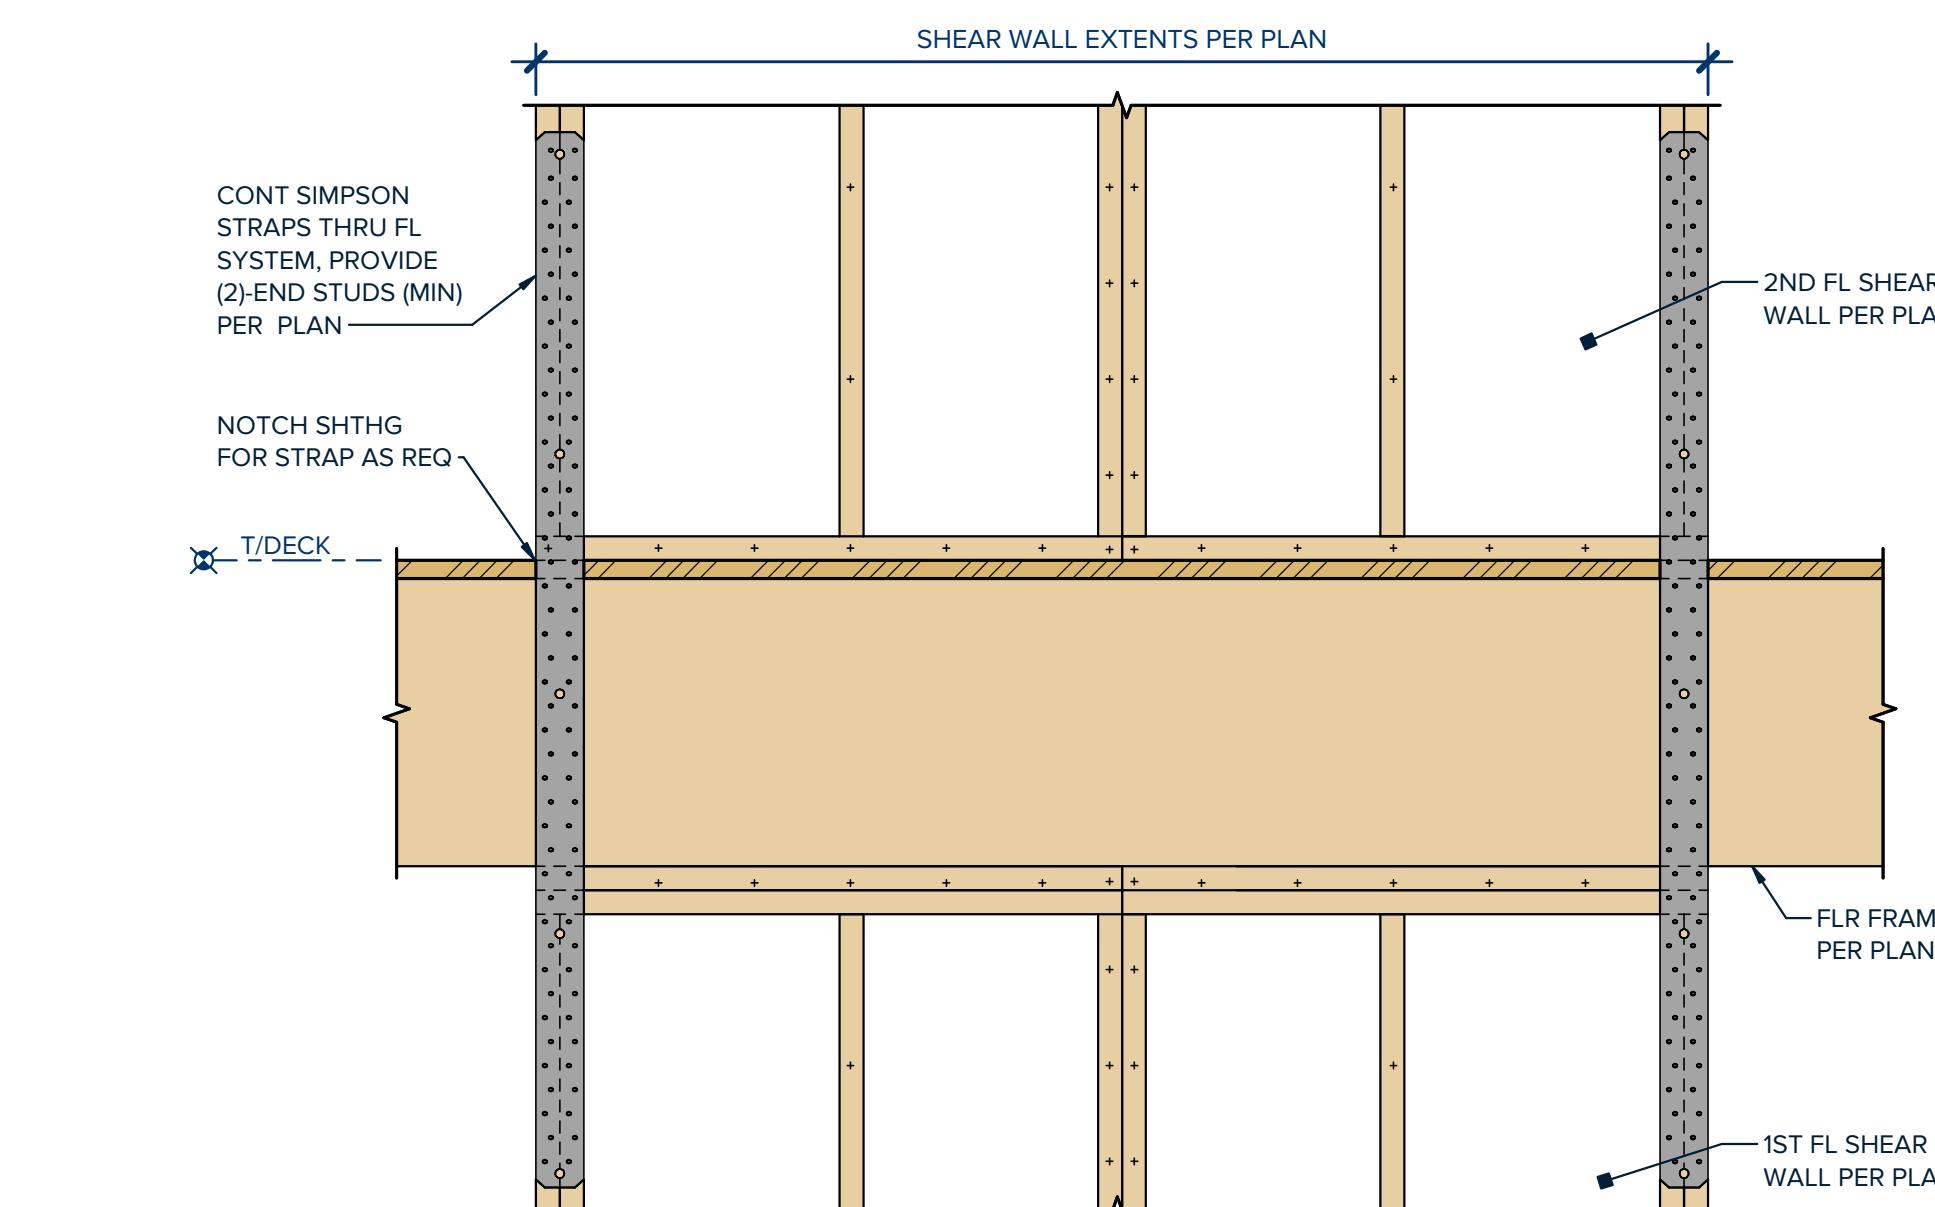


| NO                 | ISSUE | DATE |
|--------------------|-------|------|
| PM: S. Young       |       |      |
| ENG: S. Young      |       |      |
| BIM PM: C Lawrence |       |      |
| QA/QC: S Covey     |       |      |

If printed on 22x34 or 24x36 sheet, the scale is as indicated.  
If printed on an 11x17 or 12x18 sheet, the scale is reduced by half.

06 TYPICAL CONTINUOUSLY SHEATHED PORTAL FRAME WALL ELEVATION

SCALE: NTS

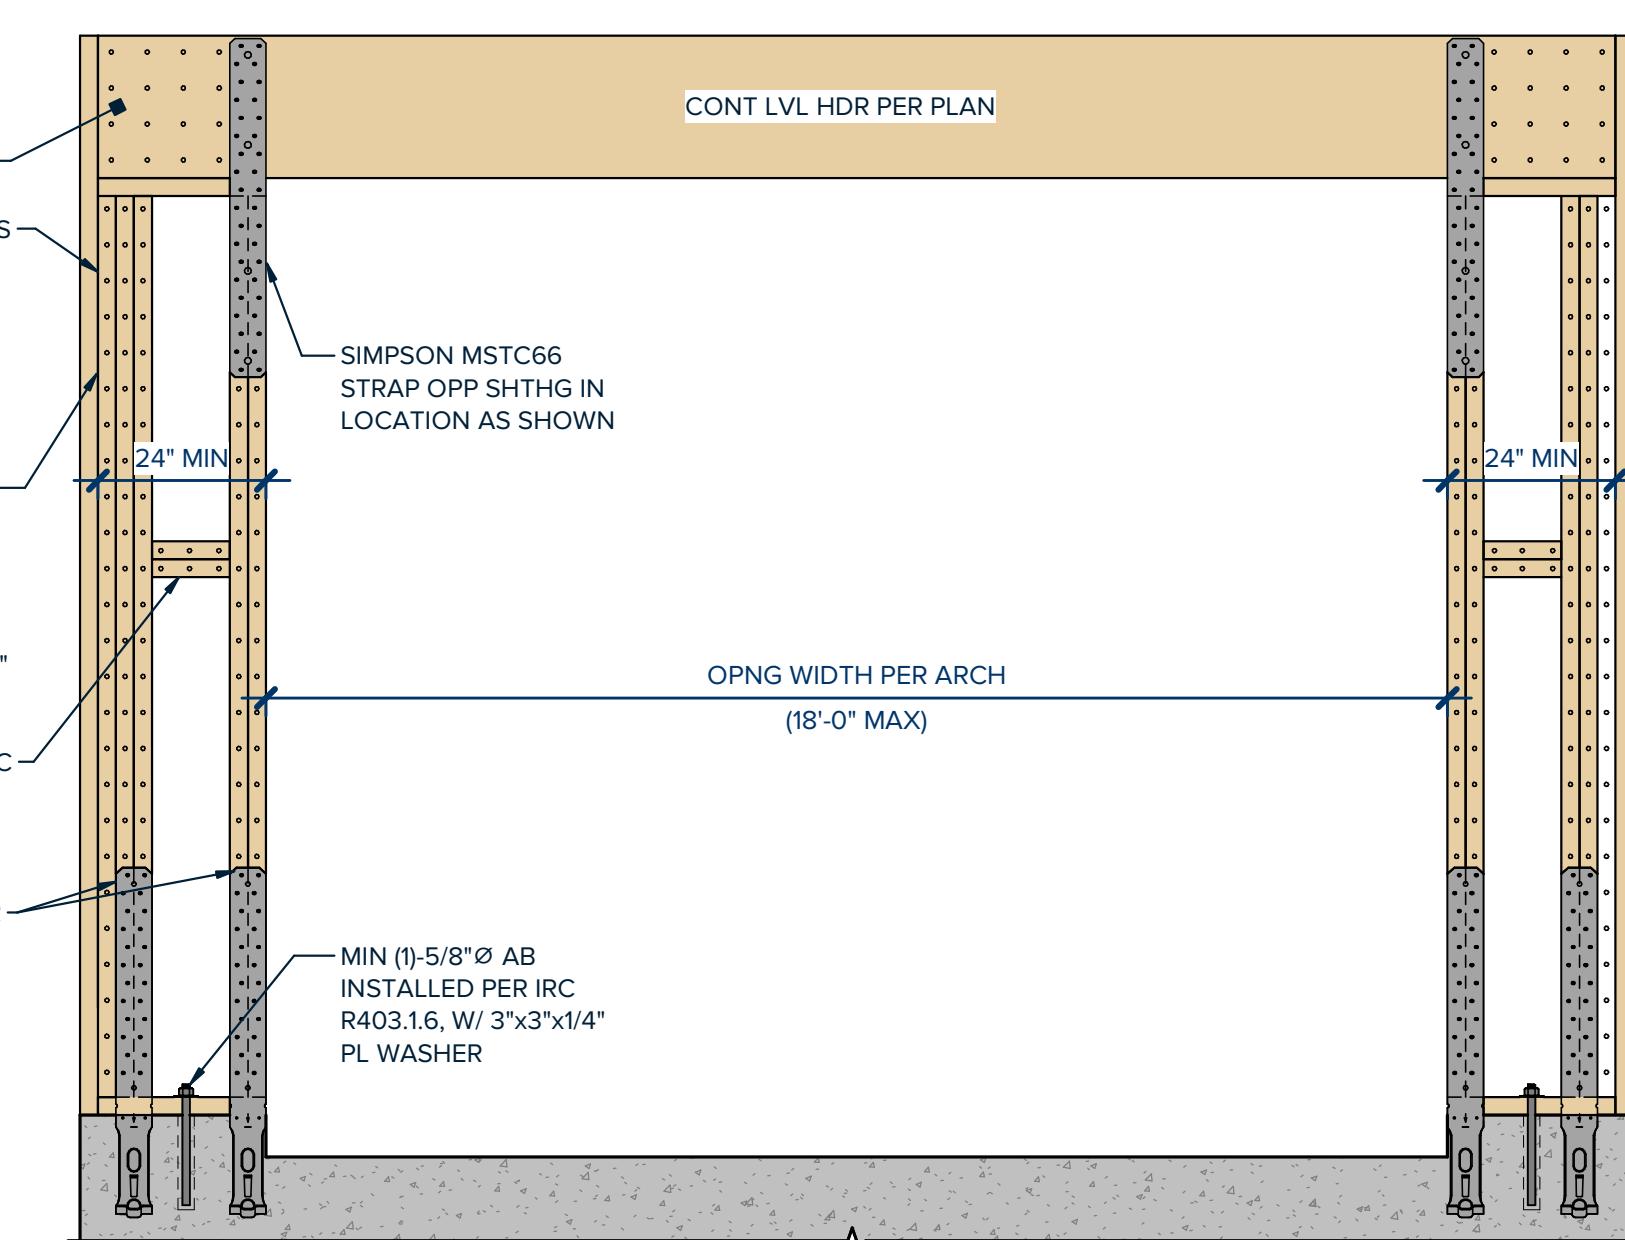

07 TYPICAL (2)-STORY INTERIOR SHEAR WALL (STACKED)

SCALE: NTS

07 TYPICAL (2)-STORY INTERIOR SHEAR WALL (STACKED)  
SCALE: 1" = 1'-0"

TYPICAL WOOD SHEAR WALL DETAILS  
SHEET TITLE

SHEET NUMBER


S8.04

ALTERSTUDIO  
ARCHITECTURE LLP  
1801 Lavaca Street  
Ste 106  
Austin, Texas 78701

ARCHITECT  
KOS RESIDENCE


17363 E Reed Parks Rd  
Jonestown, Texas 78645

PERMIT SET  
12.15.2023

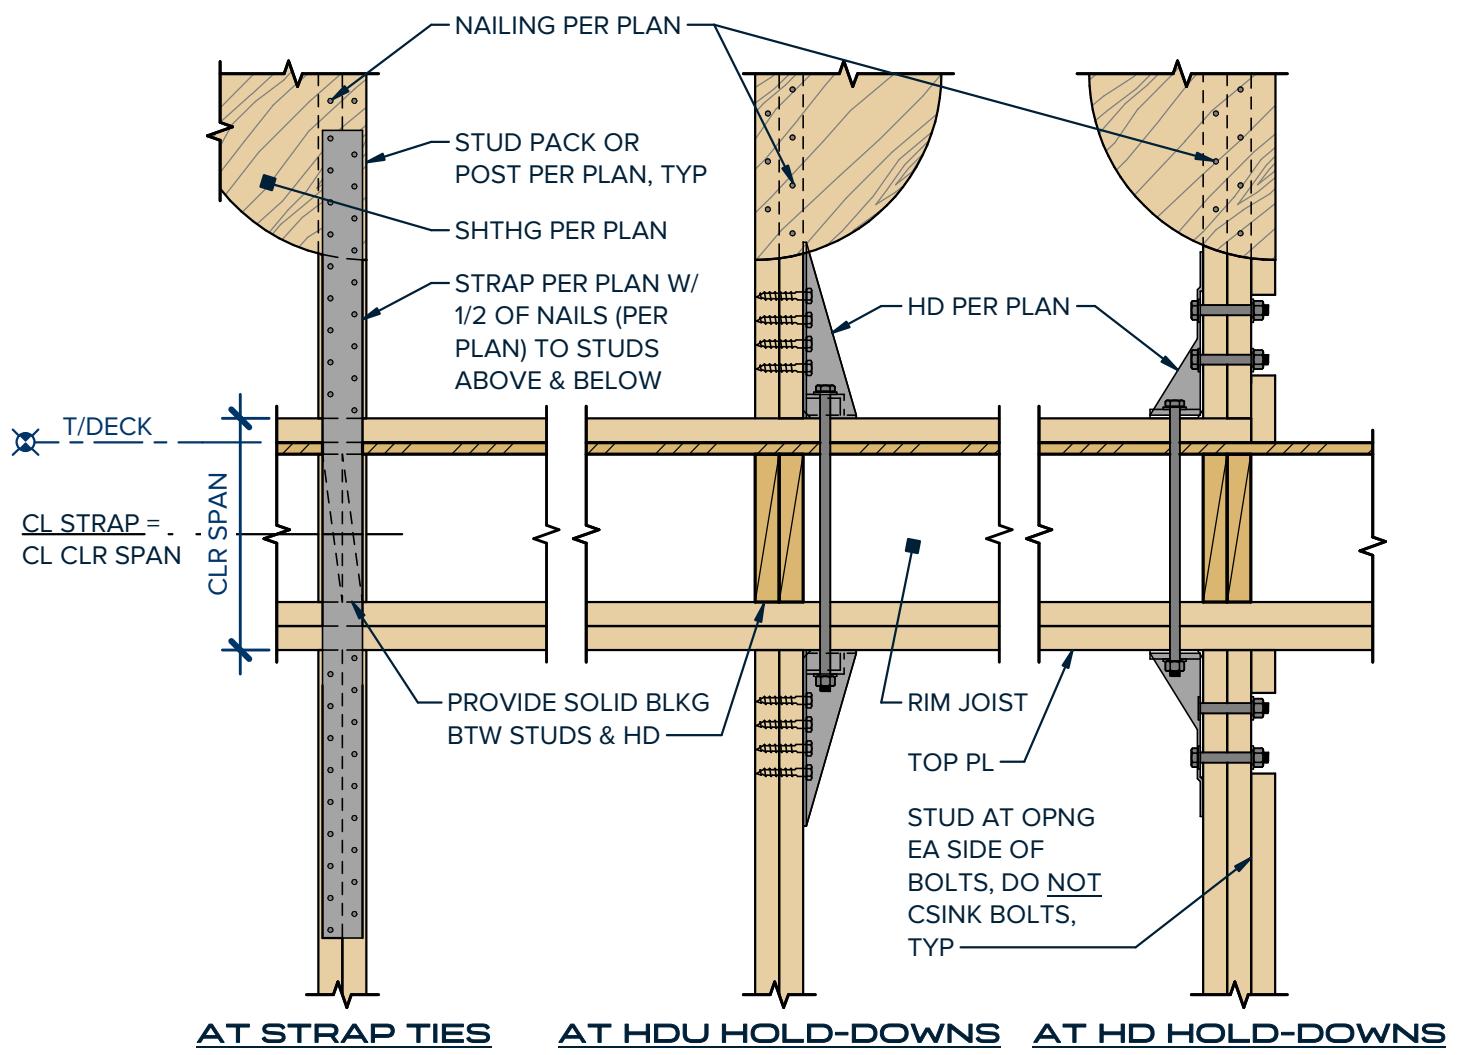


**01** TYPICAL HOLD-DOWN OR STRAP CONNECTION AT FLOOR FRAMING

SCALE : NTS

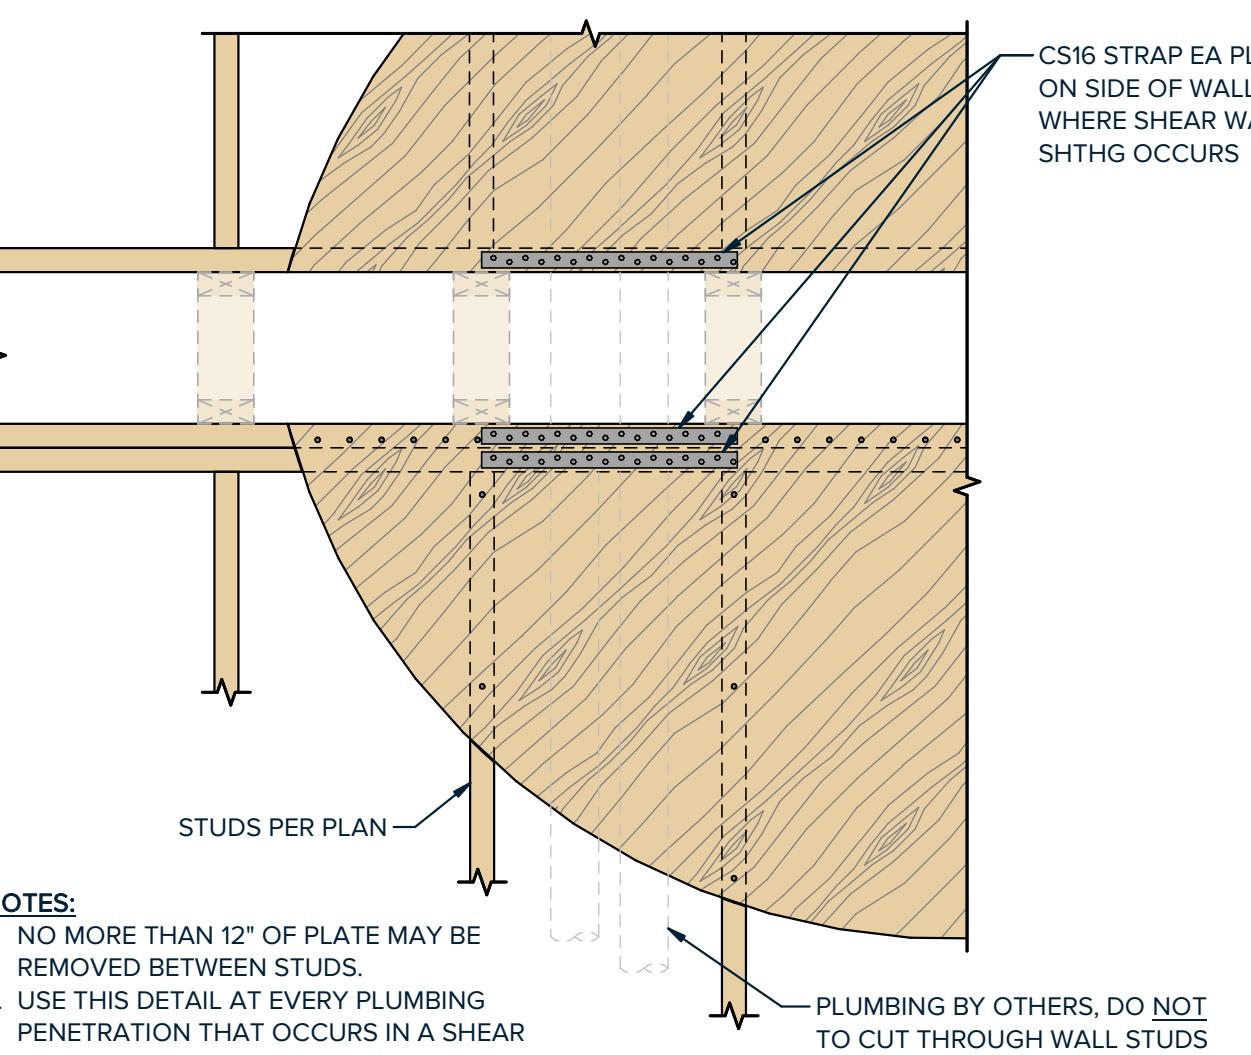

**02** PLATE STRAPPING AT SHEAR WALL PLUMBING PENETRATIONS

SCALE : NTS

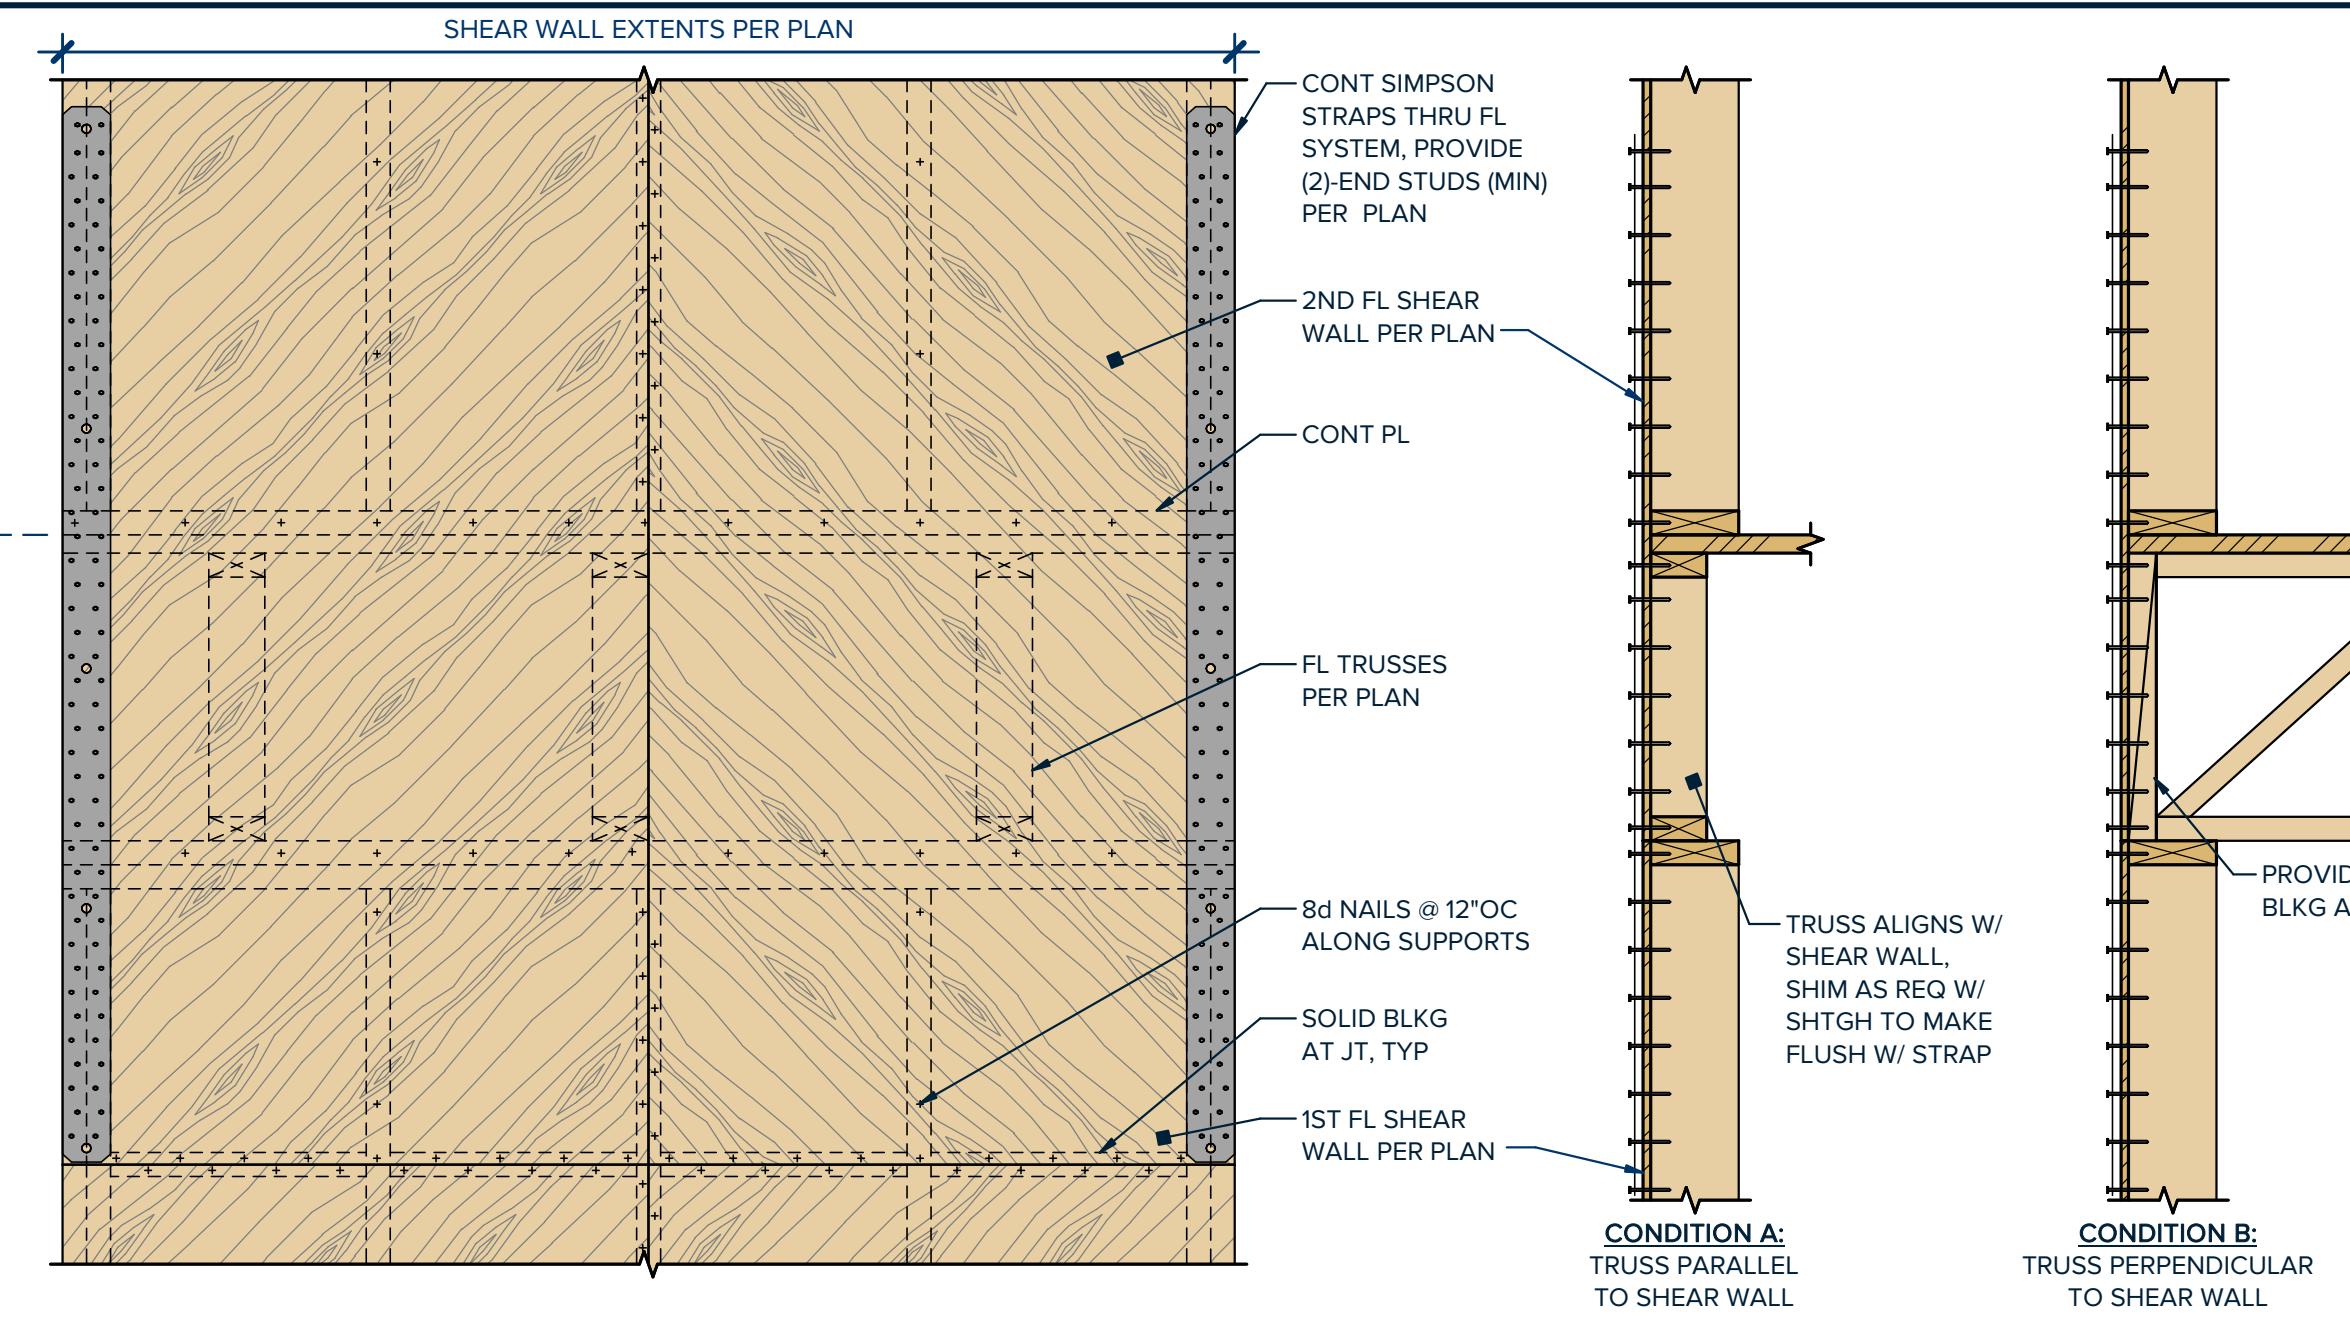

**03** TYPICAL (2)-STORY EXTERIOR SHEAR WALL ELEVATION

SCALE : NTS

| NO                 | ISSUE | DATE |
|--------------------|-------|------|
| PM: S.Young        |       |      |
| ENG: S. Young      |       |      |
| BIM PM: C Lawrence |       |      |
| QA/QC: S Covey     |       |      |

If printed on 22x34 or 24x36 sheet, the scale is as indicated.  
If printed on an 11x17 or 12x18 sheet, the scale is reduced by half. SCALE


TYPICAL WOOD SHEAR WALL DETAILS

SHEET TITLE

PERMIT DOCUMENTS


**S8.05**

SHEET NUMBER

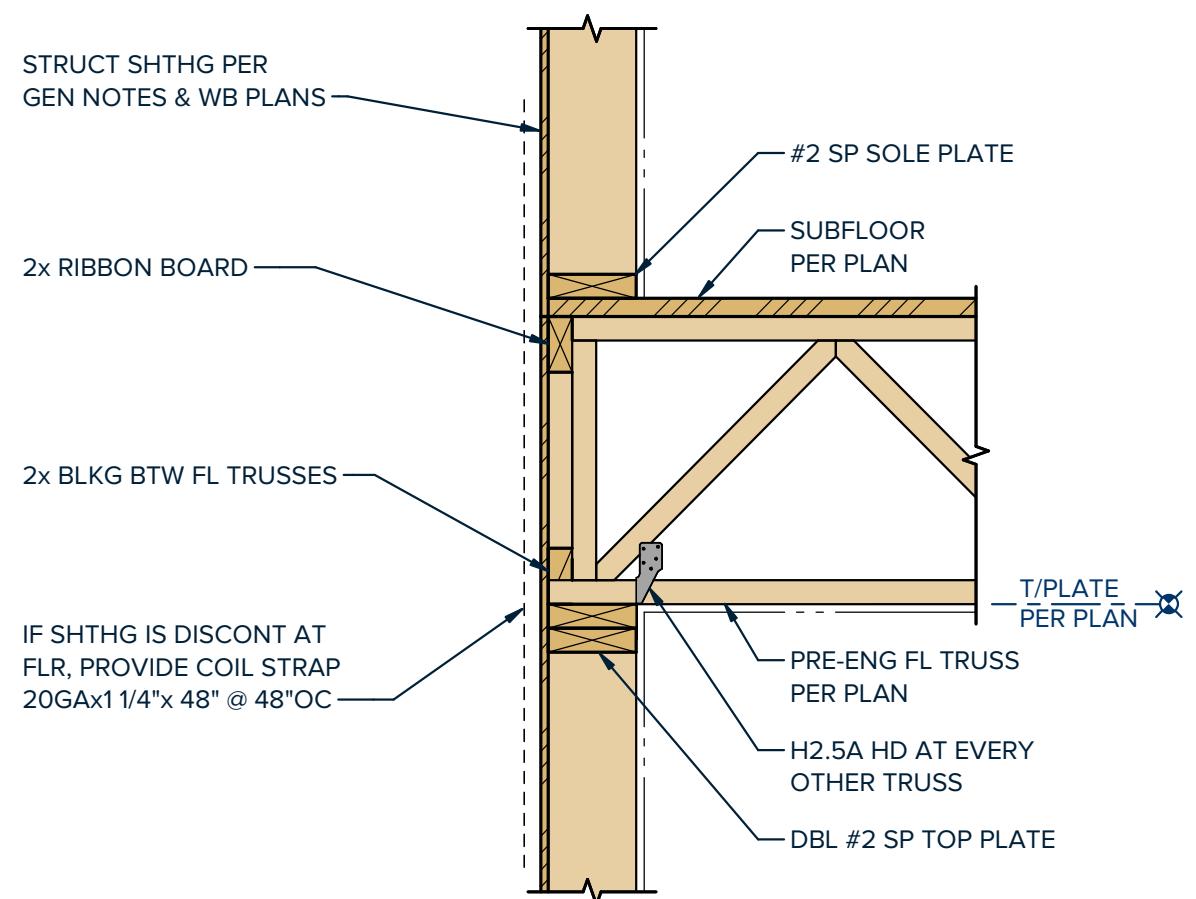


**01** FLOOR TRUSS - PERPENDICULAR TO EXT WALL

SCALE : 1" = 1'-0"

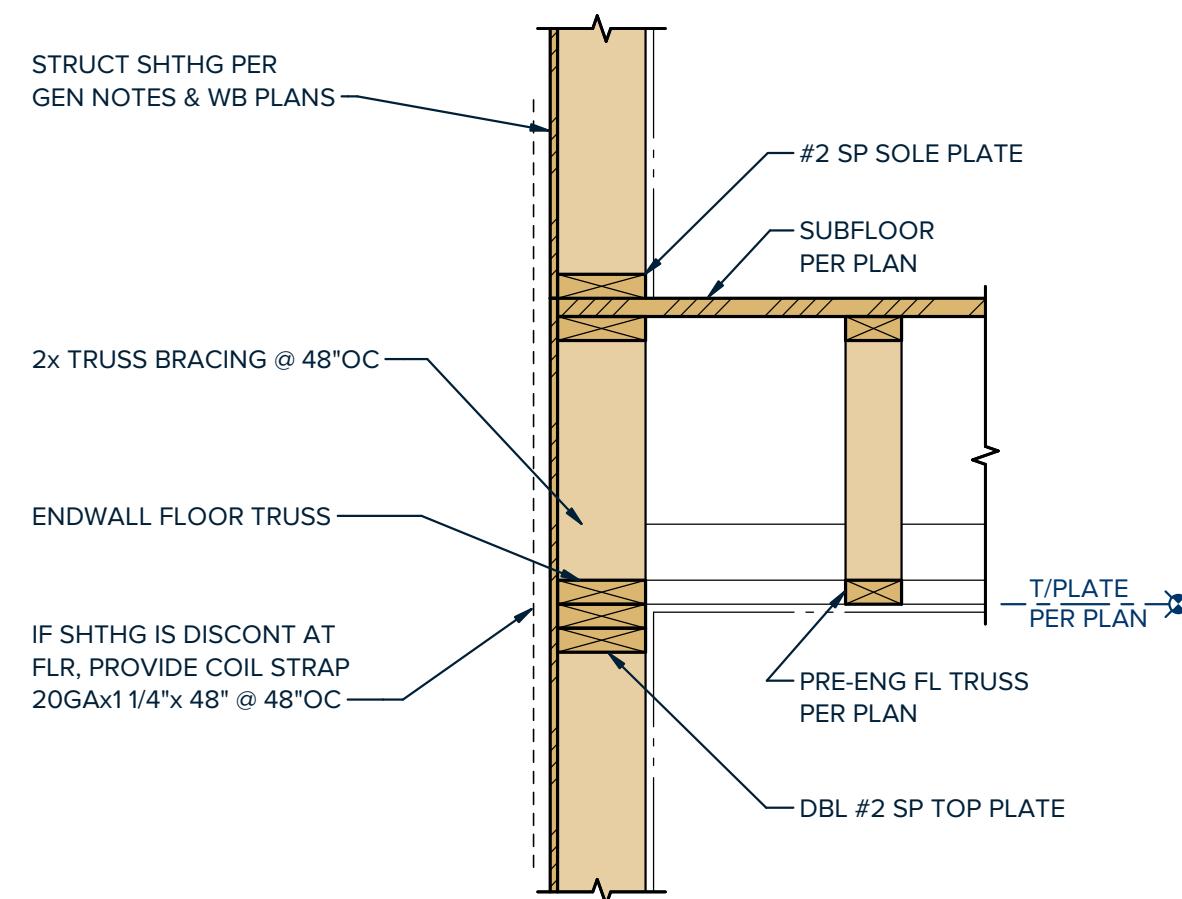


**02** FLOOR TRUSS - PARALLEL TO EXT WALL

SCALE : 1" = 1'-0"

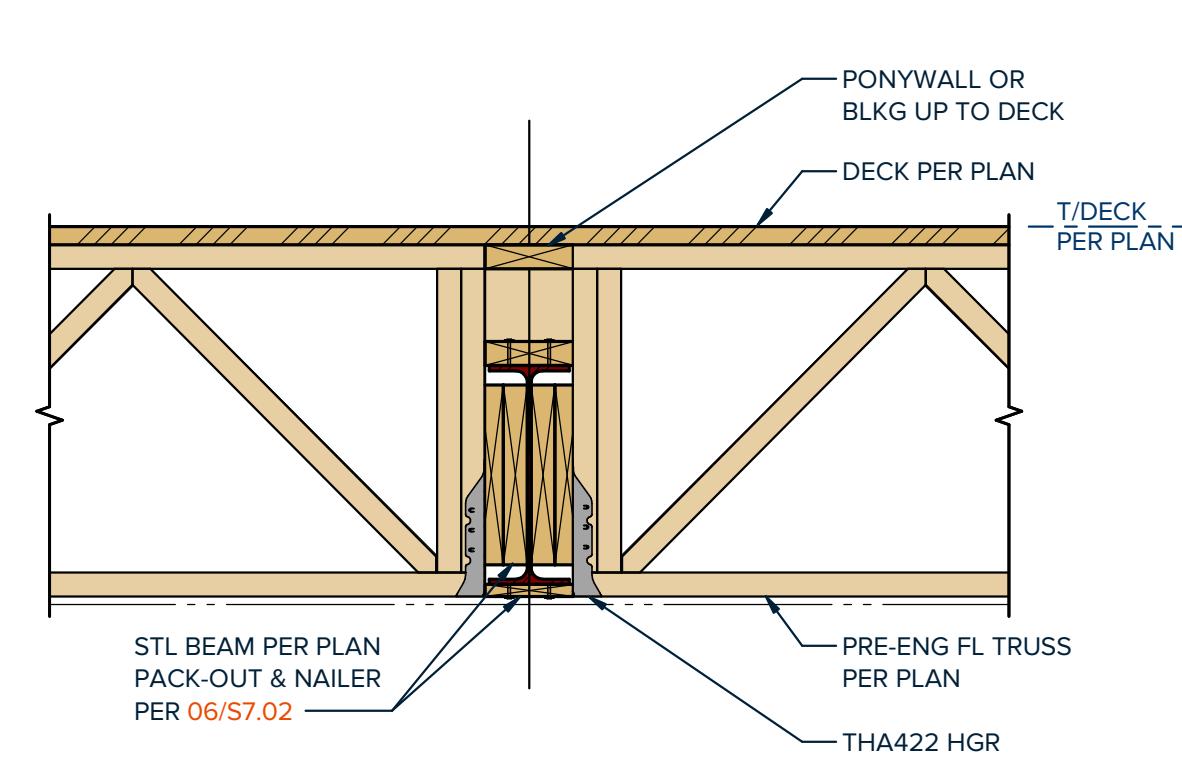


**03** FLOOR TRUSS AT WIDE FLANGE BEAM

SCALE : 1" = 1'-0"

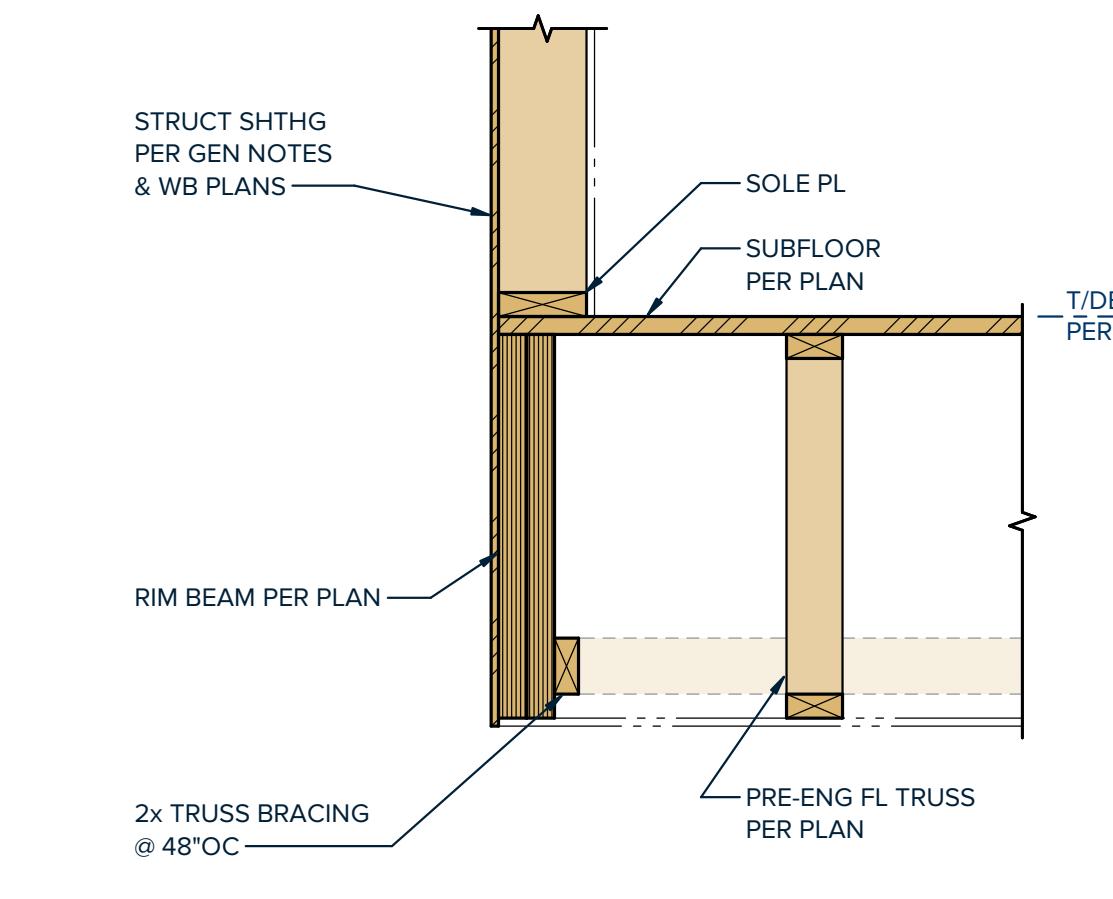


**04** FLOOR TRUSS, PARALLEL W/ LVL

SCALE : 1" = 1'-0"

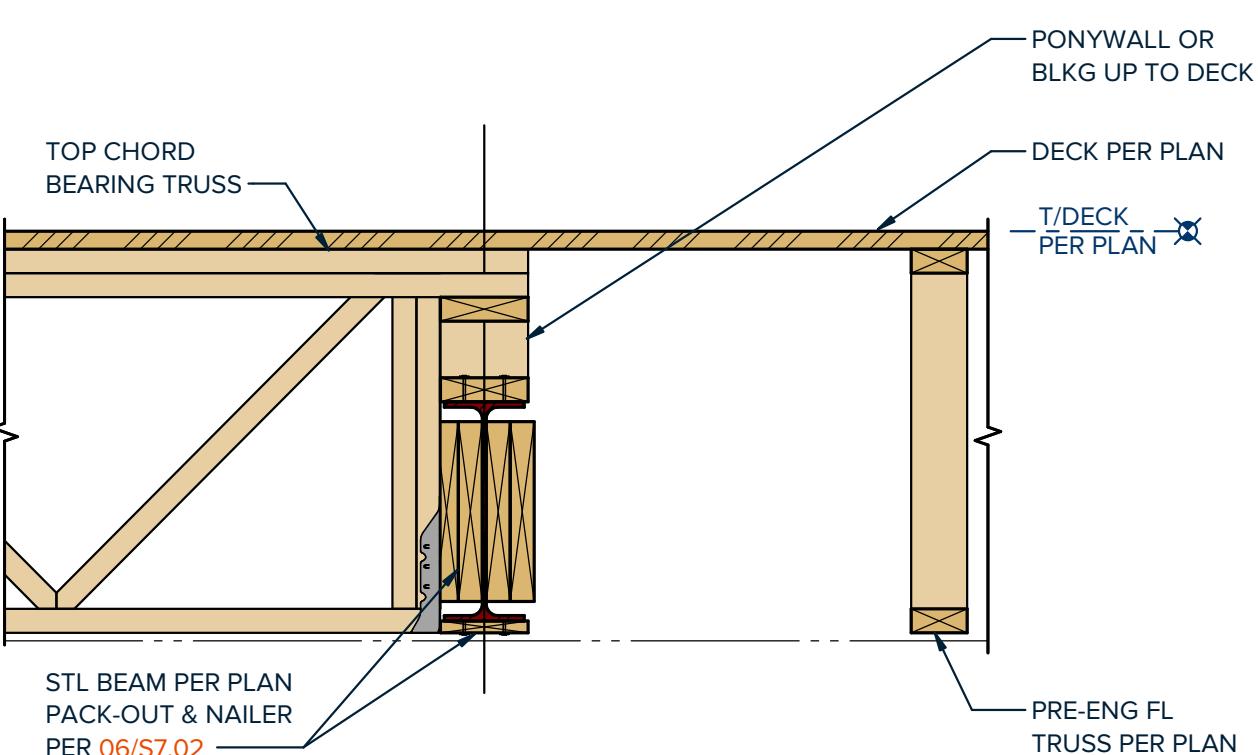


**05** FLOOR TRUSS AT WIDE FLANGE BEAM

SCALE : 1" = 1'-0"

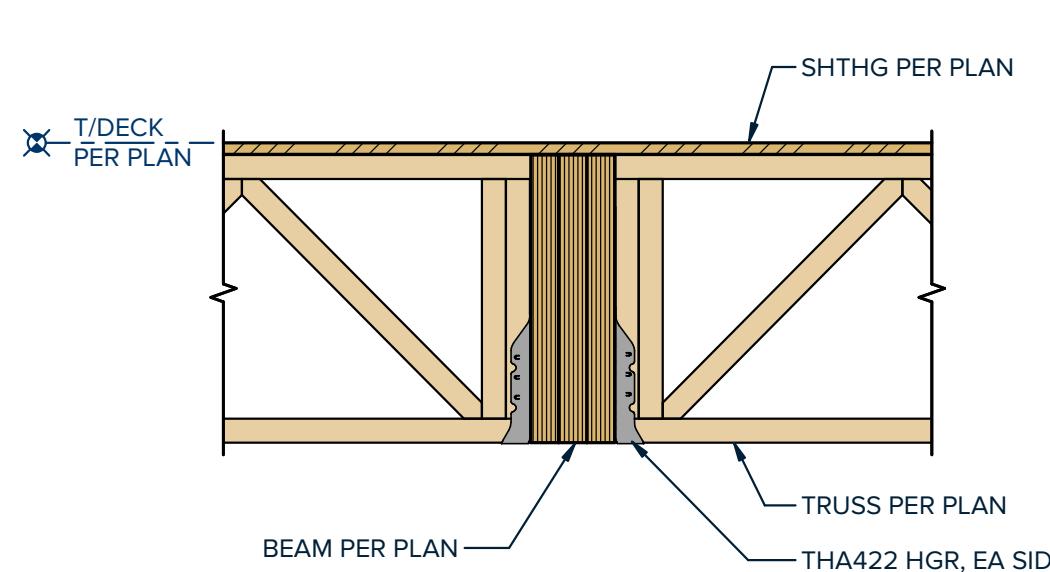


**06** FLOOR TRUSS TO WOOD BEAM

SCALE : 1" = 1'-0"

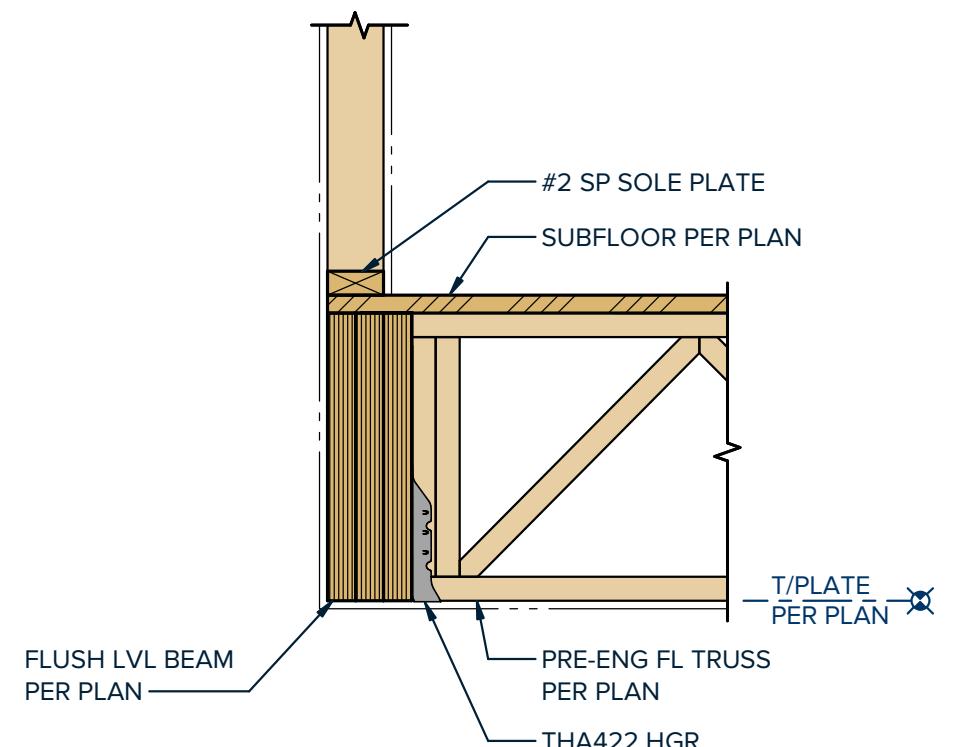


**07** FLOOR TRUSS - FLUSH LVL BEAM

SCALE : 1" = 1'-0"

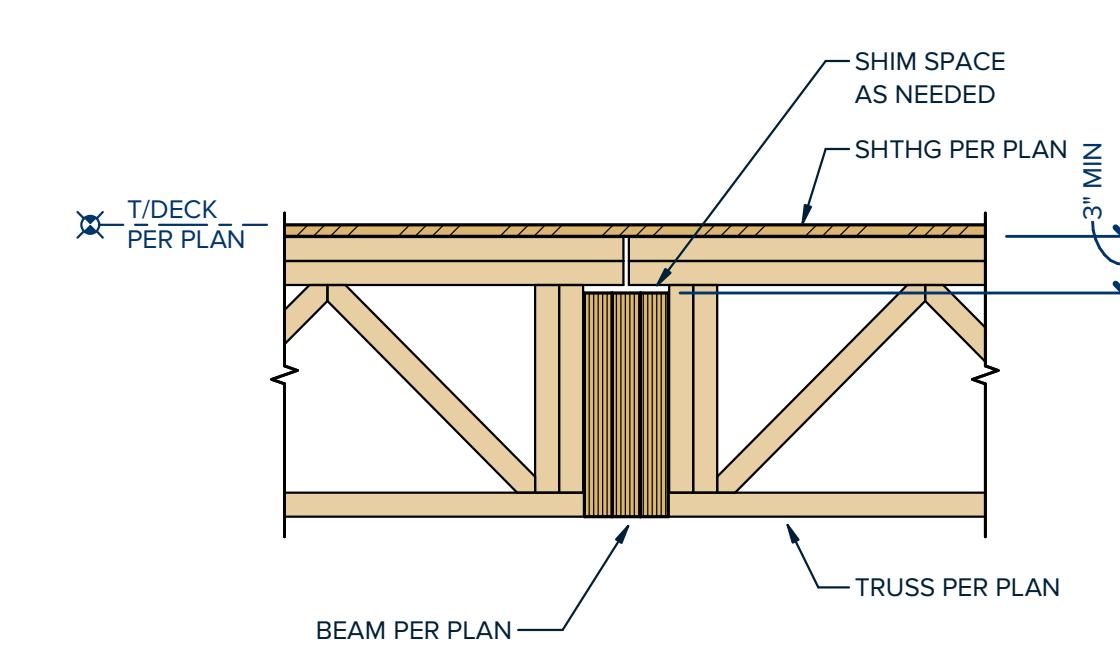


**08** TOP CHORD BEARING TRUSS ON WOOD BEAM

SCALE : 1" = 1'-0"

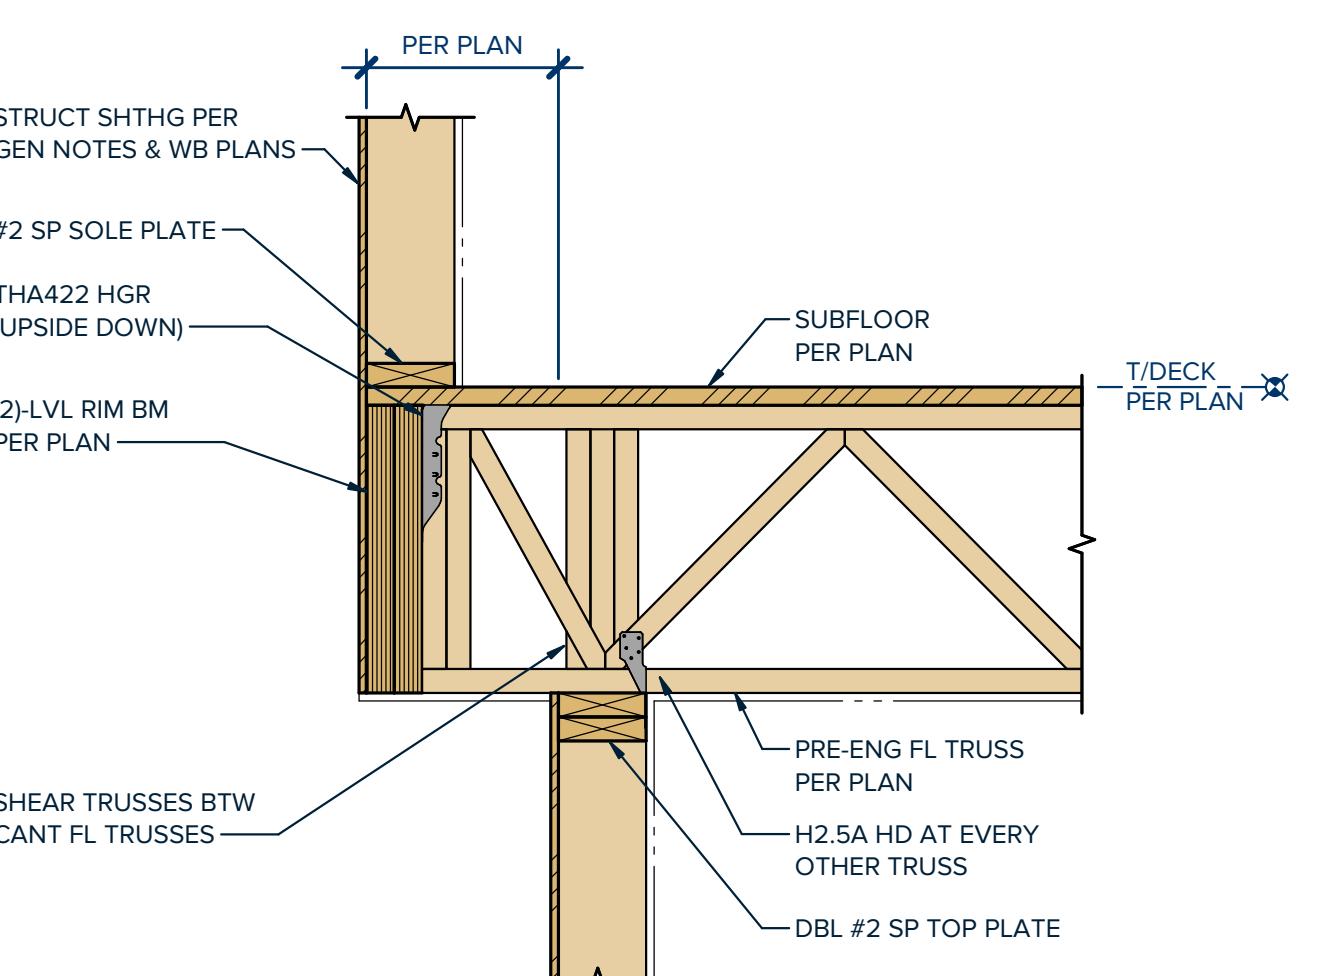


**09** CANTILEVER FLOOR TRUSS

SCALE : 1" = 1'-0"

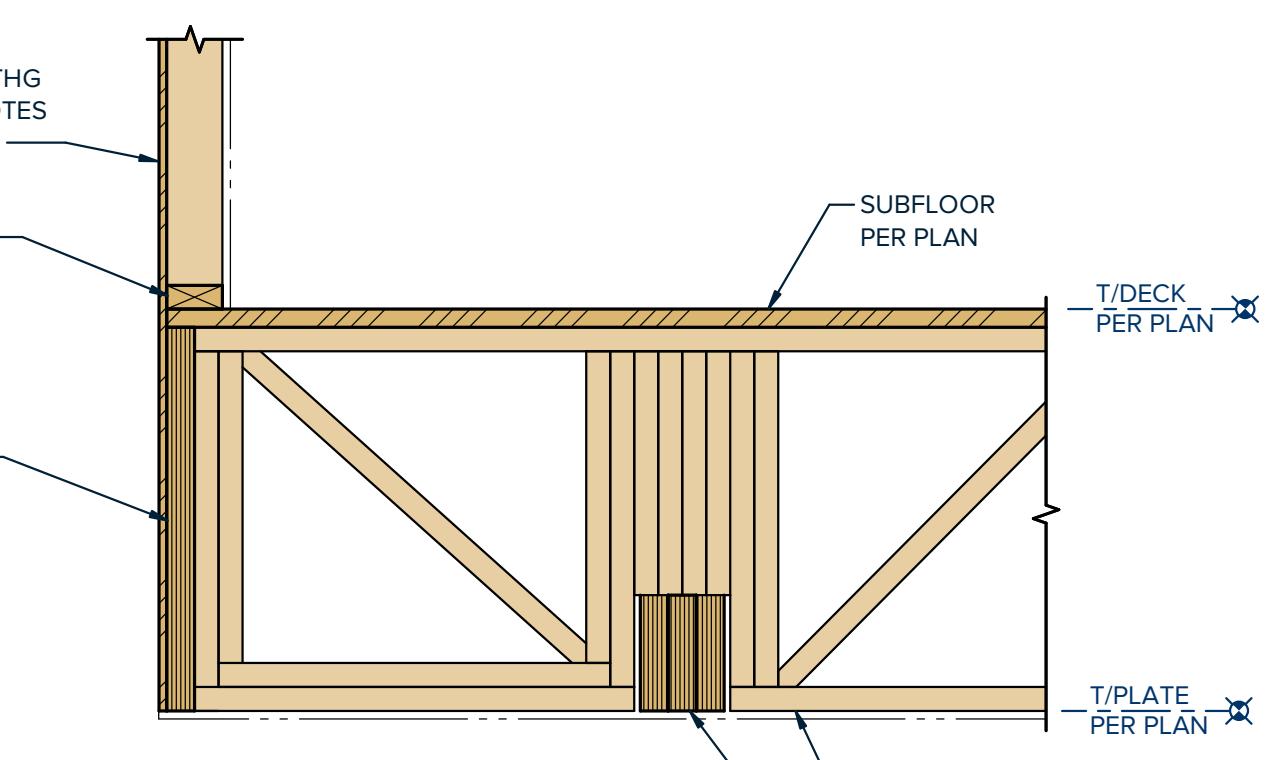

**10** FLOOR TRUSS - FLUSH LVL BEAM

SCALE : 1" = 1'-0"

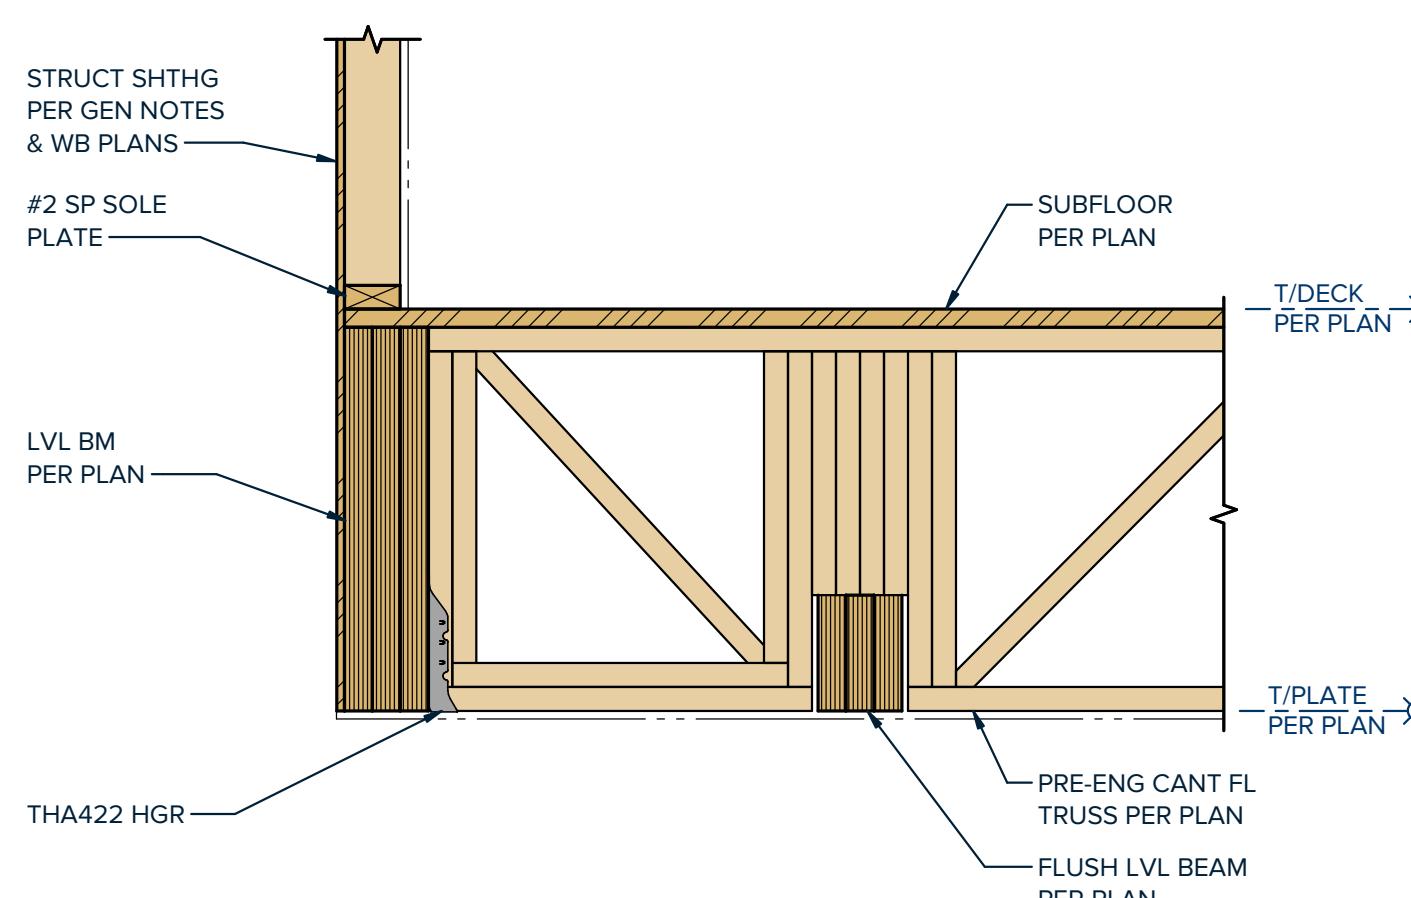

**11** FLOOR TRUSS - FLUSH LVL BEAM

SCALE : 1" = 1'-0"

PERMIT DOCUMENTS

| NO                 | ISSUE | DATE |
|--------------------|-------|------|
| PM: S. Young       |       |      |
| ENG: S. Young      |       |      |
| BIM PM: C Lawrence |       |      |
| QA/QC: S Covey     |       |      |


If printed on 22x34 or 24x36 sheet, the scale is as indicated.  
If printed on an 11x17 or 12x18 sheet, the scale is reduced by half. SCALE

WOOD FRAMING

SHEET TITLE

SHEET NUMBER

**S8.10**

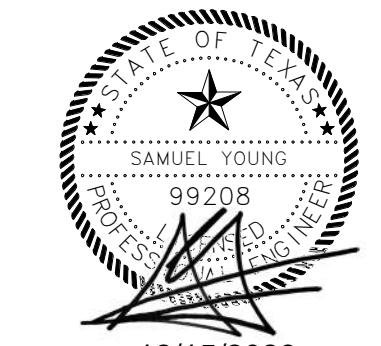


ALTERSTUDIO  
ARCHITECTURE LLP  
1801 Lavaca Street  
Ste 106  
Austin, Texas 78701

ARCHITECT  
**KOS RESIDENCE**


17363 E Reed Parks Rd  
Jonestown, Texas 78645

PERMIT SET  
12.15.2023

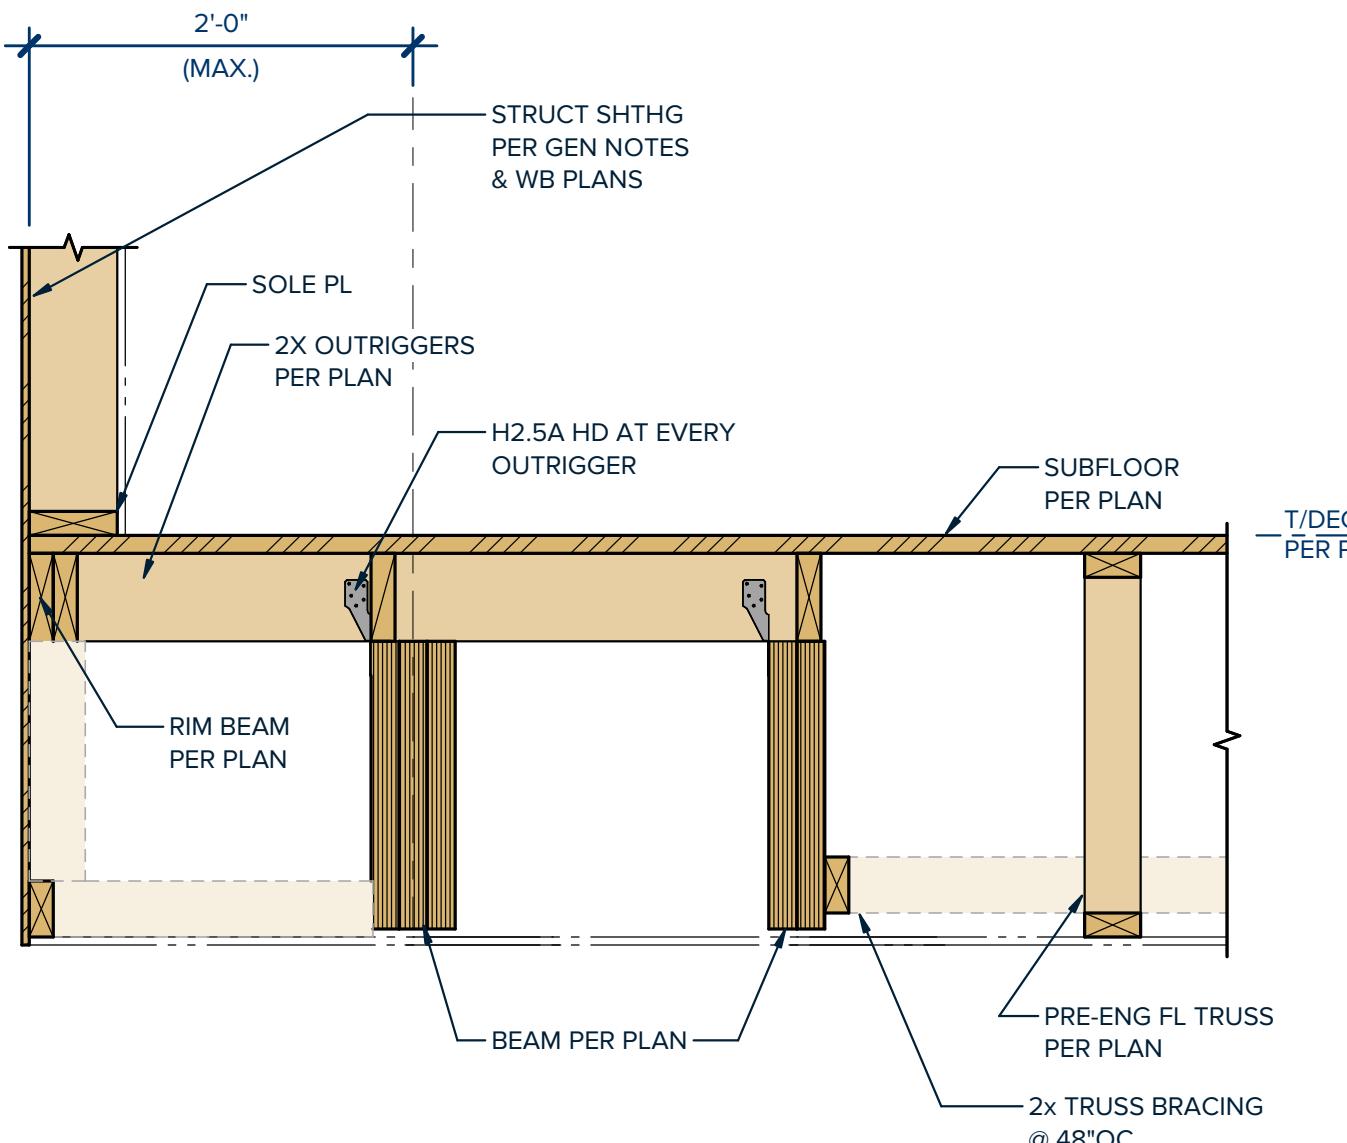


**01** FLOOR TRUSS, PARALLEL W/ LVL

SCALE : 1" = 1'-0"

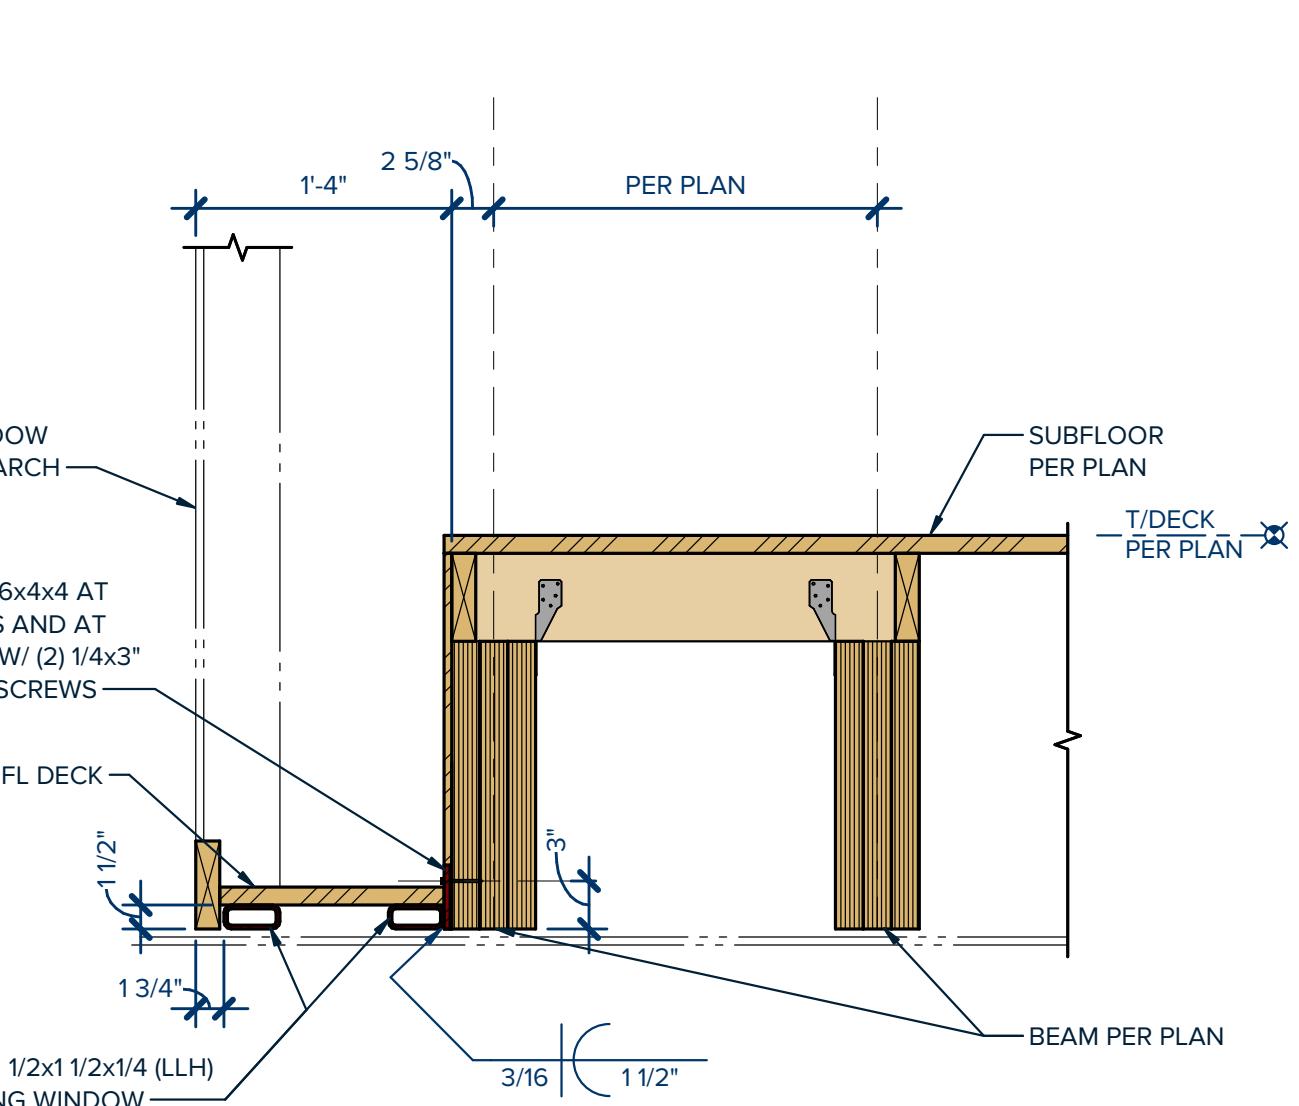


**02** FLOOR POCKET AT WINDOW

SCALE : 1" = 1'-0"

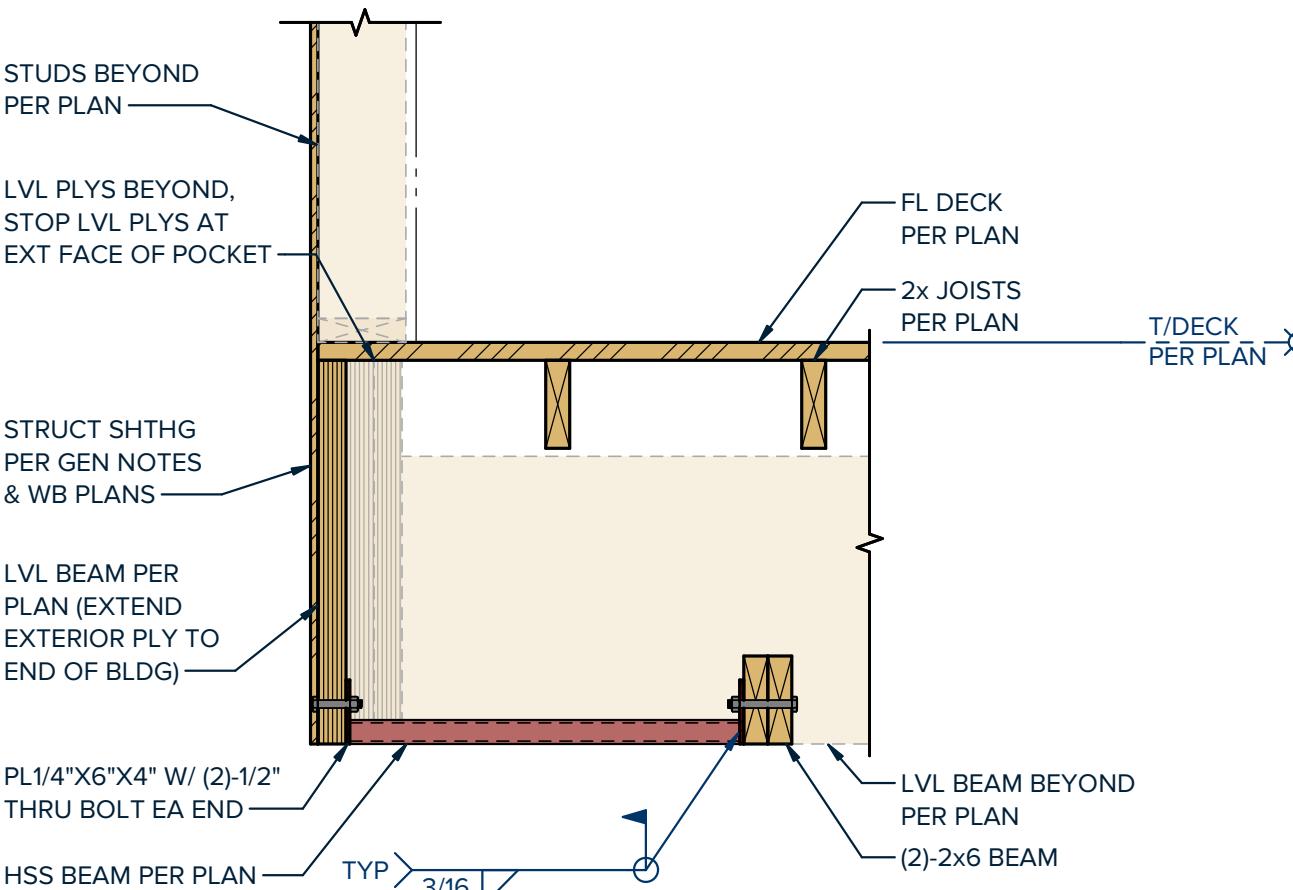

**03** FLOOR POCKET AT WINDOW

SCALE : 1" = 1'-0"

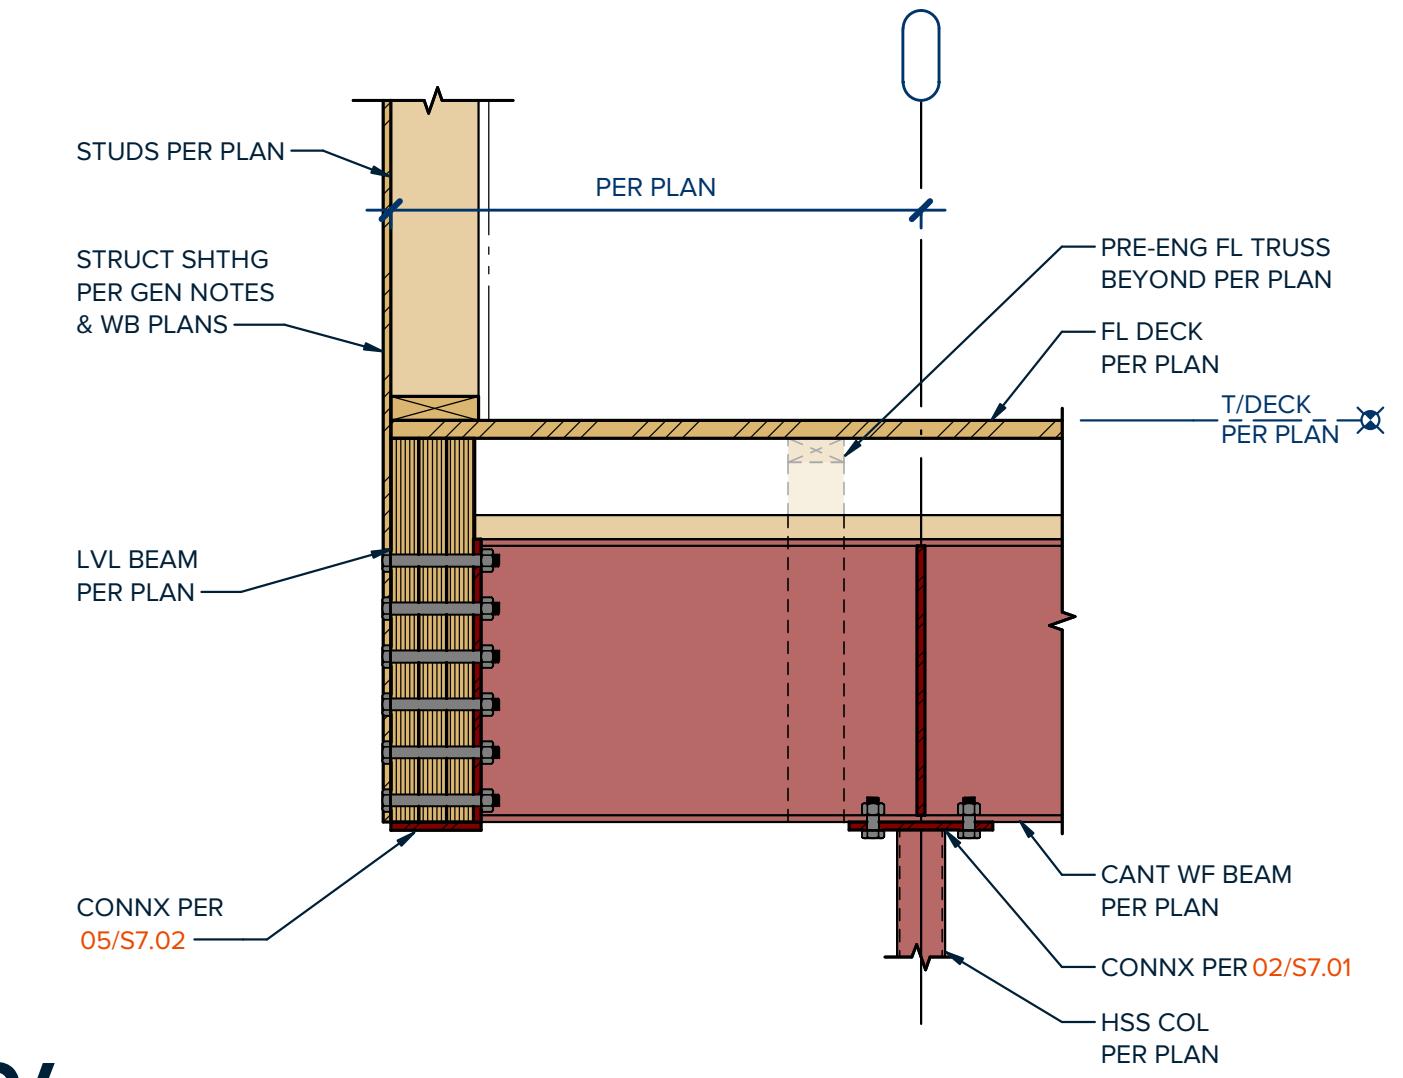

**04** LVL TO WF BEAM CONNECTION

SCALE : 1" = 1'-0"

| NO                 | ISSUE | DATE |
|--------------------|-------|------|
| PM: S. Young       |       |      |
| ENG: S. Young      |       |      |
| BIM PM: C Lawrence |       |      |
| QA/QC: S Covey     |       |      |

If printed on 22x34 or 24x36 sheet,  
the scale is as indicated.  
If printed on an 11x17 or 12x18  
sheet, the scale is reduced by half. SCALE

**WOOD FRAMING DETAILS**

SHEET TITLE

PERMIT DOCUMENTS

**S8.11**

SHEET NUMBER



# REScheck Software Version 4.7.2

# Compliance Certificate

Project 17363 E Reed Parks Rd.

Energy Code: **2015 IECC**  
Location: **Jonestown, Texas**  
Construction Type: **Single-family**  
Project Type: **New Construction**  
Conditioned Floor Area: **3,434 ft<sup>2</sup>**  
Glazing Area **36%**  
Climate Zone: **2 (1688 HDD)**  
Permit Date:  
Permit Number:

Construction Site:  
17363 E Reed Parks Rd.  
Jonestown, TX 78645

Owner/Agent:  
Alterstudio  
17363 E Reed Parks Rd.  
Jonestown, TX 78645

Designer/Contractor:  
TX

## Compliance: Passes using UA trade-off

Compliance: **7.8% Better Than Code**      Maximum UA: **930**      Your UA: **857**      Maximum SHGC: **0.25**      Your SHGC: **0.25**

The % Better or Worse Than Code Index reflects how close to compliance the house is based on code trade-off rules.  
It DOES NOT provide an estimate of energy use or cost relative to a minimum-code home.

NOTE: Slab-on-grade tradeoffs are no longer considered in the UA or performance compliance path in REScheck. Each slab-on-grade assembly in the specified climate zone must meet the minimum energy code insulation R-value and depth requirements.

## Envelope Assemblies

| Assembly                                                                                   | Gross Area or Perimeter | Cavity R-Value | Cont. R-Value | Prop. U-Factor | Req. U-Factor | Prop. UA | Req. UA |
|--------------------------------------------------------------------------------------------|-------------------------|----------------|---------------|----------------|---------------|----------|---------|
| Wall 1: Wood Frame, 16" o.c.                                                               | 427                     | 19.0           | 0.0           | 0.060          | 0.084         | 9        | 12      |
| Window 1: 2 glazing, clr low-e outr, argon gas, mtl /w brk frm mat, clr innr<br>SHGC: 0.25 | 138                     |                |               | 0.400          | 0.400         | 55       | 55      |
| Window 2: 2 glazing, clr low-e outr, argon gas, mtl /w brk frm mat, clr innr<br>SHGC: 0.25 | 48                      |                |               | 0.400          | 0.400         | 19       | 19      |
| Window 3: 2 glazing, clr low-e outr, argon gas, mtl /w brk frm mat, clr innr<br>SHGC: 0.25 | 49                      |                |               | 0.400          | 0.400         | 20       | 20      |
| Window 4: 2 glazing, clr low-e outr, argon gas, mtl /w brk frm mat, clr innr<br>SHGC: 0.25 | 50                      |                |               | 0.400          | 0.400         | 20       | 20      |
| Wall 2: Wood Frame, 16" o.c.                                                               | 400                     | 19.0           | 0.0           | 0.060          | 0.084         | 16       | 22      |
| Window 1: 2 glazing, clr low-e outr, argon gas, mtl /w brk frm mat, clr innr<br>SHGC: 0.25 | 138                     |                |               | 0.400          | 0.400         | 55       | 55      |
| Wall 3: Wood Frame, 16" o.c.                                                               | 234                     | 19.0           | 0.0           | 0.060          | 0.084         | 11       | 16      |
| Window 1: 2 glazing, clr low-e outr, argon gas, mtl /w brk frm mat, clr innr<br>SHGC: 0.25 | 43                      |                |               | 0.400          | 0.400         | 17       | 17      |

| Assembly                                                                                   | Gross Area or Perimeter | Cavity R-Value | Cont. R-Value | Prop. U-Factor | Req. U-Factor | Prop. UA | Req. UA |
|--------------------------------------------------------------------------------------------|-------------------------|----------------|---------------|----------------|---------------|----------|---------|
| Wall 4: Wood Frame, 16" o.c.                                                               | 278                     | 19.0           | 0.0           | 0.060          | 0.084         | 7        | 10      |
| Window 1: 2 glazing, clr low-e outr, argon gas, mtl /w brk frm mat, clr innr<br>SHGC: 0.25 | 22                      |                |               | 0.400          | 0.400         | 9        | 9       |
| Window 2: 2 glazing, clr low-e outr, argon gas, mtl /w brk frm mat, clr innr<br>SHGC: 0.25 | 94                      |                |               | 0.400          | 0.400         | 38       | 38      |
| Window 3: 2 glazing, clr low-e outr, argon gas, mtl /w brk frm mat, clr innr<br>SHGC: 0.25 | 40                      |                |               | 0.400          | 0.400         | 16       | 16      |
| Wall 5: Wood Frame, 16" o.c.                                                               | 45                      | 19.0           | 0.0           | 0.060          | 0.084         | 3        | 4       |
| Wall 6: Wood Frame, 16" o.c.                                                               | 483                     | 19.0           | 0.0           | 0.060          | 0.084         | 13       | 18      |
| Window 1: 2 glazing, clr low-e outr, argon gas, mtl /w brk frm mat, clr innr<br>SHGC: 0.25 | 10                      |                |               | 0.400          | 0.400         | 4        | 4       |
| Window 2: 2 glazing, clr low-e outr, argon gas, mtl /w brk frm mat, clr innr<br>SHGC: 0.25 | 173                     |                |               | 0.400          | 0.400         | 69       | 69      |
| Window 3: 2 glazing, clr low-e outr, argon gas, mtl /w brk frm mat, clr innr<br>SHGC: 0.25 | 49                      |                |               | 0.400          | 0.400         | 20       | 20      |
| Window 4: 2 glazing, clr low-e outr, argon gas, mtl /w brk frm mat, clr innr<br>SHGC: 0.25 | 38                      |                |               | 0.400          | 0.400         | 15       | 15      |
| Wall 7: Wood Frame, 16" o.c.                                                               | 721                     | 19.0           | 0.0           | 0.060          | 0.084         | 30       | 43      |
| Window 1: 2 glazing, clr low-e outr, argon gas, mtl /w brk frm mat, clr innr<br>SHGC: 0.25 | 67                      |                |               | 0.400          | 0.400         | 27       | 27      |
| Window 2: 2 glazing, clr low-e outr, argon gas, mtl /w brk frm mat, clr innr<br>SHGC: 0.25 | 26                      |                |               | 0.400          | 0.400         | 11       | 11      |
| Window 3: 2 glazing, clr low-e outr, argon gas, mtl /w brk frm mat, clr innr<br>SHGC: 0.25 | 54                      |                |               | 0.400          | 0.400         | 22       | 22      |
| Window 4: 2 glazing, clr low-e outr, argon gas, mtl /w brk frm mat, clr innr<br>SHGC: 0.25 | 36                      |                |               | 0.400          | 0.400         | 14       | 14      |
| Window 5: 2 glazing, clr low-e outr, argon gas, mtl /w brk frm mat, clr innr<br>SHGC: 0.25 | 32                      |                |               | 0.400          | 0.400         | 13       | 13      |
| Wall 8: Wood Frame, 16" o.c.                                                               | 209                     | 19.0           | 0.0           | 0.060          | 0.084         | 10       | 14      |
| Window 1: 2 glazing, clr low-e outr, argon gas, mtl /w brk frm mat, clr innr<br>SHGC: 0.25 | 10                      |                |               | 0.400          | 0.400         | 4        | 4       |
| Window 2: 2 glazing, clr low-e outr, argon gas, mtl /w brk frm mat, clr innr<br>SHGC: 0.25 | 28                      |                |               | 0.400          | 0.400         | 11       | 11      |
| Wall 9: Wood Frame, 16" o.c.                                                               | 198                     | 19.0           | 0.0           | 0.060          | 0.084         | 9        | 12      |
| Window 1: 2 glazing, clr low-e outr, argon gas, mtl /w brk frm mat, clr innr<br>SHGC: 0.25 | 54                      |                |               | 0.400          | 0.400         | 22       | 22      |
| Wall 10: Wood Frame, 16" o.c.                                                              | 55                      | 19.0           | 0.0           | 0.060          | 0.084         | 1        | 1       |
| Door 1: Solid                                                                              | 40                      |                |               | 0.390          | 0.400         | 16       | 16      |
| Wall 11: Wood Frame, 16" o.c.                                                              | 74                      | 19.0           | 0.0           | 0.060          | 0.084         | 4        | 6       |
| Wall 12: Wood Frame, 16" o.c.                                                              | 299                     | 19.0           | 0.0           | 0.060          | 0.084         | 10       | 14      |

| Assembly                                                                                     | Gross Area or Perimeter | Cavity R-Value | Cont. R-Value | Prop. U-Factor | Req. U-Factor | Prop. UA | Req. UA |
|----------------------------------------------------------------------------------------------|-------------------------|----------------|---------------|----------------|---------------|----------|---------|
| Window 1: 2 glazing, clr low-e outr, argon gas, mtl /w brk frm mat, clr innr<br>SHGC: 0.25   | 45                      |                |               | 0.400          | 0.400         | 18       | 18      |
| Window 2: 2 glazing, clr low-e outr, argon gas, mtl /w brk frm mat, clr innr<br>SHGC: 0.25   | 92                      |                |               | 0.400          | 0.400         | 37       | 37      |
| Wall 13: Wood Frame, 16" o.c.                                                                | 457                     | 19.0           | 0.0           | 0.060          | 0.084         | 23       | 32      |
| Window 1: 2 glazing, clr low-e outr, argon gas, mtl /w brk frm mat, clr innr<br>SHGC: 0.25   | 12                      |                |               | 0.400          | 0.400         | 5        | 5       |
| Window 2: 2 glazing, clr low-e outr, argon gas, mtl /w brk frm mat, clr innr<br>SHGC: 0.25   | 66                      |                |               | 0.400          | 0.400         | 26       | 26      |
| Wall 14: Wood Frame, 16" o.c.                                                                | 60                      | 19.0           | 0.0           | 0.060          | 0.084         | 4        | 5       |
| Floor 2: All-Wood Joist/Truss:Over Unconditioned Space                                       | 871                     | 13.0           | 0.0           | 0.064          | 0.064         | 56       | 56      |
| Floor 3: All-Wood Joist/Truss:Over Unconditioned Space                                       | 47                      | 13.0           | 0.0           | 0.064          | 0.064         | 3        | 3       |
| Floor 1: Slab-On-Grade:Unheated<br>Insulation depth: 0.5'                                    | 175                     |                | 0.0           | 1.042          | 0.064         | 0        | 0       |
| Ceiling 1: Cathedral Ceiling (no attic)                                                      | 2,176                   | 26.0           | 12.0          | 0.026          | 0.030         | 56       | 65      |
| Skylight 1: Sky glazing, small, r-6 or better curb, no shaft lgt shaft, vnl sa<br>SHGC: 0.25 | 21                      |                |               | 0.430          | 0.650         | 9        | 14      |

*Compliance Statement:* The proposed building design described here is consistent with the building plans, specifications, and other calculations submitted with the permit application. The proposed building has been designed to meet the 2015 IECC requirements in REScheck Version 4.7.2 and to comply with the mandatory requirements listed in the REScheck Inspection Checklist.

Andrew Pell

Name - Title

*Andrew Pell*

Signature

4/26/2023

Date

Project Notes:

Completed by - Andrew Pell, License # TACLA57315E



# Inspection Checklist

Energy Code: 2015 IECC

Requirements: 0.0% were addressed directly in the REScheck software

Text in the "Comments/Assumptions" column is provided by the user in the REScheck Requirements screen. For each requirement, the user certifies that a code requirement will be met and how that is documented, or that an exception is being claimed. Where compliance is itemized in a separate table, a reference to that table is provided.

| Section # & Req.ID                     | Pre-Inspection/Plan Review                                                                                                                                                                                               | Plans Verified Value | Field Verified Value | Complies?                                                                                                                                                    | Comments/Assumptions |
|----------------------------------------|--------------------------------------------------------------------------------------------------------------------------------------------------------------------------------------------------------------------------|----------------------|----------------------|--------------------------------------------------------------------------------------------------------------------------------------------------------------|----------------------|
| 103.1, 103.2 [PR1] <sup>1</sup>        | Construction drawings and documentation demonstrate energy code compliance for the building envelope. Thermal envelope represented on construction documents.                                                            |                      |                      | <input type="checkbox"/> Complies<br><input type="checkbox"/> Does Not<br><input type="checkbox"/> Not Observable<br><input type="checkbox"/> Not Applicable |                      |
| 103.1, 103.2, 403.7 [PR3] <sup>1</sup> | Construction drawings and documentation demonstrate energy code compliance for lighting and mechanical systems. Systems serving multiple dwelling units must demonstrate compliance with the IECC Commercial Provisions. |                      |                      | <input type="checkbox"/> Complies<br><input type="checkbox"/> Does Not<br><input type="checkbox"/> Not Observable<br><input type="checkbox"/> Not Applicable |                      |
| 302.1, 403.7 [PR2] <sup>2</sup>        | Heating and cooling equipment is sized per ACCA Manual S based on loads calculated per ACCA Manual J or other methods approved by the code official.                                                                     | Heating: Btu/hr_____ | Heating: Btu/hr_____ | <input type="checkbox"/> Complies<br><input type="checkbox"/> Does Not<br><input type="checkbox"/> Not Observable<br><input type="checkbox"/> Not Applicable |                      |

**Additional Comments/Assumptions:**

| Section # & Req.ID          | Foundation Inspection                                                                                                 | Plans Verified Value                                                           | Field Verified Value                                                           | Complies?                                                                                                                                                    | Comments/Assumptions                          |
|-----------------------------|-----------------------------------------------------------------------------------------------------------------------|--------------------------------------------------------------------------------|--------------------------------------------------------------------------------|--------------------------------------------------------------------------------------------------------------------------------------------------------------|-----------------------------------------------|
| 402.1.2 [FO1] <sup>1</sup>  | Slab edge insulation R-value.                                                                                         | R-____<br><input type="checkbox"/> Unheated<br><input type="checkbox"/> Heated | R-____<br><input type="checkbox"/> Unheated<br><input type="checkbox"/> Heated | <input type="checkbox"/> Complies<br><input type="checkbox"/> Does Not<br><input type="checkbox"/> Not Observable<br><input type="checkbox"/> Not Applicable | See the Envelope Assemblies table for values. |
| 402.1.2 [FO3] <sup>1</sup>  | Slab edge insulation depth/length.                                                                                    | ____ ft                                                                        | ____ ft                                                                        | <input type="checkbox"/> Complies<br><input type="checkbox"/> Does Not<br><input type="checkbox"/> Not Observable<br><input type="checkbox"/> Not Applicable | See the Envelope Assemblies table for values. |
| 303.2.1 [FO11] <sup>2</sup> | A protective covering is installed to protect exposed exterior insulation and extends a minimum of 6 in. below grade. |                                                                                |                                                                                | <input type="checkbox"/> Complies<br><input type="checkbox"/> Does Not<br><input type="checkbox"/> Not Observable<br><input type="checkbox"/> Not Applicable |                                               |
| 403.9 [FO12] <sup>2</sup>   | Snow- and ice-melting system controls installed.                                                                      |                                                                                |                                                                                | <input type="checkbox"/> Complies<br><input type="checkbox"/> Does Not<br><input type="checkbox"/> Not Observable<br><input type="checkbox"/> Not Applicable |                                               |

**Additional Comments/Assumptions:**

| Section # & Req.ID                                                                                                                      | Framing / Rough-In Inspection                                                                                                                                                                                                                                                             | Plans Verified Value | Field Verified Value | Complies?                                                                                                                                                    | Comments/Assumptions                          |
|-----------------------------------------------------------------------------------------------------------------------------------------|-------------------------------------------------------------------------------------------------------------------------------------------------------------------------------------------------------------------------------------------------------------------------------------------|----------------------|----------------------|--------------------------------------------------------------------------------------------------------------------------------------------------------------|-----------------------------------------------|
| 402.1.1, 402.3.4 [FR1] <sup>1</sup>                    | Door U-factor.                                                                                                                                                                                                                                                                            | U-_____              | U-_____              | <input type="checkbox"/> Complies<br><input type="checkbox"/> Does Not<br><input type="checkbox"/> Not Observable<br><input type="checkbox"/> Not Applicable | See the Envelope Assemblies table for values. |
| 402.1.1, 402.3.1, 402.3.3, 402.5 [FR2] <sup>1</sup>    | Glazing U-factor (area-weighted average).                                                                                                                                                                                                                                                 | U-_____              | U-_____              | <input type="checkbox"/> Complies<br><input type="checkbox"/> Does Not<br><input type="checkbox"/> Not Observable<br><input type="checkbox"/> Not Applicable | See the Envelope Assemblies table for values. |
| 402.1.1, 402.3.2, 402.3.3, 402.5 [FR3] <sup>1</sup>    | Glazing SHGC value (area-weighted average).                                                                                                                                                                                                                                               | SHGC:_____           | SHGC:_____           | <input type="checkbox"/> Complies<br><input type="checkbox"/> Does Not<br><input type="checkbox"/> Not Observable<br><input type="checkbox"/> Not Applicable | See the Envelope Assemblies table for values. |
| 303.1.3 [FR4] <sup>1</sup>                             | U-factors of fenestration products are determined in accordance with the NFRC test procedure or taken from the default table.                                                                                                                                                             |                      |                      | <input type="checkbox"/> Complies<br><input type="checkbox"/> Does Not<br><input type="checkbox"/> Not Observable<br><input type="checkbox"/> Not Applicable |                                               |
| 402.1.1, 402.3.3, 402.3.6, 402.5 [FR5] <sup>1</sup>    | Skylight U-factor.                                                                                                                                                                                                                                                                        | U-_____              | U-_____              | <input type="checkbox"/> Complies<br><input type="checkbox"/> Does Not<br><input type="checkbox"/> Not Observable<br><input type="checkbox"/> Not Applicable | See the Envelope Assemblies table for values. |
| 402.1.1, 402.3.3, 402.3.6, 402.5 [FR6] <sup>1</sup>  | Skylight SHGC value.                                                                                                                                                                                                                                                                      | SHGC:_____           | SHGC:_____           | <input type="checkbox"/> Complies<br><input type="checkbox"/> Does Not<br><input type="checkbox"/> Not Observable<br><input type="checkbox"/> Not Applicable | See the Envelope Assemblies table for values. |
| 303.1.3 [FR7] <sup>1</sup>                           | SHGC values are determined in accordance with the NFRC test procedure or taken from the default table.                                                                                                                                                                                    |                      |                      | <input type="checkbox"/> Complies<br><input type="checkbox"/> Does Not<br><input type="checkbox"/> Not Observable<br><input type="checkbox"/> Not Applicable |                                               |
| 402.4.1.1 [FR23] <sup>1</sup>                        | Air barrier and thermal barrier installed per manufacturer's instructions.                                                                                                                                                                                                                |                      |                      | <input type="checkbox"/> Complies<br><input type="checkbox"/> Does Not<br><input type="checkbox"/> Not Observable<br><input type="checkbox"/> Not Applicable |                                               |
| 402.4.3 [FR20] <sup>1</sup>                          | Fenestration that is not site built is listed and labeled as meeting AAMA /WDMA/CSA 101/I.S.2/A440 or has infiltration rates per NFRC 400 that do not exceed code limits.                                                                                                                 |                      |                      | <input type="checkbox"/> Complies<br><input type="checkbox"/> Does Not<br><input type="checkbox"/> Not Observable<br><input type="checkbox"/> Not Applicable |                                               |
| 402.4.5 [FR16] <sup>2</sup>                          | IC-rated recessed lighting fixtures sealed at housing/interior finish and labeled to indicate $\leq 2.0$ cfm leakage at 75 Pa.                                                                                                                                                            |                      |                      | <input type="checkbox"/> Complies<br><input type="checkbox"/> Does Not<br><input type="checkbox"/> Not Observable<br><input type="checkbox"/> Not Applicable |                                               |
| 403.3.1 [FR12] <sup>1</sup>                          | Supply and return ducts in attics insulated $\geq R-8$ where duct is $\geq 3$ inches in diameter and $\geq R-6$ where $< 3$ inches. Supply and return ducts in other portions of the building insulated $\geq R-6$ for diameter $\geq 3$ inches and $R-4.2$ for $< 3$ inches in diameter. |                      |                      | <input type="checkbox"/> Complies<br><input type="checkbox"/> Does Not<br><input type="checkbox"/> Not Observable<br><input type="checkbox"/> Not Applicable |                                               |

1 High Impact (Tier 1)

2 Medium Impact (Tier 2)

3 Low Impact (Tier 3)

| Section # & Req.ID          | Framing / Rough-In Inspection                                                                         | Plans Verified Value | Field Verified Value | Complies?                                                                                                                                                    | Comments/Assumptions |
|-----------------------------|-------------------------------------------------------------------------------------------------------|----------------------|----------------------|--------------------------------------------------------------------------------------------------------------------------------------------------------------|----------------------|
| 403.3.5 [FR15] <sup>3</sup> | Building cavities are not used as ducts or plenums.                                                   |                      |                      | <input type="checkbox"/> Complies<br><input type="checkbox"/> Does Not<br><input type="checkbox"/> Not Observable<br><input type="checkbox"/> Not Applicable |                      |
| 403.4 [FR17] <sup>2</sup>   | HVAC piping conveying fluids above 105 °F or chilled fluids below 55 °F are insulated to $\geq R-3$ . | R-____               | R-____               | <input type="checkbox"/> Complies<br><input type="checkbox"/> Does Not<br><input type="checkbox"/> Not Observable<br><input type="checkbox"/> Not Applicable |                      |
| 403.4.1 [FR24] <sup>1</sup> | Protection of insulation on HVAC piping.                                                              |                      |                      | <input type="checkbox"/> Complies<br><input type="checkbox"/> Does Not<br><input type="checkbox"/> Not Observable<br><input type="checkbox"/> Not Applicable |                      |
| 403.5.3 [FR18] <sup>2</sup> | Hot water pipes are insulated to $\geq R-3$ .                                                         | R-____               | R-____               | <input type="checkbox"/> Complies<br><input type="checkbox"/> Does Not<br><input type="checkbox"/> Not Observable<br><input type="checkbox"/> Not Applicable |                      |
| 403.6 [FR19] <sup>2</sup>   | Automatic or gravity dampers are installed on all outdoor air intakes and exhausts.                   |                      |                      | <input type="checkbox"/> Complies<br><input type="checkbox"/> Does Not<br><input type="checkbox"/> Not Observable<br><input type="checkbox"/> Not Applicable |                      |

**Additional Comments/Assumptions:**

| Section # & Req.ID                                                                                                                | Insulation Inspection                                                                                                                                                                                                                                                                                                                                             | Plans Verified Value                                                                                         | Field Verified Value                                                                                         | Complies?                                                                                                                                                    | Comments/Assumptions                          |
|-----------------------------------------------------------------------------------------------------------------------------------|-------------------------------------------------------------------------------------------------------------------------------------------------------------------------------------------------------------------------------------------------------------------------------------------------------------------------------------------------------------------|--------------------------------------------------------------------------------------------------------------|--------------------------------------------------------------------------------------------------------------|--------------------------------------------------------------------------------------------------------------------------------------------------------------|-----------------------------------------------|
| 303.1 [IN13] <sup>2</sup><br>                    | All installed insulation is labeled or the installed R-values provided.                                                                                                                                                                                                                                                                                           |                                                                                                              |                                                                                                              | <input type="checkbox"/> Complies<br><input type="checkbox"/> Does Not<br><input type="checkbox"/> Not Observable<br><input type="checkbox"/> Not Applicable |                                               |
| 402.1.1, 402.2.6 [IN1] <sup>1</sup><br>          | Floor insulation R-value.                                                                                                                                                                                                                                                                                                                                         | R- _____<br><input type="checkbox"/> Wood<br><input type="checkbox"/> Steel                                  | R- _____<br><input type="checkbox"/> Wood<br><input type="checkbox"/> Steel                                  | <input type="checkbox"/> Complies<br><input type="checkbox"/> Does Not<br><input type="checkbox"/> Not Observable<br><input type="checkbox"/> Not Applicable | See the Envelope Assemblies table for values. |
| 303.2, 402.2.7 [IN2] <sup>1</sup><br>            | Floor insulation installed per manufacturer's instructions and in substantial contact with the underside of the subfloor, or floor framing cavity insulation is in contact with the top side of sheathing, or continuous insulation is installed on the underside of floor framing and extends from the bottom to the top of all perimeter floor framing members. |                                                                                                              |                                                                                                              | <input type="checkbox"/> Complies<br><input type="checkbox"/> Does Not<br><input type="checkbox"/> Not Observable<br><input type="checkbox"/> Not Applicable |                                               |
| 402.1.1, 402.2.5, 402.2.6 [IN3] <sup>1</sup><br> | Wall insulation R-value. If this is a mass wall with at least ½ of the wall insulation on the wall exterior, the exterior insulation requirement applies (FR10).                                                                                                                                                                                                  | R- _____<br><input type="checkbox"/> Wood<br><input type="checkbox"/> Mass<br><input type="checkbox"/> Steel | R- _____<br><input type="checkbox"/> Wood<br><input type="checkbox"/> Mass<br><input type="checkbox"/> Steel | <input type="checkbox"/> Complies<br><input type="checkbox"/> Does Not<br><input type="checkbox"/> Not Observable<br><input type="checkbox"/> Not Applicable | See the Envelope Assemblies table for values. |
| 303.2 [IN4] <sup>1</sup>                                                                                                          | Wall insulation is installed per manufacturer's instructions.                                                                                                                                                                                                                                                                                                     |                                                                                                              |                                                                                                              | <input type="checkbox"/> Complies<br><input type="checkbox"/> Does Not<br><input type="checkbox"/> Not Observable<br><input type="checkbox"/> Not Applicable |                                               |

#### Additional Comments/Assumptions:

| Section # & Req.ID                                                | Final Inspection Provisions                                                                                                                                                                                                                                                                                                                                                                                                     | Plans Verified Value                                                      | Field Verified Value                                                      | Complies?                                                                                                                                                    | Comments/Assumptions                          |
|-------------------------------------------------------------------|---------------------------------------------------------------------------------------------------------------------------------------------------------------------------------------------------------------------------------------------------------------------------------------------------------------------------------------------------------------------------------------------------------------------------------|---------------------------------------------------------------------------|---------------------------------------------------------------------------|--------------------------------------------------------------------------------------------------------------------------------------------------------------|-----------------------------------------------|
| 402.1.1,<br>402.2.1,<br>402.2.2,<br>402.2.6<br>[FI1] <sup>1</sup> | Ceiling insulation R-value.                                                                                                                                                                                                                                                                                                                                                                                                     | R-____<br><input type="checkbox"/> Wood<br><input type="checkbox"/> Steel | R-____<br><input type="checkbox"/> Wood<br><input type="checkbox"/> Steel | <input type="checkbox"/> Complies<br><input type="checkbox"/> Does Not<br><input type="checkbox"/> Not Observable<br><input type="checkbox"/> Not Applicable | See the Envelope Assemblies table for values. |
| 303.1.1.1,<br>303.2<br>[FI2] <sup>1</sup>                         | Ceiling insulation installed per manufacturer's instructions. Blown insulation marked every 300 ft <sup>2</sup> .                                                                                                                                                                                                                                                                                                               |                                                                           |                                                                           | <input type="checkbox"/> Complies<br><input type="checkbox"/> Does Not<br><input type="checkbox"/> Not Observable<br><input type="checkbox"/> Not Applicable |                                               |
| 402.2.3<br>[FI22] <sup>2</sup>                                    | Vented attics with air permeable insulation include baffle adjacent to soffit and eave vents that extends over insulation.                                                                                                                                                                                                                                                                                                      |                                                                           |                                                                           | <input type="checkbox"/> Complies<br><input type="checkbox"/> Does Not<br><input type="checkbox"/> Not Observable<br><input type="checkbox"/> Not Applicable |                                               |
| 402.2.4<br>[FI3] <sup>1</sup>                                     | Attic access hatch and door insulation $\geq$ R-value of the adjacent assembly.                                                                                                                                                                                                                                                                                                                                                 | R-____                                                                    | R-____                                                                    | <input type="checkbox"/> Complies<br><input type="checkbox"/> Does Not<br><input type="checkbox"/> Not Observable<br><input type="checkbox"/> Not Applicable |                                               |
| 402.4.1.2<br>[FI17] <sup>1</sup>                                  | Blower door test @ 50 Pa. $\leq$ 5 ach in Climate Zones 1-2, and $\leq$ =3 ach in Climate Zones 3-8.                                                                                                                                                                                                                                                                                                                            | ACH 50 =____                                                              | ACH 50 =____                                                              | <input type="checkbox"/> Complies<br><input type="checkbox"/> Does Not<br><input type="checkbox"/> Not Observable<br><input type="checkbox"/> Not Applicable |                                               |
| 403.3.4<br>[FI4] <sup>1</sup>                                     | Duct tightness test result of $\leq$ 4 cfm/100 ft <sup>2</sup> across the system or $\leq$ =3 cfm/100 ft <sup>2</sup> without air handler @ 25 Pa. For rough-in tests, verification may need to occur during Framing Inspection.                                                                                                                                                                                                | ____ cfm/100 ft <sup>2</sup>                                              | ____ cfm/100 ft <sup>2</sup>                                              | <input type="checkbox"/> Complies<br><input type="checkbox"/> Does Not<br><input type="checkbox"/> Not Observable<br><input type="checkbox"/> Not Applicable |                                               |
| 403.3.3<br>[FI27] <sup>1</sup>                                    | Ducts are pressure tested to determine air leakage with either: Rough-in test: Total leakage measured with a pressure differential of 0.1 inch w.g. across the system including the manufacturer's air handler enclosure if installed at time of test. Postconstruction test: Total leakage measured with a pressure differential of 0.1 inch w.g. across the entire system including the manufacturer's air handler enclosure. | ____ cfm/100 ft <sup>2</sup>                                              | ____ cfm/100 ft <sup>2</sup>                                              | <input type="checkbox"/> Complies<br><input type="checkbox"/> Does Not<br><input type="checkbox"/> Not Observable<br><input type="checkbox"/> Not Applicable |                                               |
| 403.3.2.1<br>[FI24] <sup>1</sup>                                  | Air handler leakage designated by manufacturer at $\leq$ =2% of design air flow.                                                                                                                                                                                                                                                                                                                                                |                                                                           |                                                                           | <input type="checkbox"/> Complies<br><input type="checkbox"/> Does Not<br><input type="checkbox"/> Not Observable<br><input type="checkbox"/> Not Applicable |                                               |
| 403.1.1<br>[FI9] <sup>2</sup>                                     | Programmable thermostats installed for control of primary heating and cooling systems and initially set by manufacturer to code specifications.                                                                                                                                                                                                                                                                                 |                                                                           |                                                                           | <input type="checkbox"/> Complies<br><input type="checkbox"/> Does Not<br><input type="checkbox"/> Not Observable<br><input type="checkbox"/> Not Applicable |                                               |
| 403.1.2<br>[FI10] <sup>2</sup>                                    | Heat pump thermostat installed on heat pumps.                                                                                                                                                                                                                                                                                                                                                                                   |                                                                           |                                                                           | <input type="checkbox"/> Complies<br><input type="checkbox"/> Does Not<br><input type="checkbox"/> Not Observable<br><input type="checkbox"/> Not Applicable |                                               |
| 403.5.1<br>[FI11] <sup>2</sup>                                    | Circulating service hot water systems have automatic or accessible manual controls.                                                                                                                                                                                                                                                                                                                                             |                                                                           |                                                                           | <input type="checkbox"/> Complies<br><input type="checkbox"/> Does Not<br><input type="checkbox"/> Not Observable<br><input type="checkbox"/> Not Applicable |                                               |

1 High Impact (Tier 1)

2 Medium Impact (Tier 2)

3 Low Impact (Tier 3)

| Section # & Req.ID            | Final Inspection Provisions                                                                                                                                                                                                                                                                                                                                                                                                                                               | Plans Verified Value | Field Verified Value | Complies?                                                                                                                                                    | Comments/Assumptions |
|-------------------------------|---------------------------------------------------------------------------------------------------------------------------------------------------------------------------------------------------------------------------------------------------------------------------------------------------------------------------------------------------------------------------------------------------------------------------------------------------------------------------|----------------------|----------------------|--------------------------------------------------------------------------------------------------------------------------------------------------------------|----------------------|
| 403.6.1 [FI25] <sup>2</sup>   | All mechanical ventilation system fans not part of tested and listed HVAC equipment meet efficacy and air flow limits.                                                                                                                                                                                                                                                                                                                                                    |                      |                      | <input type="checkbox"/> Complies<br><input type="checkbox"/> Does Not<br><input type="checkbox"/> Not Observable<br><input type="checkbox"/> Not Applicable |                      |
| 403.2 [FI26] <sup>2</sup>     | Hot water boilers supplying heat through one- or two-pipe heating systems have outdoor setback control to lower boiler water temperature based on outdoor temperature.                                                                                                                                                                                                                                                                                                    |                      |                      | <input type="checkbox"/> Complies<br><input type="checkbox"/> Does Not<br><input type="checkbox"/> Not Observable<br><input type="checkbox"/> Not Applicable |                      |
| 403.5.1.1 [FI28] <sup>2</sup> | Heated water circulation systems have a circulation pump. The system return pipe is a dedicated return pipe or a cold water supply pipe. Gravity and thermos-syphon circulation systems are not present. Controls for circulating hot water system pumps start the pump with signal for hot water demand within the occupancy. Controls automatically turn off the pump when water is in circulation loop is at set-point temperature and no demand for hot water exists. |                      |                      | <input type="checkbox"/> Complies<br><input type="checkbox"/> Does Not<br><input type="checkbox"/> Not Observable<br><input type="checkbox"/> Not Applicable |                      |
| 403.5.1.2 [FI29] <sup>2</sup> | Electric heat trace systems comply with IEEE 515.1 or UL 515. Controls automatically adjust the energy input to the heat tracing to maintain the desired water temperature in the piping.                                                                                                                                                                                                                                                                                 |                      |                      | <input type="checkbox"/> Complies<br><input type="checkbox"/> Does Not<br><input type="checkbox"/> Not Observable<br><input type="checkbox"/> Not Applicable |                      |
| 403.5.2 [FI30] <sup>2</sup>   | Water distribution systems that have recirculation pumps that pump water from a heated water supply pipe back to the heated water source through a cold water supply pipe have a demand recirculation water system. Pumps have controls that manage operation of the pump and limit the temperature of the water entering the cold water piping to 104°F.                                                                                                                 |                      |                      | <input type="checkbox"/> Complies<br><input type="checkbox"/> Does Not<br><input type="checkbox"/> Not Observable<br><input type="checkbox"/> Not Applicable |                      |
| 403.5.4 [FI31] <sup>2</sup>   | Drain water heat recovery units tested in accordance with CSA B55.1. Potable water-side pressure loss of drain water heat recovery units < 3 psi for individual units connected to one or two showers. Potable water-side pressure loss of drain water heat recovery units < 2 psi for individual units connected to three or more showers.                                                                                                                               |                      |                      | <input type="checkbox"/> Complies<br><input type="checkbox"/> Does Not<br><input type="checkbox"/> Not Observable<br><input type="checkbox"/> Not Applicable |                      |
| 403.10.2 [FI12] <sup>3</sup>  | Readily accessible switch on heaters for swimming pools or permanent in-ground spas. Switch operation does not change heater thermostat setting. Heater circuit breaker is installed independent of switch. Gas-fired heaters equipped with ignition pilots that are not continuously burning pilots.                                                                                                                                                                     |                      |                      | <input type="checkbox"/> Complies<br><input type="checkbox"/> Does Not<br><input type="checkbox"/> Not Observable<br><input type="checkbox"/> Not Applicable |                      |

1 High Impact (Tier 1)

2 Medium Impact (Tier 2)

3 Low Impact (Tier 3)

| Section # & Req.ID           | Final Inspection Provisions                                                                                                       | Plans Verified Value | Field Verified Value | Complies?                                                                                                                                                    | Comments/Assumptions |
|------------------------------|-----------------------------------------------------------------------------------------------------------------------------------|----------------------|----------------------|--------------------------------------------------------------------------------------------------------------------------------------------------------------|----------------------|
| 403.10.3 [FI19] <sup>3</sup> | Timer switches or other automatic preset schedule control method are installed on heaters and pumps serving pools and permanent   |                      |                      | <input type="checkbox"/> Complies<br><input type="checkbox"/> Does Not<br><input type="checkbox"/> Not Observable<br><input type="checkbox"/> Not Applicable |                      |
| 403.10.4 [FI20] <sup>3</sup> | Outdoor heated pools and outdoor permanent spas have a vapor retardant cover.                                                     |                      |                      | <input type="checkbox"/> Complies<br><input type="checkbox"/> Does Not<br><input type="checkbox"/> Not Observable<br><input type="checkbox"/> Not Applicable |                      |
| 404.1 [FI6] <sup>1</sup>     | 75% of lamps in permanent fixtures or 75% of permanent fixtures have high efficacy lamps. Does not apply to low-voltage lighting. |                      |                      | <input type="checkbox"/> Complies<br><input type="checkbox"/> Does Not<br><input type="checkbox"/> Not Observable<br><input type="checkbox"/> Not Applicable |                      |
| 404.1.1 [FI23] <sup>3</sup>  | Fuel gas lighting systems have no continuous pilot light.                                                                         |                      |                      | <input type="checkbox"/> Complies<br><input type="checkbox"/> Does Not<br><input type="checkbox"/> Not Observable<br><input type="checkbox"/> Not Applicable |                      |
| 401.3 [FI7] <sup>2</sup>     | Compliance certificate posted.                                                                                                    |                      |                      | <input type="checkbox"/> Complies<br><input type="checkbox"/> Does Not<br><input type="checkbox"/> Not Observable<br><input type="checkbox"/> Not Applicable |                      |
| 303.3 [FI18] <sup>3</sup>    | Manufacturer manuals for mechanical and water heating systems have been provided.                                                 |                      |                      | <input type="checkbox"/> Complies<br><input type="checkbox"/> Does Not<br><input type="checkbox"/> Not Observable<br><input type="checkbox"/> Not Applicable |                      |

**Additional Comments/Assumptions:**



# 2015 IECC Energy Efficiency Certificate

| Insulation Rating | R-Value |
|-------------------|---------|
|-------------------|---------|

**Above-Grade Wall** **19.00**

**Below-Grade Wall** **0.00**

**Floor** **13.00**

**Ceiling / Roof** **38.00**

**Ductwork (unconditioned spaces):** \_\_\_\_\_

| Glass & Door Rating | U-Factor | SHGC |
|---------------------|----------|------|
|---------------------|----------|------|

**Window** **0.40** **0.25**

**Door** **0.39**

**Skylight** **0.43** **0.25**

| Heating & Cooling Equipment | Efficiency |
|-----------------------------|------------|
|-----------------------------|------------|

**Heating System:** \_\_\_\_\_

**Cooling System:** \_\_\_\_\_

**Water Heater:** \_\_\_\_\_

**Name:** \_\_\_\_\_ **Date:** \_\_\_\_\_

**Comments**



# Project Summary

## Unit 1: Down

### Fresh Air HVAC Sizing

Job: 17363 E Reed Parks Rd.  
 Date: May 21, 2023  
 By: Coby Sackett

Austin, TX Phone: (512) 814-7638 Email: Info@HVAC-Sizing.com Web: www.HVAC-Sizing.com License: TACLA57315E

## Project Information

For: Alterstudio  
 17363 E Reed Parks Rd., Jonestown, TX 78645

Notes: The report we provide is only as good as the information we receive.  
 Please review all load calculations and reports you receive from us for accuracy.  
 It is ultimately the HVAC contractor who is responsible for the equipment they install.  
 Texas Department of Licensing and Regulation Number TACLA57315E

## Design Information

Weather: Georgetown Municipal, TX, US

### Winter Design Conditions

|            |    |    |
|------------|----|----|
| Outside db | 28 | °F |
| Inside db  | 72 | °F |
| Design TD  | 44 | °F |

|                     |     |       |
|---------------------|-----|-------|
| Outside db          | 100 | °F    |
| Inside db           | 72  | °F    |
| Design TD           | 28  | °F    |
| Daily range         | M   |       |
| Relative humidity   | 50  | %     |
| Moisture difference | 21  | gr/lb |

### Heating Summary

|                          |       |      |
|--------------------------|-------|------|
| Structure                | 28353 | Btuh |
| Ducts                    | 0     | Btuh |
| Central vent (43 cfm)    | 2004  | Btuh |
| Ventilating dehumidifier |       |      |
| Humidification           | 0     | Btuh |
| Piping                   | 0     | Btuh |
| Equipment load           | 30357 | Btuh |

### Infiltration

|                      |                        |
|----------------------|------------------------|
| Method               | Blower door            |
| Shielding / stories  | 3 (partial) / 2        |
| Pressure / ACH / AVF | 50 Pa / 3.5 / 1876 cfm |

|                           | Heating | Cooling |
|---------------------------|---------|---------|
| Area (ft <sup>2</sup> )   | 1260    | 1260    |
| Volume (ft <sup>3</sup> ) | 12601   | 12601   |
| Air changes/hour          | 0.39    | 0.25    |
| Equiv. AVF (cfm)          | 82      | 52      |

### Heating Equipment Summary

|                        |                   |
|------------------------|-------------------|
| Make                   | American Standard |
| Trade                  | AMERICAN STANDARD |
| Model                  | 4A6V0X36A1        |
| AHRI ref               | 210929576         |
| Efficiency             | 8.7 HSPF2         |
| Heating input          |                   |
| Heating output         | 31600 Btuh @ 47°F |
| Temperature rise       | 37 °F             |
| Actual air flow        | 800 cfm           |
| Air flow factor        | 0.028 cfm/Btuh    |
| Static pressure        | 0.70 in H2O       |
| Space thermostat       |                   |
| Capacity balance point | = 24 °F           |

Backup: American Standard AFUE 100  
 Input = 10 kW, Output = 34120 Btuh, 100 AFUE

### Summer Design Conditions

|                     |     |       |
|---------------------|-----|-------|
| Outside db          | 100 | °F    |
| Inside db           | 72  | °F    |
| Design TD           | 28  | °F    |
| Daily range         | M   |       |
| Relative humidity   | 50  | %     |
| Moisture difference | 21  | gr/lb |

### Sensible Cooling Equipment Load Sizing

|                          |       |      |
|--------------------------|-------|------|
| Structure                | 23266 | Btuh |
| Ducts                    | 0     | Btuh |
| Central vent (43 cfm)    | 1958  | Btuh |
| Ventilating dehumidifier |       |      |
| Blower                   | 0     | Btuh |
| Use manufacturer's data  |       |      |
| Rate/swing multiplier    | 1.00  | y    |
| Equipment sensible load  | 25224 | Btuh |

### Latent Cooling Equipment Load Sizing

|                                       |              |      |
|---------------------------------------|--------------|------|
| Structure                             | 1530         | Btuh |
| Ducts                                 | 0            | Btuh |
| Central vent (43 cfm)                 | 175          | Btuh |
| Ventilating dehumidifier              |              |      |
| Equipment latent load                 | 1705         | Btuh |
| <b>Equipment Total Load (Sen+Lat)</b> | <b>26930</b> | Btuh |
| Req. total capacity at 0.85 SHR       | 2.5          | ton  |

### Cooling Equipment Summary

|                          |                      |
|--------------------------|----------------------|
| Make                     | American Standard    |
| Trade                    | AMERICAN STANDARD    |
| Cond                     | 4A6V0X36A1           |
| Coil                     | TAMXB0C36V31         |
| AHRI ref                 | 210929576            |
| Efficiency               | 12.7 EER2,19.5 SEER2 |
| Sensible cooling         | 24500 Btuh           |
| Latent cooling           | 10500 Btuh           |
| Total cooling            | 35000 Btuh           |
| Actual air flow          | 1080 cfm             |
| Air flow factor          | 0.046 cfm/Btuh       |
| Static pressure          | 0.70 in H2O          |
| Load sensible heat ratio | 0.94                 |

Calculations approved by ACCA to meet all requirements of Manual J 8th Ed.



A Mitek® / Berkshire Hathaway Company

Right-Suite® Universal 2023 23.0.01 RSU20313

...7363 E Reed Parks Rd. HVAC Design (5-10-23).rpu Calc = MJ8 House Front faces: NW

2023-May-29 14:47:09

Page 1



# Project Summary

## Unit 2: Upstairs

### Fresh Air HVAC Sizing

Job: 17363 E Reed Parks Rd.  
 Date: May 21, 2023  
 By: Coby Sackett

Austin, TX Phone: (512) 814-7638 Email: Info@HVAC-Sizing.com Web: www.HVAC-Sizing.com License: TACLA57315E

## Project Information

For: Alterstudio  
 17363 E Reed Parks Rd., Jonestown, TX 78645

Notes: The report we provide is only as good as the information we receive.  
 Please review all load calculations and reports you receive from us for accuracy.  
 It is ultimately the HVAC contractor who is responsible for the equipment they install.  
 Texas Department of Licensing and Regulation Number TACLA57315E

## Design Information

Weather: Georgetown Municipal, TX, US

### Winter Design Conditions

|            |    |    |
|------------|----|----|
| Outside db | 28 | °F |
| Inside db  | 72 | °F |
| Design TD  | 44 | °F |

|                     |     |       |
|---------------------|-----|-------|
| Outside db          | 100 | °F    |
| Inside db           | 72  | °F    |
| Design TD           | 28  | °F    |
| Daily range         | M   |       |
| Relative humidity   | 50  | %     |
| Moisture difference | 21  | gr/lb |

### Heating Summary

|                          |       |      |
|--------------------------|-------|------|
| Structure                | 28069 | Btuh |
| Ducts                    | 0     | Btuh |
| Central vent (67 cfm)    | 3140  | Btuh |
| Ventilating dehumidifier |       |      |
| Humidification           | 0     | Btuh |
| Piping                   | 0     | Btuh |
| Equipment load           | 31210 | Btuh |

### Infiltration

|                           |                        |         |
|---------------------------|------------------------|---------|
| Method                    | Blower door            |         |
| Shielding / stories       | 3 (partial) / 2        |         |
| Pressure / ACH / AVF      | 50 Pa / 3.5 / 1876 cfm |         |
|                           |                        |         |
| Area (ft <sup>2</sup> )   | Heating                | Cooling |
| Volume (ft <sup>3</sup> ) | 2176                   | 2176    |
| Air changes/hour          | 19582                  | 19582   |
| Equiv. AVF (cfm)          | 0.31                   | 0.20    |
|                           | 102                    | 65      |

### Heating Equipment Summary

|                          |                   |
|--------------------------|-------------------|
| Make                     | American Standard |
| Trade                    | AMERICAN STANDARD |
| Model                    | 4A6V0X48A1        |
| AHRI ref                 | 207690050         |
| Efficiency               | 10 HSPF           |
| Heating input            |                   |
| Heating output           | 42500 Btuh @ 47°F |
| Temperature rise         | 40 °F             |
| Actual air flow          | 1000 cfm          |
| Air flow factor          | 0.036 cfm/Btuh    |
| Static pressure          | 0.70 in H2O       |
| Space thermostat         |                   |
| Capacity balance point = | 14 °F             |

Backup: American Standard AFUE 100  
 Input = 10 kW, Output = 34120 Btuh, 100 AFUE

### Summer Design Conditions

|                     |     |       |
|---------------------|-----|-------|
| Outside db          | 100 | °F    |
| Inside db           | 72  | °F    |
| Design TD           | 28  | °F    |
| Daily range         | M   |       |
| Relative humidity   | 50  | %     |
| Moisture difference | 21  | gr/lb |

### Sensible Cooling Equipment Load Sizing

|                          |       |      |
|--------------------------|-------|------|
| Structure                | 33175 | Btuh |
| Ducts                    | 0     | Btuh |
| Central vent (67 cfm)    | 3069  | Btuh |
| Ventilating dehumidifier |       |      |
| Blower                   | 0     | Btuh |
| Use manufacturer's data  | y     |      |
| Rate/swing multiplier    | 1.00  |      |
| Equipment sensible load  | 36244 | Btuh |

### Latent Cooling Equipment Load Sizing

|                                       |       |      |
|---------------------------------------|-------|------|
| Structure                             | 2112  | Btuh |
| Ducts                                 | 0     | Btuh |
| Central vent (67 cfm)                 | 275   | Btuh |
| Ventilating dehumidifier              |       |      |
| Equipment latent load                 | 2386  | Btuh |
| <b>Equipment Total Load (Sen+Lat)</b> | 38631 | Btuh |
| Req. total capacity at 0.85 SHR       | 3.6   | ton  |

### Cooling Equipment Summary

|                          |                      |
|--------------------------|----------------------|
| Make                     | American Standard    |
| Trade                    | AMERICAN STANDARD    |
| Cond                     | 4A6V0X48A1           |
| Coil                     | TAMXA0C48V41         |
| AHRI ref                 | 207690050            |
| Efficiency               | 12.5 EER, 19.25 SEER |
| Sensible cooling         | 35250 Btuh           |
| Latent cooling           | 11750 Btuh           |
| Total cooling            | 47000 Btuh           |
| Actual air flow          | 1440 cfm             |
| Air flow factor          | 0.043 cfm/Btuh       |
| Static pressure          | 0.70 in H2O          |
| Load sensible heat ratio | 0.94                 |

Calculations approved by ACCA to meet all requirements of Manual J 8th Ed.



A Mitek® / Berkshire Hathaway Company

Right-Suite® Universal 2023 23.0.01 RSU20313

...7363 E Reed Parks Rd. HVAC Design (5-10-23).rpu Calc = MJ8 House Front faces: NW

2023-May-29 14:47:09

Page 2

Austin, TX Phone: (512) 814-7638 Email: Info@HVAC-Sizing.com Web: www.HVAC-Sizing.com License: TACLA57315E

## Project Information

For: Alterstudio  
17363 E Reed Parks Rd., Jonestown, TX 78645

## Design Information

|                             | Htg | Clg | Infiltration        |                        |
|-----------------------------|-----|-----|---------------------|------------------------|
| Outside db (°F)             | 28  | 100 | Method              | Blower door            |
| Inside db (°F)              | 72  | 72  | Shielding / stories | 3 (partial) / 2        |
| Design TD (°F)              | 44  | 28  | Pressure /ACH /AVF  | 50 Pa / 3.5 / 1876 cfm |
| Daily range                 | -   | M   |                     |                        |
| Inside humidity (%)         | 30  | 50  |                     |                        |
| Moisture difference (gr/lb) | 18  | 21  |                     |                        |

## HEATING EQUIPMENT

|                        |                   |
|------------------------|-------------------|
| Make                   | American Standard |
| Trade                  | AMERICAN STANDARD |
| Model                  | 4A6V0X36A1        |
| AHRI ref               | 210929576         |
| Efficiency             | 8.7 HSPF2         |
| Heating input          |                   |
| Heating output         | 31600 Btuh @ 47°F |
| Temperature rise       | 37 °F             |
| Actual air flow        | 800 cfm           |
| Air flow factor        | 0.028 cfm/Btuh    |
| Static pressure        | 0.70 in H2O       |
| Space thermostat       |                   |
| Capacity balance point | = 24 °F           |

Backup: American Standard AFUE 100

Input = 10 kW, Output = 34120 Btuh, 100 AFUE

## COOLING EQUIPMENT

|                          |                      |
|--------------------------|----------------------|
| Make                     | American Standard    |
| Trade                    | AMERICAN STANDARD    |
| Cond                     | 4A6V0X36A1           |
| Coil                     | TAMXB0C36V31         |
| AHRI ref                 | 210929576            |
| Efficiency               | 12.7 EER2,19.5 SEER2 |
| Sensible cooling         | 24500 Btuh           |
| Latent cooling           | 10500 Btuh           |
| Total cooling            | 35000 Btuh           |
| Actual air flow          | 1080 cfm             |
| Air flow factor          | 0.046 cfm/Btuh       |
| Static pressure          | 0.70 in H2O          |
| Load sensible heat ratio | 0.94                 |

Backup: American Standard AFUE 100

Input = 10 kW, Output = 34120 Btuh, 100 AFUE

| ROOM NAME      | Area (ft <sup>2</sup> ) | Htg load (Btuh) | Clg load (Btuh) | Htg AVF (cfm) | Clg AVF (cfm) |
|----------------|-------------------------|-----------------|-----------------|---------------|---------------|
| Kitchen/Dining | 456                     | 9124            | 10046           | 257           | 466           |
| Living         | 522                     | 14663           | 11069           | 414           | 514           |
| Mud            | 85                      | 1443            | 776             | 41            | 36            |
| Pantry         | 66                      | 1565            | 924             | 44            | 43            |
| Pwdr           | 47                      | 1558            | 451             | 44            | 21            |
| Stairs 1       | 35                      | 0               | 0               | 0             | 0             |
| Storage        | 49                      | 0               | 0               | 0             | 0             |

Calculations approved by ACCA to meet all requirements of Manual J 8th Ed.

|                                                                          |      |               |                                |     |      |
|--------------------------------------------------------------------------|------|---------------|--------------------------------|-----|------|
| Unit 1: Down<br>Other equip loads<br>Equip. @ 1.00 RSM<br>Latent cooling | 1260 | 28353<br>2004 | 23266<br>1958<br>25224<br>1705 | 800 | 1080 |
| TOTALS                                                                   | 1260 | 30357         | 26930                          | 800 | 1080 |

Calculations approved by ACCA to meet all requirements of Manual J 8th Ed.

## Project Information

For: Alterstudio  
17363 E Reed Parks Rd., Jonestown, TX 78645

## Design Information

|                             | Htg | Clg | Infiltration        |                        |
|-----------------------------|-----|-----|---------------------|------------------------|
| Outside db (°F)             | 28  | 100 | Method              | Blower door            |
| Inside db (°F)              | 72  | 72  | Shielding / stories | 3 (partial) / 2        |
| Design TD (°F)              | 44  | 28  | Pressure /ACH /AVF  | 50 Pa / 3.5 / 1876 cfm |
| Daily range                 | -   | M   |                     |                        |
| Inside humidity (%)         | 30  | 50  |                     |                        |
| Moisture difference (gr/lb) | 18  | 21  |                     |                        |

## HEATING EQUIPMENT

|                        |                   |
|------------------------|-------------------|
| Make                   | American Standard |
| Trade                  | AMERICAN STANDARD |
| Model                  | 4A6V0X48A1        |
| AHRI ref               | 207690050         |
| Efficiency             | 10 HSPF           |
| Heating input          |                   |
| Heating output         | 42500 Btuh @ 47°F |
| Temperature rise       | 40 °F             |
| Actual air flow        | 1000 cfm          |
| Air flow factor        | 0.036 cfm/Btuh    |
| Static pressure        | 0.70 in H2O       |
| Space thermostat       |                   |
| Capacity balance point | = 14 °F           |

Backup: American Standard AFUE 100  
Input = 10 kW, Output = 34120 Btuh, 100 AFUE

## COOLING EQUIPMENT

|                          |                      |
|--------------------------|----------------------|
| Make                     | American Standard    |
| Trade                    | AMERICAN STANDARD    |
| Cond                     | 4A6V0X48A1           |
| Coil                     | TAMXA0C48V41         |
| AHRI ref                 | 207690050            |
| Efficiency               | 12.5 EER, 19.25 SEER |
| Sensible cooling         | 35250 Btuh           |
| Latent cooling           | 11750 Btuh           |
| Total cooling            | 47000 Btuh           |
| Actual air flow          | 1440 cfm             |
| Air flow factor          | 0.043 cfm/Btuh       |
| Static pressure          | 0.70 in H2O          |
| Load sensible heat ratio | 0.94                 |

| ROOM NAME   | Area (ft <sup>2</sup> ) | Htg load (Btuh) | Clg load (Btuh) | Htg AVF (cfm) | Clg AVF (cfm) |
|-------------|-------------------------|-----------------|-----------------|---------------|---------------|
| Bath 1      | 71                      | 1140            | 658             | 41            | 29            |
| Bath 2      | 78                      | 706             | 423             | 25            | 18            |
| Bed 1       | 181                     | 3126            | 2949            | 111           | 128           |
| Bed 2       | 219                     | 2989            | 3453            | 106           | 150           |
| Clst 2      | 36                      | 0               | 0               | 0             | 0             |
| Craft       | 74                      | 1037            | 1497            | 37            | 65            |
| Kitchenette | 94                      | 304             | 954             | 11            | 41            |
| Laundry     | 92                      | 1250            | 2221            | 45            | 96            |
| M. Bath     | 168                     | 2708            | 2539            | 96            | 110           |
| M. WC       | 33                      | 1287            | 1418            | 46            | 62            |
| M. WIC      | 196                     | 1675            | 1729            | 60            | 75            |
| Master Bed  | 279                     | 3919            | 5046            | 140           | 219           |
| Mech/Server | 102                     | 0               | 0               | 0             | 0             |
| Office 1    | 75                      | 1568            | 3692            | 56            | 160           |

Calculations approved by ACCA to meet all requirements of Manual J 8th Ed.

|                   |      |       |       |      |      |
|-------------------|------|-------|-------|------|------|
| Office 2          | 50   | 1331  | 2325  | 47   | 101  |
| Stairs 2          | 381  | 4425  | 3920  | 158  | 170  |
| WIC 1             | 45   | 604   | 352   | 22   | 15   |
|                   |      |       |       |      |      |
| Unit 2: Upstairs  | 2176 | 28069 | 33175 | 1000 | 1440 |
| Other equip loads |      | 3140  | 3069  |      |      |
| Equip. @ 1.00 RSM |      |       | 36244 |      |      |
| Latent cooling    |      |       | 2386  |      |      |
| TOTALS            | 2176 | 31210 | 38631 | 1000 | 1440 |

Calculations approved by ACCA to meet all requirements of Manual J 8th Ed.

## Fresh Air HVAC Sizing

Austin, TX Phone: (512) 814-7638 Email: Info@HVAC-Sizing.com Web: www.HVAC-Sizing.com License: TACLA57315E

### Infiltration Summary

| ZONE NAME        | Heating                   |      |            |                             | Cooling                   |      |            |                             |
|------------------|---------------------------|------|------------|-----------------------------|---------------------------|------|------------|-----------------------------|
|                  | Volume<br>ft <sup>3</sup> | ACH  | AVF<br>cfm | HTM<br>Btuh/ft <sup>2</sup> | Volume<br>ft <sup>3</sup> | ACH  | AVF<br>cfm | HTM<br>Btuh/ft <sup>2</sup> |
| Unit 1: Down     | 12601                     | 0.39 | 82         | 2.2                         | 12601                     | 0.25 | 52         | 0.9                         |
| Unit 2: Upstairs | 19582                     | 0.31 | 102        | 2.2                         | 19582                     | 0.20 | 65         | 0.9                         |
| Entire House     | 32183                     | 0.34 | 183        | 2.2                         | 32183                     | 0.22 | 117        | 0.9                         |

### Load and AVF Summary

| ROOM NAME        | Area<br>ft <sup>2</sup> | Htg load<br>Btuh | Clg load<br>Btuh | Htg AVF<br>cfm | Clg AVF<br>cfm |
|------------------|-------------------------|------------------|------------------|----------------|----------------|
| Kitchen/Dining   | 456                     | 9124             | 10046            | 257            | 466            |
| Living           | 522                     | 14663            | 11069            | 414            | 514            |
| Mud              | 85                      | 1443             | 776              | 41             | 36             |
| Pantry           | 66                      | 1565             | 924              | 44             | 43             |
| Pwdr             | 47                      | 1558             | 451              | 44             | 21             |
| Stairs 1         | 35                      | 0                | 0                | 0              | 0              |
| Storage          | 49                      | 0                | 0                | 0              | 0              |
| Unit 1: Down     | 1260                    | 28353            | 23266            | 800            | 1080           |
| Bath 1           | 71                      | 1140             | 658              | 41             | 29             |
| Bath 2           | 78                      | 706              | 423              | 25             | 18             |
| Bed 1            | 181                     | 3126             | 2949             | 111            | 128            |
| Bed 2            | 219                     | 2989             | 3453             | 106            | 150            |
| Clst 2           | 36                      | 0                | 0                | 0              | 0              |
| Craft            | 74                      | 1037             | 1497             | 37             | 65             |
| Kitchenette      | 94                      | 304              | 954              | 11             | 41             |
| Laundry          | 92                      | 1250             | 2221             | 45             | 96             |
| M. Bath          | 168                     | 2708             | 2539             | 96             | 110            |
| M. WC            | 33                      | 1287             | 1418             | 46             | 62             |
| M. WIC           | 196                     | 1675             | 1729             | 60             | 75             |
| Master Bed       | 279                     | 3919             | 5046             | 140            | 219            |
| Mech/Server      | 102                     | 0                | 0                | 0              | 0              |
| Office 1         | 75                      | 1568             | 3692             | 56             | 160            |
| Office 2         | 50                      | 1331             | 2325             | 47             | 101            |
| Stairs 2         | 381                     | 4425             | 3920             | 158            | 170            |
| WIC 1            | 45                      | 604              | 352              | 22             | 15             |
| Unit 2: Upstairs | 2176                    | 28069            | 33175            | 1000           | 1440           |
| Entire House     | 3436                    | 56422            | 56442            | 1800           | 2520           |

## Project Information

For: Alterstudio  
 17363 E Reed Parks Rd., Jonestown, TX 78645

## Design Conditions

### Location:

Georgetown Municipal, TX, US  
 Elevation: 787 ft  
 Latitude: 31°N

### Indoor:

Indoor temperature (°F)  
 Design TD (°F)  
 Relative humidity (%)  
 Moisture difference (gr/lb)

### Heating

### Cooling

72  
 44  
 30  
 17.6

72  
 28  
 50  
 21.2

### Outdoor:

|                  | Heating | Cooling |
|------------------|---------|---------|
| Dry bulb (°F)    | 28      | 100     |
| Daily range (°F) | -       | 22 (M)  |
| Wet bulb (°F)    | -       | 73      |
| Wind speed (mph) | 15.0    | 7.5     |

### Infiltration:


Method  
 Shielding / stories  
 Pressure / ACH / AVF

### Blower door

3 (partial) / 2  
 50 Pa / 3.5 / 1876 cfm


## Heating

| Component      | Btuh/ft <sup>2</sup> | Btuh         | % of load    |
|----------------|----------------------|--------------|--------------|
| Walls          | 3.0                  | 2790         | 9.2          |
| Glazing        | 17.5                 | 13512        | 44.5         |
| Doors          | 17.0                 | 682          | 2.2          |
| Ceilings       | 0                    | 0            | 0            |
| Floors         | 6.0                  | 7560         | 24.9         |
| Infiltration   | 2.2                  | 3809         | 12.5         |
| Ducts          |                      | 0            | 0            |
| Piping         |                      | 0            | 0            |
| Humidification |                      | 0            | 0            |
| Ventilation    |                      | 2004         | 6.6          |
| Adjustments    |                      | 0            | 0            |
| <b>Total</b>   |                      | <b>30357</b> | <b>100.0</b> |

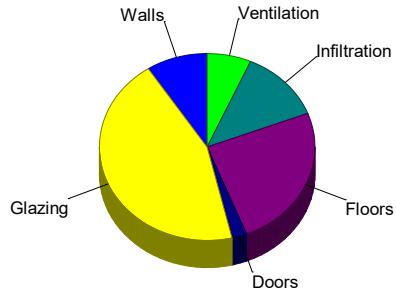

## Cooling

| Component      | Btuh/ft <sup>2</sup> | Btuh         | % of load    |
|----------------|----------------------|--------------|--------------|
| Walls          | 2.0                  | 1887         | 7.5          |
| Glazing        | 20.5                 | 15865        | 62.9         |
| Doors          | 10.9                 | 436          | 1.7          |
| Ceilings       | 0                    | 0            | 0            |
| Floors         | 0                    | 0            | 0            |
| Infiltration   | 0.9                  | 1558         | 6.2          |
| Ducts          |                      | 0            | 0            |
| Ventilation    |                      | 1958         | 7.8          |
| Internal gains |                      | 3520         | 14.0         |
| Blower         |                      | 0            | 0            |
| Adjustments    |                      | 0            | 0            |
| <b>Total</b>   |                      | <b>25224</b> | <b>100.0</b> |

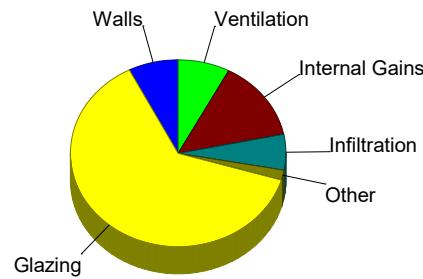

Latent Cooling Load = 1705 Btuh

Overall U-value = 0.186 Btuh/ft<sup>2</sup>·°F, Window / Floor Area = 61.3 %

WARNING: window to floor area ratio = 61.3% - more than 25%.

## Project Information


For: Alterstudio  
 17363 E Reed Parks Rd., Jonestown, TX 78645

## Design Conditions

|                  |                              |                |       |                             |                        |         |
|------------------|------------------------------|----------------|-------|-----------------------------|------------------------|---------|
| <b>Location:</b> | Georgetown Municipal, TX, US |                |       | <b>Indoor:</b>              | Heating                | Cooling |
| Elevation:       | 787 ft                       |                |       | Indoor temperature (°F)     | 72                     | 72      |
| Latitude:        | 31°N                         |                |       | Design TD (°F)              | 44                     | 28      |
| <b>Outdoor:</b>  | <b>Heating</b>               | <b>Cooling</b> |       | Relative humidity (%)       | 30                     | 50      |
| Dry bulb (°F)    | 28                           | 100            |       | Moisture difference (gr/lb) | 17.6                   | 21.2    |
| Daily range (°F) | -                            | 22             | ( M ) |                             |                        |         |
| Wet bulb (°F)    | -                            | 73             |       | <b>Infiltration:</b>        |                        |         |
| Wind speed (mph) | 15.0                         | 7.5            |       | Method                      | Blower door            |         |
|                  |                              |                |       | Shielding / stories         | 3 (partial) / 2        |         |
|                  |                              |                |       | Pressure / ACH / AVF        | 50 Pa / 3.5 / 1876 cfm |         |


## Heating

| Component      | Btuh/ft <sup>2</sup> | Btuh         | % of load    |
|----------------|----------------------|--------------|--------------|
| Walls          | 3.0                  | 4597         | 14.7         |
| Glazing        | 17.5                 | 11609        | 37.2         |
| Doors          | 0                    | 0            | 0            |
| Ceilings       | 2.1                  | 4426         | 14.2         |
| Floors         | 2.9                  | 2679         | 8.6          |
| Infiltration   | 2.2                  | 4758         | 15.2         |
| Ducts          | 0                    | 0            | 0            |
| Piping         | 0                    | 0            | 0            |
| Humidification | 0                    | 0            | 0            |
| Ventilation    | 3140                 | 3140         | 10.1         |
| Adjustments    | 0                    | 0            | 0            |
| <b>Total</b>   |                      | <b>31210</b> | <b>100.0</b> |

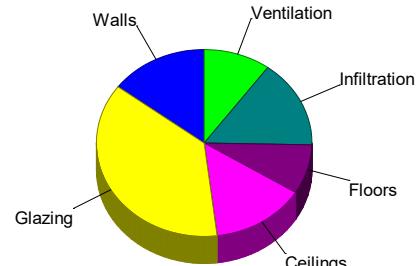

## Cooling

| Component      | Btuh/ft <sup>2</sup> | Btuh         | % of load    |
|----------------|----------------------|--------------|--------------|
| Walls          | 2.0                  | 3109         | 8.6          |
| Glazing        | 23.9                 | 15819        | 43.6         |
| Doors          | 0                    | 0            | 0            |
| Ceilings       | 1.8                  | 3864         | 10.7         |
| Floors         | 1.5                  | 1358         | 3.7          |
| Infiltration   | 0.9                  | 1946         | 5.4          |
| Ducts          | 0                    | 0            | 0            |
| Ventilation    | 3069                 | 3069         | 8.5          |
| Internal gains | 7080                 | 7080         | 19.5         |
| Blower         | 0                    | 0            | 0            |
| Adjustments    | 0                    | 0            | 0            |
| <b>Total</b>   |                      | <b>36244</b> | <b>100.0</b> |

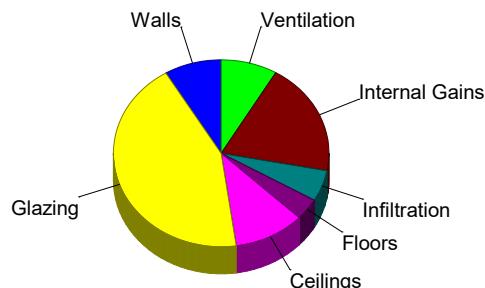

Latent Cooling Load = 2386 Btuh  
 Overall U-value = 0.101 Btuh/ft<sup>2</sup>·°F, Window / Floor Area = 30.5 %

WARNING: window to floor area ratio = 30.5% - more than 25%.

## Project Information

For: Alterstudio  
17363 E Reed Parks Rd., Jonestown, TX 78645

|                                    | Heating              | Cooling              |
|------------------------------------|----------------------|----------------------|
| External static pressure           | 0.70 in H2O          | 0.70 in H2O          |
| Pressure losses                    | 0.25 in H2O          | 0.25 in H2O          |
| Available static pressure          | 0.44 in H2O          | 0.44 in H2O          |
| Supply / return available pressure | 0.211 / 0.234 in H2O | 0.211 / 0.234 in H2O |
| Lowest friction rate               | 0.060 in/100ft       | 0.060 in/100ft       |
| Actual air flow                    | 800 cfm              | 1080 cfm             |
| Total effective length (TEL)       |                      | 736 ft               |

## Supply Branch Detail Table

| Name             | Design (Btuh) | Htg (cfm) | Clg (cfm) | Design FR | Diam (in) | H x W (in) | Duct Matl | Actual Ln (ft) | Ftg.Eqv Ln (ft) | Trunk |
|------------------|---------------|-----------|-----------|-----------|-----------|------------|-----------|----------------|-----------------|-------|
| Kitchen/Dining   | c 3350        | 86        | 155       | 0.099     | 8.0       | 0x0        | VIFx      | 17.1           | 195.0           | st3   |
| Kitchen/Dining-A | c 3349        | 86        | 155       | 0.139     | 8.0       | 0x0        | VIFx      | 11.2           | 140.0           | st3   |
| Kitchen/Dining-B | c 3349        | 86        | 155       | 0.144     | 8.0       | 0x0        | VIFx      | 6.7            | 140.0           | st3   |
| Living-A         | c 3690        | 138       | 171       | 0.065     | 9.0       | 0x0        | VIFx      | 37.0           | 285.0           | st14  |
| Living-B         | c 3690        | 138       | 171       | 0.062     | 9.0       | 0x0        | VIFx      | 40.5           | 300.0           | st15  |
| Living-C         | c 3690        | 138       | 171       | 0.060     | 9.0       | 0x0        | VIFx      | 43.8           | 305.0           | st15  |
| Mud              | h 1443        | 41        | 36        | 0.069     | 4.0       | 0x0        | VIFx      | 36.8           | 270.0           | st16  |
| Pantry           | h 1565        | 44        | 43        | 0.069     | 5.0       | 0x0        | VIFx      | 37.4           | 270.0           | st16  |
| Pwdr             | h 1558        | 44        | 21        | 0.068     | 5.0       | 0x0        | VIFx      | 45.5           | 265.0           | st16  |

## Supply Trunk Detail Table

| Name | Trunk Type | Htg (cfm) | Clg (cfm) | Design FR | Veloc (fpm) | Diam (in) | H x W (in) | Duct Material | Trunk |
|------|------------|-----------|-----------|-----------|-------------|-----------|------------|---------------|-------|
| st13 | Peak AVF   | 414       | 514       | 0.060     | 587         | 11.9      | 9 x 14     | ShtMetl       | st12  |
| st15 | Peak AVF   | 276       | 343       | 0.060     | 436         | 12.0      | 0 x 0      | VinlFlx       | st14  |
| st14 | Peak AVF   | 414       | 514       | 0.060     | 481         | 14.0      | 0 x 0      | VinlFlx       | st13  |
| st3  | Peak AVF   | 800       | 1080      | 0.060     | 653         | 16.5      | 14 x 17    | RectFbg       |       |
| st12 | Peak AVF   | 414       | 514       | 0.060     | 481         | 14.0      | 0 x 0      | VinlFlx       | st3   |
| st16 | Peak AVF   | 129       | 100       | 0.068     | 369         | 8.0       | 0 x 0      | VinlFlx       | st3   |

## Return Branch Detail Table

| Name | Grille Size (in) | Htg (cfm) | Clg (cfm) | TEL (ft) | Design FR | Veloc (fpm) | Diam (in) | H x W (in) | Stud/Joist Opening (in) | Duct Matl | Trunk |
|------|------------------|-----------|-----------|----------|-----------|-------------|-----------|------------|-------------------------|-----------|-------|
| rb9  | 0x0              | 256       | 368       | 188.2    | 0.124     | 468         | 12.0      | 0x 0       |                         | VIFx      | rt3   |
| rb1  | 0x0              | 268       | 370       | 121.5    | 0.193     | 471         | 12.0      | 0x 0       |                         | VIFx      | rt3   |
| rb7  | 0x0              | 276       | 343       | 387.5    | 0.060     | 343         | 12.0      | 36x 4      |                         | RtFg      | rt9   |

## Return Trunk Detail Table

| Name | Trunk Type | Htg (cfm) | Clg (cfm) | Design FR | Veloc (fpm) | Diam (in) | H x W (in) | Duct Material | Trunk |
|------|------------|-----------|-----------|-----------|-------------|-----------|------------|---------------|-------|
| rt9  | Peak AVF   | 276       | 343       | 0.060     | 436         | 12.0      | 0 x 0      | VinIFlx       | rt8   |
| rt8  | Peak AVF   | 276       | 343       | 0.060     | 436         | 12.0      | 0 x 0      | VinIFlx       | rt3   |
| rt3  | Peak AVF   | 800       | 1080      | 0.060     | 572         | 16.5      | 16 x 17    | RectFbg       |       |

Austin, TX Phone: (512) 814-7638 Email: Info@HVAC-Sizing.com Web: www.HVAC-Sizing.com License: TACLA57315E

### Project Information

For: Alterstudio  
17363 E Reed Parks Rd., Jonestown, TX 78645

|                                    | Heating              | Cooling              |
|------------------------------------|----------------------|----------------------|
| External static pressure           | 0.70 in H2O          | 0.70 in H2O          |
| Pressure losses                    | 0.28 in H2O          | 0.28 in H2O          |
| Available static pressure          | 0.42 in H2O          | 0.42 in H2O          |
| Supply / return available pressure | 0.245 / 0.175 in H2O | 0.245 / 0.175 in H2O |
| Lowest friction rate               | 0.063 in/100ft       | 0.063 in/100ft       |
| Actual air flow                    | 1000 cfm             | 1440 cfm             |
| Total effective length (TEL)       | 667 ft               |                      |

### Supply Branch Detail Table

| Name         | Design (Btuh) | Htg (cfm) | Clg (cfm) | Design FR | Diam (in) | H x W (in) | Duct Matl | Actual Ln (ft) | Ftg.Eqv Ln (ft) | Trunk |
|--------------|---------------|-----------|-----------|-----------|-----------|------------|-----------|----------------|-----------------|-------|
| Bath1        | h 1140        | 41        | 29        | 0.063     | 4.0       | 0x0        | VIFx      | 64.6           | 325.0           | st7   |
| Bath2        | h 706         | 25        | 18        | 0.066     | 4.0       | 0x0        | VIFx      | 53.4           | 320.0           | st7   |
| Bed 1        | c 2949        | 111       | 128       | 0.099     | 8.0       | 0x0        | VIFx      | 48.8           | 200.0           | st11  |
| Bed 2        | c 3453        | 106       | 150       | 0.067     | 9.0       | 0x0        | VIFx      | 47.2           | 320.0           | st7   |
| Craft        | c 1497        | 37        | 65        | 0.182     | 6.0       | 0x0        | VIFx      | 29.9           | 105.0           | st1   |
| Kitchenette  | c 954         | 11        | 41        | 0.112     | 5.0       | 0x0        | VIFx      | 34.4           | 185.0           | st11  |
| Laundry      | c 2221        | 45        | 96        | 0.136     | 7.0       | 0x0        | VIFx      | 25.0           | 155.0           | st10  |
| M. Bath      | c 2539        | 96        | 110       | 0.084     | 8.0       | 0x0        | VIFx      | 51.9           | 240.0           | st8   |
| M. WC        | c 1418        | 46        | 62        | 0.075     | 6.0       | 0x0        | VIFx      | 68.9           | 260.0           | st8   |
| M. WIC       | c 1729        | 60        | 75        | 0.072     | 6.0       | 0x0        | VIFx      | 46.1           | 295.0           | st5   |
| Master Bed   | c 2523        | 70        | 110       | 0.065     | 8.0       | 0x0        | VIFx      | 64.9           | 315.0           | st6   |
| Master Bed-A | c 2523        | 70        | 110       | 0.066     | 8.0       | 0x0        | VIFx      | 59.1           | 310.0           | st6   |
| Office 1     | c 3692        | 56        | 160       | 0.289     | 7.0       | 0x0        | VIFx      | 5.0            | 80.0            |       |
| Office 2     | c 2325        | 47        | 101       | 0.193     | 6.0       | 0x0        | VIFx      | 22.2           | 105.0           | st1   |
| Stairs2      | c 3920        | 158       | 170       | 0.075     | 9.0       | 0x0        | VIFx      | 19.3           | 310.0           | st4   |
| WIC 1        | h 604         | 22        | 15        | 0.110     | 4.0       | 0x0        | VIFx      | 32.8           | 190.0           | st11  |

## Supply Trunk Detail Table

| Name | Trunk Type | Htg (cfm) | Clg (cfm) | Design FR | Veloc (fpm) | Diam (in) | H x W (in) | Duct Material | Trunk |
|------|------------|-----------|-----------|-----------|-------------|-----------|------------|---------------|-------|
| st4  | Peak AVF   | 672       | 833       | 0.063     | 666         | 14.8      | 18 x 10    | RectFbg       | st2   |
| st1  | Peak AVF   | 84        | 166       | 0.182     | 475         | 8.0       | 0 x 0      | VinlFlx       |       |
| st6  | Peak AVF   | 140       | 219       | 0.065     | 402         | 10.0      | 0 x 0      | VinlFlx       | st5   |
| st5  | Peak AVF   | 199       | 294       | 0.065     | 374         | 12.0      | 0 x 0      | VinlFlx       | st4   |
| st7  | Peak AVF   | 172       | 197       | 0.063     | 361         | 10.0      | 0 x 0      | VinlFlx       | st4   |
| st11 | Peak AVF   | 144       | 185       | 0.099     | 418         | 9.0       | 0 x 0      | VinlFlx       | st10  |
| st2  | Peak AVF   | 860       | 1114      | 0.063     | 685         | 16.6      | 18 x 13    | RectFbg       |       |
| st10 | Peak AVF   | 188       | 281       | 0.099     | 515         | 10.0      | 0 x 0      | VinlFlx       | st2   |
| st8  | Peak AVF   | 142       | 172       | 0.075     | 389         | 9.0       | 0 x 0      | VinlFlx       | st4   |

## Return Branch Detail Table

| Name | Grille Size (in) | Htg (cfm) | Clg (cfm) | TEL (ft) | Design FR | Veloc (fpm) | Diam (in) | H x W (in) | Stud/Joist Opening (in) | Duct Matl | Trunk |
|------|------------------|-----------|-----------|----------|-----------|-------------|-----------|------------|-------------------------|-----------|-------|
| rb5  | 0x 0             | 174       | 172       | 277.4    | 0.063     | 318         | 10.0      | 0x 0       |                         | VIFx      | rt5   |
| rb6  | 0x 0             | 132       | 168       | 264.5    | 0.066     | 381         | 9.0       | 0x 0       |                         | VIFx      | rt5   |
| rb4  | 0x 0             | 137       | 322       | 185.2    | 0.094     | 590         | 10.0      | 0x 0       |                         | VIFx      | rt4   |
| rb8  | 0x 0             | 216       | 312       | 157.7    | 0.111     | 398         | 12.0      | 0x 0       |                         | VIFx      | rt2   |
| rb2  | 0x 0             | 342       | 466       | 164.5    | 0.106     | 593         | 12.0      | 0x 0       |                         | VIFx      | rt2   |

## Return Trunk Detail Table

| Name | Trunk Type | Htg (cfm) | Clg (cfm) | Design FR | Veloc (fpm) | Diam (in) | H x W (in) | Duct Material | Trunk |
|------|------------|-----------|-----------|-----------|-------------|-----------|------------|---------------|-------|
| rt4  | Peak AVF   | 442       | 662       | 0.063     | 596         | 13.7      | 16 x 10    | RectFbg       | rt1   |
| rt5  | Peak AVF   | 305       | 340       | 0.063     | 433         | 12.0      | 0 x 0      | VinlFlx       | rt4   |
| rt1  | Peak AVF   | 442       | 662       | 0.063     | 596         | 13.7      | 16 x 10    | RectFbg       |       |
| rt2  | Peak AVF   | 558       | 778       | 0.106     | 557         | 16.0      | 0 x 0      | VinlFlx       |       |

## Project Information

For: Alterstudio  
17363 E Reed Parks Rd., Jonestown, TX 78645

## Cooling Equipment

### Design Conditions

|                    |        |                    |       |      |                   |        |
|--------------------|--------|--------------------|-------|------|-------------------|--------|
| Outdoor design DB: | 100°F  | Sensible gain:     | 25224 | Btuh | Entering coil DB: | 73.7°F |
| Outdoor design WB: | 72.8°F | Latent gain:       | 1705  | Btuh | Entering coil WB: | 60.6°F |
| Indoor design DB:  | 72.0°F | Total gain:        | 26930 | Btuh |                   |        |
| Indoor RH:         | 50%    | Estimated airflow: | 1080  | cfm  |                   |        |

### Manufacturer's Performance Data at Actual Design Conditions

|                    |                   |              |                         |     |
|--------------------|-------------------|--------------|-------------------------|-----|
| Equipment type:    | Split ASHP        |              |                         |     |
| Manufacturer:      | American Standard | Model:       | 4A6V0X36A1+TAMXB0C36V31 |     |
| Actual airflow:    | 1080 cfm          |              |                         |     |
| Sensible capacity: | 24500 Btuh        | 97% of load  |                         |     |
| Latent capacity:   | 10500 Btuh        | 616% of load |                         |     |
| Total capacity:    | 35000 Btuh        | 130% of load | SHR:                    | 70% |

## Heating Equipment

### Design Conditions

|                    |        |            |       |      |                   |        |
|--------------------|--------|------------|-------|------|-------------------|--------|
| Outdoor design DB: | 28.3°F | Heat loss: | 30357 | Btuh | Entering coil DB: | 69.6°F |
| Indoor design DB:  | 72.0°F |            |       |      |                   |        |

### Manufacturer's Performance Data at Actual Design Conditions

|                             |                   |              |                         |        |
|-----------------------------|-------------------|--------------|-------------------------|--------|
| Equipment type:             | Split ASHP        |              |                         |        |
| Manufacturer:               | American Standard | Model:       | 4A6V0X36A1+TAMXB0C36V31 |        |
| Actual airflow:             | 800 cfm           |              |                         |        |
| Output capacity:            | 31600 Btuh        | 104% of load |                         |        |
| Supplemental heat required: | 0 Btuh            |              |                         |        |
|                             |                   |              | Capacity balance:       | 24 °F  |
|                             |                   |              | Economic balance:       | -99 °F |

|                        |                   |              |             |       |
|------------------------|-------------------|--------------|-------------|-------|
| Backup equipment type: | Elec strip        |              |             |       |
| Manufacturer:          | American Standard | Model:       | AFUE 100    |       |
| Actual airflow:        | 800 cfm           |              |             |       |
| Output capacity:       | 10.0 kW           | 112% of load | Temp. rise: | 50 °F |

Meets all requirements of ACCA Manual S.

## Project Information

For: Alterstudio  
17363 E Reed Parks Rd., Jonestown, TX 78645

## Cooling Equipment

### Design Conditions

|                    |        |                    |       |      |                   |        |
|--------------------|--------|--------------------|-------|------|-------------------|--------|
| Outdoor design DB: | 100°F  | Sensible gain:     | 36244 | Btuh | Entering coil DB: | 74.0°F |
| Outdoor design WB: | 72.8°F | Latent gain:       | 2386  | Btuh | Entering coil WB: | 60.7°F |
| Indoor design DB:  | 72.0°F | Total gain:        | 38631 | Btuh |                   |        |
| Indoor RH:         | 50%    | Estimated airflow: | 1440  | cfm  |                   |        |

### Manufacturer's Performance Data at Actual Design Conditions

|                    |                   |              |                         |  |
|--------------------|-------------------|--------------|-------------------------|--|
| Equipment type:    | Split ASHP        |              |                         |  |
| Manufacturer:      | American Standard | Model:       | 4A6V0X48A1+TAMXA0C48V41 |  |
| Actual airflow:    | 1440 cfm          |              |                         |  |
| Sensible capacity: | 35250 Btuh        | 97% of load  |                         |  |
| Latent capacity:   | 11750 Btuh        | 492% of load |                         |  |
| Total capacity:    | 47000 Btuh        | 122% of load | SHR: 75%                |  |

## Heating Equipment

### Design Conditions


|                    |        |            |       |      |                   |        |
|--------------------|--------|------------|-------|------|-------------------|--------|
| Outdoor design DB: | 28.3°F | Heat loss: | 31210 | Btuh | Entering coil DB: | 69.0°F |
| Indoor design DB:  | 72.0°F |            |       |      |                   |        |

### Manufacturer's Performance Data at Actual Design Conditions


|                             |                   |              |                         |                          |
|-----------------------------|-------------------|--------------|-------------------------|--------------------------|
| Equipment type:             | Split ASHP        |              |                         |                          |
| Manufacturer:               | American Standard | Model:       | 4A6V0X48A1+TAMXA0C48V41 |                          |
| Actual airflow:             | 1000 cfm          |              |                         |                          |
| Output capacity:            | 42500 Btuh        | 136% of load |                         |                          |
| Supplemental heat required: | 0 Btuh            |              |                         | Capacity balance: 14 °F  |
|                             |                   |              |                         | Economic balance: -99 °F |

|                        |                   |              |                   |  |
|------------------------|-------------------|--------------|-------------------|--|
| Backup equipment type: | Elec strip        |              |                   |  |
| Manufacturer:          | American Standard | Model:       | AFUE 100          |  |
| Actual airflow:        | 1000 cfm          |              |                   |  |
| Output capacity:       | 10.0 kW           | 109% of load | Temp. rise: 50 °F |  |

Meets all requirements of ACCA Manual S.

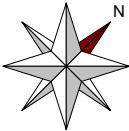

Level 2

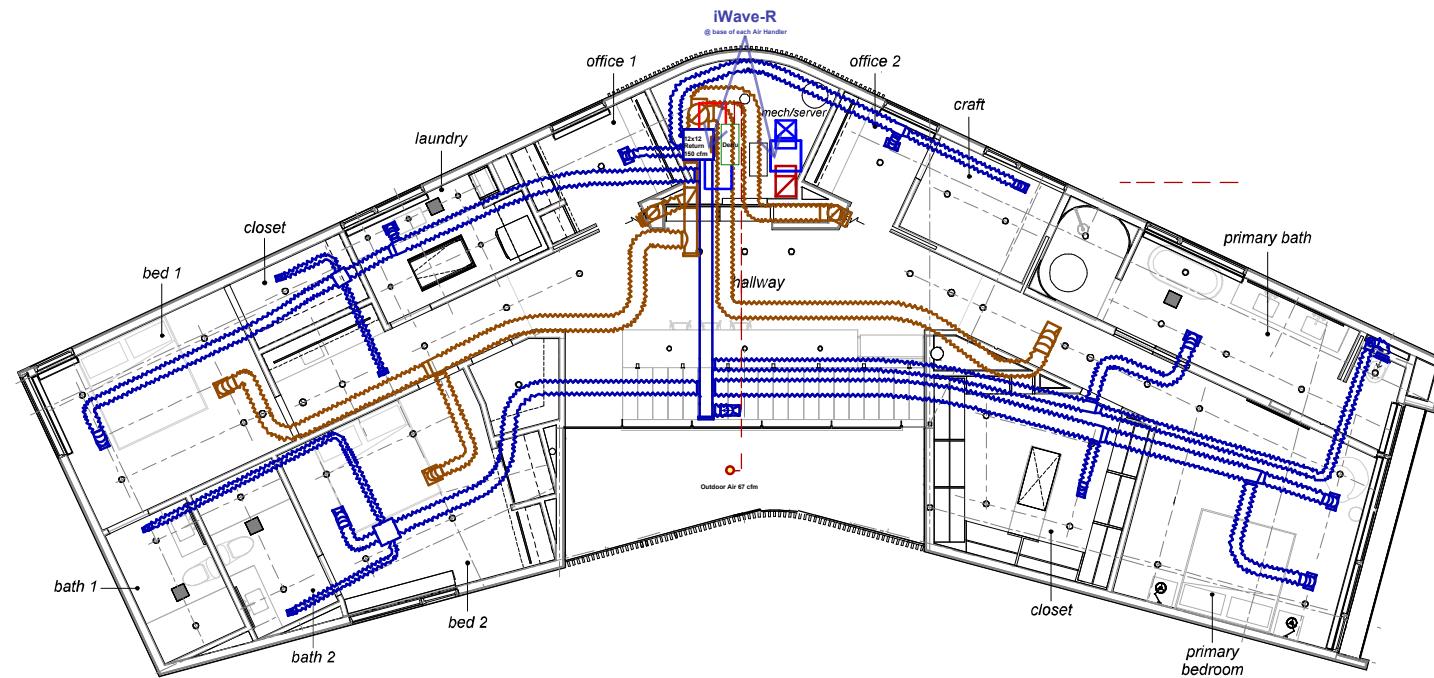


**Job #: 17363 E Reed Parks Rd.**  
**Performed by Coby Sackett for:**  
Alterstudio  
17363 E Reed Parks Rd.  
Jonestown, TX 78645

### Fresh Air HVAC Sizing


Austin, TX  
Phone: (512) 814-7638 License: TACLA57315E  
[www.HVAC-Sizing.com](http://www.HVAC-Sizing.com) [Info@HVAC-Sizing.com](mailto:Info@HVAC-Sizing.com)

Scale: 1 : 152

Page 1  
Right-Suite® Universal 2023  
23.0.01 RSU20313  
2023-Jun-05 08:39:46  
...ks Rd. HVAC Design (5-10-23).rup

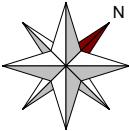

## Level 2

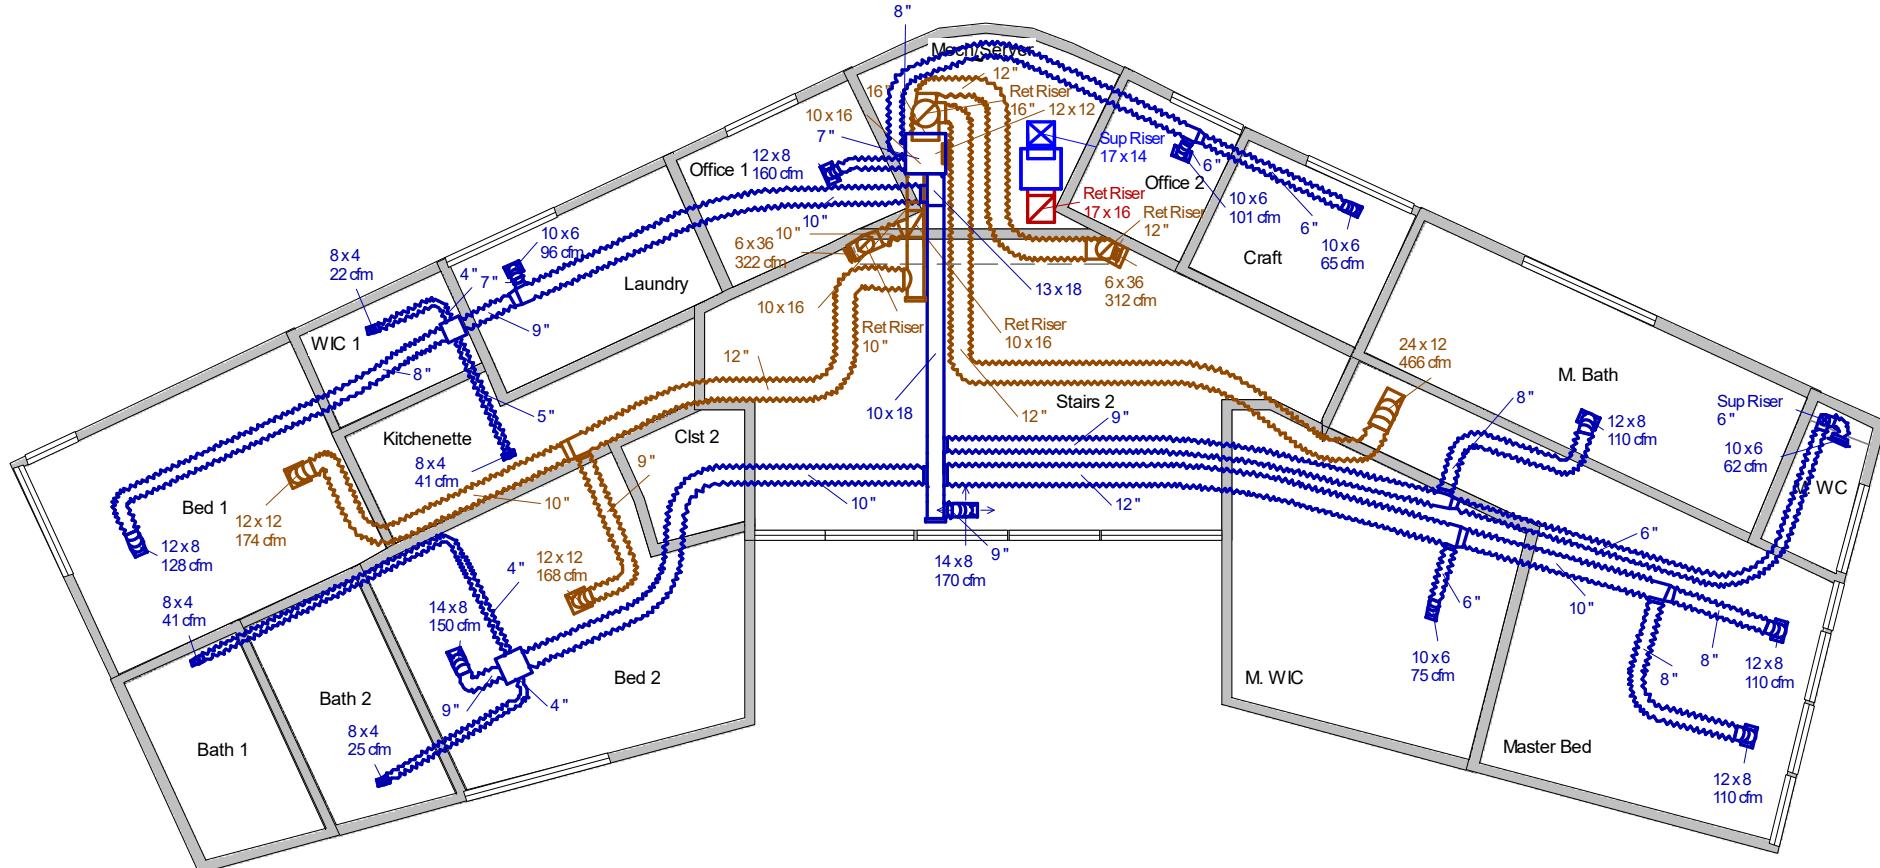


Job #: 17363 E Reed Parks Rd.  
Performed by Coby Sackett for:  
Alterstudio  
17363 E Reed Parks Rd.  
Jonestown, TX 78645

## Fresh Air HVAC Sizing


Austin, TX  
Phone: (512) 814-7638 License: TACLA57315E  
[www.HVAC-Sizing.com](http://www.HVAC-Sizing.com) [Info@HVAC-Sizing.com](mailto:Info@HVAC-Sizing.com)

Scale: 1 : 115

Page 1  
Right-Suite® Universal 2023  
23.0.01 RSU20313  
2023-May-15 17:15:26  
...ks Rd. HVAC Design (5-10-23).rup

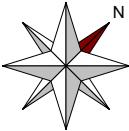

## Level 1

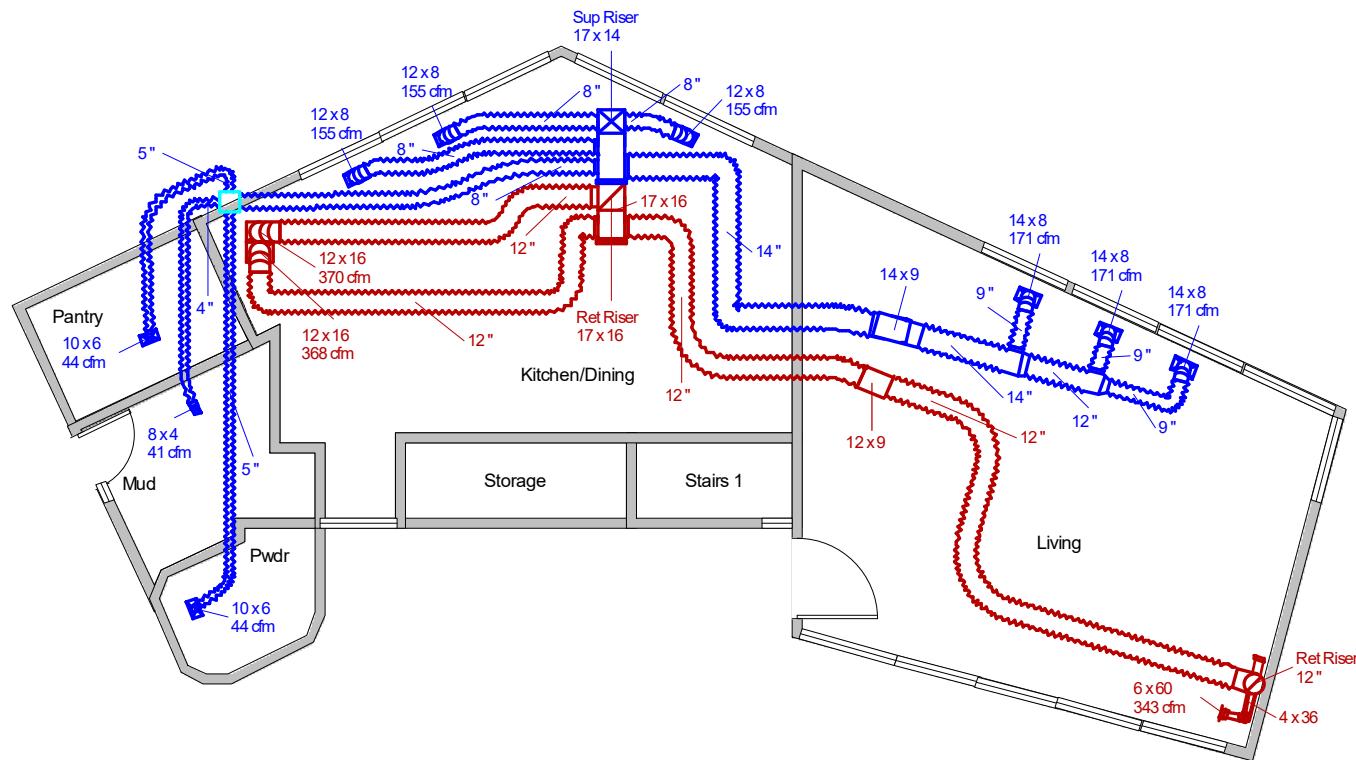

**Job #: 17363 E Reed Parks Rd.  
Performed by Coby Sackett for:  
Alterstudio  
17363 E Reed Parks Rd.  
Jonestown, TX 78645**

## Fresh Air HVAC Sizing


Austin, TX  
Phone: (512) 814-7638 License: TACLA57315E  
[www.HVAC-Sizing.com](http://www.HVAC-Sizing.com) [Info@HVAC-Sizing.com](mailto:Info@HVAC-Sizing.com)

Scale: 1 : 115

Page 2

Page 2  
Right-Suite® Universal 2023  
23.01 RSU20313  
2023-May-15 17:15:27  
1ks Rd. HVAC Design (5-10-23).rpu

AHU 1: Downstairs  
American Standard Platinum 20  
Outdoor: 4A6V0X36A1  
Indoor: TAMXB0C36V31  
Tonnage: 3.0  
Outdoor Air: 43 CFM

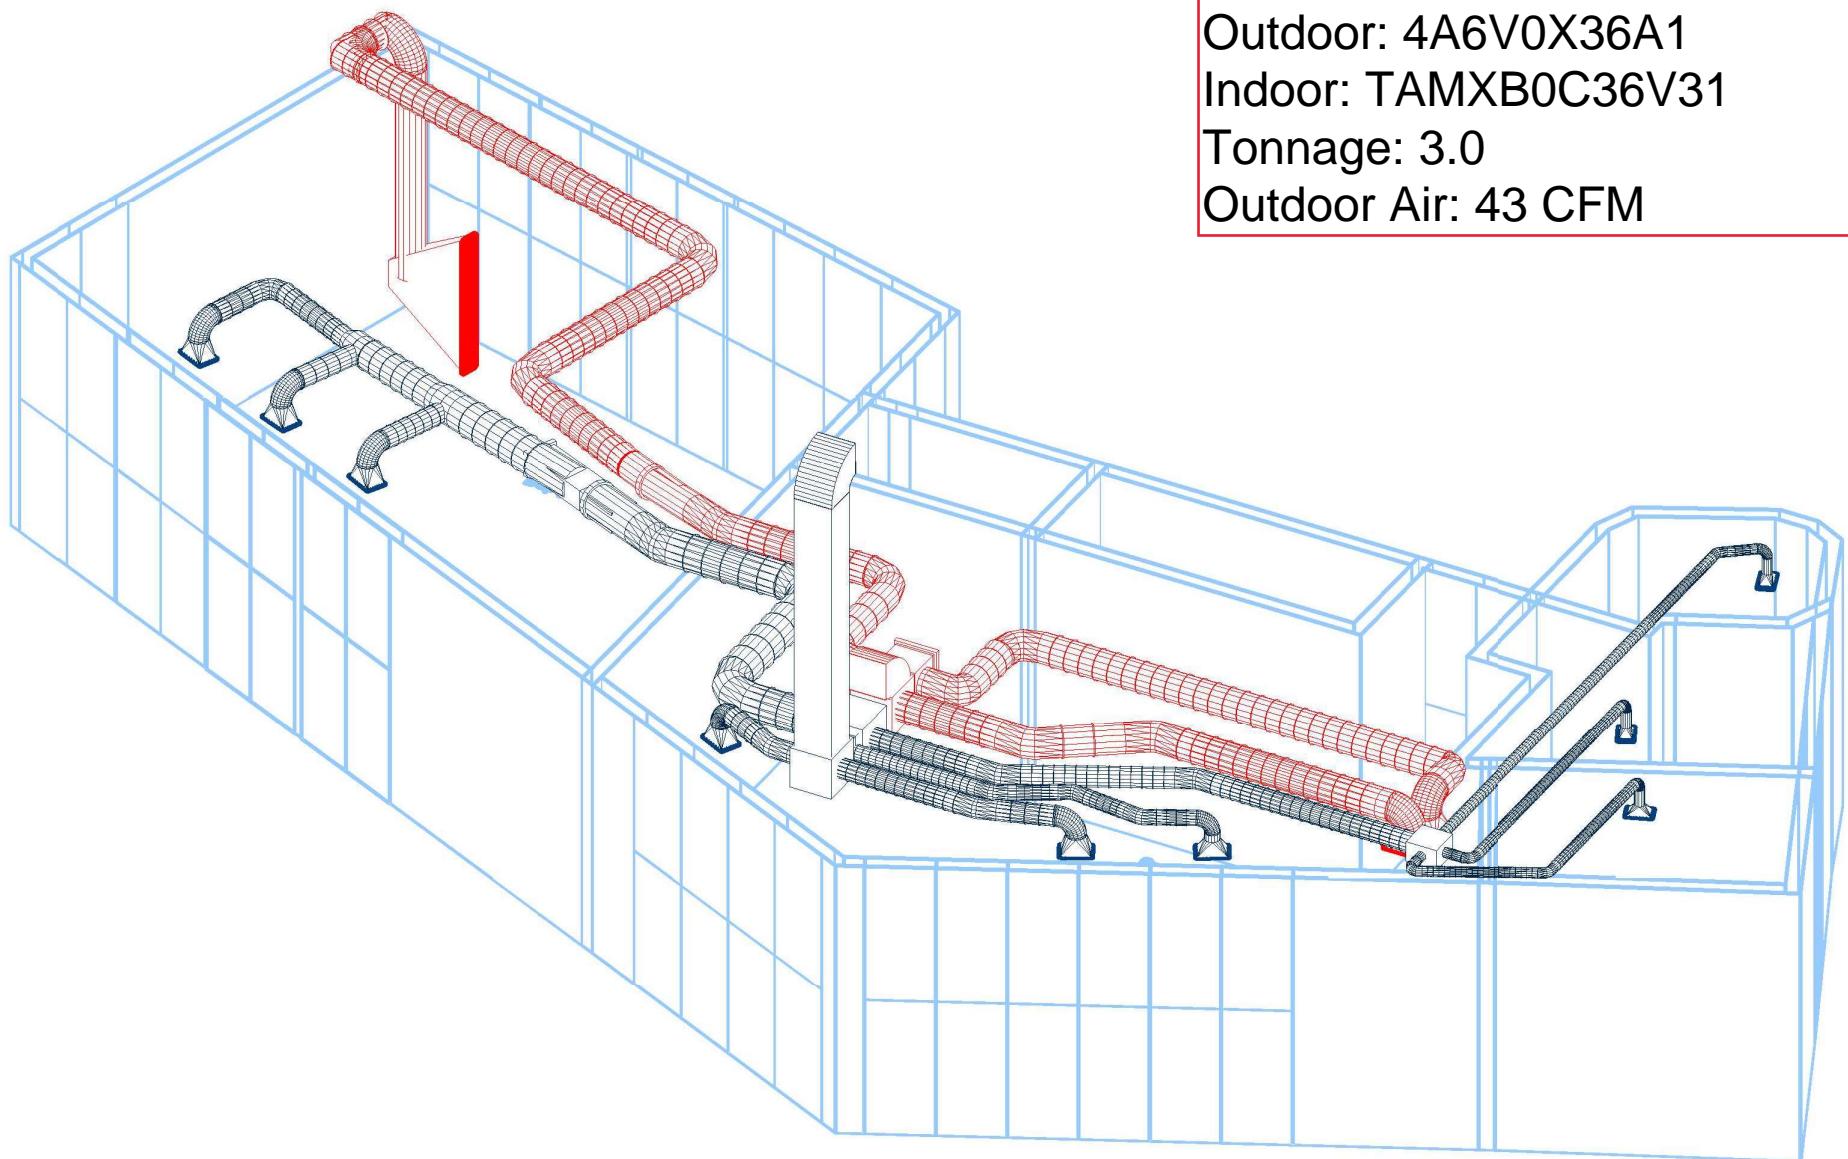

AHU 2: Upstairs


American Standard Platinum 20


Outdoor: 4A6V0X48A1


Indoor: TAMXA0C48V41

Tonnage: 4.0

Outdoor Air: 67 CFM

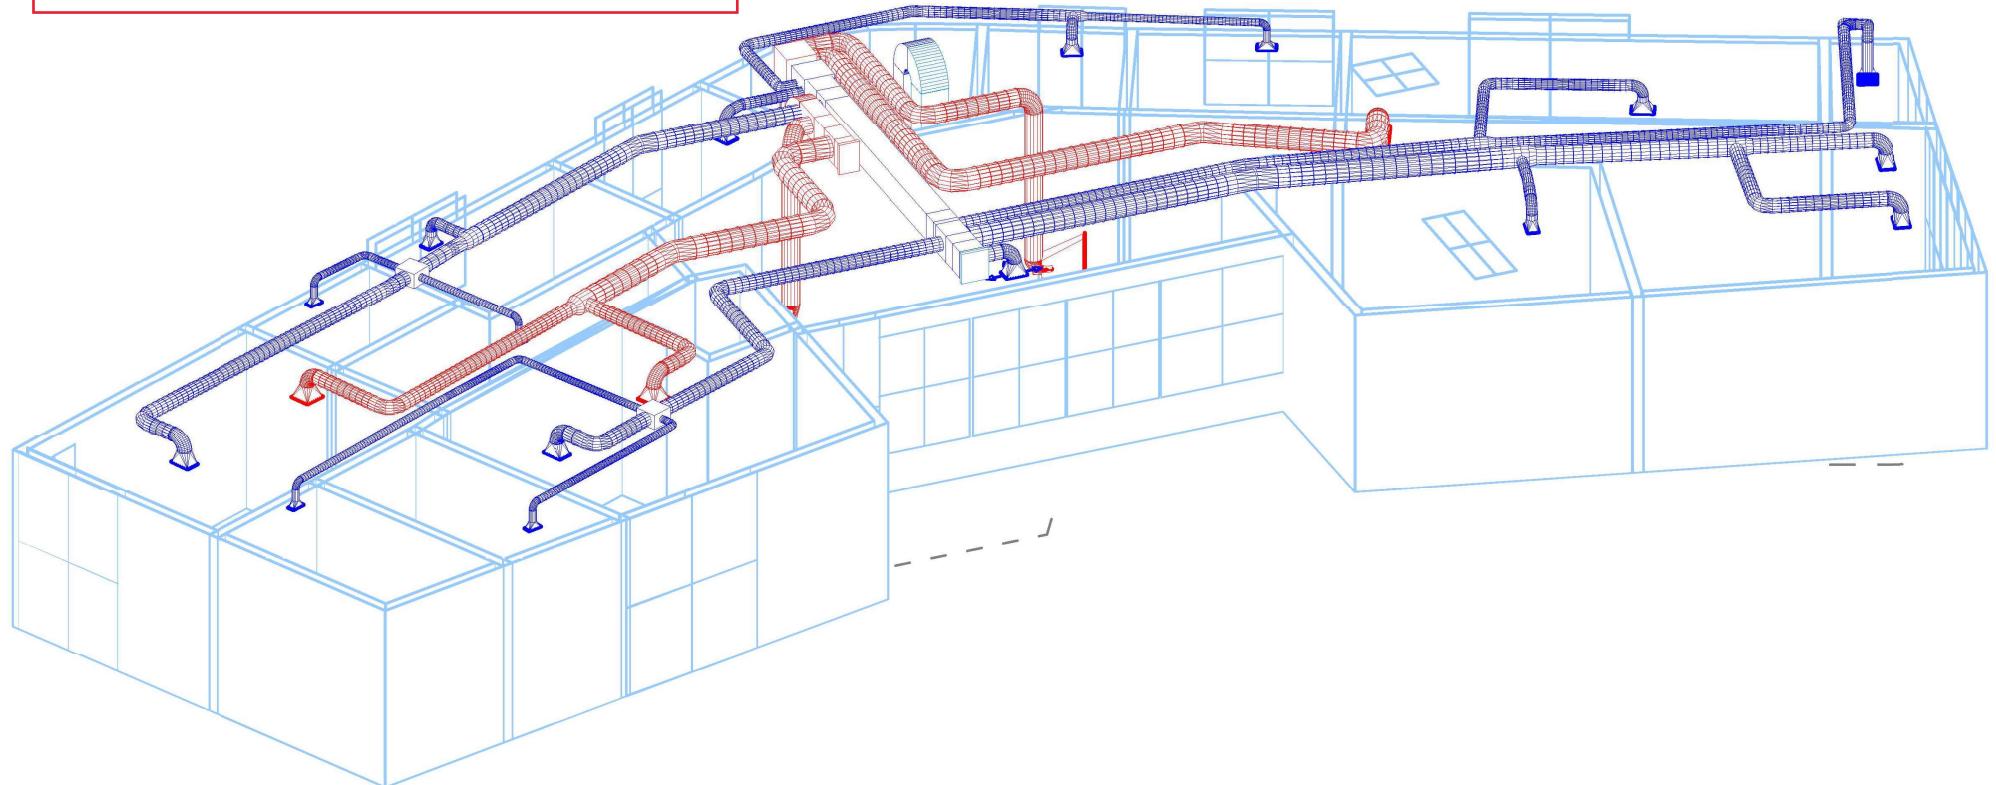

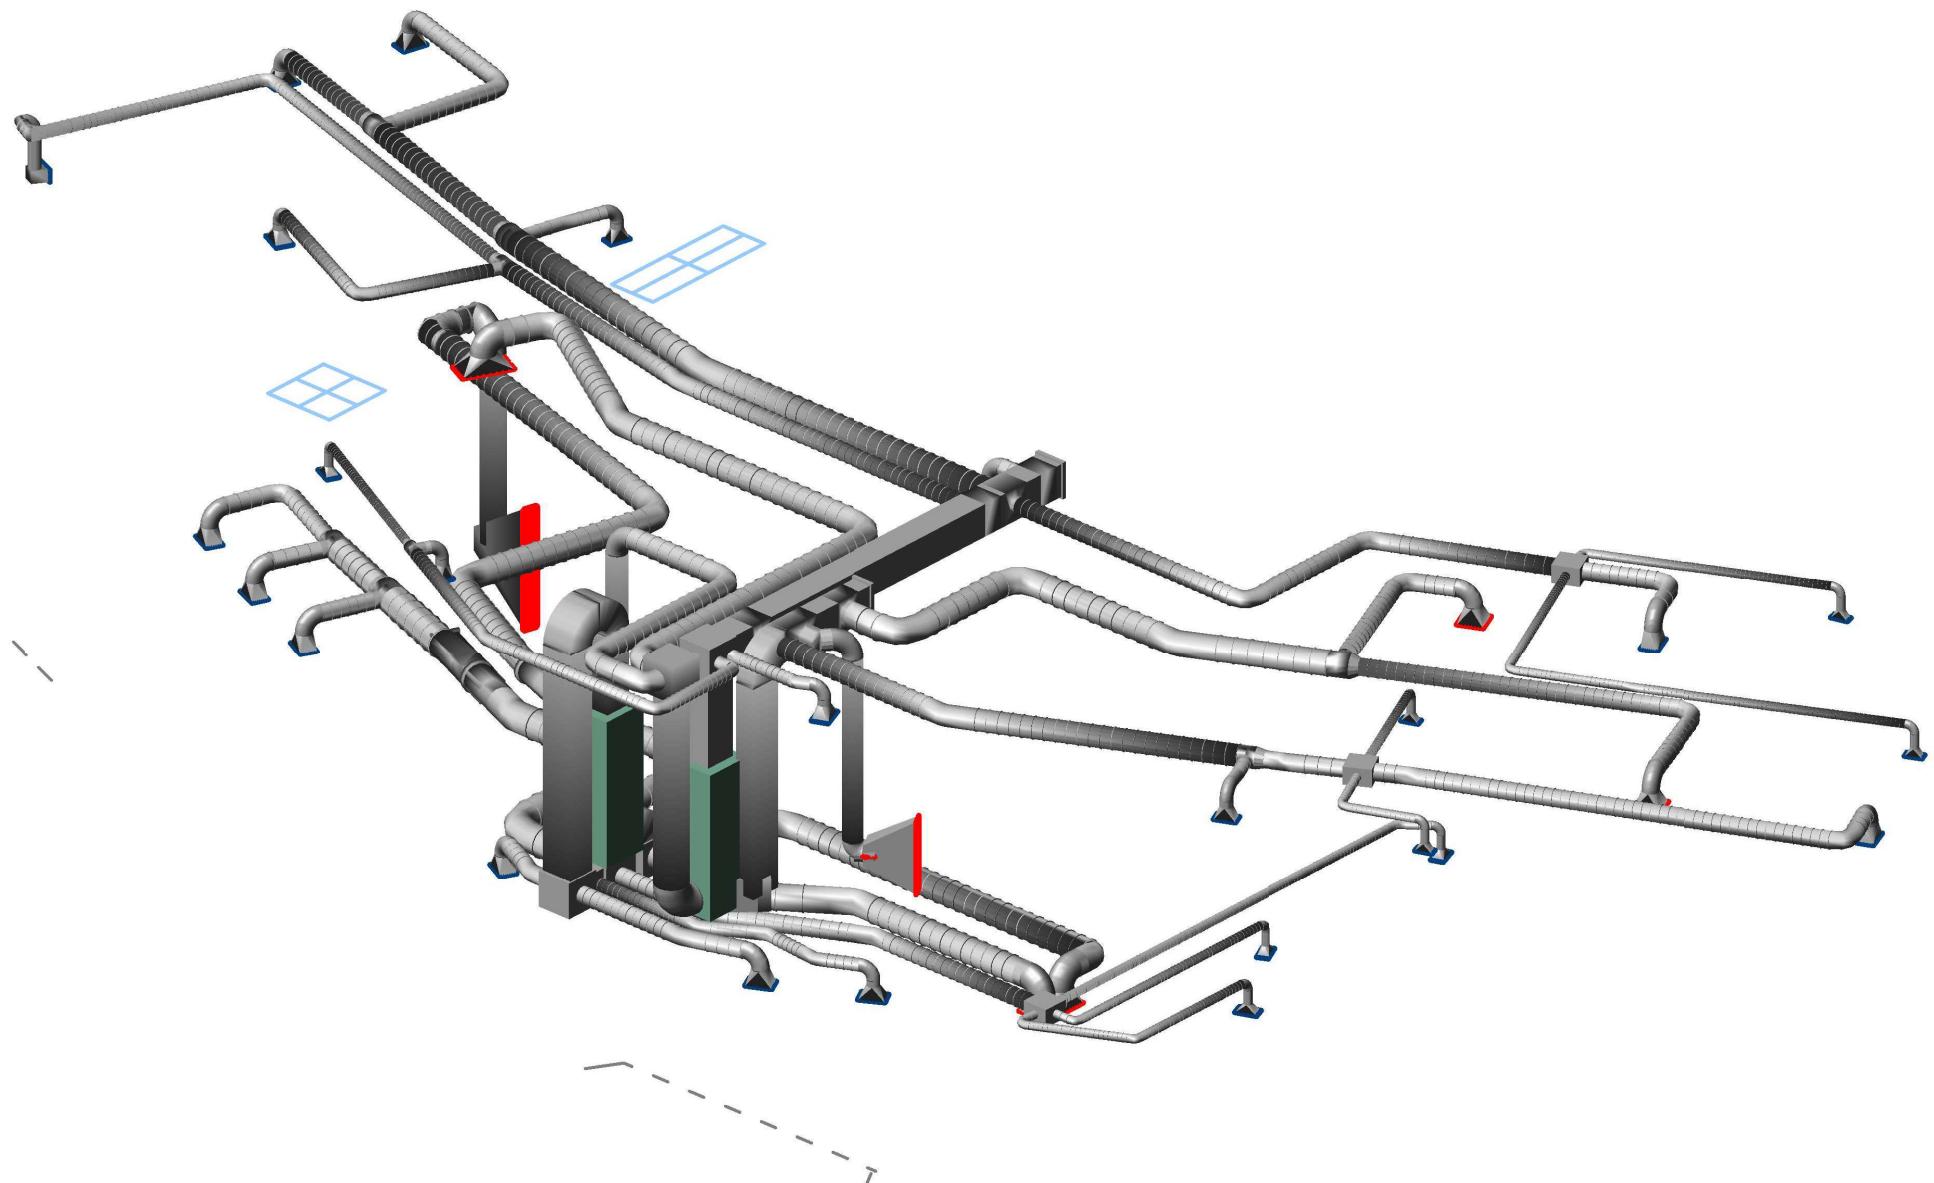

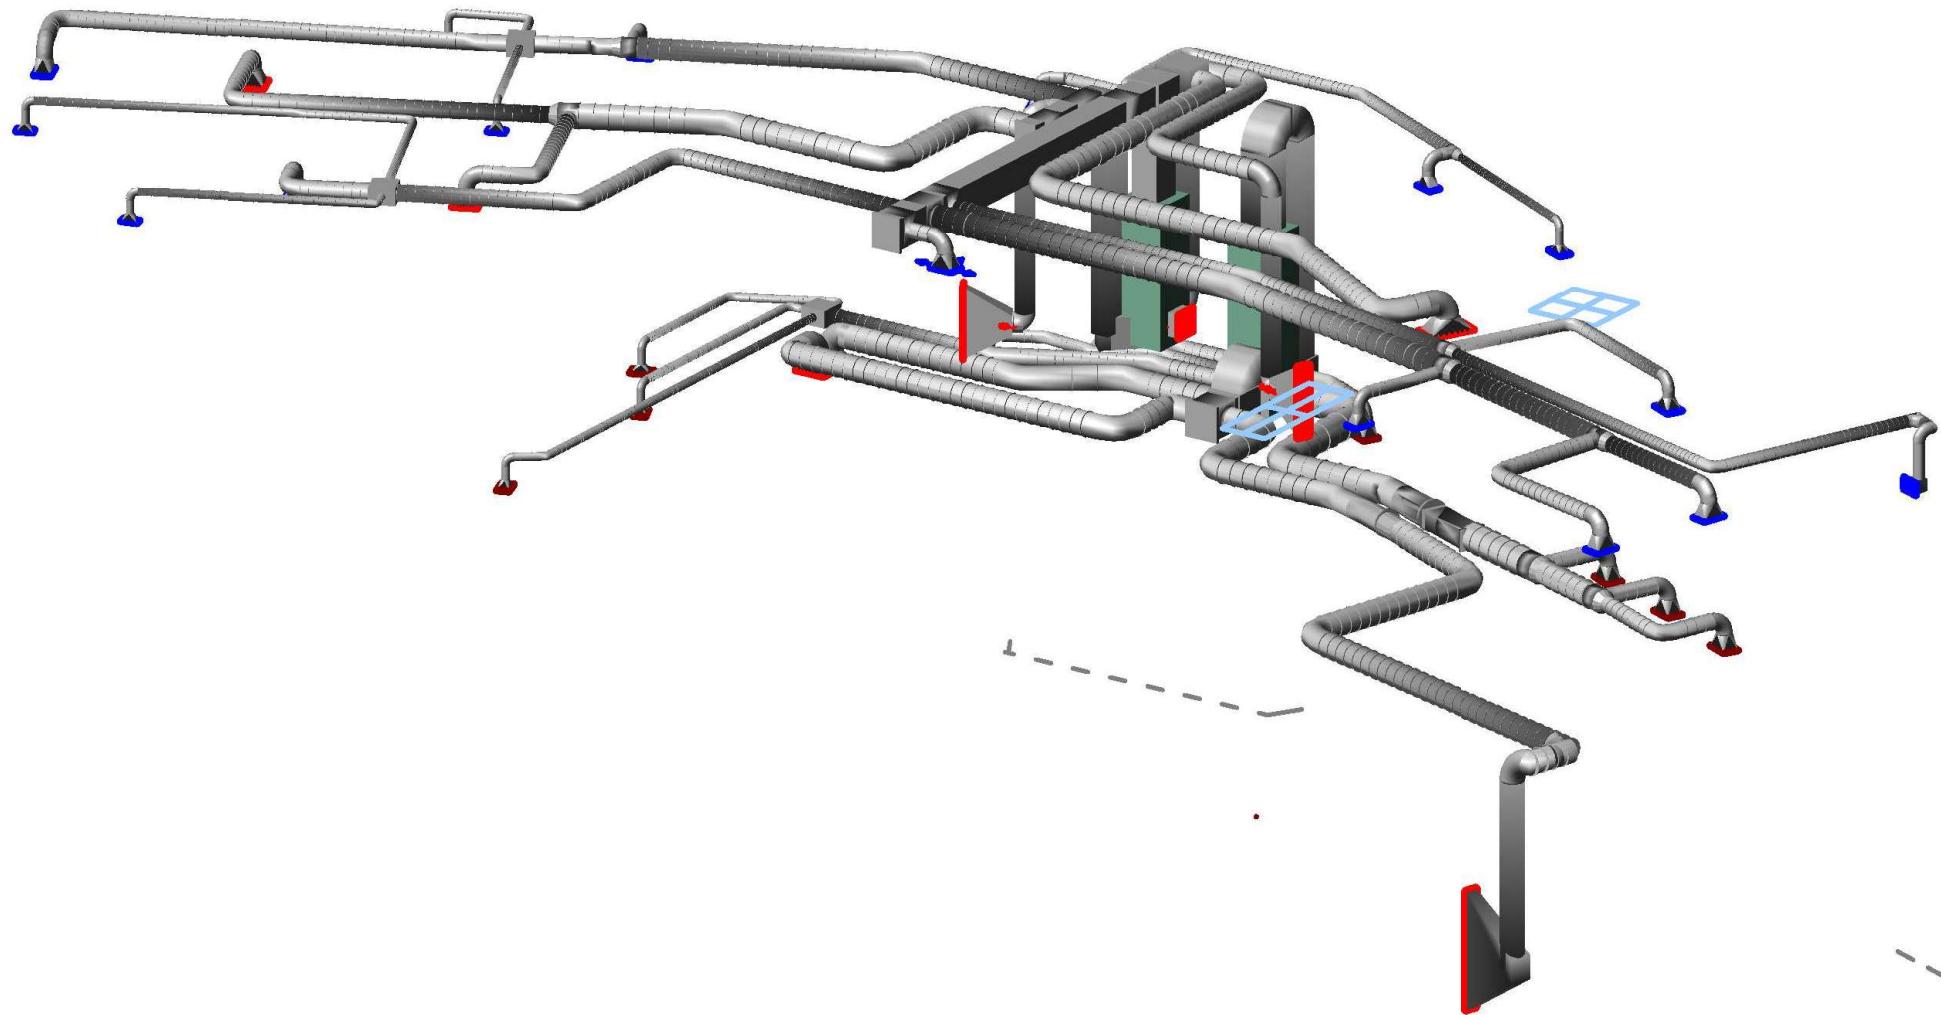

# EasyStart™ 364 & 368 Soft Starters For Residential and Commercial




This is our largest EasyStart and works with substantial AC units (up to 72,000 BTUs). We take power for granted until it is not available, like when a weather disaster strikes. Generators are a great backup but have their own limits. They often lack the power to START AC units that they can otherwise run.

Imagine an engine that can RUN but not START your car. That's the problem the EasyStart solves. It can start an AC for anyone wanting comfort, especially those requiring it -- like people with special medical needs. Even without emergency power requirements, the EasyStart makes for smoother AC starts with its gentle ramping at the start. Eliminates dimming lights and shaking wires and conduit at commencement. Two year limited warranty.

"Using a relatively low-cost portable generator rigged for propane power and your EasyStart 368, I was able to solve our problem! With a commercially available electric interlock switch, a propane adapter and a little better power management we now have emergency power for our home (wife has a serious illness requiring A/C) AND our A/C for days on end during a Public Safety Power Shutoff for high winds.

- Ed King, California Resident

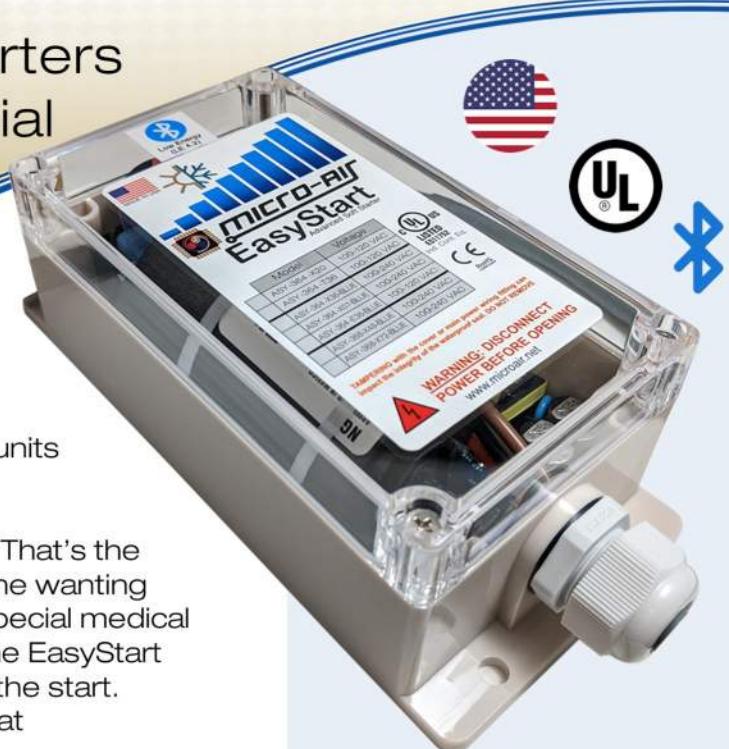

## How Can the EasyStart Help Your Home and Family?



Emergency Situations Can Strike with Little or No Warning, ensures AC Starts for Comfort or Medical Needs



Supports Commercial Grade Central Air Conditioning Units in Today's Market



UV and Water-Resistant Protection to Assure Your AC Stays Up and Running



No Power, No Problem. Run Your Air Conditioner Compressor on a Generator, Inverter or Limited Power



# ***micro-AIR***



124 Route 526 | Allentown, NJ 08501  
Tel: 609-259-2636 | [www.microair.net](http://www.microair.net)

## SELF-CLEANING AIR IONIZATION SYSTEM FOR RESIDENTIAL AIR CONDITIONING SYSTEMS

- Patented self-cleaning design ensures ongoing peak performance
- Needlepoint ionization actively treats air in the living space
- For duct systems up to 6 tons (2400 CFM)
- iWave is validated to meet UL 867 ozone requirements
- No maintenance for the life of the iWave
- Easily installs in minutes in A/C system
- Patented multi-voltage input – 24VAC to 240VAC!
- Universal mounting with magnets
- Flexible design with no replacement parts
- Reduces certain bacteria and viruses\*
- Reduces odors, smoke and other airborne particles
- Keeps coil cleaner
- Programmable cleaning cycle
- Alarm contact option for secondary notification
- UL and cUL recognized
- Three-year limited warranty

## Description

With technology installed in over 200,000 applications, iWave-R is a self-cleaning, no maintenance needlepoint bipolar ionization generator designed specifically for treating air in residential duct A/C systems. As the air flows past the iWave-R, positive and negative ions actively treat the supply air, reducing certain bacteria and viruses\* in the coil and living space. The ionization process also reduces smoke, odors (cooking, pet, VOCs), as well as other particles (no more sunbeams) in the air. iWave is validated to meet UL 867 ozone requirements.

## Application

iWave-R treats the air in any brand of residential duct air conditioning systems up to 6 tons (2400 CFM) in size with no maintenance and no replacement parts. Designed for universal mounting, the iWave-R can be installed inside or outside of duct, or attached magnetically near the indoor fan in the air handler. Simply connect to power using its patented voltage input capability. Install between air filter and cooling coil to treat the indoor coil; as an alternative, the iWave-R can be installed in the supply air. iWave-R always works at peak performance, producing over 160 million ions/cc per polarity (320 million total ions/cc), more than any other ionizer product on the market. Its patented self-cleaning design includes a programmable cleaning cycle that can clean the emitter brushes every 1, 3, 5 or 10 days. The iWave-R is factory set to clean every third day which is adequate for a typical installation. iWave-R does not create "black walls" as negative-only ionizer products will do.

## Indoor Air Quality

### iWave®-R

Residential Air Ionization System



## Packaging

1 each

4900-20

## Specifications

|                              |                                                              |
|------------------------------|--------------------------------------------------------------|
| <b>Input Voltage:</b>        | 24VAC to 240VAC                                              |
| <b>Power (VA):</b>           | 10 VA                                                        |
| <b>Frequency:</b>            | 50/60 HZ                                                     |
| <b>System Size:</b>          | 6 tons (2400 CFM)                                            |
| <b>Ion Output:</b>           | 160 million ions/cc per polarity (320 million total ions/cc) |
| <b>Dimensions:</b>           | 6" L x 4.8" W x 2" D                                         |
| <b>Weight:</b>               | 1 lb.                                                        |
| <b>Electrical Approvals:</b> | UL and cUL recognized                                        |
| <b>Service Temp. Range:</b>  | -40°F to 160°F                                               |

## iWave-R Installation Instructions

1. Disconnect air handler power before installing.
2. Mount the iWave-R after the particle filter and before the indoor coil. This ensures pathogens (i.e., mold) and odors are controlled throughout the entire depth of the coil in addition to the breathing space.
3. The iWave-R is designed with universal mounting- either attach with screws or affix to the system with integral magnets. Mount near the fan inlet (shaft side) on a metal surface in the air handler, internal wall duct or external wall duct depending on what is best for the installation. For external duct mount, a three inch diameter hole will need to be cut/drilled out of the duct. **IMPORTANT:** If mounting on the fan housing, ensure the iWave-R is secured from fan vibration - use short length self-tapping screws so as not to impair operation of fan.



## iWave-R Installation Instructions Continued

**CRITICAL:** The iWave-R is designed for flush, external duct mount installations as an optional install. Ensure in all installations that other metal surfaces/wires are kept a minimum of two inches away from the tip ends of the high voltage emitters to prevent grounding, leading to premature failure.

4. The iWave-R has multi-voltage capability, connect 24VAC to 240VAC voltage input, whatever is most convenient for quick installation. Although the device only pulls 10 watts, sometimes a dedicated 24VAC power supply may be necessary depending on the current load on the transformer for other system accessories.
5. Unit may be powered 24/7 or may be interlocked with indoor fan – unit only purifies when air is flowing. If unit is wired with the fan, the quickest air purification to address an air concern is to let the fan/iWave-R run continually for 72 hours. Leaving the fan continually in the ‘on’ position will provide the best ongoing air purification in the house.
6. **Wiring:** The iWave-R has a patented multi-voltage 24VAC to 240VAC input capability. The black wire (marked ‘AC’ on label) is for 24VAC to 240VAC voltage input. The white wire (marked ‘N’ on the label) is the neutral leg for 24VAC or 120VAC; or the other hot leg for 208/240VAC. The green striped wire is ground, marked ‘G’ on the label. The brown wires (marked ‘A’ on the label) are leads to a normally closed alarm contact – see step 7.
7. The iWave-R is equipped with an alarm contact option to provide a visual indicator outside of the air conditioning system to let the homeowner know that it is in normal operation or if there is a fault. The alarm contact, a normally closed contact, rated at 240 VAC/1A, will require a power source and visual indicator, such as a LED. In normal mode, the LED will stay illuminated. If the device goes into default mode, the LED will not light. If a homeowner wants a remote indication of iWave-R status, it is recommend that the 24VAC light (bought separately) be powered through the alarm contacts and sent to a remote wall.
8. When powered up, a green LED on the iWave-R will illuminate; the ionizer is working and the stepper motor for the cleaning feature is in the home position. If the light is not illuminated, check voltage to the iWave-R.
9. **Self-Cleaning/Program Feature:** The patented iWave-R has a self-cleaning feature to ensure it is always operating at peak performance over its design life. The functions for the button include:
  - a. While in normal operation mode, press the button once, the LED light will flash and the stepper motor starts an on-demand cleaning cycle.
  - b. While in cleaning cycle (after step ‘a’ above), press the button and hold for 3 seconds, it goes into the mode of setting the cleaning cycle intervals. The iWave-R is designed to be programmed for 1, 3, 5, or 10 day cleaning cycle intervals. **The iWave-R is factory preset for cleaning the emitters every third day; this is adequate for most applications and will not need to be reprogrammed in the field.**



### **While in the cleaning mode (with LED flashing and cleaning feature working):**

- a. Press the button and hold for 3 seconds, the LED will flash once every second and the motor works once every day.
- b. Press the button twice (the first press hold for three seconds), the LED will flash twice every second and the motor works once every 3 days. This is the factory preset program.
- c. Press the button three times (the first press hold for three seconds), the LED will flash five times every second and the motor works once every 5 days.
- d. Press the button four times (the first press hold for three seconds), the LED will flash ten times every second and the motor works once every 10 days.

**Three-Year Limited Warranty** - The iWave-R offers a limited warranty for three years that covers any defects in material or workmanship under normal use. If you make a claim during the warranty period, you must provide proof of purchase and proof of proper installation by a licensed contractor for the warranty to be valid. The iWave warranty does not cover labor, return shipping charges, damage from improper installation or improper voltage usage. The iWave warranty begins on the date that the unit was purchased. Installation of your iWave by any person other than a licensed contractor will void the warranty. Contact your local Nu-Calgon account manager or [info@nucalgon.com](mailto:info@nucalgon.com) with further questions.

\*Visit [iwaveair.com](http://iwaveair.com) for performance data.

BUILT TO A HIGHER STANDARD®

American Standard®  
HEATING & AIR CONDITIONING



## HEAT PUMPS





Platinum 19  
Side Discharge



UP TO  
19 SEER2 / 9 HSPF2

Platinum 18\*



UP TO  
18 SEER2 / 8.5 HSPF2

Silver 15  
Side Discharge



UP TO  
16.0 SEER2 / 8.1 HSPF2

## AccuComfort™ Platinum 20\*



Communicating  
UP TO 20.5 SEER2 / 9.0 HSPF2

Platinum 17\*



UP TO  
17 SEER2 / 8.5 HSPF2

Gold 16



UP TO  
16.2 SEER2 / 8.1 HSPF2

Silver 15



UP TO  
16.0 SEER2 / 8.1 HSPF2

Silver 14



UP TO  
14.8 SEER2 / 7.8 HSPF2

## PLATINUM SERIES

During warm months, a heat pump works as an air conditioner, and when the weather's cool, it runs in reverse to provide heat—making it an excellent choice for mild climates. Our most efficient model, American Standard® Heating and Air Conditioning Platinum series, includes innovative American Standard Link technology to control all of the system components. The Duration™ variable-speed compressor runs at lower speeds for longer periods of time, with up to 750 speeds to provide optimal temperature control and ultra-quiet operation.

## GOLD SERIES

Equipped with Duration two-stage compressors, American Standard's Gold heat pumps operate at high or low speeds to ensure even heating and cooling depending on demand. Similar to the Platinum line, high-quality components include our proprietary Spine Fin coils for efficient heat transfer and outstanding long-term durability.

## SILVER SERIES

American Standard's Silver heat pumps pair hardworking, single-stage Duration compressors with Spine Fin coils, offering an excellent balance of affordability, efficiency and year-round comfort. For tight spaces and zero-lot-line applications, our ENERGY STAR qualified Silver 15 Side Discharge heat pump makes a perfect match.



Select models include innovative American Standard Link technology, which uses Bluetooth to communicate between system components. Simply opt in through the American Standard Home app to have your system's data remotely monitored for even the slightest system changes—letting you relax and enjoy the exceptional comfort your variable speed system provides.

\*American Standard Link enabled

## AWARD-WINNING EXCELLENCE.

2022

### Top Tier Owner Satisfaction for Gas Furnaces

"National Product Testing and Research Magazine"

In 2019 and 2021 Summer Surveys of 36,348 gas furnaces, owned by members who purchased a new gas furnace [unit] between 2005 and 2021, American Standard gas furnaces were rated Top Tier in Owner Satisfaction.

### Top Tier Owner Satisfaction for Heat Pumps

"National Product Testing and Research Magazine"

In 2019 and 2021 Summer Surveys of 13,458 heat pumps, owned by members who purchased a new heat pump [unit] between 2005 and 2021, American Standard heat pumps were rated Top Tier in Owner Satisfaction.

### Top Tier Reliability for Heat Pumps

"National Product Testing and Research Magazine"

In 2019 and 2021 Summer Surveys of 13,458 heat pumps, owned by members who purchased a new heat pump [unit] between 2005 and 2021, American Standard heat pumps were rated Top Tier in Reliability.

2021

### Top Tier Owner Satisfaction for Central Air Conditioning

"National Product Testing and Research Magazine"


In a survey based on the proportion of members who are extremely likely to recommend their central air conditioning system to friends and family found American Standard Central Air Conditioning Systems' to be Top Tier in 2018 and 2020 Summer Surveys of 23,997 central air conditioning systems, owned by members who installed a new system between 2005-2020.



**WE OBSESS  
OVER IT  
SO YOU DON'T.**

For over a hundred years, we've made some of the most awarded, well-engineered heating and conditioning equipment, and earned a reputation for doing things ...right. And through it all, we've followed a pretty simple idea: "A Higher Standard" isn't just how we build our products. It's how we build our relationships with the customers who depend on us every single day.

# A CLOSER LOOK

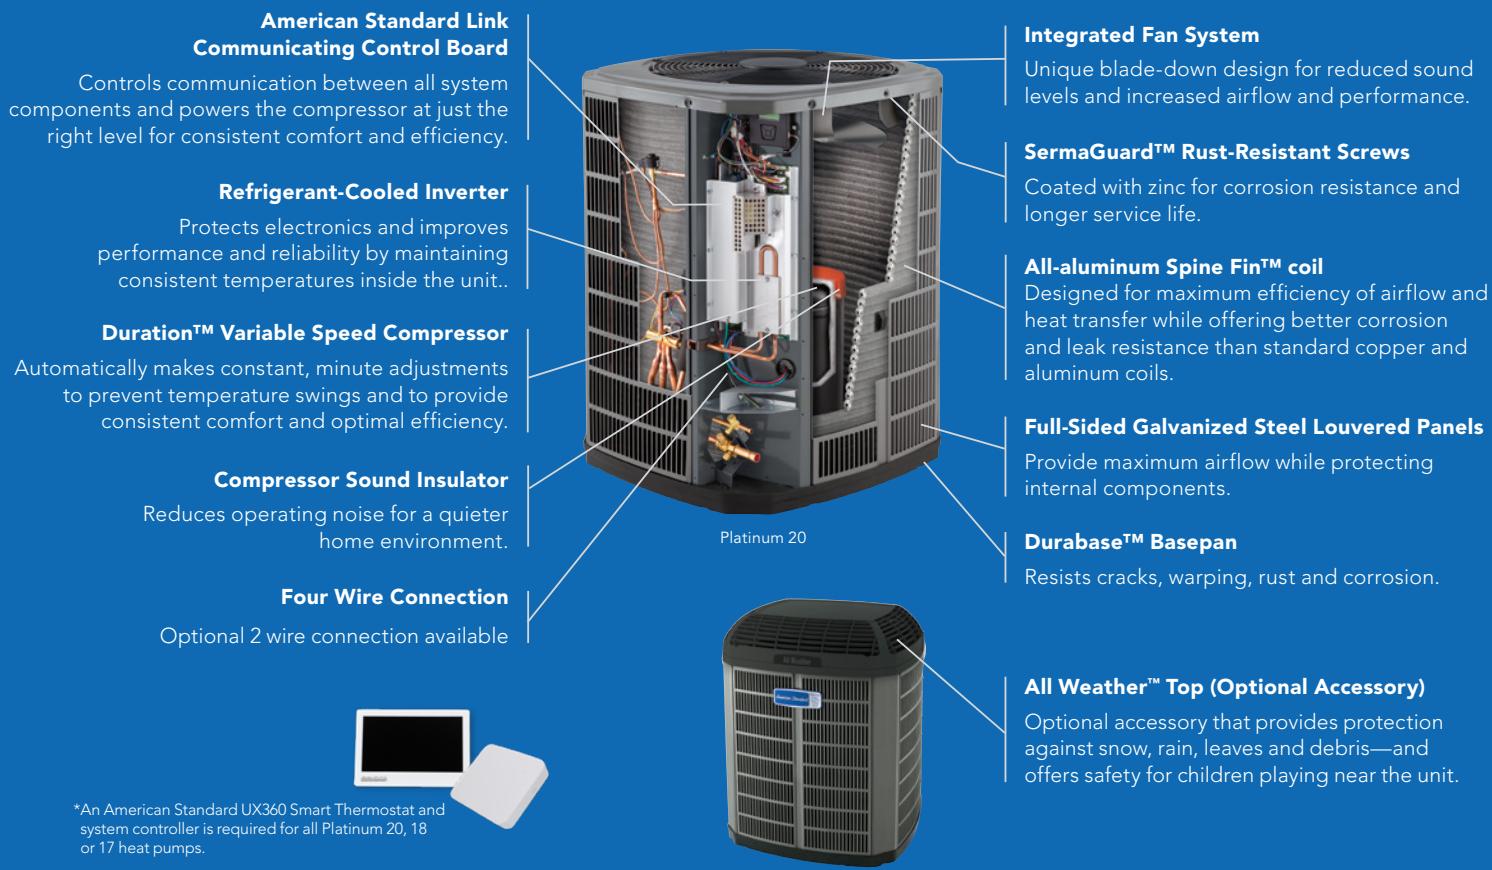

## Features

|                                                                                                                         | Platinum 20 | Platinum 19<br>Side Discharge | Platinum 18 | Platinum 17 | Gold 16 | Silver 15<br>Side Discharge | Silver 15     | Silver 14     |
|-------------------------------------------------------------------------------------------------------------------------|-------------|-------------------------------|-------------|-------------|---------|-----------------------------|---------------|---------------|
| American Standard Link Connectivity                                                                                     | Link*       | -                             | Link        | Link        | -       | -                           | -             | -             |
| AccuLink™ Communicating Technology                                                                                      | ✓           | ✓                             | ✓           | -           | -       | -                           | -             | -             |
| Duration™ compressor stages                                                                                             | 750         | 500-700+                      | 750         | 75          | 2       | 1                           | 1             | 1             |
| Capacity variability                                                                                                    | 25-100**    | 30-100++                      | 25-100**    | 25-100**    | 70/100  | 100                         | 100           | 100           |
| Compressor sound insulator                                                                                              | ✓           | -                             | ✓           | ✓           | -       | -                           | Select Models | Select Models |
| Overall sound power level [db(A)]                                                                                       | 54-76       | 43-57                         | 54-76       | 55-76       | 72-74   | 69-74                       | 71-75         | 71-76         |
| All-aluminum Spine Fin™ coil                                                                                            | ✓           | Plate Fin                     | ✓           | ✓           | ✓       | Plate Fin                   | ✓             | ✓             |
| Durabase™ basepan                                                                                                       | ✓           | -                             | ✓           | ✓           | ✓       | -                           | ✓             | ✓             |
| Variable-speed fan motor                                                                                                | ✓           | ✓                             | ✓           | ✓           | -       | -                           | -             | -             |
| Single-speed fan motor                                                                                                  | -           | -                             | -           | -           | ✓       | ✓                           | ✓             | ✓             |
| Heavy-duty steel louvered panels                                                                                        | ✓           | -                             | ✓           | ✓           | ✓       | -                           | ✓             | ✓             |
| Appliance-grade finish                                                                                                  | ✓           | ✓                             | ✓           | ✓           | ✓       | ✓                           | ✓             | ✓             |
| SermaGuard™ rust-resistant screws                                                                                       | ✓           | ✓                             | ✓           | ✓           | ✓       | ✓                           | ✓             | ✓             |
| All Weather™ Top (Optional Accessory)                                                                                   | ✓           | -                             | ✓           | ✓           | ✓       | -                           | ✓             | ✓             |
| High SEER2 efficiency (up to) When installed with certain American Standard Heating & Air Conditioning indoor products. | 20.50       | 19.00                         | 18.00       | 17.00       | 16.20   | 16.00                       | 16.00         | 14.80         |
| High HSPF2 efficiency (up to) When installed with certain American Standard Heating & Air Conditioning indoor products. | 9.00        | 9.00                          | 8.50        | 8.50        | 8.10    | 8.10                        | 8.10          | 7.80          |
| 12 Year limited warranty compressor, 10 Year limited warranty outdoor coil and functional parts with registration.*     | ✓           | -                             | ✓           | ✓           | ✓       | -                           | -             | -             |
| 10 Year limited warranty compressor, outdoor coil and functional parts with registration.*                              | -           | ✓                             | -           | -           | -       | ✓                           | ✓             | ✓             |

\*\* Platinum 20/18 vary speed in 1/10 of 1% increments. Platinum 17 varies speed in 1% increments.

+ 2 & 3 ton have 500 stages, 4 ton has 650 stages, 5 ton has 700 stages

++ 2 & 3 ton are 50-100%, 4 ton is 35-100%, 5 ton is 30-100%

\* Registered Limited Warranty terms are available when you register within 60 days of installation. You can register online at [americanstandardair.com](http://americanstandardair.com) or by phone at 855-260-2975, otherwise American Standard Heating & Air Conditioning's Base Limited Warranty terms will apply. Base Limited Warranty information on specific products can be found on [americanstandardair.com](http://americanstandardair.com). Ask your dealer for full warranty information at time of purchase. Warranties are for residential and multi-family use only, some exclusions may apply.



#### COMFORTABLE. RELIABLE. EFFICIENT.

Optimize the comfort and efficiency of your home with the American Standard Home smart comfort system. The American Standard Home mobile app gives you remote access to your HVAC system through your connected American Standard smart thermostat. Adjust your temperature, set your schedule, and view your HVAC usage from anywhere.



American Standard Home connects to your American Standard HVAC system to provide you with remote control and diagnostics. To view additional integrations and subscriptions, visit our Knowledge Base at [AmericanStandardAir.com/home-subscription](http://AmericanStandardAir.com/home-subscription).

#### WHY IS INDOOR AIR QUALITY IMPORTANT?

We spend 90% of our time indoors, and 70% of that is in our home<sup>1</sup> where the air can be up to 5X poorer quality than the air outside<sup>2</sup>. So, AccuClean<sup>®</sup> utilizes patented technology to deliver cleaner air to the whole home by removing up to 99.98% of airborne particles<sup>3</sup> that pass through the re-usable filter, including 99.9% of the Influenza A (H1N1) virus<sup>4</sup>. The AccuClean<sup>®</sup> Whole Home Air Cleaner, when used in accordance with manufacturer's directions, is effective at removing a surrogate for the virus that causes COVID-19. Effective removal rate based on independent testing results using MS-2 bacteriophage, a bacteria representative of virus-sized particles like SARS-CoV-2 that causes COVID-19. This level of filtration makes it up to 100X more effective than a standard 1" filter<sup>5</sup>.

#### Certified by the Asthma and Allergy Foundation of America.

With more than 65 million Americans suffering from asthma and allergies, this certification mark guides consumers in identifying products more suitable for people with asthma and allergies. The **asthma & allergy friendly<sup>®</sup>** Certification Mark is awarded only to those products that are scientifically proven to reduce exposure to asthma and allergy triggers.



American Standard AccuClean<sup>®</sup> is verified zero ozone producing so you can breathe easier knowing your air is free from harmful byproducts.<sup>6</sup>

<sup>1</sup> The National Human Activity Pattern Survey (2001)

<sup>2</sup> U.S. Environmental Protection Agency. EPA/600/6-87/002a. (1987)

<sup>3</sup> Based on 3<sup>rd</sup> party testing of particle removal efficiency down to 0.3 microns (2005)

<sup>4</sup> As reported by airmid healthgroup in ASCR092142v2 (2015)

<sup>5</sup> Assuming <1% removal rate of 0.3 – 10 micron particles

<sup>6</sup> Verified Zero Ozone per UL 2998, Intertek Certificate #: ZOZ-90113-2022a

## WE OBSESS OVER IT. SO YOU DON'T.

BUILT TO A HIGHER STANDARD<sup>®</sup>  
**American Standard**  
HEATING & AIR CONDITIONING

SCAN ME



About American Standard Heating and Air Conditioning

American Standard has been creating comfortable and affordable living environments for more than a century. For more information, please visit [www.americanstandardair.com](http://www.americanstandardair.com).

All trademarks referenced are trademarks of their respective owners.  
© 2023 American Standard Heating and Air Conditioning.



ULTRA  
SERIES

# ► SANTA FE ULTRA120



The **Ultra120** is designed to deliver exceptional indoor air quality by providing dedicated moisture control, fresh air mechanical ventilation, and superior air filtration (MERV 13) to homes up to 3,000 sq. ft. The unit features an extremely well-insulated, compact horizontal cabinet for the ultimate in quiet operation and install options.

## MODEL 4031957

### PERFORMANCE

|                       |                                                             |
|-----------------------|-------------------------------------------------------------|
| Water Removal         | 121 Pints / 15.125 Gallons                                  |
| Efficiency            | 6.1 Pints/kWh                                               |
| Energy Factor         | 2.95 L/kWh                                                  |
| Blower                | 350 CFM @ 0.0" WG<br>285 CFM @ 0.2" WG<br>210 CFM @ 0.4" WG |
| Operating Temperature | 49°F Min., 95°F Max.                                        |
| Sizing                | Up to 3,000 Sq. Ft. / 30,000 Cu. Ft.                        |

### ELECTRICAL

|                     |                             |
|---------------------|-----------------------------|
| Power               | 840 watts @ 80°F and 60% RH |
| Supply Voltage      | 115 volt – 1 phase – 60 Hz  |
| Current Draw        | 7.3 amps                    |
| Power Cord          | 9', 115 VAC, Ground         |
| Circuit Requirement | 15 Amps                     |




Plug Type B  
(USA, MEX, CAN, JPN)

### SPECIFICATIONS

|                  |                                                   |
|------------------|---------------------------------------------------|
| Duct Connections | 6" Round Inlet, 10" Round Inlet, 10" Round Outlet |
| Drain Connection | 3/4" Threaded Female NPT                          |
| Refrigerant      | R410A, 1 lb. 10 oz.                               |
| Unit Dimensions  | 14.4"W x 21"H x 32.2"D                            |
| Unit Weight      | 91 lbs.                                           |

### SHIPPING

|                     |                        |
|---------------------|------------------------|
| Shipping Dimensions | 18.5"W x 23.5"H x 40"D |
| Shipping Weight     | 101 lbs.               |
| Pallet Quantity     | 4 per pallet           |
| UPC Number          | 859029004656           |
| Shipping Options    | LTL                    |

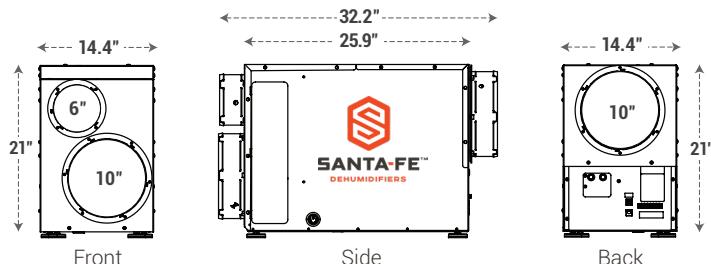

Specifications are subject to change without notice. Performance is based on pints / gallons per day @80°F/60%RH. Sizing is based on 10 foot ceiling height. Unit dimensions and weight are with collars on.

\* Previously the Ultra Aire 120H.

### FEATURES

- + Features a horizontal configuration with optional vertical discharge
- + Designed for quiet operation
- + Engineered for low temperature operation providing comfort year round
- + Use of DEH 3000/R digital control for outdoor air ventilation and humidity control
- + Superior MERV-13 filtration to improve indoor air quality
- + Ducting option for fresh outdoor air ventilation
- + Push button reset for transformer protection



**SANTA-FE**™  
INDOOR AIR QUALITY SOLUTIONS



**BUILT TO LAST. POWERED TO PROTECT.**

**Please publish once in the December 25, 2025, edition**

### **Notice of Public Hearing**

Notice is hereby given that the City of Jonestown Board of Adjustments will hold a public hearing to receive citizen input and consider action on the following item:

- A public hearing to receive public input and consider a request by Csaba Kos and Seon Mee Chang for a Special Exception from the Jonestown Unified Development Code Ordinance No. 2025-O-650 adopted January 9, 2025, Table 3-3.2.4-1 to allow unenclosed off-street parking for property located at 17363 East Reed Parks Road (Property ID: 953652), in Jonestown, Texas.

This public hearing before the Board of Adjustments will be held on Monday, January 12, 2026, at 6:00 p.m.

Information concerning these requests are available for viewing at Jonestown City Hall, 18649 FM 1431, Suite 4-A, during the hours of 7:00 a.m. to 5:00 p.m., Monday through Thursday and 8:00 a.m. to 12:00 p.m. on Friday. You may call (512) 267-0359 or e-mail [permitting@jonestowntx.gov](mailto:permitting@jonestowntx.gov) for more information.



17363 E REED PARK RD



**alterstudio, LLP**

512.499.8007  
fax 512.499.8049

THIS DRAWING IS RELEASED  
UNDER THE AUTHORITY OF  
ERNESTO CRAGNOLINO  
(TEXAS REGISTRATION #17761)  
AND IS NOT FOR REGULATORY  
APPROVAL, PERMITTING OR  
CONSTRUCTION



**kos residence**

site plan

09.11.2025

1/64" = 1'-0"

Aerial View - Garage



Aerial View - Carport



View from the bottom of the driveway - Garage



View from the bottom of the driveway - Carport



View from the parking court - Garage



View from the parking court - Carport



View from the entry walkway - Garage



View from the entry walkway - Carport

